
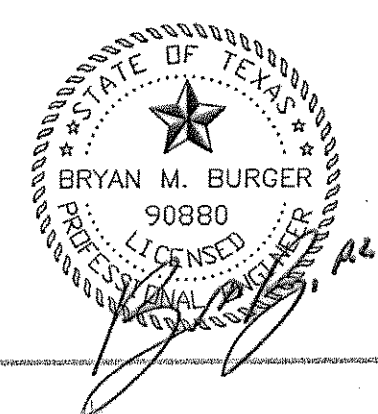


AS BUILT
DATE 11-6-03

BENCH MARK:
BOX CUT IN NW CURB RETURN AT THE
INTERSECTION OF WESTWOOD AND
ROCKWALL PARKWAY.
ELEVATION = 537.56

THE SEAL APPEARING ON THIS
DOCUMENT WAS AUTHORIZED BY
BRYAN M. BURGER, P.E. 90880
ON 03/12/05

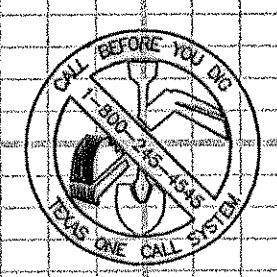

SANITARY SEWER PROFILE

LOT 5, BLOCK A
HORIZON RIDGE ADDITION
CITY OF ROCKWALL, TEXAS

LAWRENCE A. CATES & ASSOC., INC. CONSULTING ENGINEERS
14200 MIDWAY ROAD, SUITE 122 (972) 385-2272 DALLAS, TEXAS

DESIGN	DRAWN	DATE	SCALE	NOTES	FILE	NO.
		2/03	1"=40' 1"=8'	D.P.	23008 ss-profile	C-10