


BENCH MARK:
 BOX CUT IN NW CURB RETURN AT THE
 INTERSECTION OF WESTWOOD AND
 ROCKWALL PARKWAY.
 ELEVATION = 537.56



- LEGEND**
- F.H. FIRE HYDRANT
 - X SET CHISELED "X" SET
 - F.X. CHISELED "X" FOUND
 - F.I.R. IRON ROD FOUND (SIZE AS NOTED)
 - S.I.R. IRON ROD SET (SIZE AS NOTED)
 - U.P. OVERHEAD UTILITY POLE W/ GUY
 - U.E. UNDERGROUND ELECTRIC OR TELEPHONE
 - L.P. LIGHT POLE (EX)
 - S.M.H. SANITARY SEWER MANHOLE (EX)
 - C.O. SAN. SWR. CLEAN OUT (EX)
 - G.V. GAS VALVE (EX)
 - W.V. WATER VALVE (EX)
 - T. TREE
 - PROP. COMBINATION GRATE INLET
 - PROP. DROP INLET
 - PROP. CURB INLET
 - PROP. SIGNAGE (H.C.)
 - PAINTED HANDICAP SYMBOL
 - ▬ PROPOSED STORM SEWER
 - ▬ EXISTING STORM SEWER
 - ▬ REMOVE EX. CONC. P.W.M.

NOTE: ALL DIMENSIONS ARE TO FACE OF CURB UNLESS OTHERWISE NOTED.

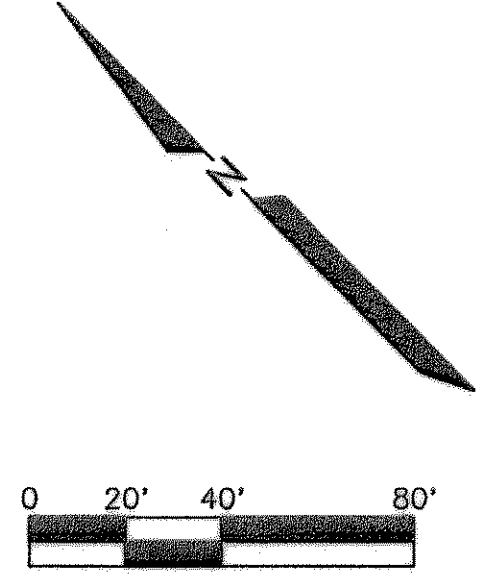


~ CURVE TABLE ~

NO.	RADIUS	DELTA	ARC	CH. BEARING	CHORD
C8	100'	30°00'00"	52.36'	N 29°22'43" E	51.76'
C9	100'	30°00'00"	52.36'	S 29°22'43" W	51.76'

THE SEAL APPEARING ON THIS DOCUMENT WAS AUTHORIZED BY BRYAN M. BURGER, P.E. 90880 ON 04/16/03

AS BUILT
 DATE 11-6-03

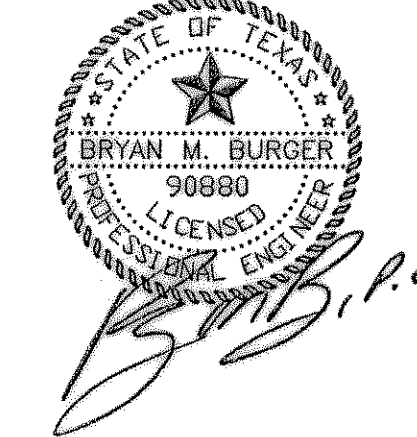

1	4/15/03	CITY COMMENTS				
REV	DATE	REMARKS				
DRAINAGE PLAN						
LOT 5, BLOCK A						
HORIZON RIDGE ADDITION						
THE CITY OF ROCKWALL, TEXAS						
LAWRENCE A. CATES & ASSOC., INC. CONSULTING ENGINEERS						
14200 MIDWAY ROAD, SUITE 122 (972) 385-2272 DALLAS, TEXAS						
DESIGN	DRAWN	DATE	SCALE	NOTES	FILE	NO.
LAC	LAC	5/01	1"=40'	D.P.	23008 DRAINAGE2	C-7