


STORM LN I.5


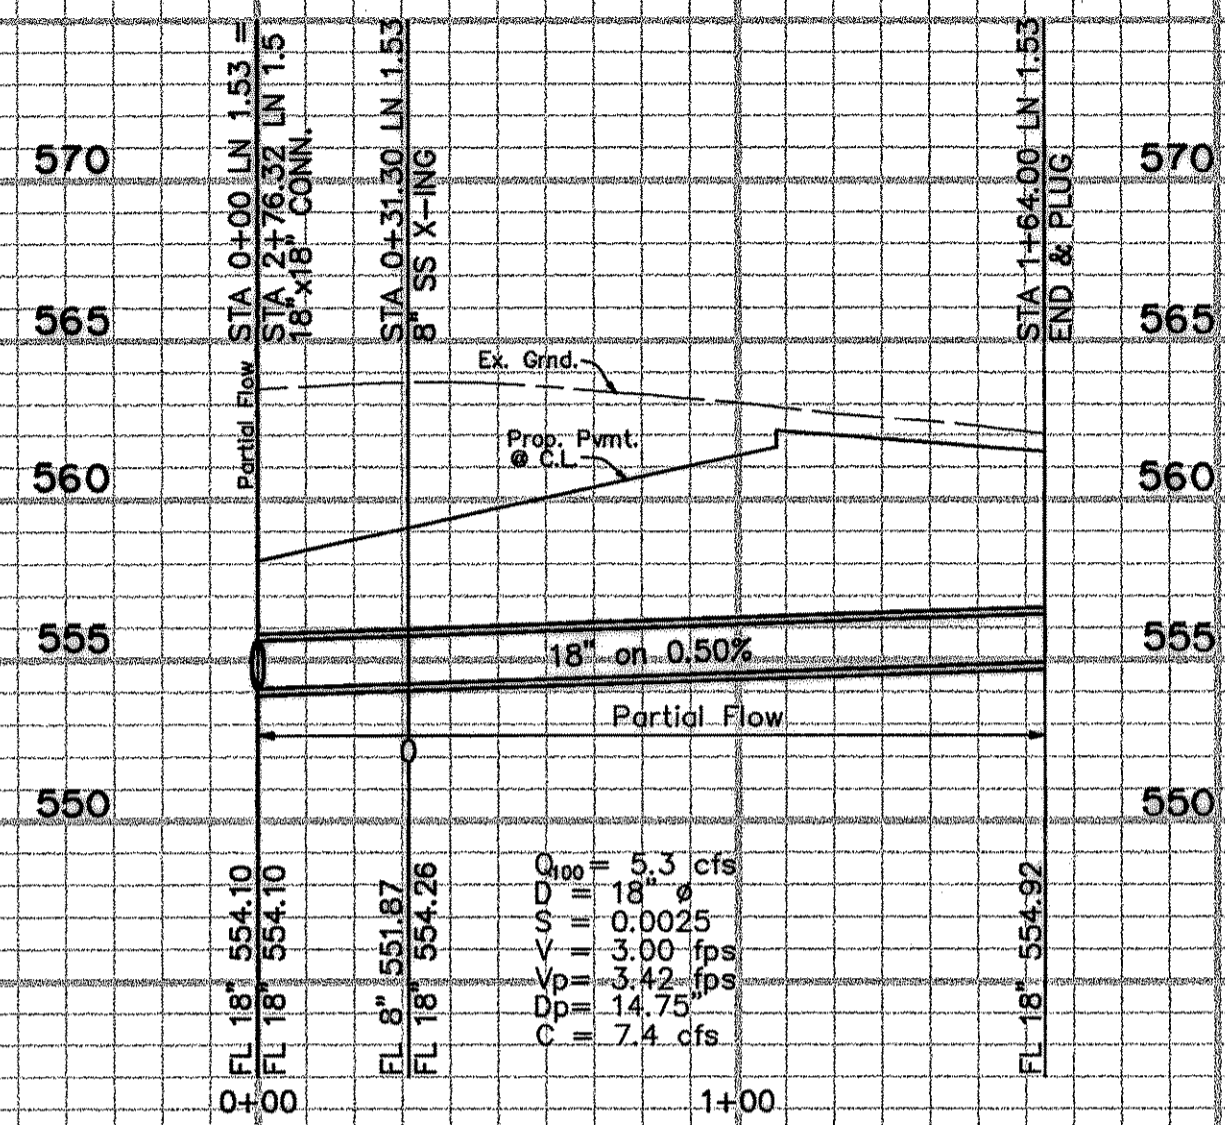


STORM LN I.53

AS BUILT
DATE 11-6-03

BENCH MARK:
BOX CUT IN NW CURB RETURN AT THE
INTERSECTION OF WESTWOOD AND
ROCKWALL PARKWAY,
ELEVATION = 537.56

THE SEAL APPEARING ON THIS
DOCUMENT WAS AUTHORIZED BY
BRYAN M. BURGER, P.E. 90880
ON 03/12/03

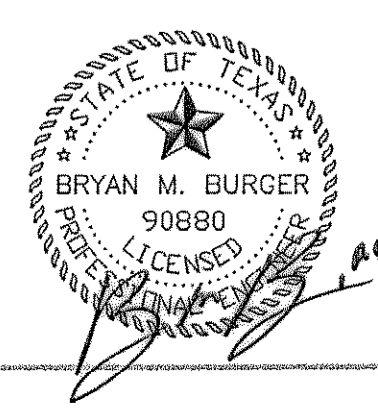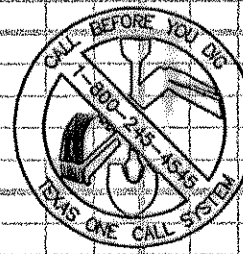

REV.	DATE	REMARKS
STORM SEWER PROFILES		
LOT 5, BLOCK A HORIZON RIDGE ADDITION THE CITY OF ROCKWALL, TEXAS		
LAWRENCE A. CATES & ASSOC., INC. 14200 MIDWAY ROAD, SUITE 122 (972) 385-2272		CONSULTING ENGINEERS DALLAS, TEXAS
DESIGN	DRAWN	DATE
		2/03
SCALE	NOTES	FILE
1"=40' 1"=8'	D.P.	23008 storm
		NO.
		C-8