


GENERAL NOTES

- ALL WORK, UNLESS OTHERWISE NOTED, SHALL CONFORM TO THE STANDARD SPECIFICATIONS FOR PUBLIC WORKS CONSTRUCTION, ISSUED BY THE NORTH CENTRAL TEXAS COUNCIL OF GOVERNMENT, AND CITY OF ROCKWALL STANDARD CONSTRUCTION SPECIFICATIONS.
- PRIOR TO ANY CONSTRUCTION, THE CONTRACTOR SHALL BE FAMILIAR WITH THE PLANS INCLUDING ALL NOTES, THE STANDARD SPECIFICATIONS FOR PUBLIC WORKS CONSTRUCTION NORTH CENTRAL TEXAS AND THE CITY STANDARDS FOR CONSTRUCTION AND ANY OTHER APPLICABLE STANDARD AND SPECIFICATIONS RELEVANT TO THE PROPER COMPLETION OF THE WORK SPECIFIED. FAILURE ON THE PART OF THE CONTRACTOR TO BE FAMILIAR WITH ALL STANDARDS AND SPECIFICATION PERTAINING TO THIS WORK SHALL IN NO WAY RELIEVE THE CONTRACTOR OF RESPONSIBILITY OF PERFORMING THE WORK IN ACCORDANCE WITH ALL SUCH APPLICABLE STANDARDS AND SPECIFICATIONS.
- THE HORIZONTAL AND VERTICAL LOCATIONS OF EXISTING SUBSURFACE UTILITIES HAVE BEEN DETERMINED FROM DATA RECORDED BY OTHERS. CONTRACTOR SHALL VERIFY THAT NECESSARY CROSSING CLEARANCES BETWEEN EXISTING AND PROPOSED UTILITIES EXIST PRIOR TO CONSTRUCTION OF ANY SUCH CROSSING. IT WILL BE THE RESPONSIBILITY OF THE CONTRACTOR TO PROTECT ALL UTILITIES IN THE CONSTRUCTION OF THIS PROJECT. CONTRACTOR TO VERIFY SIZE AND LOCATION OF ALL UTILITIES PRIOR TO CONSTRUCTION.
- IT WILL BE THE RESPONSIBILITY OF THE CONTRACTOR TO PROTECT ALL MANHOLES, CLEANOUTS, VALVE BOXES, FIRE HYDRANTS, ETC. THEY MUST BE ADJUSTED TO PROPER LINE AND GRADE BY THE CONTRACTOR PRIOR TO AND AFTER THE PLACING OF PERMANENT PAVING AND GRADING. UTILITIES MUST BE MAINTAINED TO PROPER LINE AND GRADE DURING THE CONSTRUCTION OF THIS DEVELOPMENT.
- PROTECT AND MAINTAIN ROADWAY TRAFFIC THROUGHOUT THE PROJECT, PROVIDING A MINIMUM OF ONE (1) LANE OPEN IN EACH DIRECTION;
 - PROVIDE AND MAINTAIN INTERIM ACCESS FROM ROADWAYS CURRENTLY IN USE TO ALL DRIVEWAYS AND INTERSECTING STREETS OR ALLEYS;
 - MAINTAIN NORMAL PROJECT DRAINAGE UNTIL NEW DRAINAGE FACILITIES ARE FUNCTIONAL, INCLUDING, WHERE NECESSARY, INTERIM REPLACEMENT OF EXISTING DRAINAGE STRUCTURES REMOVED FOR CONSTRUCTION OF NEW DRAINAGE FACILITIES;
 - MAINTAIN ALL WORK AND MATERIAL STORAGE AREAS IN ORDERLY CONDITION, FREE OF DEBRIS AND WASTE; ON COMPLETION OF CONSTRUCTION, CLEAN UP THE PROJECT AND ADJACENT AFFECTED AREAS TO ACCEPTABLE CONDITION, ALL AS PROVIDED IN THE GENERAL CONDITIONS.
- PRIOR TO COMMENCEMENT OF CONSTRUCTION, BONDS AND THREE-WAY CONTRACTS SHALL BE SUBMITTED TO THE CITY AS REQUIRED.
- THE CONTRACTOR IS RESPONSIBLE FOR COMPLIANCE WITH ALL FEDERAL, STATE AND LOCAL REGULATIONS REGARDING TRENCH SAFETY.
- REFER TO ARCHITECTURAL AND STRUCTURAL DETAILS TO VERIFY ALL BUILDING DIMENSIONS.
- REFER TO ARCHITECTURAL PLANS FOR DETAILED BUILDING ENTRANCE LAYOUTS, RAMPS, LANDSCAPE AND SIDEWALKS.
- BARRICADING AND PROJECT SIGNS SHALL CONFORM TO TEXAS DEPARTMENT OF TRANSPORTATION MANUAL OF UNIFORM TRAFFIC CONTROL DEVICES AND LATEST UPDATES.
- ALL DIMENSIONS ARE FROM BACK OF CURB UNLESS OTHERWISE NOTED.


PETER TEMUNOVIC & CUVJETA TEMUNOVIC
(VOL. 959, PG. 150)

LEGEND

- BOLLARD
- ELECTRIC METER
- POWER POLE
- LIGHT STANDARD
- WATER METER
- WATER VALVE
- IRRIGATION CONTROL VALVE
- FIRE HYDRANT
- CLEANOUT
- MANHOLE
- TRAFFIC SIGNAL CONTROL
- TRAFFIC SIGNAL POLE
- TELEPHONE BOX
- FLAG POLE
- TRAFFIC SIGN
- PROPERTY LINE
- FENCE
- 1/2-INCH IRON ROD W/ "PACHECO KOCH" CAP SET (C.M.)
- CONTROLLING MONUMENT

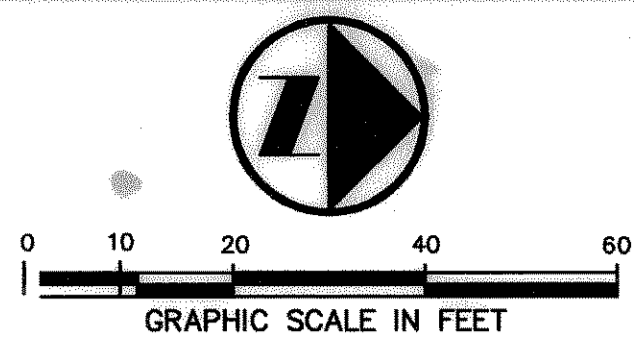

LOT 10R, BLOCK A
HORIZON RIDGE ADDITION
(CAB. E, SLIDE 325-326)
YANCEY-HAUSMAN DEVELOPMENT, INC.
(VOL. 2918, PG. 0221)

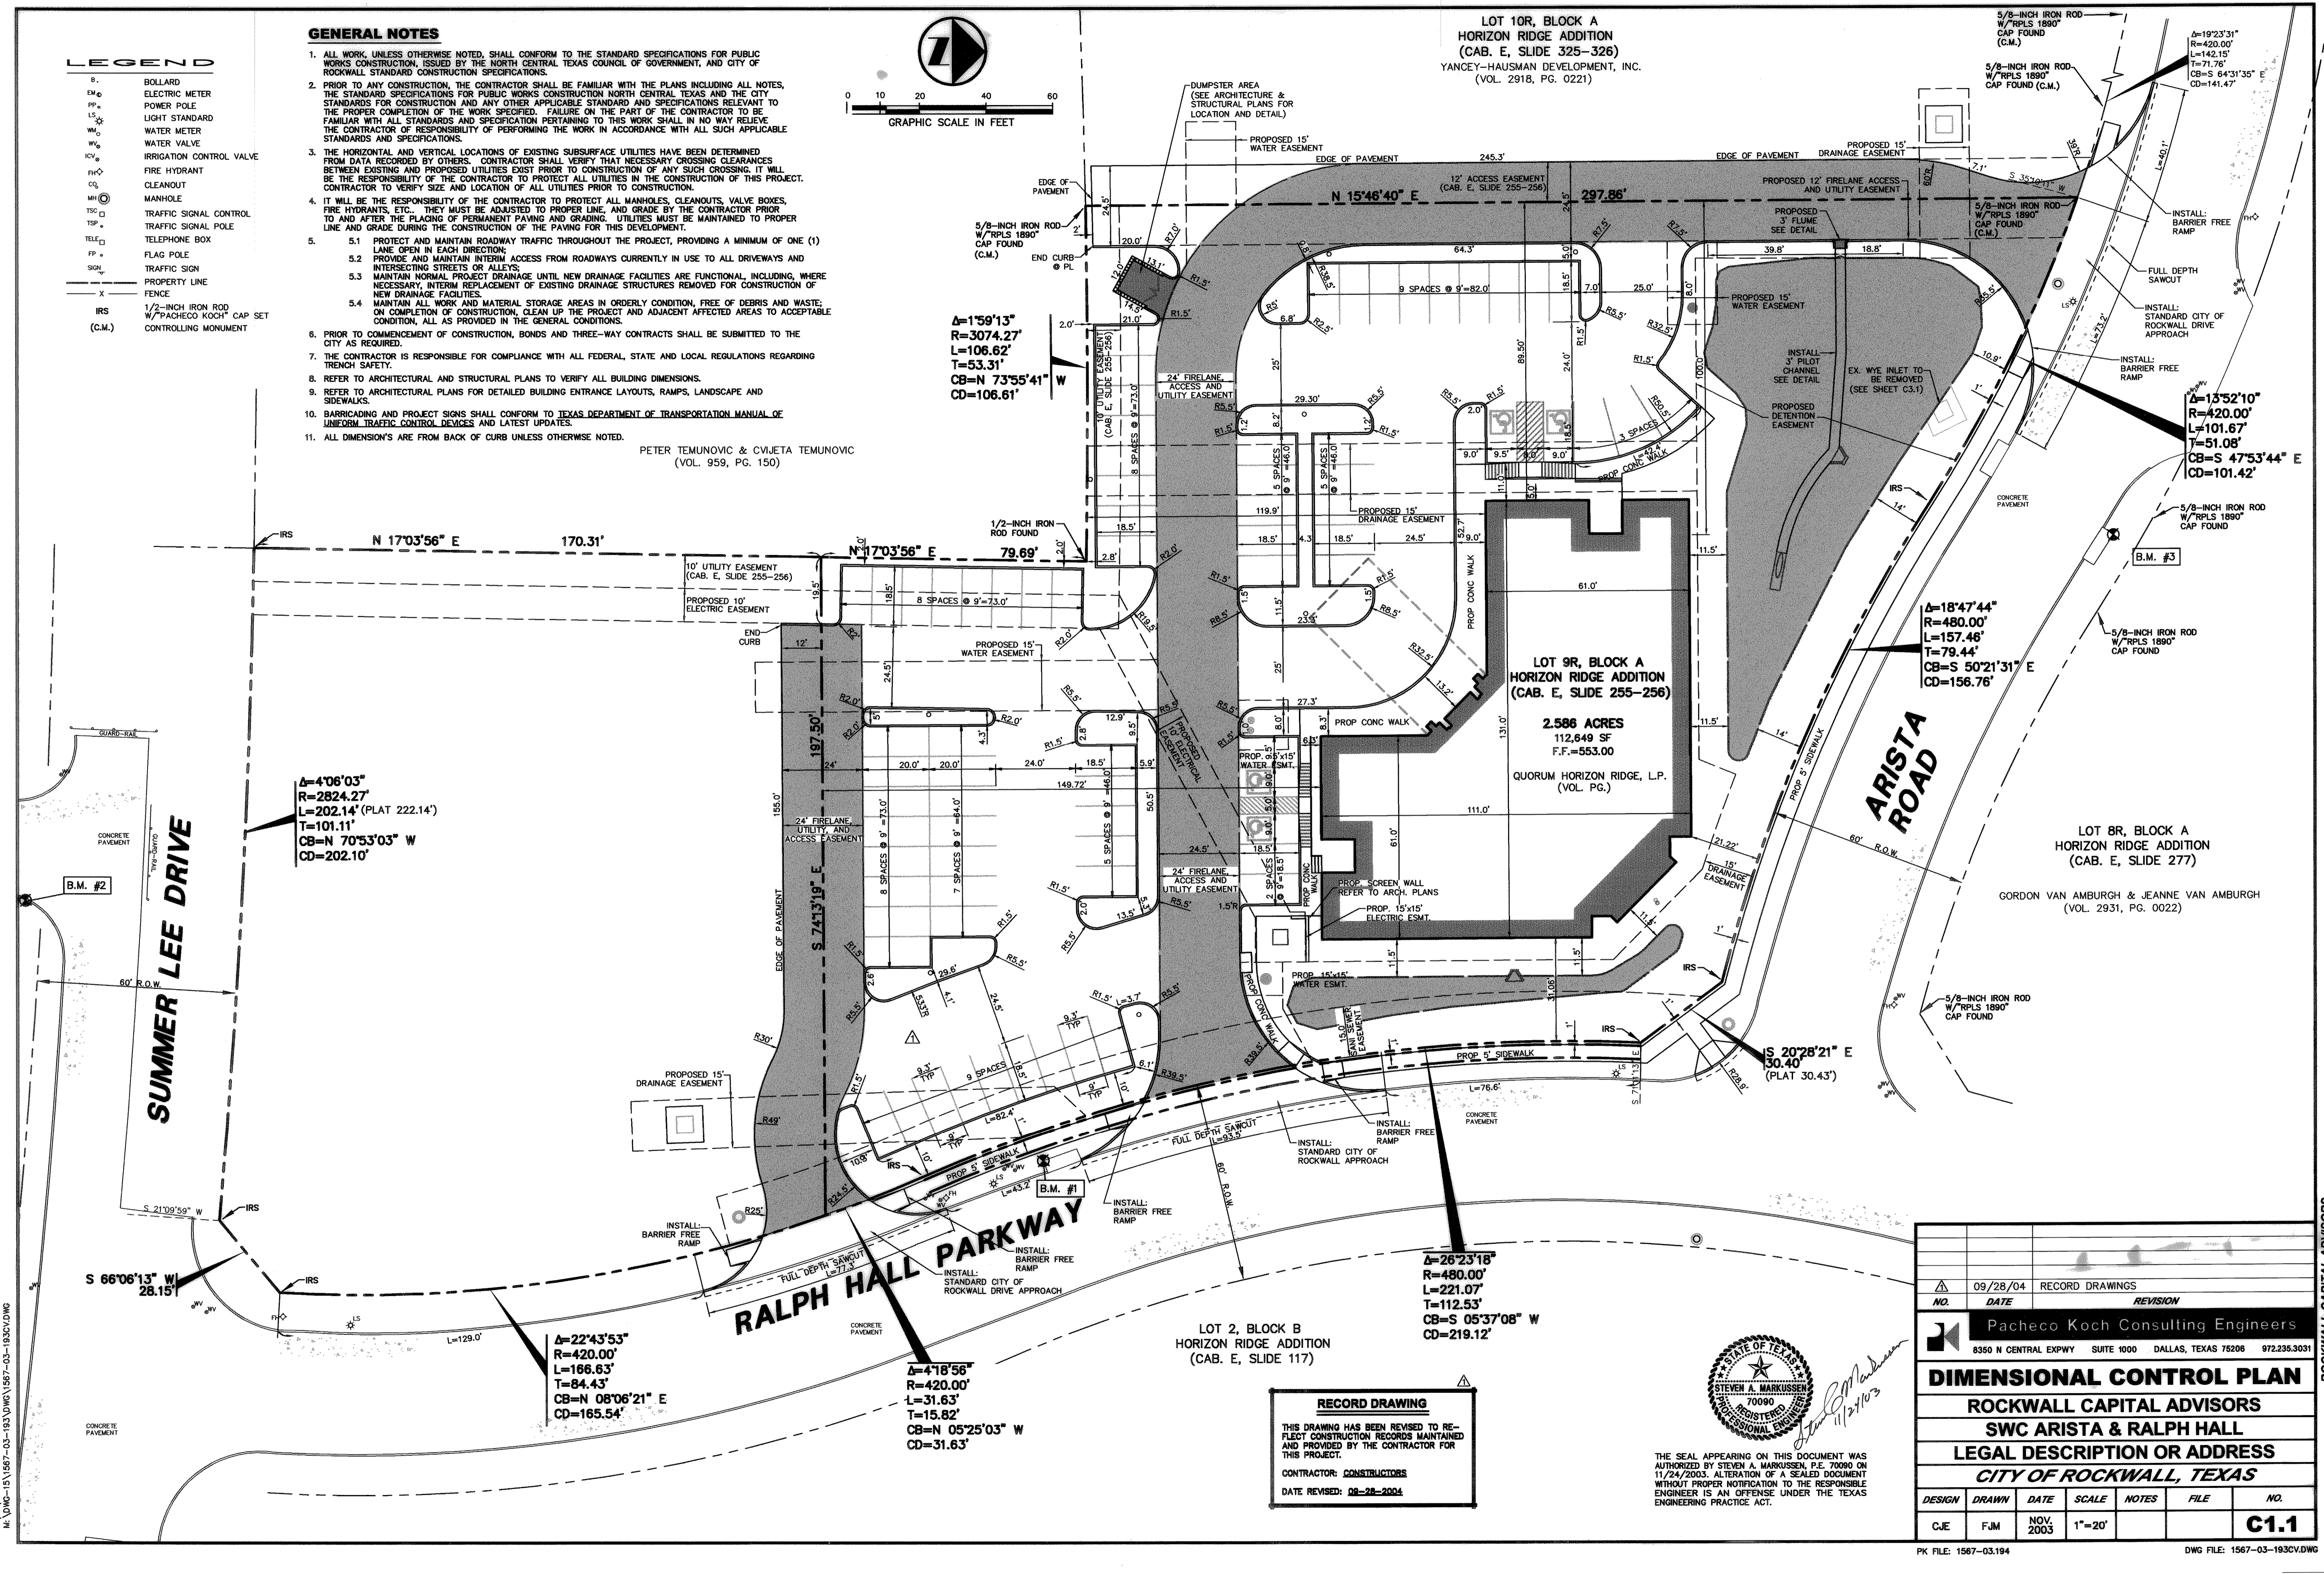

$\Delta=4'06'03''$
 $R=2824.27'$
 $L=202.14'$ (PLAT 222.14')
 $T=101.11'$
 $CB=N 70'53'03'' W$
 $CD=202.10'$

$\Delta=1'59'13''$
 $R=3074.27'$
 $L=106.62'$
 $T=53.31'$
 $CB=N 73'55'41'' W$
 $CD=106.61'$

$\Delta=18'47'44''$
 $R=480.00'$
 $L=157.46'$
 $T=79.44'$
 $CB=S 50'21'31'' E$
 $CD=156.76'$

$\Delta=13'52'10''$
 $R=420.00'$
 $L=101.67'$
 $T=51.08'$
 $CB=S 47'53'44'' E$
 $CD=101.42'$

$\Delta=22'43'53''$
 $R=420.00'$
 $L=166.63'$
 $T=84.43'$
 $CB=N 08'06'21'' E$
 $CD=165.54'$

$\Delta=4'18'56''$
 $R=420.00'$
 $L=31.63'$
 $T=15.82'$
 $CB=N 05'25'03'' W$
 $CD=31.63'$

$\Delta=26'23'18''$
 $R=480.00'$
 $L=221.07'$
 $T=112.53'$
 $CB=S 05'37'08'' W$
 $CD=219.12'$

RECORD DRAWING
THIS DRAWING HAS BEEN REVISED TO REFLECT CONSTRUCTION RECORDS MAINTAINED AND PROVIDED BY THE CONTRACTOR FOR THIS PROJECT.
CONTRACTOR: CONSTRUCTORS
DATE REVISED: 02-28-2004



THE SEAL APPEARING ON THIS DOCUMENT WAS AUTHORIZED BY STEVEN A. MARKUSSEN, P.E. 70990 ON 11/24/2003. ALTERATION OF A SEALED DOCUMENT WITHOUT PROPER NOTIFICATION TO THE RESPONSIBLE ENGINEER IS AN OFFENSE UNDER THE TEXAS ENGINEERING PRACTICE ACT.

NO.	DATE	REVISION
09/28/04	09/28/04	RECORD DRAWINGS
Pacheco Koch Consulting Engineers		
8350 N CENTRAL EXPWY SUITE 1000 DALLAS, TEXAS 75208 972.235.3031		
DIMENSIONAL CONTROL PLAN		
ROCKWALL CAPITAL ADVISORS		
SWC ARISTA & RALPH HALL		
LEGAL DESCRIPTION OR ADDRESS		
CITY OF ROCKWALL, TEXAS		
DESIGN	DRAWN	DATE
CJE	FJM	NOV. 2003
SCALE	NOTES	FILE
1"=20'		
		NO.
		C1.1