

LEGEND


B	BOLLARD
EM	ELECTRIC METER
PP	POWER POLE
LS	LIGHT STANDARD
WM	WATER METER
WV	WATER VALVE
ICV	IRRIGATION CONTROL VALVE
FH	FIRE HYDRANT
CO	CLEANOUT
MH	MANHOLE
TSC	TRAFFIC SIGNAL CONTROL
TSP	TRAFFIC SIGNAL POLE
TELE	TELEPHONE BOX
FL	FLOOD LIGHT
FP	FLAG POLE
SH	TRAFFIC SIGN
IRS	1/2-INCH IRON ROD
W/P	W/PACHECO KOCH CAP SET
(C.M.)	CONTROLLING MONUMENT
---	PROPERTY LINE
-X-	FENCE
OH	OVERHEAD UTILITY LINE
UW	UNDERGROUND WATER LINE
E	UNDERGROUND ELECTRIC LINE
T	UNDERGROUND TELEPHONE LINE
C	UNDERGROUND CABLE LINE
6"SS	UNDERGROUND SANITARY SEWER LINE

NOTE:
CONTRACTOR TO COORDINATE WITH THE CITY INSPECTOR ON THE REMOVAL OF STREET PAVEMENT TO FACILITATE THE INSTALLATION OF THE PROPOSED MANHOLE. IF PAVEMENT REMOVAL IS REQUIRED, WHOLE PANELS ARE TO BE REMOVED AND REPLACED MATCHING THE STREET THICKNESS IF LINED, OR ADDING 2-INCHES TO THE PAVEMENT IF NOT LINED.


BENCH MARK LIST

BM# 1	"	CUT SET ON THE NORTHWEST CORNER OF INLET ON THE NORTH SIDE OF RALPH HALL PARKWAY 215'± WEST OF CENTERLINE OF RALPH HALL PARKWAY AND ARISTA ROAD.	ELEV=551.01
BM# 2	"	CUT SET ON TOP OF CURB ON THE POINT OF CURVE OF THE BACK OF CURB AT THE SOUTHWEST CORNER OF THE INTERSECTION OF OAK DRIVE AND SUMMER LEE DRIVE.	ELEV=563.21
BM# 3	"	CUT ON THE NORTHEAST CORNER OF INLET ON THE EAST SIDE OF ARISTA ROAD 200'± NORTH OF CENTERLINE OF RALPH HALL PARKWAY.	ELEV=546.93

RECORD DRAWING
THIS DRAWING HAS BEEN REVISED TO REFLECT CONSTRUCTION RECORDS MAINTAINED AND PROVIDED BY THE CONTRACTOR FOR THIS PROJECT.
CONTRACTOR: CONSTRUCTORS
DATE REVISED: 09-28-2004

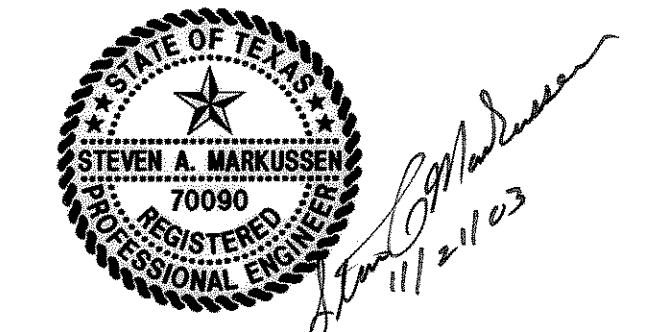

THE SEAL APPEARING ON THIS DOCUMENT WAS AUTHORIZED BY STEVEN A. MARKUSSEN, P.E. 70090 ON 11/21/2003. ALTERATION OF A SEALED DOCUMENT WITHOUT PROPER NOTIFICATION TO THE RESPONSIBLE ENGINEER IS AN OFFENSE UNDER THE TEXAS ENGINEERING PRACTICE ACT.

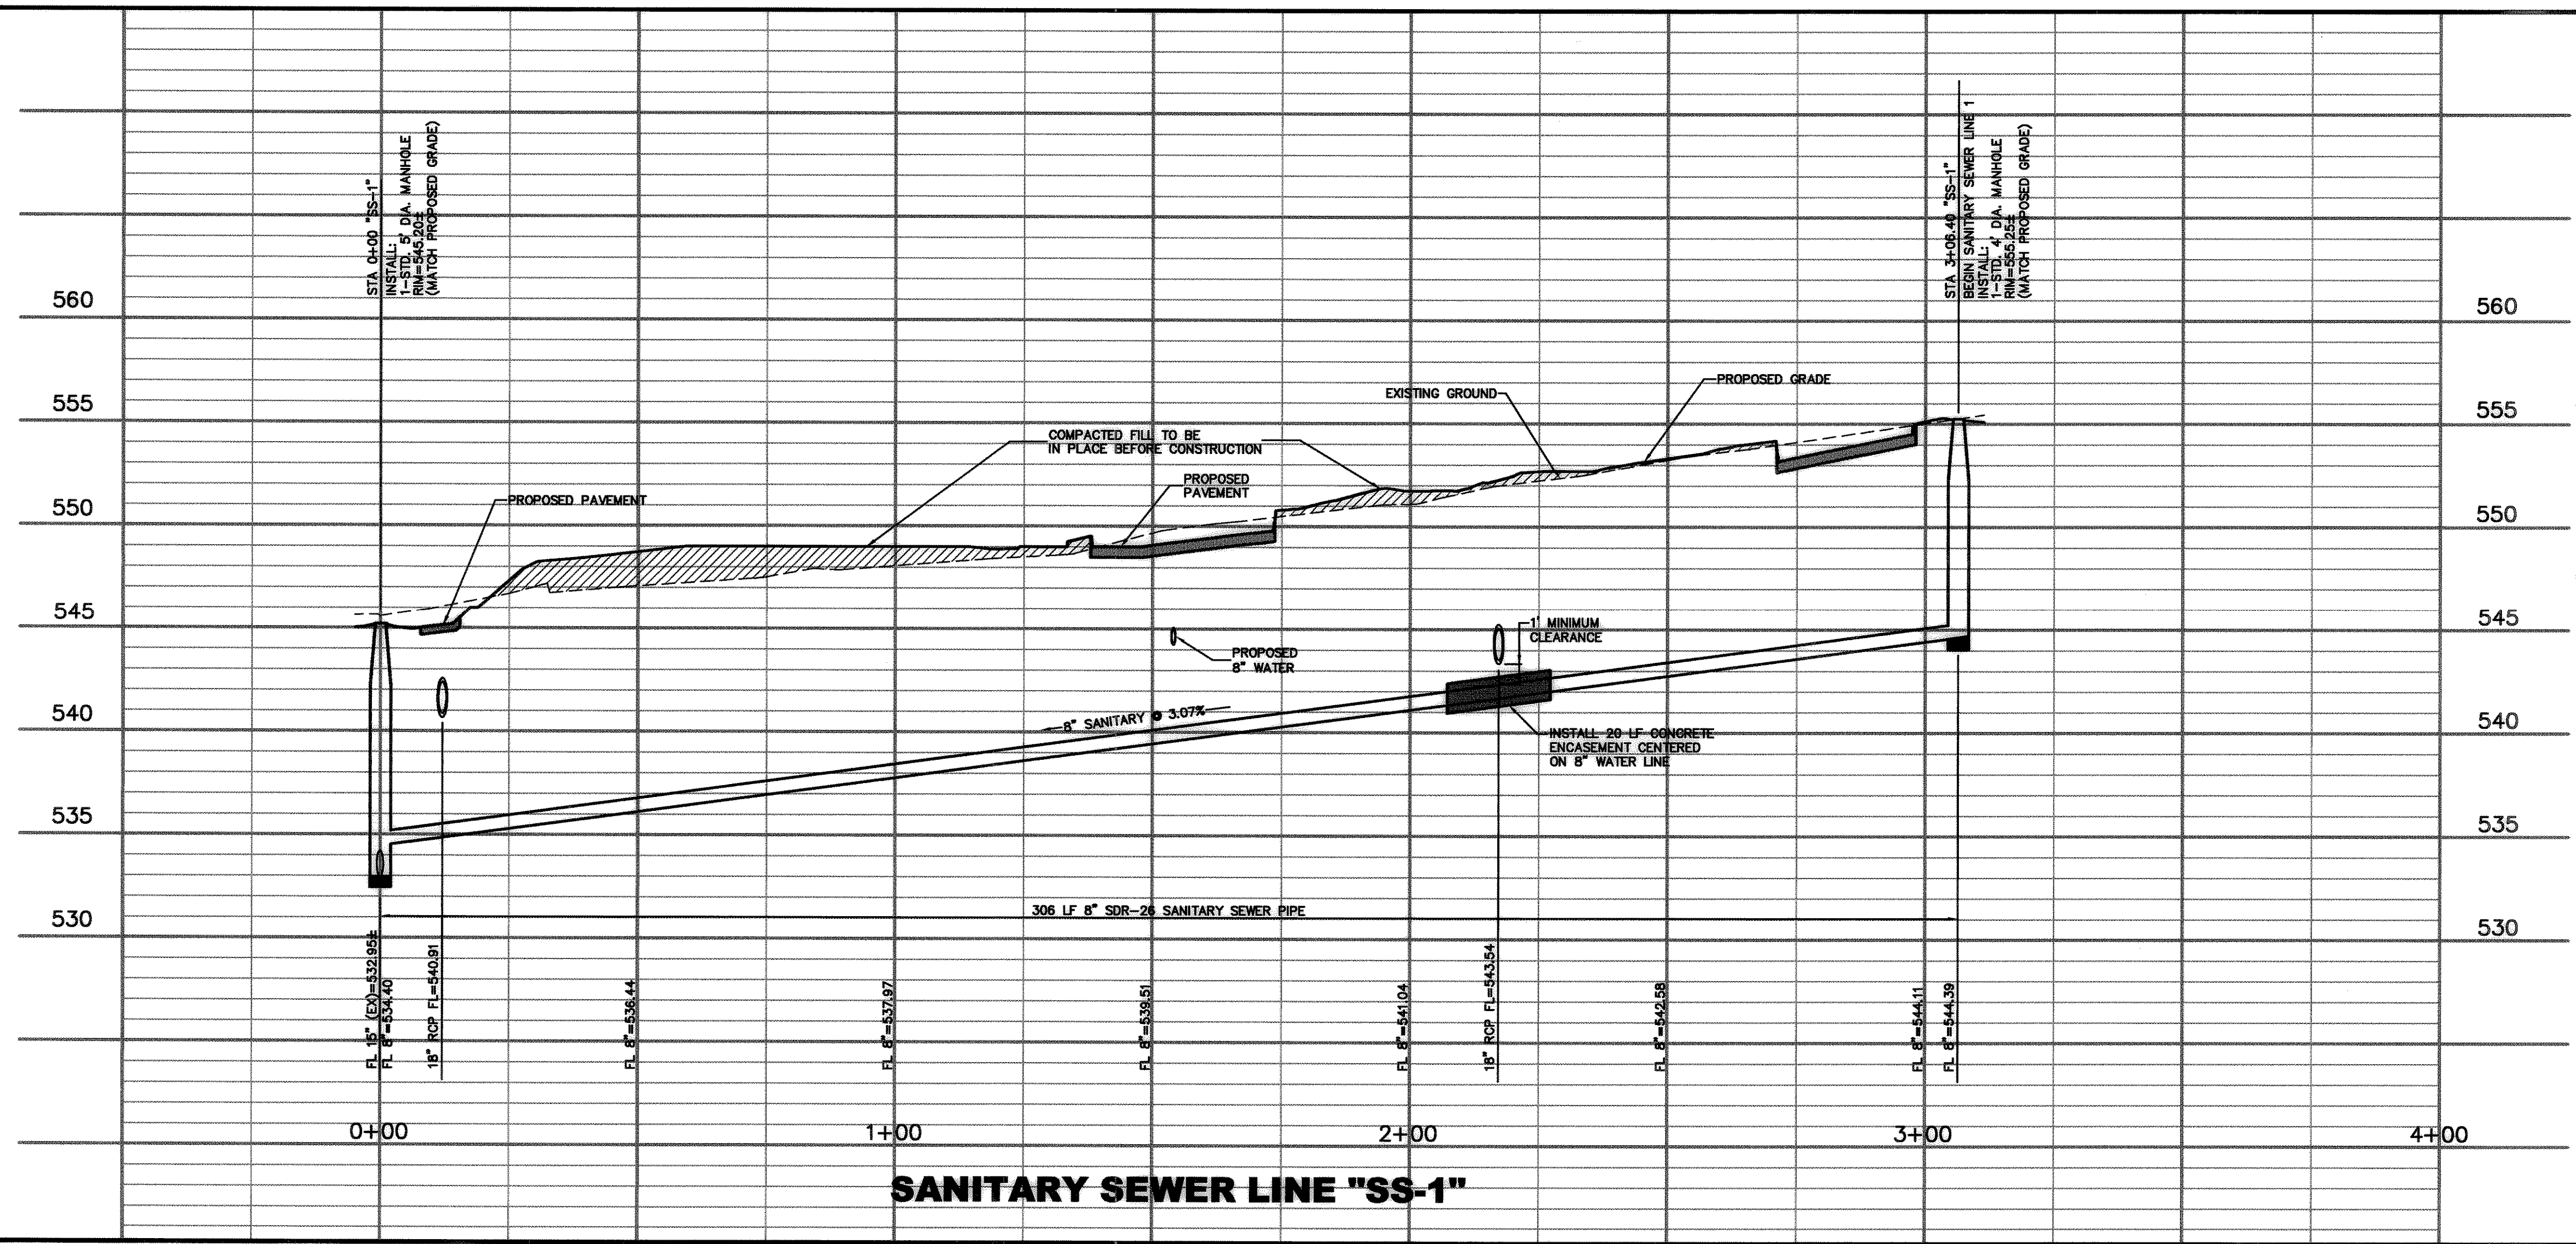

NO.	DATE	REVISION
1	09/28/04	RECORD DRAWINGS
Pacheco Koch Consulting Engineers		
8350 N CENTRAL EXPWY SUITE 1000 DALLAS, TEXAS 75206 972.235.3031		
SANITARY SEWER PLAN & PROFILE		
ROCKWALL CAPITAL ADVISORS		
SWC ARISTA & RALPH HALL		
LEGAL DESCRIPTION OR ADDRESS		
CITY OF ROCKWALL, TEXAS		
DESIGN	DRAWN	DATE
CJE	FJM	NOV, 2003
SCALE	NOTES	FILE
1"=20'		
		NO.
		C4.2

BTHAYER 10/18/2004 - 5:02AM M:\DWG-15\1567-03-193C\DWG