


CONSTRUCTION PLANS

FOR

NTB - ROCKWALL

0.943 ACRES, LOT 5, BLOCK 1
HORIZON VILLAGE ADDITION
IN THE
JAMES SMITH SURVEY, ABST. NO. 200
CITY OF ROCKWALL,
ROCKWALL COUNTY, TEXAS

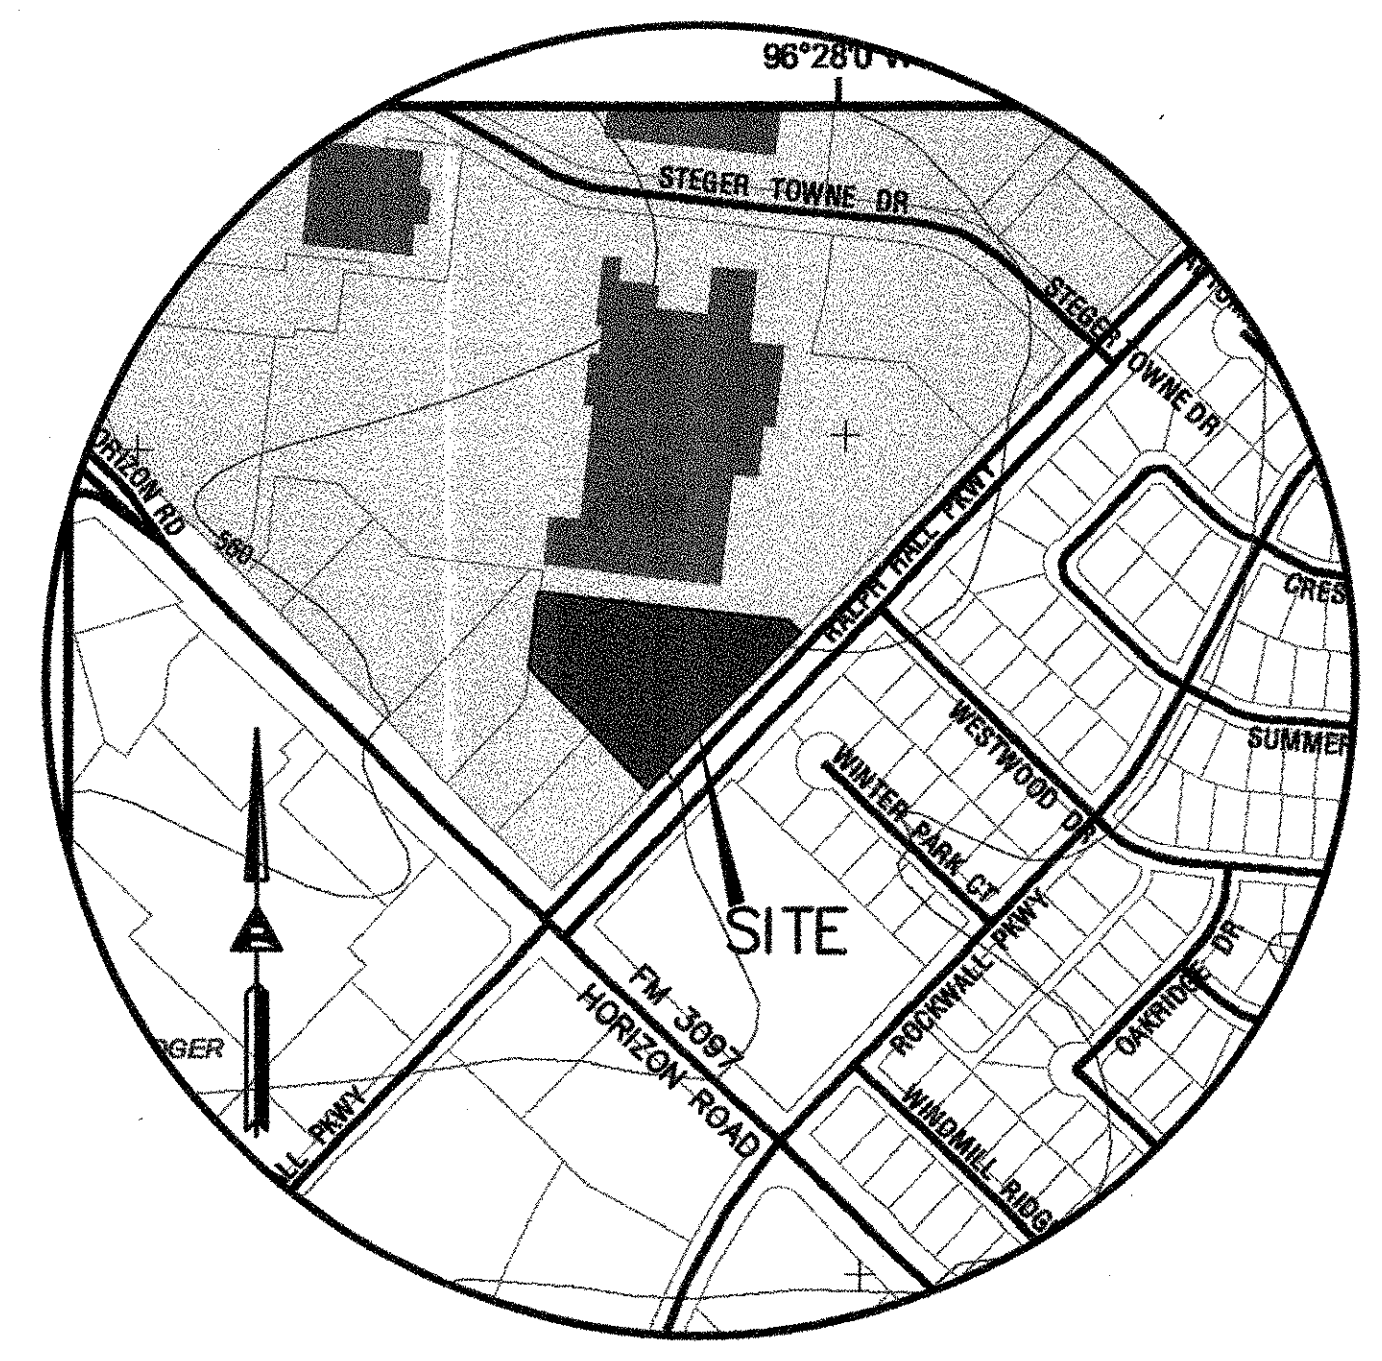

LOCATION MAP
Not To Scale

INDEX OF SHEETS


SHEET NO.	DESCRIPTION
	COVER SHEET
	REPLAT PG 1 OF 2
	REPLAT PG 2 OF 2
1-1	SITE PLAN
1-1	RETAINING WALL DESIGN
C-1	GENERAL NOTES
C-2	DIMENSION CONTROL & PAVING PLAN
C-3	GRADING & DRAINAGE PLAN
C-4	UTILITY PLAN
C-5	SANITARY SEWER PROFILE
C-6	DRAINAGE AREA MAP
C-7	EXISTING DRAINAGE AREA MAP FROM STEGER TOWNE CROSSING PH. 2
C-8	STORM SEWER PLAN
C-9	EROSION CONTROL PLAN
C-10	TxDOT TYPE 2 CURB INLET - CI (2)-08 (FW) SHEET 1 OF 2
C-11	TxDOT TYPE 2 CURB INLET - CI (2)-08 (FW) SHEET 2 OF 2
LP-1	LANDSCAPE PLAN
LP-2	IRRIGATION PLAN
S-1	TYPICAL WALL DETAIL & GENERAL NOTES


PREPARED FOR:
PAVILION DEVELOPMENT CO.
 5805 CARNEGIE BLVD., SUITE 110
 CHARLOTTE, NC 28209
 Tel.: (704) 557-9267
 Fax.: (704) 552-1159

PREPARED BY:

Allen & Ridinger
 Consulting, Inc.
 285 W. Southwest Pkwy.
 Lewisville, Texas 75067
 Tel. No. (972) 353-8000
 Fax No. (972) 353-8011

SEPTEMBER 2009

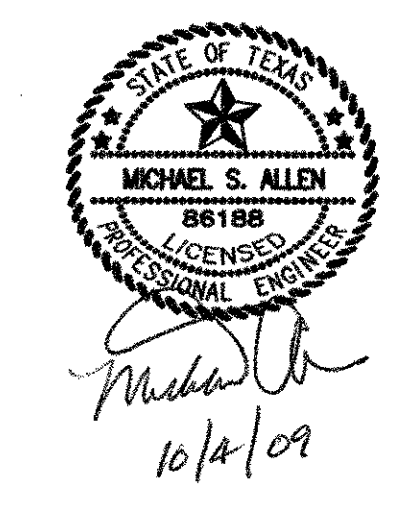

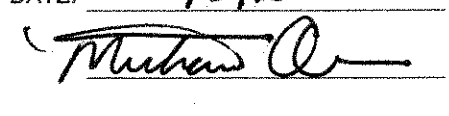RECORD DRAWING
TO THE BEST OF OUR KNOWLEDGE ALLEN & RIDINGER, HEREBY STATES THAT THIS PLAN IS AS-BUILT. THE INFORMATION PROVIDED IS BASED ON SURVEYING CONDUCTED AT THE SITE AND INFORMATION PROVIDED BY THE CONTRACTOR.
 DATE: 5/3/10


APPROVED FOR CONSTRUCTION
 DEC 9 2009
 City of Rockwall Engineering Dept.
 City Engineer: 