

RECORD DRAWING
 TO THE BEST OF OUR KNOWLEDGE ALLEN & RIDINGER, HEREBY STATES THAT THIS PLAN IS AS-BUILT. THE INFORMATION PROVIDED IS BASED ON SURVEYING CONDUCTED AT THE SITE AND INFORMATION PROVIDED BY THE CONTRACTOR.
 DATE: 5/3/10
 [Signature]

OWNER
 FLEMING INVESTMENT, INC.
 CONTACT: SCOTT FLEMING
 1500 McDONALD RD
 ROCKWALL, TX 75087
 PHONE: (972) 771-1208


ENGINEER
 ALLEN & RIDINGER CONSULTING, INC.
 CONTACT: MICHAEL S. ALLEN, PE
 285 W. SOUTHWEST PARKWAY
 LEWISVILLE, TX 75067
 PHONE: (972) 353-8000
 FAX: (972) 353-8011
 EMAIL: MALLEN@ALLEN-RIDINGER.COM

DEVELOPER
 PAVILION DEVELOPMENT CO.
 CONTACT: WESLEY WALLS
 5605 CARNEGIE BLVD., SUITE 110
 CHARLOTTE, NC 28209
 PHONE: (704) 557-9267
 FAX: (704) 552-1159
 EMAIL: WESLEY.WALLS@PAVILIONDEVELOPMENT.COM

APPROVED FOR CONSTRUCTION
 DEC 9 2009
 [Signature]
 City of Rockwall Engineering Dept.
 City Engineer

NATIONAL TIRE & BATTERY
W. RALPH HALL PKWY.
 Lot 5, Block 1
 0.943 Acres
 Horizon Village Addition
 City of Rockwall
 Rockwall County, Texas

No.	Date	Revisions	App.

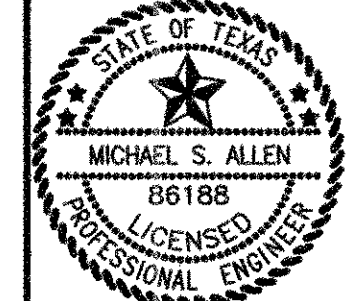

[Signature]
 10/14/10

NATIONAL TIRE & BATTERY (NTB)
W. RALPH HALL PKWY.
 CITY OF ROCKWALL, TEXAS

SANITARY SEWER PROFILE

Scale: HOR: 1"=20', VERT: 1"=2'
 Designed by: MSA
 Drawn by: JDL
 Checked by: MSA
 Date: SEPTEMBER 30, 2009
 Project No. 082-010

SHEET
C-5
 OF 11

Allen & Ridinger Consulting, Inc.
 Firm No. 1969
 285 W. Southwest Parkway
 Lewisville, Texas 75067
 Tel. No. (972) 353-8000
 Fax No. (972) 353-8011