

NOTE:
 IN ORDER TO COMPLY WITH THE UNITED STATES ENVIRONMENTAL PROTECTION AGENCY AND ALL OTHER AGENCIES HAVING JURISDICTION, THE CONTRACTOR SHALL PROVIDE ANY ADDITIONAL EROSION OR POLLUTION DEVICES, AS REQUIRED, DURING CONSTRUCTION. FILING OF N.O.I. (PER TCEQ REQUIREMENTS) SHALL BE THE RESPONSIBILITY OF THE CONTRACTOR.

RECORD DRAWING
 TO THE BEST OF OUR KNOWLEDGE ALLEN & RIDINGER, HEREBY STATES THAT THIS PLAN IS AS-BUILT. THE INFORMATION PROVIDED IS BASED ON SURVEYING CONDUCTED AT THE SITE AND INFORMATION PROVIDED BY THE CONTRACTOR.
 DATE: 5/3/10
Michael S. Allen

- STANDARD EROSION CONTROL GENERAL NOTES**
1. EROSION CONTROL DEVICES AS SHOWN ON THE EROSION CONTROL PLAN FOR THE PROJECT SHALL BE INSTALLED PRIOR TO THE START OF LAND DISTURBING ACTIVITIES ON THE PROJECT.
 2. ALL EROSION CONTROL DEVICES ARE TO BE INSTALLED IN ACCORDANCE WITH THE APPROVED PLANS AND SPECIFICATIONS FOR THE PROJECT. CHANGES ARE TO BE APPROVED BEFORE CONSTRUCTION BY THE DESIGN ENGINEER AND THE TOWN OF FLOWER MOUND ENGINEERING DIVISION.
 3. IF THE EROSION CONTROL PLAN AS APPROVED CANNOT CONTROL EROSION AND OFF-SITE SEDIMENTATION FROM THE PROJECT THE EROSION CONTROL PLAN WILL BE REQUIRED TO BE REVISED AND/OR ADDITIONAL EROSION CONTROL DEVICES WILL BE REQUIRED ON SITE.
 4. IF OFF-SITE BORROW OR SPOILS SITES ARE USED IN CONJUNCTION WITH THIS PROJECT, THIS INFORMATION SHALL BE DISCLOSED AND SHOWN ON THE EROSION CONTROL PLAN. OFF-SITE BORROW AND SPOILS AREAS ARE CONSIDERED PART OF THE PROJECT SITE AND THEREFORE SHALL COMPLY WITH THE TOWN OF FLOWER MOUND EROSION CONTROL REQUIREMENTS. THESE AREAS SHALL BE STABILIZED WITH GROUND COVER PRIOR TO FINAL APPROVAL OF THE PROJECT.
 5. 75%-80% GRASS COVERAGE REQUIRED OF ALL DISTURBED AREAS PRIOR TO ENGINEERING ACCEPTANCE OF PROJECT.

OWNER:
 FLEMING INVESTMENT, INC.
 CONTACT: SCOTT FLEMING
 1500 McDONALD RD
 ROCKWALL, TX 75032
 PHONE: (972) 771-1208

ENGINEER:
 ALLEN & RIDINGER CONSULTING, INC.
 CONTACT: MICHAEL S. ALLEN, PE
 285 W. SOUTHWEST PARKWAY
 LEWISVILLE, TX 75067
 PHONE: (972) 353-8000
 FAX: (972) 353-8011
 EMAIL: MALLEN@ALLEN-RIDINGER.COM

DEVELOPER:
 PAVILION DEVELOPMENT CO.
 CONTACT: WESLEY WALLS
 5605 CARNEGIE BLVD., SUITE 110
 CHARLOTTE, NC 28209
 PHONE: (704) 557-9267
 FAX: (704) 552-1159
 EMAIL: WESLEY.WALLS@PAVILIONDEVELOPMENT.COM


REVISION
 DEC 14 2009
 CITY OF ROCKWALL ENGINEERING DEPT.

NATIONAL TIRE & BATTERY
W. RALPH HALL PKWY.
 Lot 5, Block 1
 0.943 Acres
 Horizon Village Addition
 City of Rockwall
 Rockwall County, Texas


APPROVED FOR CONSTRUCTION
 DEC 9 2009
 City of Rockwall Engineering Dept.
 City Engineer: *Carol*

EROSION CONTROL SCHEDULE AND SEQUENCING

TASK	EROSION CONTROL MEASURES
ROUGH GRADING	ALL SILT FENCE, STONE OVERFLOW STRUCTURES & CONSTRUCTION ENTRANCE / EXIT SHALL BE INSTALLED PRIOR TO THE INITIATION OF ROUGH GRADING. CONSTRUCTION ENTRANCE AND ROCK FILTER DAMS TO BE INSTALLED AT THIS TIME.
UTILITY & STORM INSTALLATION	ALL SILT FENCE SHALL BE INSTALLED PRIOR TO THE INITIATION OF ALL UTILITY CONSTRUCTION. UPON THE COMPLETION OF STORM SEWER INSTALLATION TYPE A AND B INLET PROTECTORS TO BE INSTALLED.
PAVING	ALL PRIOR EROSION CONTROL MEASURES INSTALLED ABOVE TO BE MAINTAINED DURING PAVING AND THROUGHOUT THE REMAINDER OF THE PROJECT.
FINE GRADING	ALL PRIOR EROSION CONTROL MEASURES INSTALLED ABOVE TO BE MAINTAINED DURING FINE GRADING AND THROUGHOUT THE REMAINDER OF THE PROJECT.
FINAL	ALL EROSION CONTROL MEASURES TO BE REMOVED AT THE CONCLUSION OF THE PROJECT AS DIRECTED BY THE TOWN OF FLOWER MOUND

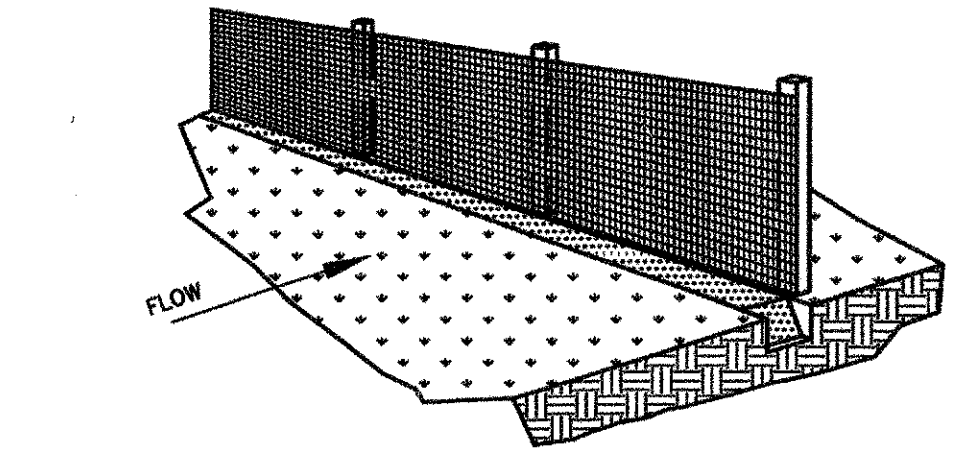

- CONSTRUCTION OF A FILTER BARRIER**
1. SYNTHETIC FILTER FABRIC SHALL BE 8 OUNCE PER SQUARE YARD FABRIC AND SHALL BE CUT FROM A CONTINUOUS ROLL TO AVOID JOINTS. 6" x 6" WIRE MESH BACKING IS REQUIRED FOR ALL SILT FENCES.
 2. SILT FENCE POSTS SHALL BE METAL WITH A MINIMUM LENGTH OF 3 FEET.
 3. SILT FENCE TIES SHALL BE OF HEAVY DUTY WIRE.
 4. METAL POSTS SHALL BE SPACED AROUND THE PERIMETER OF THE SITE A MAXIMUM OF 3 FEET APART AND SECURELY DRIVEN INTO GROUND (MINIMUM OF 18 INCHES).
 5. A TRENCH SHALL BE EXCAVATED APPROXIMATELY 4 INCHES WIDE AND 4 INCHES DEEP AROUND THE OUTSIDE PERIMETER OF THE POSTS.
 6. THE FABRIC SHALL BE TIED TO THE POSTS, AND 8 INCHES OF THE FABRIC SHALL BE EXTENDED INTO THE TRENCH. THE HEIGHT OF THE FILTER BARRIER SHALL BE A MINIMUM OF 15 INCHES AND SHALL NOT EXCEED 18 INCHES.
 7. THE TRENCH SHALL BE BACK FILLED AND THE SOIL COMPACTED OVER THE FABRIC.

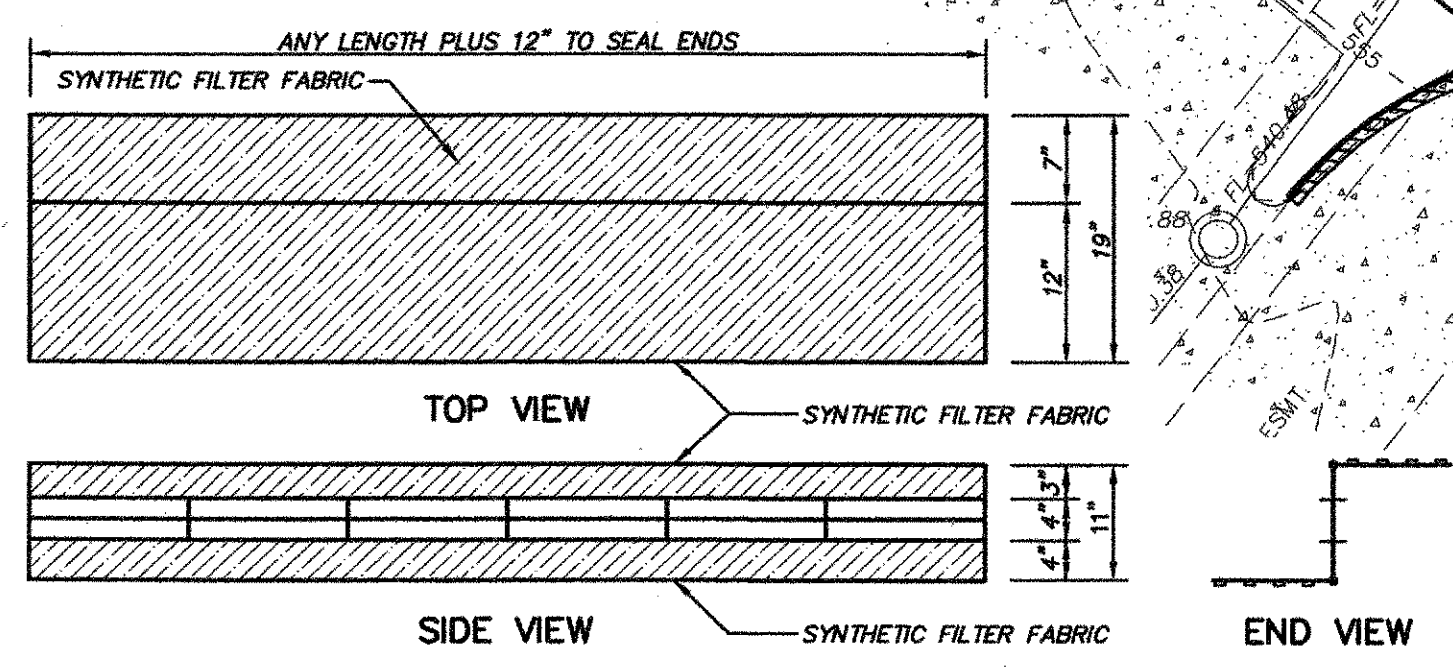

HEAVY DUTY CURB INLET PROTECTOR

CONSTRUCTION OF A FILTER BARRIER