

* TIE IN 1" TAP INTO EXISTING 8" WATER LINE AT SE. CORNER OF BUILDING

CONTROLLER W/ RAIN & FREEZE SENSOR
PROVIDE 110V POWER
COORDINATE EXACT LOCATION WITH OWNERS REP.

TEMPORARY IRRIGATION - TIE TO ~~NTB~~ IRRIGATION SYSTEM
REFER TO LANDSCAPE PLAN FOR AREA DISTURBED

~~NTB TO REPAIR AND REPLACE ANY DISTURBED PORTIONS OF THE LONE'S IRRIGATION SYSTEM RESULTING FROM THE USE OF LONE'S IRRIGATION SYSTEM FOR TEMPORARY IRRIGATION~~


RALPH HALL PARKWAY

DESIGN PRESSURE = 52 PSI

IRRIGATION EQUIPMENT LEGEND

SYMBOL	DESCRIPTION	MANUFACTURER
[C]	CONTROLLER	HUNTER ICC W/ HUNTER FREEZE AND RAIN CLIK
[■]	TURF SIDE STRIP SPRAY	HUNTER INST-04
[●]	ROTOR	HUNTER PGP/PGJ
[○]	TURF SPRAY	HUNTER INST-04
[⊕]	GATE VALVE	1 1/2" NIBCO T-13K
[⊕]	Y-STRAINER VALVE	1 1/2" WILKINS SERIES "S" STRAINER
[⊕]	REMOTE CONTROL VALVE	HUNTER ICV FOR SPRAY ZONES HUNTER IGZ-101 FOR DRIP ZONES
[X]	DOUBLE CHECK DETECTOR	1 1/2" FEBCO (FOLLOW LOCAL CODES)
[M]	WATER METER	1 1/2" METER
[▲]	QUICK COUPLER	HUNTER H33DRG
[---]	MAINLINE PIPING	SCHEDULE 40 - ALL 2"
[---]	SLEEVE PIPING	SCHEDULE 40 PVC
[---]	LATERAL PIPING	CLASS 200 (SDR 21)
[1]	STATION NUMBER	
[1"]	VALVE SIZE	
[32]	GPM (APPROX.)	
[■]	NETAFIM DRIP IRRIGATION - TECHLINE CV-06-12 3" BELOW GRADE	

No. 3	4-19-10	ADDED TEMP IRRIGATION	APP.
No. 2	9-28-08	PER CITY COMMENTS	
No. 1	9-2-09	PER CITY COMMENTS	

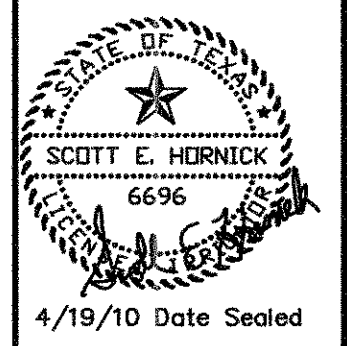

NATIONAL TIRE & BATTERY (NTB)
W. RALPH HALL PKWY.
CITY OF ROCKWALL, TEXAS

IRRIGATION PLANS

Scale: 1"=20'
Designed by: SEH
Drawn by: SEH
Checked by: SEH
Date: AUGUST 3, 2009
Project No. 082-010

Allen & Ridinger Consulting, Inc.
285 W. Southwest Pkwy
Lewisville, Texas 75067
Tel. No. (972) 353-8000
Fax No. (972) 353-8011