



1 GRASS SWALE SECTION

SCALE: NTS

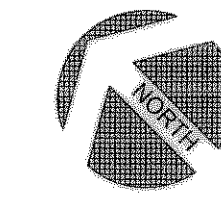

GRADING PLAN

SCALE: 1" = 20'-0"

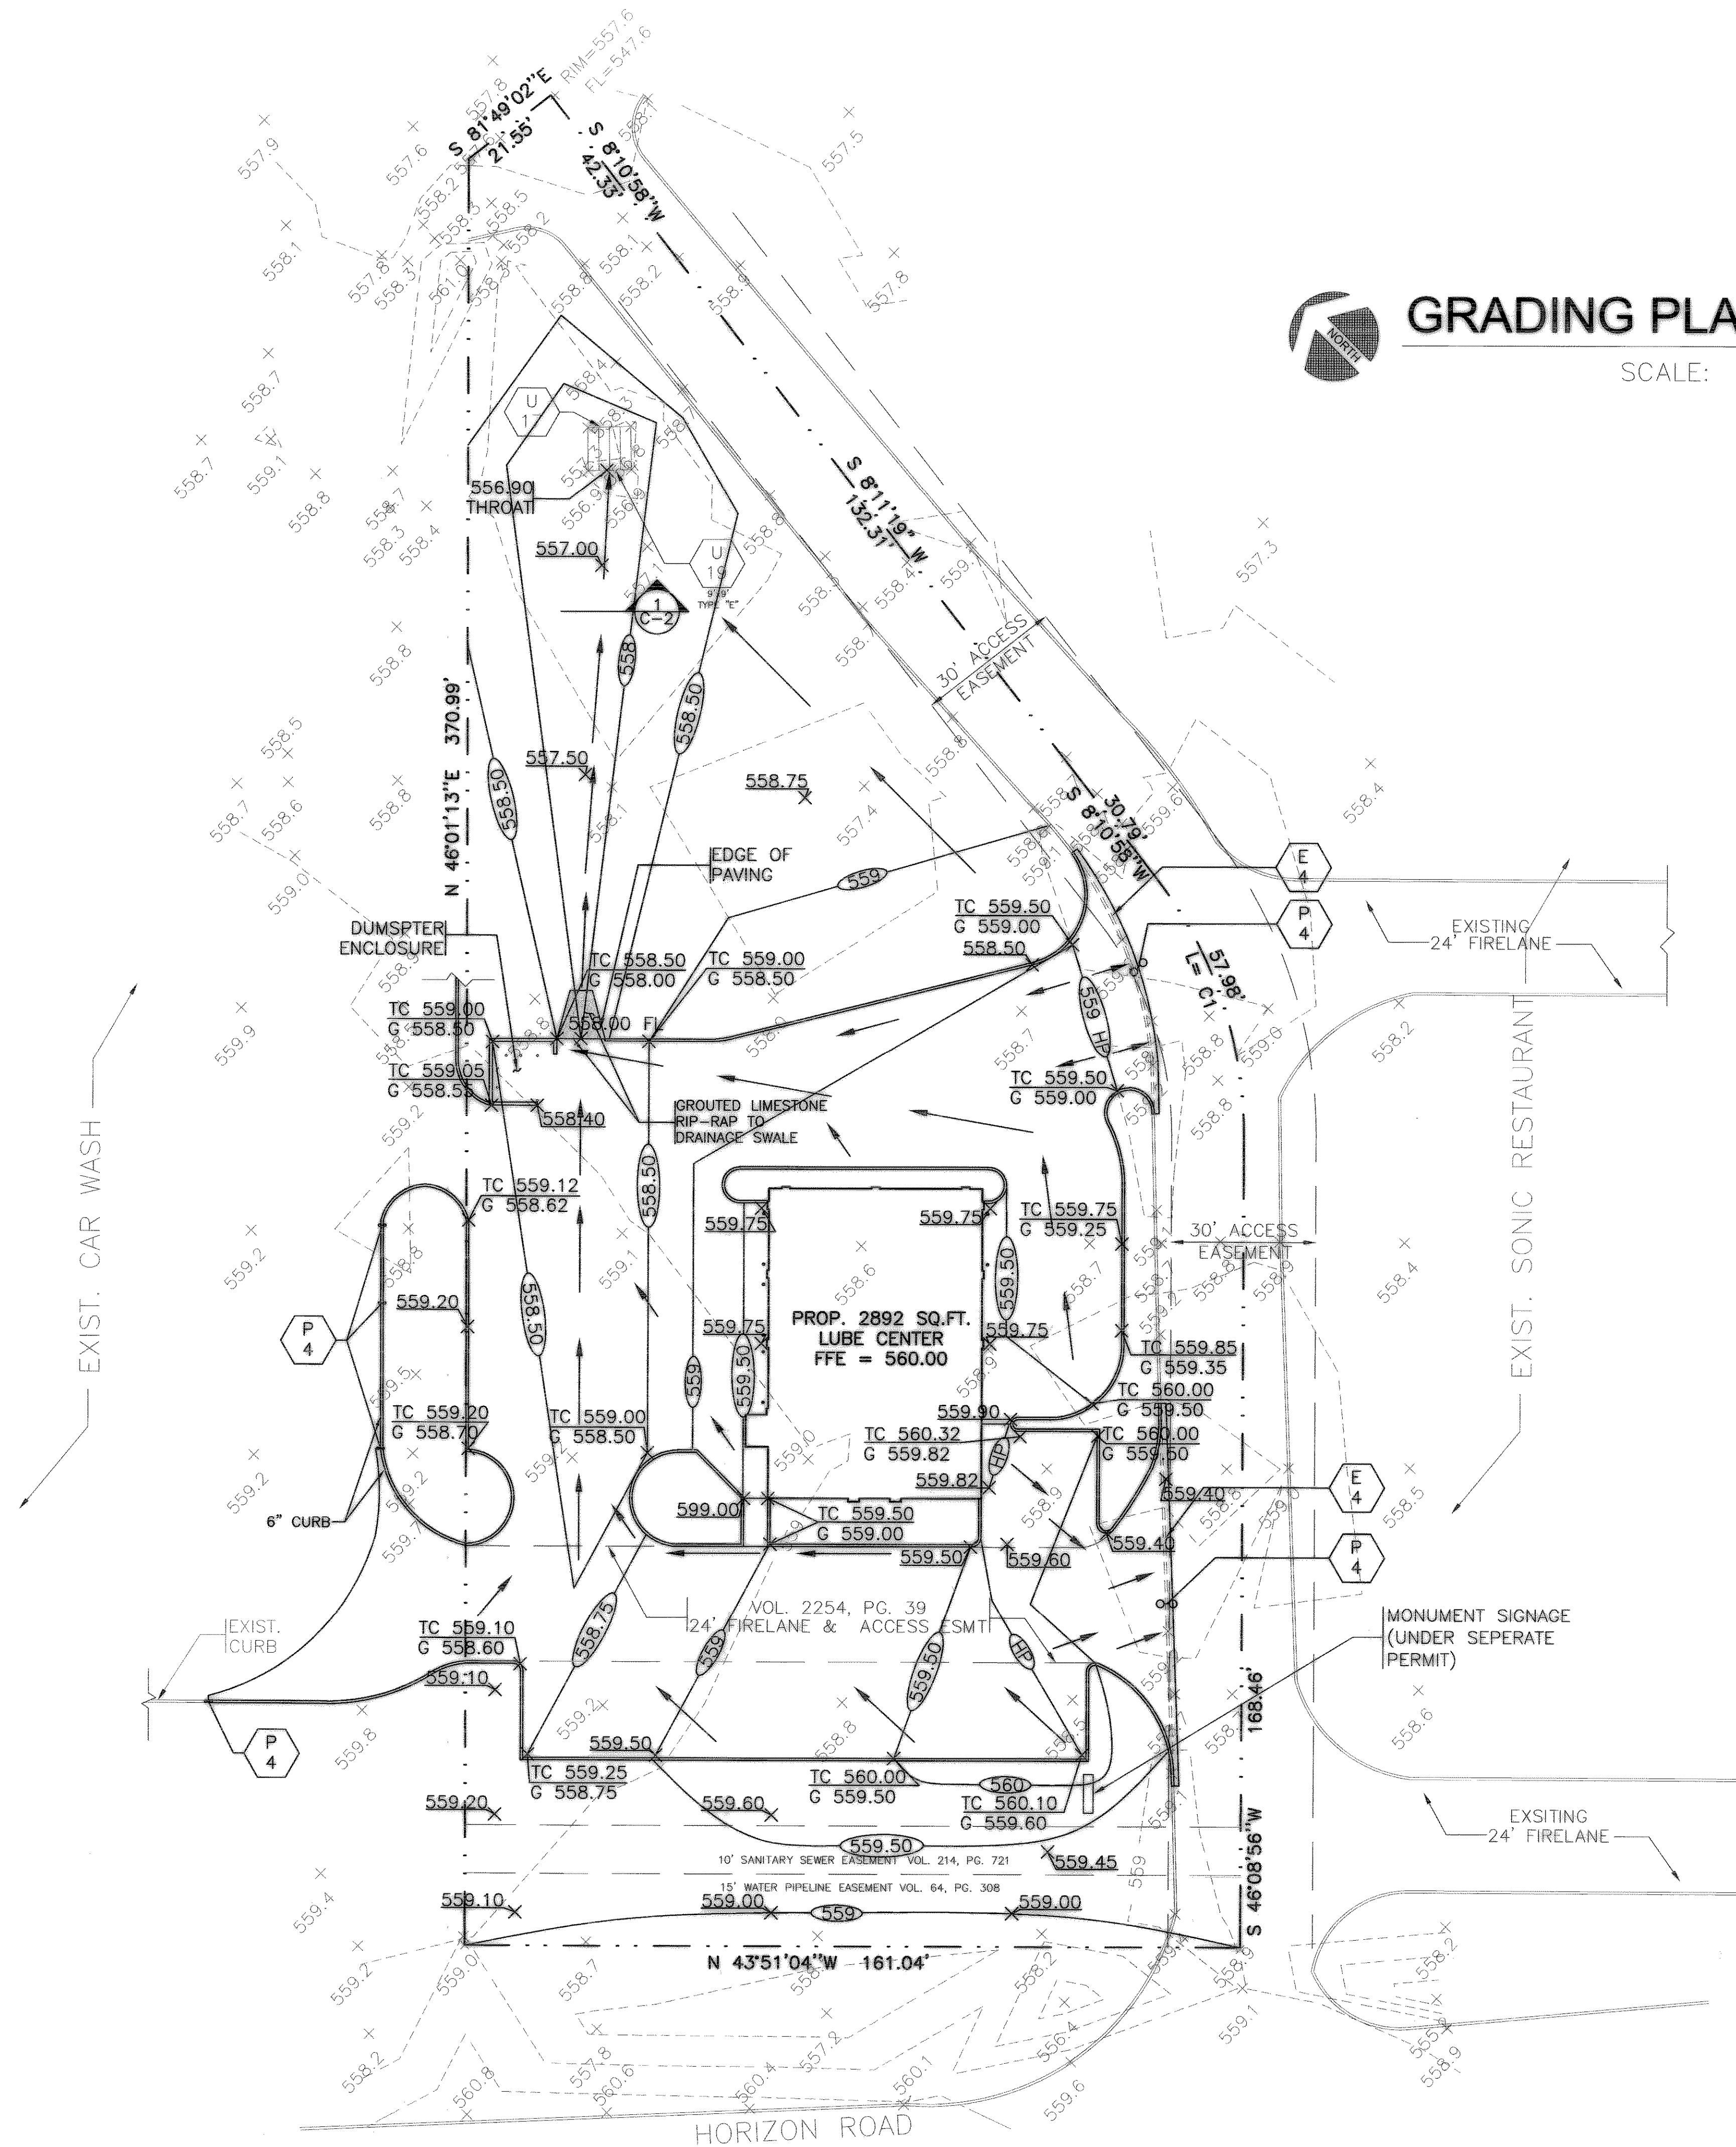

NOTE:
 TOPOGRAPHIC INFORMATION
 RECORDED BY ROCKWALL
 SURVEYING CO., INC. ON
 09/27/04.
 R.S.C. FILE NO. 20040837P2

NOTE:
 ALL FILL TO BE COMPACTED USING
 SHEEP'S FOOT ROLLER.

AS-BUILT
 01-10-06


J. Brian Campbell
 J. BRIAN CAMPBELL, P.E.

ARCHITECT:
 ANTON JACOBS ARCHITECTS, INC.
 2885 CREEK SIDE CT.
 HIGHLAND VILLAGE, TX 75077
 TEL: 1-888-326-3712

CONSTRUCTION:
 BENCHMARK CONSTRUCTION, INC.
 123A MARSHALL CREEK ROAD
 ROANOKE, TX 76262
 TEL: 817-854-0300
 FAX: 817-854-0303

Rockwall Lube Center
 FM 3907 & RALPH HALL PARKWAY
 ROCKWALL, TEXAS

g w C engineering
 4201 Spring Valley Road Ste. 1120
 Farmers Branch, TX 75244
 (tel) 469-374-0810 (fax) 469-374-0811
 (email) production@gwceengineering.com

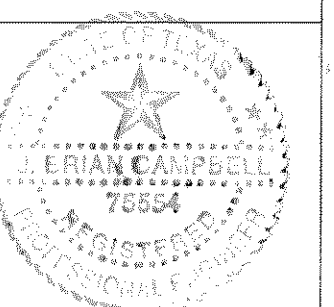

JOB NO. 50031
 DATE: JUN 2005
 DRAWN: IMH
 CHECKED: JBC
 SCALE: NOTED
 DRAWING NUMBER
C-2