


DIMENSION CONTROL PLAN

SCALE: 1" = 20'-0"

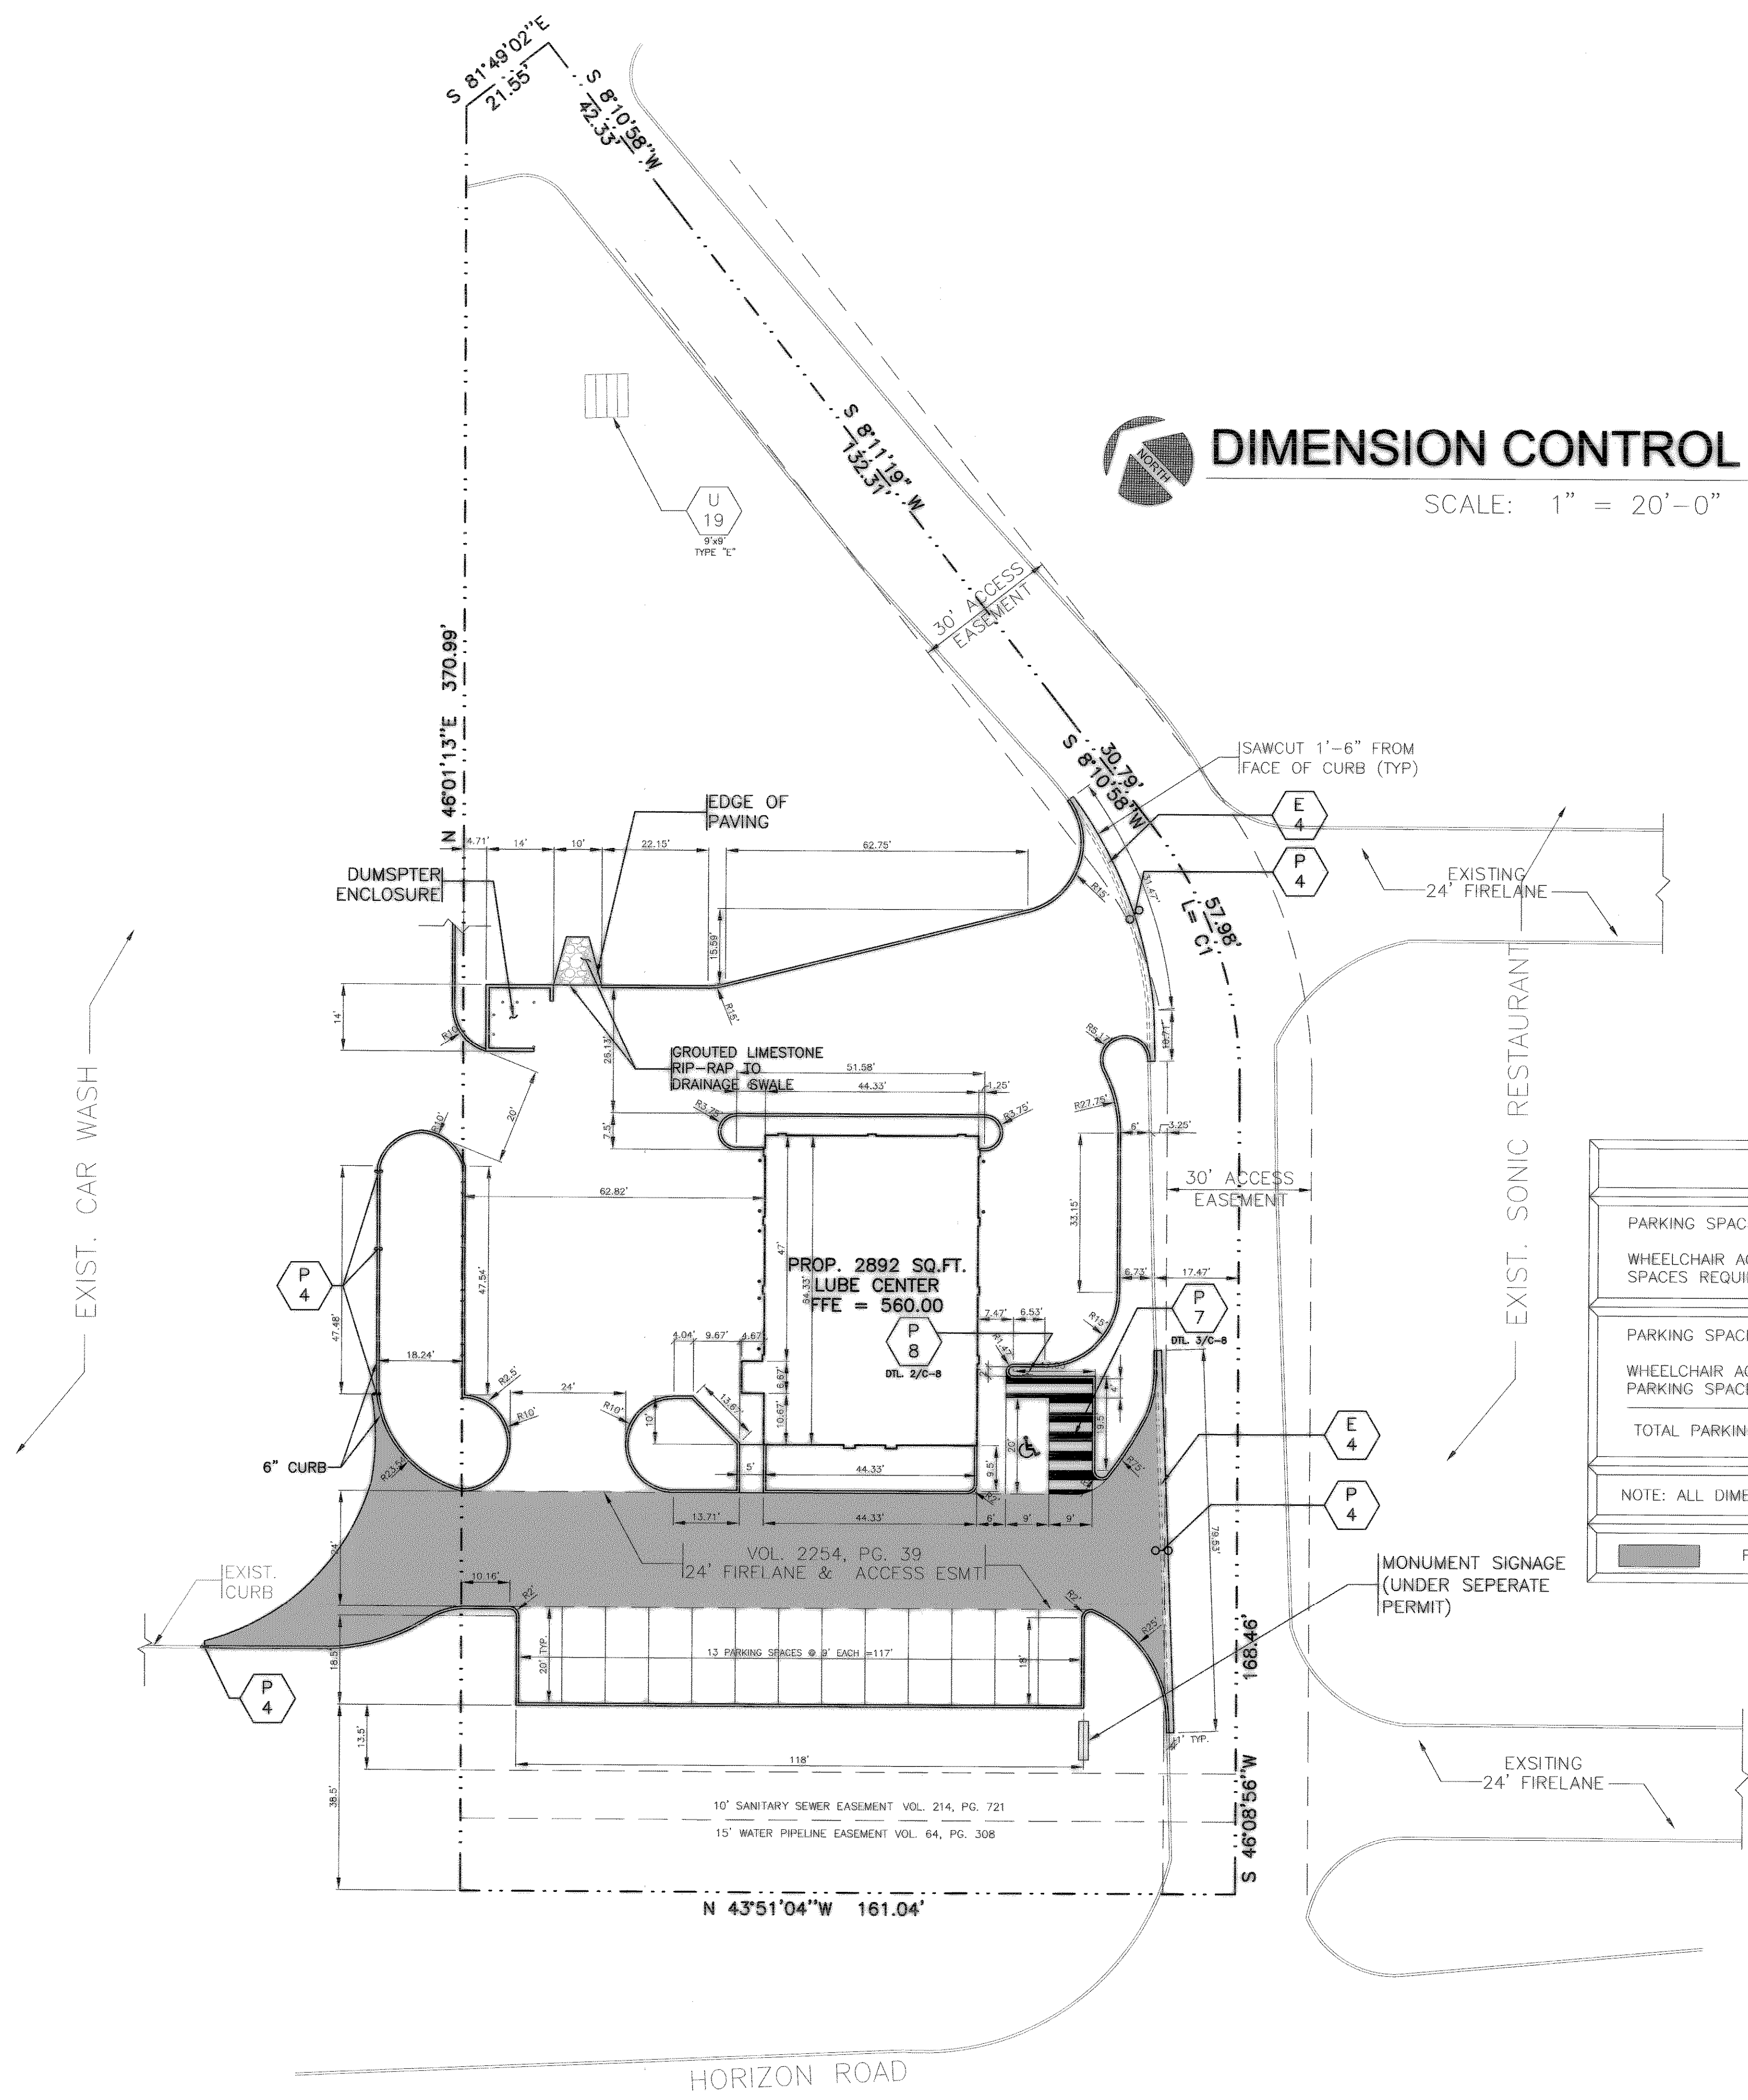

PARKING TABLE	
PARKING SPACES REQUIRED	= 13
WHEELCHAIR ACCESSIBLE SPACES REQUIRED	= 1
PARKING SPACES PROVIDED	= 13
WHEELCHAIR ACCESSIBLE PARKING SPACES PROVIDED	= 1
TOTAL PARKING SPACES PROVIDED	= 14
NOTE: ALL DIMENSIONS TO FACE OF CURBS.	
	FIRELANE

AS-BUILT
01-10-06

J. Brian Campbell
J. BRIAN CAMPBELL, P.E.

ARCHITECT:
ANTON JACOBS ARCHITECTS, INC.
2685 CREEK SIDE CT.
HIGHLAND VILLAGE, TX 75077
TEL: 1-888-326-3712

CONSTRUCTION:
BENCHMARK CONSTRUCTION, INC.
123A MARSHALL CREEK ROAD
ROANOKE, TX 76262
TEL: 817-854-0300
FAX: 817-854-0303

Rockwall Lube Center
FM 3907 & RALPH HALL PARKWAY
ROCKWALL, TEXAS

g w C engineering
4201 Spring Valley Road Ste. 1120
Farmers Branch, TX 75244
(tel) 469-374-0810 (fax) 469-374-0811
(email) production@gwceengineering.com

JOB NO. 50031
DATE: JUN 2005
DRAWN: IMH
CHECKED: JBC
SCALE: NOTED
DRAWING NUMBER
C-4