


LEGEND


- PROP. FLOW ARROW
- 667.70 EXISTING SPOT ELEVATION
- 668 EXISTING CONTOURS
- 556 PROPOSED CONTOURS
- DETENTION AREA

THE CONTRACTOR SHALL BE RESPONSIBLE FOR VERIFYING EXISTING GROUND GRADES PRIOR TO COMMENCING CONSTRUCTION AND THE DEPTH AND LOCATIONS OF AND PROTECTING ALL EXISTING SERVICE LINES, OR OTHER PROPERTY CROSSED OR EXPOSED BY HIS CONSTRUCTION OPERATIONS. WHERE EXISTING UTILITIES OR SERVICE LINES ARE CUT, BROKEN OR DAMAGED, THE CONTRACTOR SHALL REPLACE OR REPAIR THE UTILITIES OR SERVICE LINES WITH THE SAME TYPE OF ORIGINAL MATERIAL AND CONSTRUCTION, OR BETTER, UNLESS OTHERWISE SHOWN OR NOTED ON THE PLANS, AT HIS OWN COST AND EXPENSE. THE CONTRACTOR SHALL IMMEDIATELY NOTIFY THE OWNER OF THE DAMAGED UTILITY OR SERVICE LINE. HE SHALL COOPERATE WITH THE OWNERS OF ALL UTILITIES TO LOCATE EXISTING UNDERGROUND FACILITIES AND IMMEDIATELY NOTIFY THE ENGINEER AT ONCE OF ANY CONFLICTS IN GRADES AND ALIGNMENT.

- 556.87 PROPOSED SPOT ELEVATION
- 556.37 PROPOSED SPOT ELEVATION
- 560 EXISTING CONTOUR

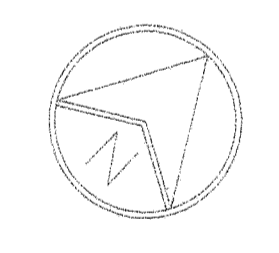

SCALE 1" = 20'

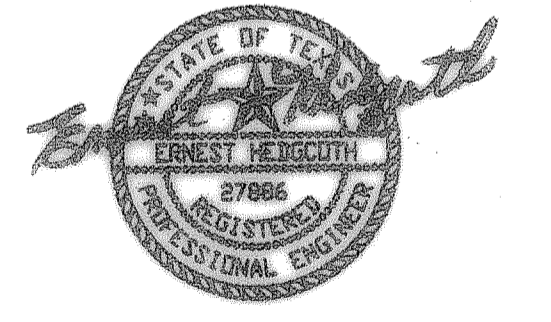

The seal appearing in this document was authorized by ERNEST HEDGCOTT, P.E. #27886
DATE 2/1/04

SONIC RESTAURANT
 LOT 1, BLOCK 1,
 HORIZON VILLAGE ADDITION
 CITY OF ROCKWALL

OWNER/DEVELOPER
 FLEMING INVESTMENTS INC
 1500 McDONALD ROAD, ROCKWALL, TEXAS 75032
 TEL: 214 236 4546 CONTACT: DALE FLEMING

GRADING PLAN

ERNEST HEDGCOTT
 CONSULTING ENGINEERS, INC.
 8701-C MIDWAY ROAD, FORT WORTH, TX 76117
 TEL: 617 831 7711, FAX: 817-831-6708

Job No 2003-067 Design: VKM
 Date: 2/03/04 Draft: VKM
 Scale: Review: EH

SHEET OF

HORIZON ADDITION - 2003-067-Plan