


CONSTRUCTION PLANS
FOR
WATER, SANITARY SEWER, & PAVING
TO SERVE
HOUSER ADDITION
ROCKWALL COUNTY, TEXAS

OWNER/DEVELOPER

GERALD HOUSER
1108 ASPEN COURT
ROCKWALL, TX 75087
(214) 558-1577

NOTE: CONTRACTOR TO FIELD VERIFY THE LOCATIONS OF ALL EXISTING UTILITIES PRIOR TO CONSTRUCTION. INFORMATION PROVIDED WITHIN THESE PLANS DOES NOT RELIEVE THE CONTRACTOR OF THE FULL AND TOTAL RESPONSIBILITY FOR THE PROTECTION OF EXISTING UTILITIES NOR ANY DAMAGES CAUSED BY SAID CONTRACTOR DURING CONSTRUCTION

NOTE: ALL PAVING, WATER, GRADING, SANITARY SEWER AND STORM SEWER FOR THIS PROJECT SHALL BE BUILT TO NCTCOG STANDARDS 3rd EDITION, AND CITY OF ROCKWALL STANDARDS.

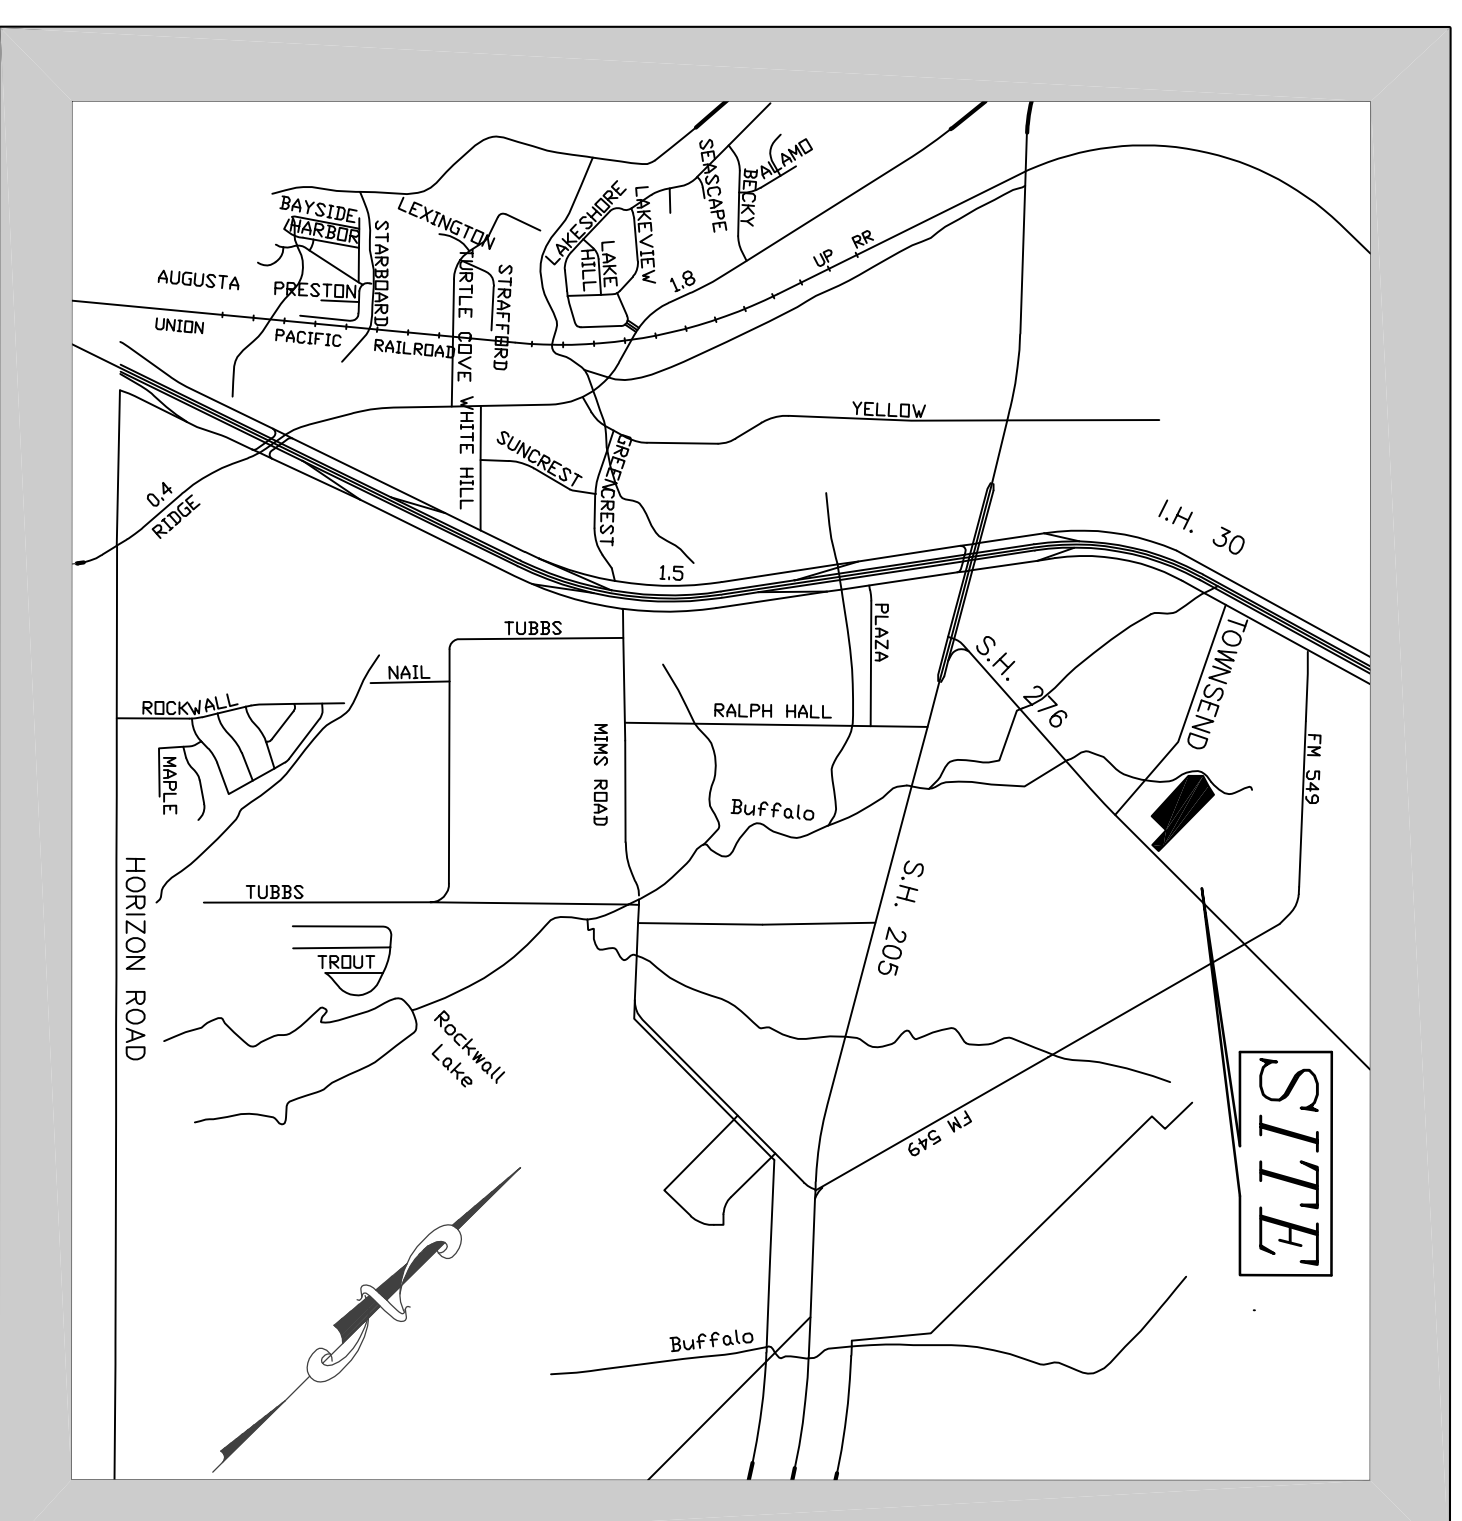

VICINITY MAP
N.T.S.

SHEET INDEX

- COVER SHEET
1 SITE & UTILITY PLAN
2 PLAN & PROFILE ~ SANITARY LINE "A"
3 EROSION CONTROL PLAN
4 EROSION CONTROL DETAILS

RECORD DRAWING

THIS DRAWING HAS BEEN REVIEWED TO REFLECT THE RECORD DRAWING. ANY CHANGES TO THIS DRAWING SHALL BE MADE BY THE CONTRACTOR FOR THIS PROJECT.
CONTRACTOR = WIL. DOUPHRATE
DATE REVIEWED = 03-24-09

DOUPHRATE
& ASSOCIATES, INC.
ENGINEERING • PROJECT MANAGEMENT • SURVEYING

2235 RIDGE ROAD, SUITE 200 ROCKWALL, TEXAS 75087
PHONE: (972)771-9004 FAX: (972)771-9005

THE SEAL APPEARING ON THIS DOCUMENT WAS AUTHORIZED BY WIL. DOUPHRATE II TEXAS P.E. NO. 60102 ON 9/24/2009
FRM NO. 886



DATE: OCTOBER 2008