


CAMBRIDGE PROPERTIES  
ZONING: PLANNED DEVELOPMENT

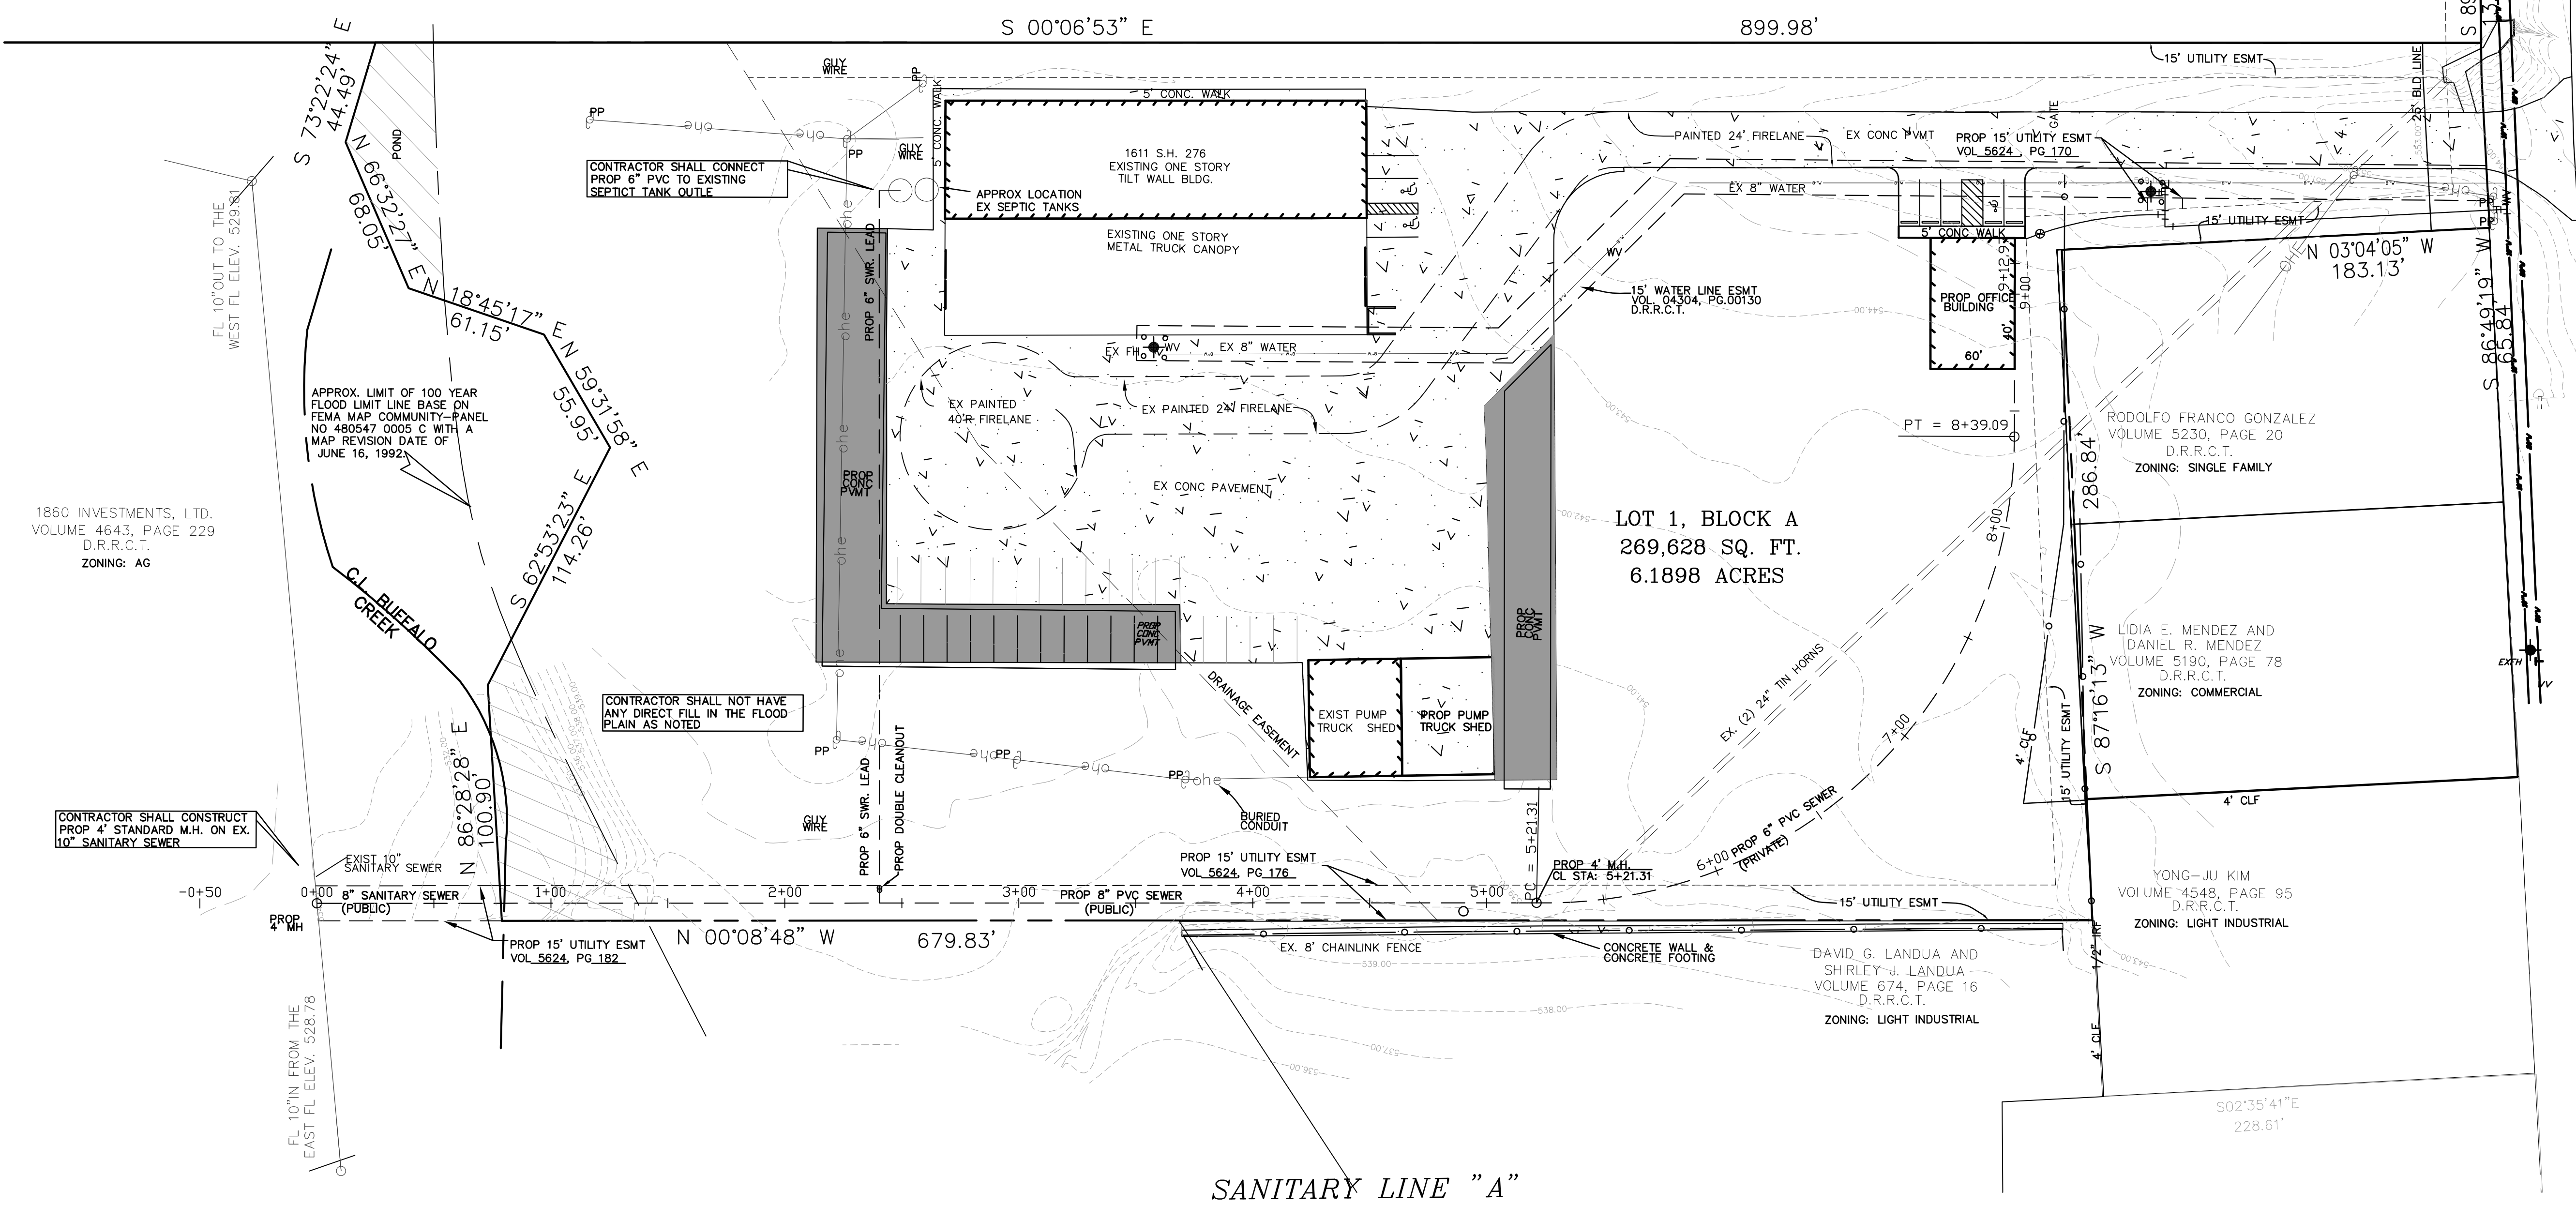

1860 INVESTMENTS, LTD.  
VOLUME 4643, PAGE 229  
D.R.R.C.T.  
ZONING: AG


APPROX. LIMIT OF 100 YEAR FLOOD LIMIT LINE BASE ON FEMA MAP COMMUNITY-PANEL NO 480547 0005 C WITH A MAP REVISION DATE OF JUNE 16, 1992

CONTRACTOR SHALL CONNECT PROP 6" PVC TO EXISTING SEPTIC TANK OUTLET

CONTRACTOR SHALL NOT HAVE ANY DIRECT FILL IN THE FLOOD PLAIN AS NOTED

CONTRACTOR SHALL CONSTRUCT PROP 4" STANDARD M.H. ON EX. 10" SANITARY SEWER


RECORD DRAWING  
THIS DRAWING HAS BEEN REVISED TO REFLECT CONSTRUCTION RECORDS MAINTAINED AND PROVIDED BY THE CONTRACTOR FOR THIS PROJECT.  
CONTRACTOR = WILL MORROW  
DATE REVISED = 9-24-09

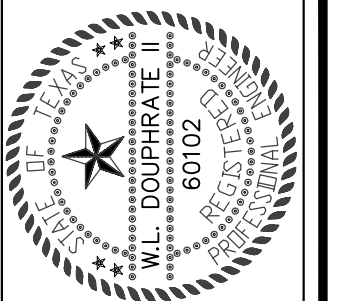

THE SEAL APPEARING ON THIS DOCUMENT WAS AUTHORIZED BY WILL DOUPHRATE II TEXAS P.E. NO. 60102 ON 9/24/2009 FIRM NO. 886

DOUPHRATE & ASSOCIATES, INC.  
ENGINEERING - PROJECT MANAGEMENT - SURVEYING  
22345 RIDGE RD., # 200 ROCKWALL, TEXAS 75087  
PHONE: (972)771-9004 FAX: (972)771-9005

PLAN & PROFILE - SANITARY LINE "A"  
(STA. 0+00 TO STA. 8+62.97)  
HOUSER ADDITION  
CITY OF ROCKWALL, ROCKWALL COUNTY, TEXAS

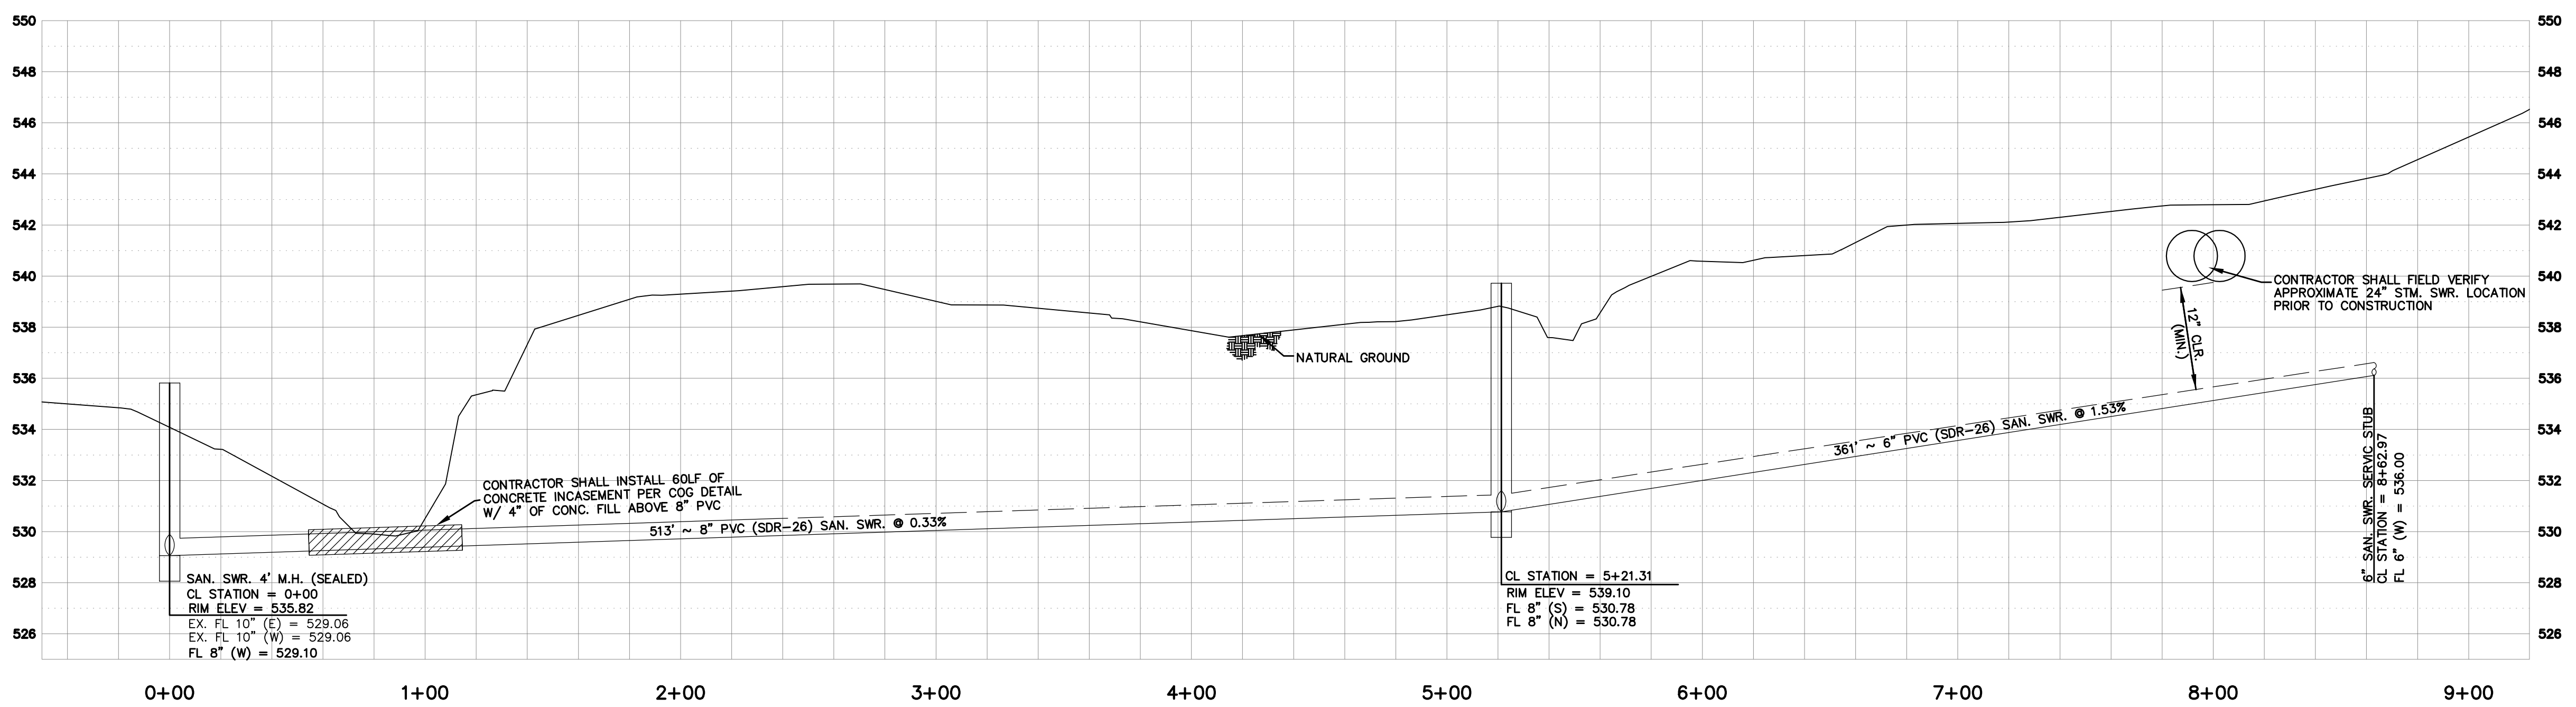

REVISION	
CHECKED	W.L.D.
DRAWN	K.E.B.
DATE	10/08
PROJECT	0812-PP01