

# PAVING, GRADING, DRAINAGE & UTILITIES


FOR

## HYATT PLACE

LOT 18, BLOCK A  
LA JOLLA POINTE ADDITION  
CITY OF ROCKWALL,  
ROCKWALL COUNTY, TEXAS

**DEVELOPER:**

ROCKWALL INN KEEPERS I, LTD.  
6176 FM 2011  
LONGVIEW, TEXAS 75603  
TELE: 214-455-5254  
CONTACT: DEEPAK GANDHI

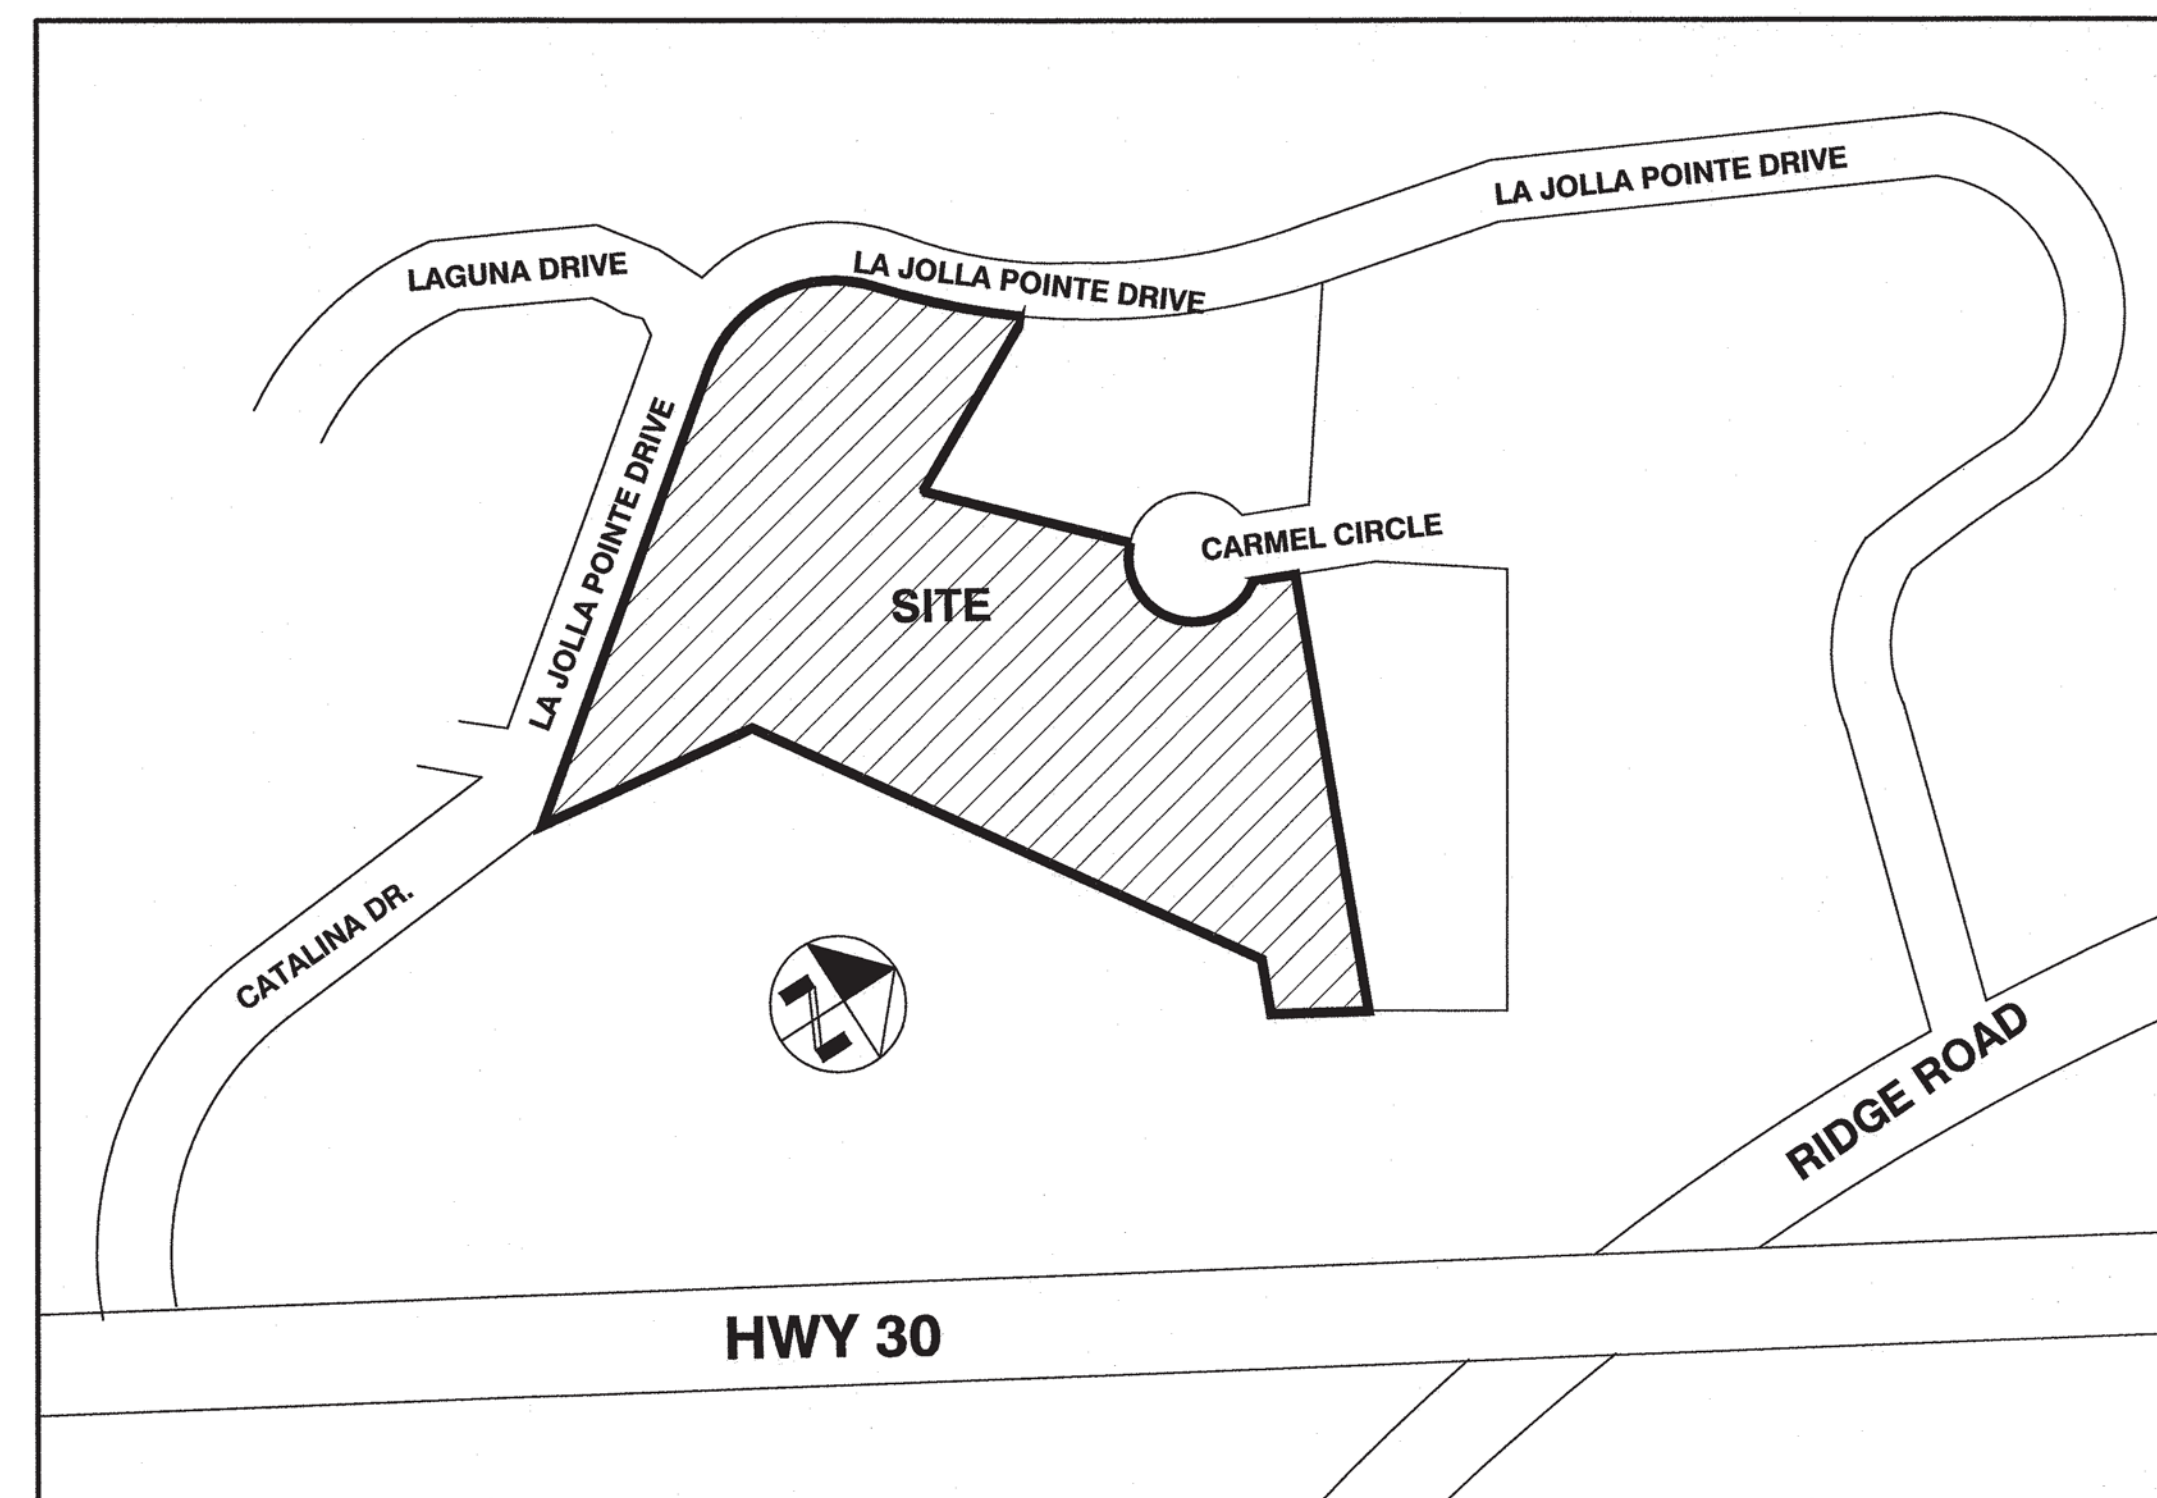

LOCATION MAP  
N.T.S.


**RECORD DRAWING**

TO THE BEST OF OUR KNOWLEDGE THE IMPROVEMENTS SHOWN ON THIS PLAN WERE COMPLETED IN GENERAL CONFORMANCE WITH THE DESIGN PLANS. THIS DETERMINATION WAS MADE BASED ON POST-CONSTRUCTION SURVEY DATA AND INFORMATION PROVIDED BY THE CONTRACTOR

Juan J. Vasquez, P.E. 09/04/2020  
SIGNED DATE

VASQUEZ ENGINEERING, LLC  
TEXAS REG. F-12266

THE SEAL APPEARING ON THIS DOCUMENT WAS AUTHORIZED BY JUAN J. VASQUEZ, P.E. 85852, ON 09/04/2020

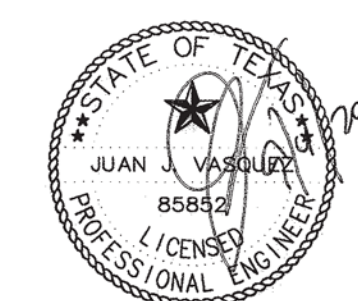

**SHEET INDEX**

- COVER
- FINAL PLAT
- SP1 SITE PLAN
- L1.1 TREE PRESERVATION PLAN
- L1.2 TREE PRESERVATION NOTES
- L1.3 LANDSCAPE PLAN
- L1.4 LANDSCAPE NOTES
- L1.5 LANDSCAPE SPECIFICATIONS AND DETAILS
- C1 DIMENSIONAL CONTROL PLAN
- C2 PAVING PLAN
- C3.1 GRADING PLAN
- C3.2 GRADING PLAN
- C4.1 POST-DEVELOPED DRAINAGE AREA MAP
- C4.2 STORM SEWER CALCULATIONS
- C4.3 DETENTION CALCULATIONS
- C4.4 DETENTION CALCULATIONS
- C5.1 EROSION CONTROL PLAN
- C5.2 EROSION CONTROL DETAIL
- C6.1 STORM SEWER PLAN
- C6.2 STORM SEWER PROFILES
- C6.3 STORM SEWER PROFILES
- C6.4 STORM SEWER DETAILS
- C7.1 UTILITY PLAN
- C7.2 SANITARY SEWER PROFILE
- C7.3 SANITARY SEWER PROFILE
- C8 DETAILS & GENERAL NOTES
- TP1 TRAFFIC CONTROL PLAN

**POND & EAST RETAINING WALLS**

- RW1 RETAINING WALL DETAILS AND NOTES
- RW2 RETAINING WALL DETAILS AND NOTES

**SOUTH RETAINING WALL**

- SP1 SITE PLAN - PIER LOCATIONS
- RW1 MASONRY RETAINING WALLS - NOTES & STANDARD DETAILS
- RW2 SOLDIER PIER WALL AND TEMPORARY FACING DETAILS
- RW3 SOLDIER PIER WALL AND PERMANENT STONE FACING
- RW4 MODIFIED SOLDIER PIER WALL AND PERMANENT STONE FACIN



**FOR INFORMATIONAL PURPOSES ONLY**

- C-7 DRAINAGE AREA MAP - LA JOLLA POINTE ADDITION
- C-24 DRAINAGE DETAILS & DETENTION CALCULATIONS LA JOLLA POINTE ADDITION

**SUBMITTALS**

NO	DATE	COMMENTS
1	03/26/2018	PROGRESS SET
2	04/06/2018	CITY SUBMITTAL
3	05/29/2018	CITY COMMENTS
4	06/21/2018	CITY COMMENTS
5	10/11/2018	CONSTRUCTION SET
6	09/04/2020	RECORD DRAWINGS




**VASQUEZ ENGINEERING, L.L.C.**

1919 S. Shiloh Road  
Suite 440, LB 44  
Garland, Texas 75042  
Ph: 972-278-2948  
TX Registration #F-12266

636-01 HYATT ROCKWALL ADDITION, ROCKWALL, TEXAS



VICINITY MAP  
N.T.S.

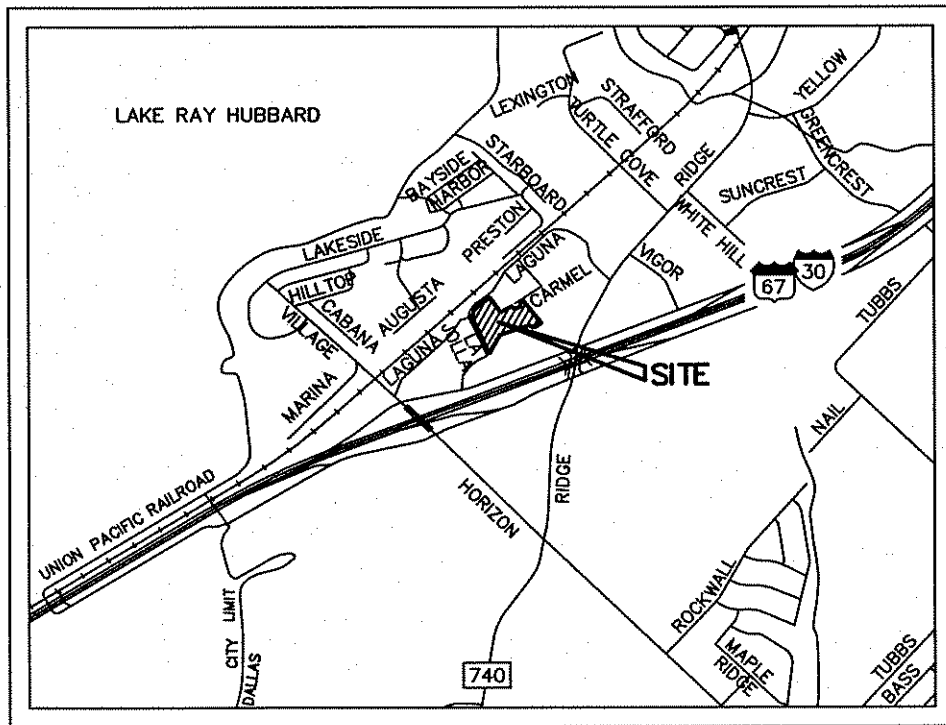

**LEGEND**  
 U.E. - UTILITY EASEMENT  
 D.E. - DRAINAGE EASEMENT  
 W.E. - WATER EASEMENT  
 S.E. - SIDEWALK EASEMENT  
 D.U.E. - DRAINAGE AND UTILITY EASEMENT  
 F.P.A.D.U.E. - FIRELANE, PUBLIC ACCESS, DRAINAGE AND UTILITY EASEMENT  
 IRF - IRON ROD FOUND  
 YCIRF - IRON ROD FOUND WITH YELLOW CAP  
 IRS - IRON ROD SET WITH "PEISER & MANKIN SURV" RED PLASTIC CAP  
 (ALL CORNERS MONUMENTED WITH 1/2" IRS UNLESS OTHERWISE NOTED HEREON)

D=87°15'39"  
 R=120.00'  
 L=182.76'  
 CB=N19°45'54"E  
 CD=165.60'

D=11°52'02"  
 R=660.00'  
 L=136.70'  
 CB=N57°27'43"E  
 CD=136.46'

D=23°26'31"  
 R=660.00'  
 L=270.03'  
 CB=N39°48'26"E  
 CD=268.15'

**LOT 18, BLOCK A**  
 116,789 SQ. FT. OR  
 2.681 AC.  
 (BY THIS PLAT)

**LOT 19, BLOCK A**  
 110,827 SQ. FT. OR  
 2.544 AC.  
 (BY THIS PLAT)

**HYATT ROCKWALL ADDITION**  
 OVERALL AREA  
 290,216 SQ. FT. OR  
 6.662 AC.

**LOT 20, BLOCK A**  
 62,601 SQ. FT. OR  
 1.437 AC.  
 (BY THIS PLAT)

**LOT 4R, BLOCK C**  
 LA JOLLA POINTE ADDITION  
 PHASE I  
 CAB. E, PG. 276-277  
 P.R.R.C.T.

**BLOCK A**  
 LA JOLLA POINTE ADDITION  
 PHASE 2  
 CAB. G, PG. 258-260  
 P.R.R.C.T.

**BLOCK A**  
 LA JOLLA POINTE ADDITION  
 PHASE 2  
 CAB. G, PG. 258-260  
 P.R.R.C.T.


**BLOCK A**  
 LA JOLLA POINTE ADDITION  
 PHASE 2  
 CAB. G, PG. 258-260  
 P.R.R.C.T.

**LOT 1, BLOCK 1**  
 HOP NO. 9448 ADDITION  
 CAB. D, PG. 199  
 P.R.R.C.T.

**LOT 1, BLOCK 1**  
 STEAK 'N SHAKE ADDITION  
 CAB. F, PG. 229-230  
 P.R.R.C.T.

SEE SHEET 2 FOR LINE  
& CURVE TABLES

**FINAL PLAT**  
**LA JOLLA POINTE ADDITION**  
**LOTS 18-20, BLOCK A**  
 BEING 3 LOTS ON 6.662 ACRES OF LAND IN THE  
 WILLIAM BLEVINS SURVEY, ABSTRACT NO. 9  
 BEING A REPLAT OF LOTS 11, 9 AND ALL OF LOT 8  
 BLOCK A, LA JOLLA POINTE ADDITION, PHASE 2  
 CABINET G, PAGE 279  
 CITY OF ROCKWALL, ROCKWALL COUNTY, TEXAS  
 CASE NO. P2018-022 MAY 2018

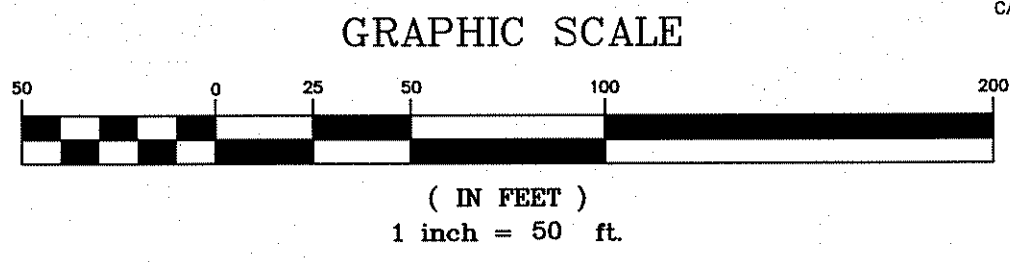

OWNER: (LOTS 18 & 19)  
 ROCKWALL INNKEEPERS I, LTD.  
 6176 FM 2011  
 LONGVIEW, TX 75603  
 CONTACT: DEEPAK GHANDI

OWNER: (LOT 20)  
 ROCKWAY PARTNERS, LLP  
 9071 E VASSAR DRIVE  
 DENVER, CO 80231  
 CONTACT: JOHN HAMMERBECK

ENGINEER:  
 VASQUEZ ENGINEERING, L.L.C.  
 1919 S. SHILOH ROAD  
 SUITE 440, LB 44  
 GARLAND, TEXAS 75042  
 972-278-2948 TELE  
 972-271-1383 FAX  
 CONTACT: JUAN J. VASQUEZ, P.E.

JOB NO.:	17-0919FP
DATE:	05/18/2018
REV:	
SCALE:	1" = 50'
DRAWN:	T.R.M.

**PEISER & MANKIN SURVEYING, LLC**  
 www.peisersurveying.com

623 E. DALLAS ROAD  
 GRAPEVINE, TEXAS 76051  
 817-481-1806 (O)  
 817-481-1809 (F)

COMMERCIAL  
 RESIDENTIAL  
 BOUNDARIES  
 TOPOGRAPHY  
 MORTGAGE

Texas Society of Professional Surveyors  
 Member Since 1977

SHEET  
 1  
 OF  
 3

PROPOSED EASEMENT CURVE TABLE					
CURVE	LENGTH	RADIUS	DELTA	CB	CD
C1	23.55'	30.00'	44°58'09"	N 43°39'00" E	22.95'
C2	23.58'	30.00'	45°01'51"	N 01°21'00" W	22.98'
C3	50.22'	30.00'	95°54'54"	N 71°49'22" W	44.56'
C4	5.57'	54.00'	05°54'54"	N 63°10'38" E	5.57'
C5	3.10'	30.00'	05°54'54"	N 63°10'38" E	3.10'
C6	9.62'	54.00'	10°12'23"	S 65°19'22" W	9.61'
C7	84.82'	54.00'	90°00'00"	N 64°34'27" W	76.37'
C8	35.38'	54.00'	37°32'10"	N 00°48'21" W	34.75'
C9	19.53'	30.00'	37°18'06"	S 00°41'19" E	19.19'
C10	25.92'	30.00'	49°29'42"	S 45°54'47" W	25.12'
C11	42.38'	54.00'	44°58'09"	N 43°39'00" E	41.30'
C12	44.03'	30.00'	84°05'06"	S 18°10'38" W	40.18'
C13	5.34'	30.00'	10°12'23"	S 65°19'22" W	5.34'
C14	47.12'	30.00'	90°00'00"	N 64°34'27" W	42.43'
C15	17.51'	30.00'	33°26'25"	N 02°51'14" W	17.26'
C16	30.42'	54.06'	32°14'40"	S 02°33'34" W	30.02'
C17	44.10'	30.00'	84°13'24"	N 28°32'56" E	40.23'
C18	44.75'	30.00'	85°28'27"	S 66°36'09" E	40.72'
C19	2.21'	54.00'	02°20'50"	N 64°57'40" E	2.21'
C20	5.60'	30.00'	10°41'24"	S 26°30'38" W	5.59'
C21	53.51'	42.00'	72°59'51"	S 12°37'59" W	49.97'
C22	9.29'	120.00'	04°26'03"	S 61°10'42" W	9.28'

PROPOSED EASEMENT LINE TABLE		
LINE	LENGTH	BEARING
L1	84.23'	N 23°51'55" W
L2	30.00'	N 23°51'55" W
L3	31.89'	N 66°08'05" E
L4	59.52'	N 21°09'56" E
L5	116.49'	N 23°51'55" W
L6	49.92'	S 60°13'11" W
L7	15.69'	S 66°13'22" W
L8	30.08'	N 23°51'55" W
L9	73.60'	N 66°12'52" E
L10	176.77'	N 60°13'11" E
L11	139.53'	N 70°25'33" E
L12	30.65'	S 19°34'27" E
L13	39.61'	S 17°57'44" W
L14	22.11'	S 19°20'22" E
L15	10.50'	N 70°39'38" E
L16	24.00'	S 19°20'22" E
L17	258.58'	S 70°39'38" W
L18	88.54'	S 21°09'56" W
L19	25.89'	S 66°08'05" W
L20	87.01'	N 23°51'55" W
L21	98.62'	N 60°13'11" E
L22	139.53'	N 70°25'33" E
L23	30.65'	S 19°34'27" E
L24	41.75'	S 17°51'25" W
L25	188.59'	S 70°39'38" W
L26	138.03'	S 23°51'55" E
L27	108.55'	N 23°51'55" W
L28	147.74'	S 23°51'55" E
L29	31.13'	S 23°51'55" E
L30	8.49'	S 68°51'54" E
L31	22.11'	S 23°51'55" E
L32	8.49'	S 21°08'05" W
L33	34.11'	N 23°51'55" W
L34	10.54'	N 66°15'57" E
L35	10.00'	S 23°51'55" E
L36	20.00'	N 66°08'05" E
L37	11.25'	N 23°51'55" W
L38	9.33'	S 60°13'11" W
L39	25.89'	N 66°08'05" E
L40	10.05'	S 23°51'55" E
L41	20.00'	N 66°08'05" E
L42	14.78'	N 23°51'55" W
L43	10.47'	S 70°39'38" W
L44	20.00'	S 70°39'38" W
L45	10.00'	N 19°20'22" W
L46	20.00'	N 70°39'38" E
L47	10.00'	S 19°20'22" E
L48	52.84'	S 70°25'33" W
L49	8.00'	S 19°34'27" E
L50	10.00'	S 70°25'33" W

PROPOSED EASEMENT LINE TABLE		
LINE	LENGTH	BEARING
L61	12.50'	S 19°34'27" E
L62	15.26'	S 70°25'33" W
L63	15.99'	S 19°34'27" E
L64	12.00'	S 70°18'19" W
L65	36.51'	N 19°34'27" W
L66	37.26'	N 70°25'33" E
L67	21.46'	S 21°09'56" W
L68	39.58'	S 21°09'56" W
L69	36.04'	N 23°51'55" W
L70	33.49'	N 21°09'56" E
L71	35.31'	S 23°51'55" E
L72	55.46'	S 60°3'24" W
L73	1.99'	S 32°52'46" E
L74	89.74'	S 60°13'11" W
L75	128.50'	S 60°13'11" W
L76	30.61'	S 60°13'11" W
L77	31.36'	S 60°13'11" W
L78	12.81'	S 66°08'05" W
L79	109.51'	N 23°51'55" W
L80	9.54'	N 51°44'32" E
L81	22.69'	N 10°58'51" W
L82	31.36'	N 60°13'11" E
L83	26.14'	S 23°51'55" E
L84	20.11'	N 60°13'11" E
L85	26.14'	N 23°51'55" W
L86	6.03'	N 23°51'55" W
L87	132.07'	N 60°13'11" E
L88	26.19'	N 29°46'49" W
L89	20.00'	N 60°13'11" E
L90	17.86'	S 29°46'49" E
L91	10.15'	N 70°25'33" E
L92	38.57'	N 50°56'18" E
L93	15.53'	N 39°03'42" W
L94	20.26'	N 60°03'24" E
L95	33.04'	S 39°03'42" E
L96	88.72'	N 70°25'33" E
L97	8.00'	S 19°34'27" E
L98	27.94'	N 70°25'33" E
L99	32.50'	S 19°34'27" E
L100	8.50'	S 70°25'33" W
L101	81.00'	N 23°51'55" W
L102	25.00'	S 19°34'27" W

EXISTING EASEMENT LINE TABLE		
LINE	LENGTH	BEARING
EL1	35.63'	N 23°51'55" W
EL2	14.81'	N 23°51'55" W
EL3	16.71'	N 23°51'55" W
EL4	60.45'	N 53°42'00" E
EL5	27.88'	N 53°42'00" E
EL6	37.19'	S 21°09'56" W
EL7	11.67'	S 53°41'07" W
EL8	49.72'	S 53°42'12" W
EL9	140.44'	N 21°09'29" E
EL10	26.14'	S 13°51'24" E
EL11	10.83'	S 21°09'29" W
EL12	32.36'	N 72°19'35" E
EL13	16.25'	N 21°09'56" E
EL14	14.59'	N 04°17'31" W
EL15	34.28'	N 72°19'35" E
EL16	13.94'	N 61°17'11" E

PROPERTY LINE TABLE		
LINE	LENGTH	BEARING
PL1	240.17'	S 29°46'49" E
PL2	115.87'	N 60°13'11" E
PL3	82.04'	N 70°25'33" E
PL4	32.50'	N 19°34'27" W
PL5	58.34'	N 70°25'33" E
PL6	30.65'	S 19°34'27" E
PL7	39.61'	S 17°57'44" W
PL8	71.61'	S 19°20'22" E

PROPERTY CURVE TABLE					
CURVE	LENGTH	RADIUS	DELTA	CB	CD
PC1	65.97'	42.00'	90°00'00"	S 64°34'27" E	59.40'
PC2	27.52'	42.00'	37°32'10"	S 00°48'21" E	27.03'
PC3	27.34'	42.00'	37°18'06"	S 00°41'19" E	26.86'
PC4	3.70'	660.00'	00°19'15"	N 63°14'06" E	3.70'
PC5	133.00'	660.00'	11°32'47"	N 57°18'05" E	132.78'
PC6	173.92'	58.00'	171°48'23"	N 64°09'30" E	115.70'

OWNER: (LOTS 18 & 19)  
 ROCKWALL INNKEEPERS I, LTD.  
 6176 FM 2011  
 LONGVIEW, TX 75603  
 CONTACT: DEEPAK GHANDI


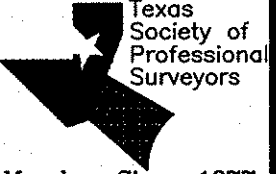
OWNER: (LOT 20)  
 ROCKWAY PARTNERS, LLP  
 9071 E VASSAR DRIVE  
 DENVER, CO 80231  
 CONTACT: JOHN HAMMERBECK

ENGINEER:

VASQUEZ ENGINEERING, L.L.C.  
 1919 S. SHILOH ROAD  
 SUITE 440, LB 44  
 GARLAND, TEXAS 75042  
 972-278-2948 TELE  
 972-271-1383 FAX  
 CONTACT: JUAN J. VASQUEZ, P.E.

CASE NO. P2018-022

MAY 2018

JOB NO.: 17-0919FP	<b>PEISER &amp; MANKIN SURVEYING, LLC</b>		SHEET
DATE: 05/18/2018	www.peisersurveying.com		
REV:	 623 E. DALLAS ROAD GRAPEVINE, TEXAS 76051 817-481-1806 (O) 817-481-1809 (F)	COMMERCIAL RESIDENTIAL BOUNDARIES TOPOGRAPHY MORTGAGE	2
SCALE: 1" = 50'		 Texas Society of Professional Surveyors Member Since 1977	OF
DRAWN: T.R.M.	tmankin@peisersurveying.com	FIRM No. 100999-00	3

**FINAL PLAT**  
**LA JOLLA POINTE ADDITION**  
**LOTS 18-20, BLOCK A**  
 BEING 3 LOTS ON 6.662 ACRES OF LAND IN THE  
 WILLIAM BLEVINS SURVEY, ABSTRACT NO. 9  
 BEING A REPLAT OF LOTS 11, 9 AND ALL OF LOT 8  
 BLOCK A, LA JOLLA POINTE ADDITION, PHASE 2  
 CABINET G, PAGE 279  
 CITY OF ROCKWALL, ROCKWALL COUNTY, TEXAS



OWNER'S CERTIFICATION

WHEREAS ROCKWALL INNKEEPERS I, LTD. AND ROCKWAY PARTNERS, LLP, are the sole owners of a tract of land in the County of Rockwall, State of Texas, said tract being described as follows:

BEING that certain tract of land situated in the R. Ballard Survey, Abstract No. 29, in the City of Rockwall, Rockwall County, Texas, and being all of that certain 5.225 acre tract of land to Rockwall Innkeepers I, Ltd., by deed recorded in Instrument Number 20170000016642, Official Public Records, Rockwall County, Texas, and being all that certain tract of land conveyed to Rockway Partners, LLP, by deed recorded in Instrument Number 201800009623, Official Public Records, Rockwall County, Texas, and being all of Lots 11 8, and 9, Block A, La Jolla Pointe Addition, Phase 2, an addition to the City of Rockwall, Rockwall County, Texas, according to the plat thereof recorded in Cabinet G, Page 131, Plat Records, Rockwall County, Texas, and being more particularly described as follows:

BEGINNING at a 1/2 inch iron rod found for the south corner of said Lot 11, same being the most westerly northwest corner of Lot 15, Block A, La Jolla Pointe Addition, Phase 2, an addition to the City of Rockwall, Rockwall County, Texas, according to the plat thereof recorded in Cabinet G, Pages 258-260, said Plat Records, same being in the northeast right-of-way line of La Jolla Pointe Drive (a 60' right-of-way);

THENCE North 23 deg. 51 min. 55 sec. West, along the common line of said Lot 11, and the northeast right-of-way line of said La Jolla Pointe Drive, a distance of 438.29 feet to a 1/2 inch iron rod found with yellow cap stamped "Arthur" for the beginning of a curve to the right having a radius of 120.00 feet, a delta angle of 87 deg. 15 min. 39 sec., and a chord bearing and distance of North 19 deg. 45 min. 54 sec. East, 165.60 feet;

THENCE in a northeasterly direction, along the common line of said Lot 11, and the northeast right-of-way line of said La Jolla Pointe Drive, and along said curve to the right, an arc distance of 182.76 feet to a 1/2 inch iron rod set with red cap stamped "PEISER & MANKIN SURV" (hereinafter referred to as 1/2 inch iron rod set) for the beginning of a curve to the left having a radius of 660.00 feet, a delta angle of 11 deg. 52 min. 02 sec., and a chord bearing and distance of North 57 deg. 27 min. 43 sec. East, 136.46 feet, same being in the south right-of-way line of Laguna Drive (a variable width right-of-way at this point, formerly known as La Jolla Pointe Drive);

THENCE in a northeasterly direction, along the common line of said Lot 11, and the south right-of-way line of said Laguna Drive, and along said curve to the left, an arc distance of 136.70 feet to a 1/2 inch iron rod found with yellow cap stamped "Arthur" found for the northeast corner of said Lot 11, same being the northwest corner of Lot 10, said Block A, of said La Jolla Pointe Addition;

THENCE South 13 deg. 51 min. 24 sec. East, along the common line of said Lot 11, and said Lot 10, a distance of 181.81 feet to a point in a detention pond (cannot monument) for the southwest corner of said Lot 10, same being the northwest corner of aforesaid Lot 9;

THENCE North 60 deg. 03 min. 24 sec. East, along the common line of said Lot 9, and said Lot 10, a distance of 190.87 feet to a 1/2 inch iron rod set for the most northerly corner of said Lot 9, same being the most southerly southeast corner of said Lot 10, same being in the west right-of-way line of Carmel Circle (cul-de-sac), same being the beginning of a non-tangent curve to the left having a radius of 58.00 feet, a delta angle of 171 deg. 48 min. 23 sec., and a chord bearing and distance of North 64 deg. 09 min. 30 sec. East, 115.70 feet;

THENCE in a northeasterly direction, along the common line of said Lot 9, and the south right-of-way line of said Carmel Circle, and along said non-tangent curve to the left, passing the most easterly northeast corner of said Lot 9, same being the most westerly corner of aforesaid Lot 8, and continuing along the common line of said Lot 8, and the south right-of-way line of said Carmel Circle, a total arc distance of 173.92 feet to a 1/2 inch iron rod set for the end of said curve;

THENCE North 37 deg. 06 min. 28 sec. East, continuing along the common line of said Lot 8, and the south right-of-way line of said Carmel Circle, a distance of 110.51 feet to a 1/2 inch iron rod set for angle point;

THENCE North 49 deg. 43 min. 05 sec. East, continuing along the common line of said Lot 8 and the south right-of-way line of said Carmel Circle, a distance of 117.61 feet to a 1/2 inch iron rod set for the northeast corner of said Lot 8, same being the northwest corner of Lot 7, aforesaid Block A, La Jolla Pointe Addition (Cabinet F, Page 255-256), same being the most easterly northeast corner of the herein described tract;

THENCE South 43 deg. 30 min. 39 sec. East, along the common line of said Lot 8 and said Lot 7, a distance of 396.58 feet to a 1/2 inch iron rod set for the most easterly southeast corner of the herein described tract, same being the southeast corner of said Lot 8, same being the southwest corner of said Lot 7, same being in the northwesterly line of Lot 1, Block 1, IHOP No. 9448 Addition, an addition to the City of Rockwall, Rockwall County, Texas, according to the plat thereof recorded in Cabinet D, Page 199, aforesaid Plat Records;

THENCE South 46 deg. 29 min. 21 sec. West, along the common line of said Lot 8 and said Lot 1 (IHOP), a distance of 117.31 feet to a 1/2 inch iron rod set for angle point, same being the most westerly corner of said Lot 1 (IHOP), same being the most northerly corner of Lot 1, Block 1, Steak 'N Shake Addition, an addition to the City of Rockwall, Rockwall County, Texas, according to the plat thereof recorded in Cabinet F, Page 229-230, said Plat Records;

THENCE South 44 deg. 36 min. 44 sec. West, along the common line of said Lot 8, and said Lot 1 (Steak 'N Shake), a distance of 93.27 feet to a 1/2 inch iron rod set for the most southerly corner of said Lot 8, same being the northwest corner of said Lot 1 (Steak 'N Shake), same being an angle point in the east line of aforesaid Block A, La Jolla Pointe Addition, Phase 2 (Cabinet G, Pages 258-260);

THENCE North 53 deg. 10 min. 30 sec. West, along the common line of said Lot 8, and said Block A, La Jolla Pointe Addition, Phase 2 (Cabinet G, Pages 258-260), a distance of 49.31 feet to a 1/2 inch iron rod set for the southeast corner of aforesaid Lot 9;

THENCE South 70 deg. 39 min. 38 sec. West, along the common line of said Lot 9, and said Block A, La Jolla Pointe Addition, Phase 2 (Cabinet G, Pages 258-260), passing the southwest corner of said Lot 9, same being the southeast corner of aforesaid Lot 10, and continuing along the common line of said Lot 10, and said Block A, La Jolla Pointe Addition, Phase 2 (Cabinet G, Pages 258-260), a total distance of 499.76 feet to a 1/2 inch iron rod set for an angle point;

THENCE South 21 deg. 09 min. 56 sec. West, continuing along the common line of said Lot 10, and said Block A, La Jolla Pointe Addition, Phase 2 (Cabinet G, Pages 258-260), a distance of 206.62 feet to the POINT OF BEGINNING and containing 290,216 square feet or 6.662 acres of computed land.

NOW, THEREFORE, KNOW ALL MEN BY THESE PRESENTS:~

STATE OF TEXAS~ COUNTY OF ROCKWALL~

I the undersigned owner of the land shown on this plat, and designated herein as the LA JOLLA POINTE ADDITION to the City of Rockwall, Texas, and whose name is subscribed hereto, hereby dedicate to the use of the public forever all streets, alleys, parks, water courses, drains, easements and public places thereon shown on the purpose and consideration therein expressed. I further certify that all other parties who have a mortgage or lien interest in the LA JOLLA POINTE ADDITION have been notified and signed this plat. I understand and do hereby reserve the easement strips shown on this plat for the purposes stated and for the mutual use and accommodation of all utilities desiring to use or using same. I also understand the following:~

- 1. No buildings shall be constructed or placed upon, over, or across the utility easements as described herein.~
2. Any public utility shall have the right to remove and keep removed all or part of any buildings, fences, trees, shrubs, or other growths or improvements which in any way endanger or interfere with construction, maintenance or efficiency of their respective system on any of these easement strips; and any public utility shall at all times have the right of ingress or egress to, from and upon the said easement strips for purpose of construction, reconstruction, inspecting, patrolling, maintaining, and either adding to or removing all or part of their respective system without the necessity of, at any time, procuring the permission of anyone.~
3. The City of Rockwall will not be responsible for any claims of any nature resulting from or occasioned by the establishment of grade of streets in the subdivision.~
4. The developer and subdivision engineer shall bear total responsibility for storm drain improvements.~
5. The developer shall be responsible for the necessary facilities to provide drainage patterns and drainage controls such that properties within the drainage area are not adversely affected by storm drainage from the development.~
6. All detention and drainage systems to be maintained, repaired, and replaced by property owner.
7. No house dwelling unit, or other structure shall be constructed on any lot in this addition by the owner or any other person until the developer and/or owner has complied with all requirements of the Subdivision Regulations of the City of Rockwall regarding improvements with respect to the entire block on the street or streets on which property abuts, including the actual installation of streets with the required base and paving, curb and gutter, water and sewer, drainage structures, storm structures, storm sewers, and alleys, all according to the specifications of the City of Rockwall; or Until an escrow deposit, sufficient to pay for the cost of such improvements, as determined by the city's engineer and/or city administrator, computed on a private commercial rate basis, has been made with the city secretary, accompanied by an agreement signed by the developer and/or owner, authorizing the city to make such improvements at prevailing private commercial rates, or have the same made by a contractor and pay for the same out of the escrow deposit, should the developer and/or owner fail or refuse to install the required improvements within the time stated in such written agreement, but in no case shall the City be obligated to make such improvements itself. Such deposit may be used by the owner and/or developer as progress payments as the work progresses in making such improvements by making certified requisitions to the city secretary, supported by evidence of work done; or~Until the developer and/or owner files a corporate surety bond with the city secretary in a sum equal to the cost of such improvements for the designated area, guaranteeing the installation thereof within the time stated in the bond, which time shall be fixed by the city council of the City of Rockwall. I further acknowledge that the dedications and/or exactions made herein are proportional to the impact of the Subdivision upon the public services required in order that the development will comport with the present and future growth needs of the City; I, my successors and assigns hereby waive any claim, damage, or cause of action that I may have as a result of the dedication of exactions made herein.
8. Non standard street signs, poles and fixtures to be maintained by Home Owner's Association.

WITNESS MY HAND, this 28 day of SEPTEMBER 2018.

ROCKWALL INNKEEPERS I, LTD.


BY: DEEPAK GHANDI

STATE OF TEXAS: COUNTY OF DALLAS:

BEFORE ME, the undersigned authority, a Notary Public in and for the State of Texas, on this day personally appeared Deepak Ghandi, known to me to be the person whose name is subscribed to the foregoing instrument and acknowledged to me that he executed the same for the purpose and consideration thereof expressed.

GIVEN UNDER MY HAND AND SEAL OF OFFICE THIS 28 DAY OF SEPTEMBER 2018.

NOTARY PUBLIC in and for the STATE OF TEXAS

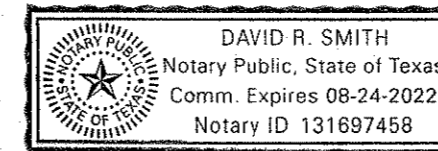

Filed and Recorded Official Public Records Shell Miller, County Clerk Rockwall County, Texas 10/18/2018 03:20:49 PM \$150.00 20180000018728



OWNER: (LOTS 18 & 19) ROCKWALL INNKEEPERS I, LTD. 6176 FM 2011 LONGVIEW, TX 75603 CONTACT: DEEPAK GHANDI

OWNER: (LOT 20) ROCKWAY PARTNERS, LLP 9071 E VASSAR DRIVE DENVER, CO 80231 CONTACT: JOHN HAMMERBECK

ENGINEER:

VASQUEZ ENGINEERING, L.L.C. 1919 S. SHILOH ROAD SUITE 440, LB 44 GARLAND, TEXAS 75042 972-278-2948 TELE 972-271-1383 FAX CONTACT: JUAN J. VASQUEZ, P.E.

WITNESS MY HAND, this 2 day of October 2018.

ROCKWAY PARTNERS, LLP


BY: JOHN HAMMERBECK

STATE OF COLORADO: COUNTY OF ARAPAHOE:

BEFORE ME, the undersigned authority, a Notary Public in and for the State of Texas on this day personally appeared John Hammerbeck, known to me to be the person whose name is subscribed to the foregoing instrument and acknowledged to me that he executed the same for the purpose and consideration thereof expressed.

GIVEN UNDER MY HAND AND SEAL OF OFFICE THIS 2 DAY OF October 2018.


NOTARY PUBLIC in and for the STATE OF COLORADO

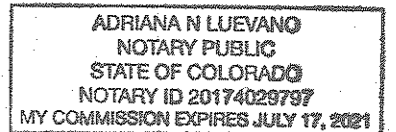

SURVEYOR'S CERTIFICATE

I, Timothy R. Mankin, a Registered Professional Land Surveyor in the State of Texas, do hereby certify that I prepared this plat from an actual on the ground survey of the land and that the monuments shown thereon were properly placed under my personal supervision in accordance with the subdivision regulations of the City of Rockwall, Texas.

Timothy R. Mankin Registered Professional Land Surveyor, No. 6122

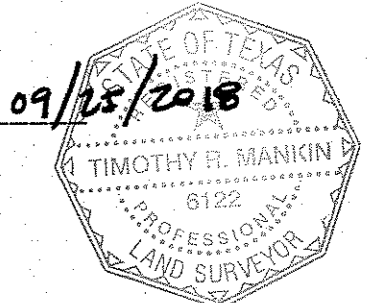

RECOMMENDED FOR FINAL APPROVAL

Planning & Zoning Commission, Chairman Date

APPROVED:

I hereby certify that the above and foregoing plat of an addition to the City of Rockwall, Texas, was approved by the City Council of the City of Rockwall on the 14 day of August, 2018.

This approval shall be invalid unless the approved plat for such addition is recorded in the office of the County Clerk of Rockwall, County, Texas, within one hundred eighty (180) days from said date of final approval.

WITNESS OUR HANDS, this 12th day of October 2018.

Mayor, City of Rockwall City Engineer

GENERAL NOTE

It shall be the policy of the City of Rockwall to withhold issuing building permits until all streets, water, sewer, and storm drainage systems have been accepted by the City. The approval of a plat by the City does not constitute any representation, assurance or guarantee that any building within such plat shall be approved, authorized or permit therefore issued, nor shall such approval constitute any representation, assurance or guarantee by the City of the adequacy and availability for water for personal use and fire protection within such plat, as required under Ordinance 83-54.




FINAL PLAT LA JOLLA POINTE ADDITION LOTS 18-20, BLOCK A

BEING 3 LOTS ON 6.662 ACRES OF LAND IN THE WILLIAM BLEVINS SURVEY, ABSTRACT NO. 9 BEING A REPLAT OF LOTS 11, 9 AND ALL OF LOT 8 BLOCK A, LA JOLLA POINTE ADDITION, PHASE 2 CABINET G, PAGE 279 CITY OF ROCKWALL, ROCKWALL COUNTY, TEXAS

CASE NO. P2018-022 MAY 2018

Table with 4 columns: JOB NO., DATE, REV., SCALE, DRAWN, and SHEET. Includes contact information for Peiser & Mankin Surveying, LLC and the Texas Society of Professional Surveyors.



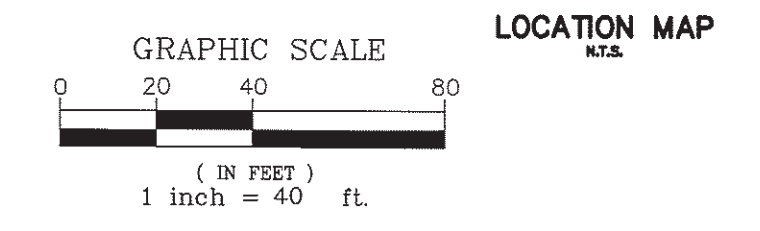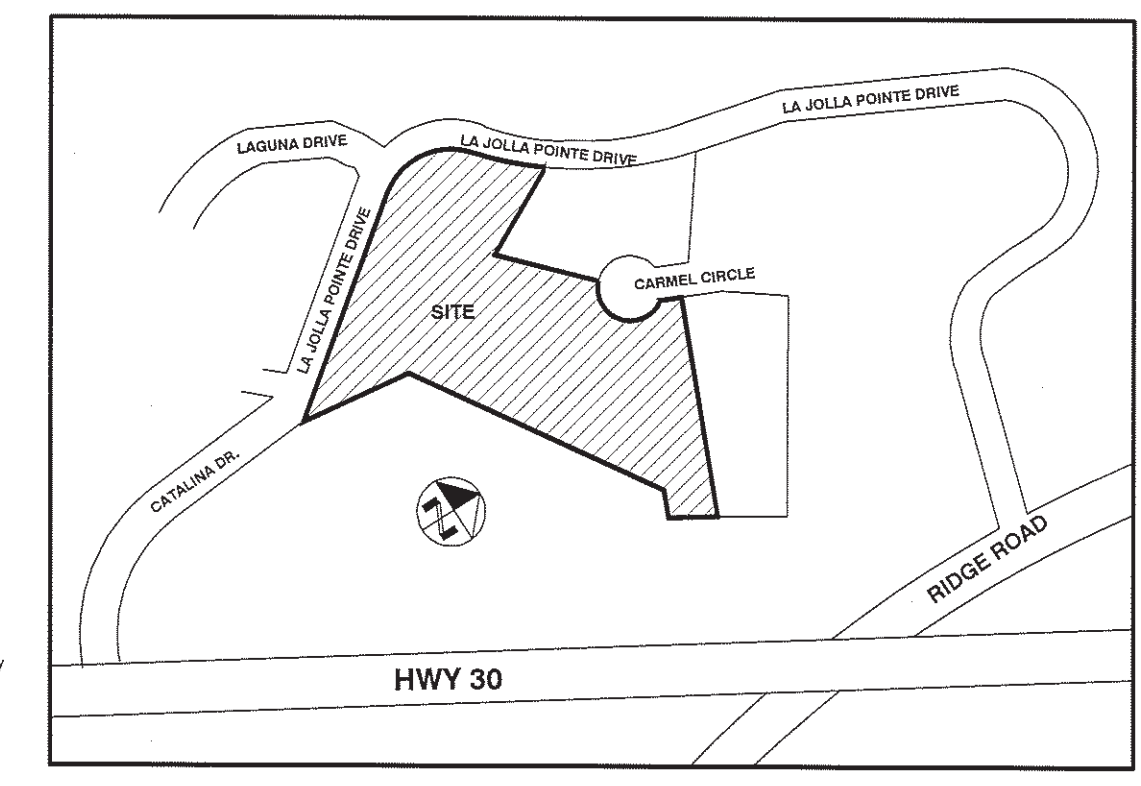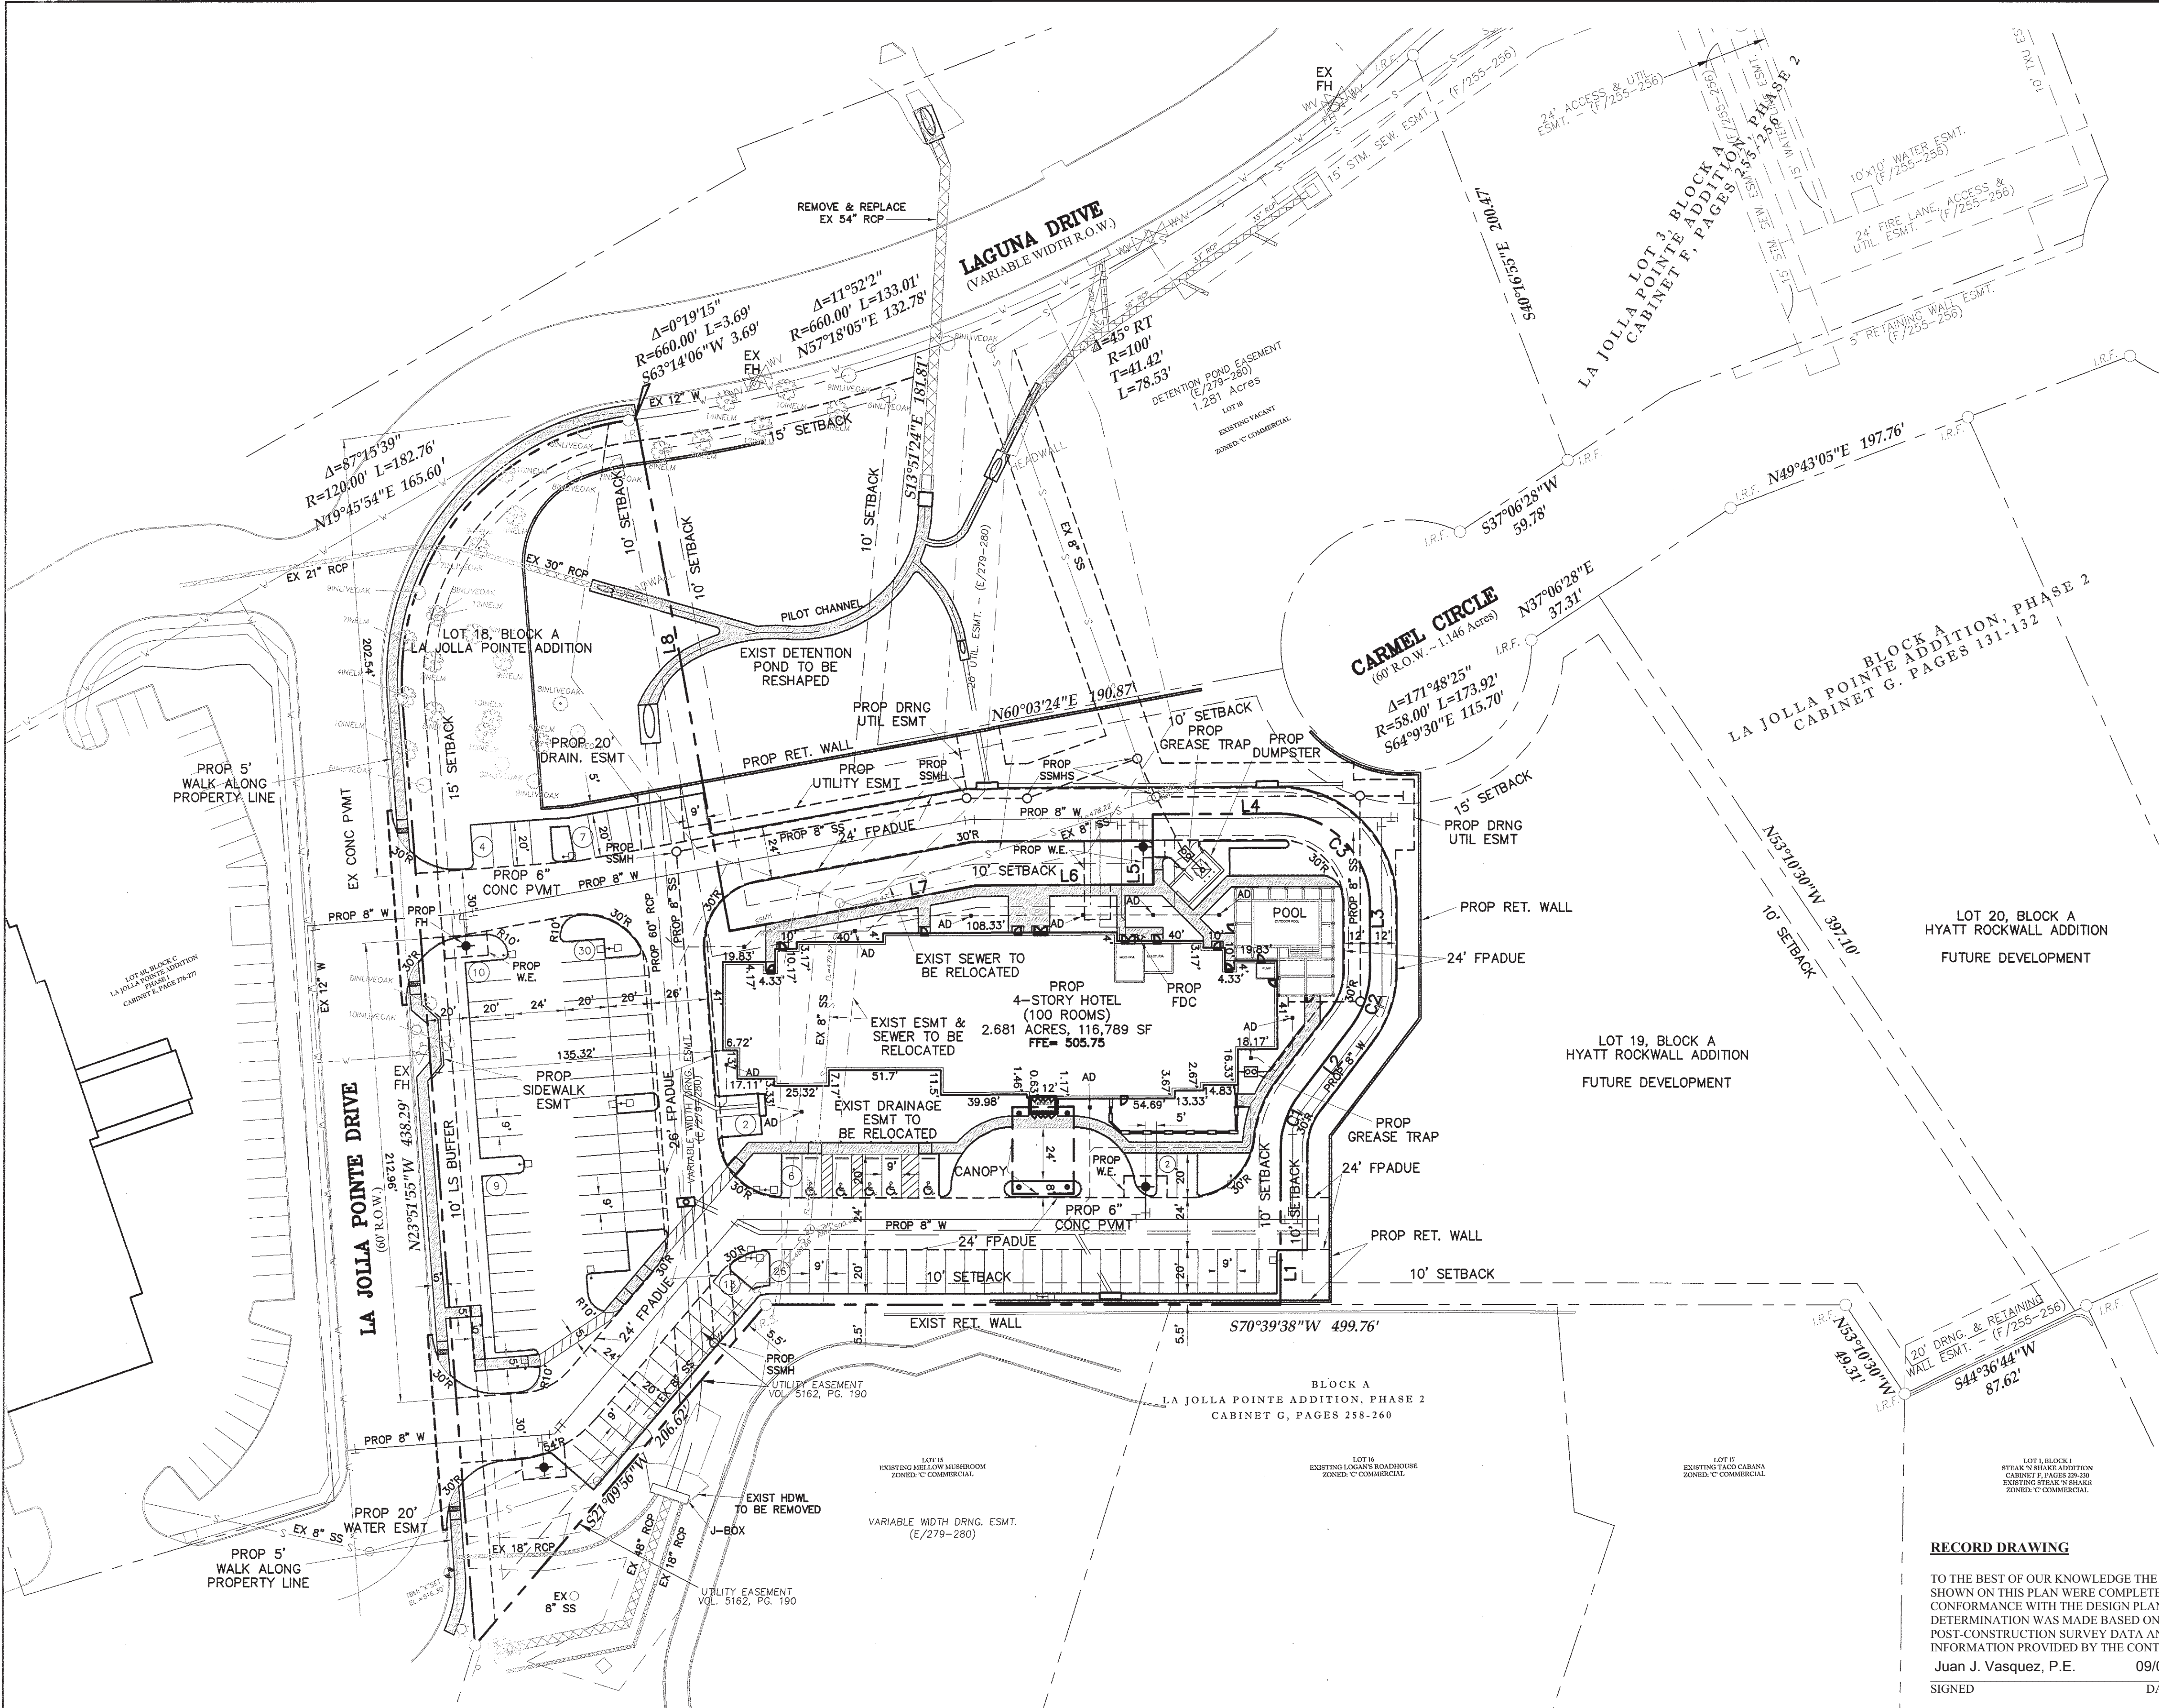

- LEGEND
- PROP. 6" INTEGRAL CURB
  - EXISTING CURB/PAVEMENT
  - - - PROPERTY LINE
  - ⊙ PARKING COUNT
  - PROP RETAINING WALL
  - FPADUE FIRE LANE, PUBLIC ACCESS, DRAINAGE & UTILITY EASEMENT
  - ◆ PROPOSED (FH) FIRE HYDRANT
  - AREA DRAIN (AD)
  - LIGHT POLE

- NOTES:
- TOPOGRAPHIC SURVEY PROVIDED BY PROPERTY SELLER.
  - SEE CIVIL SHEETS FOR CIVIL SITE DESIGN.
  - SEE LANDSCAPE PLANS FOR SITE LANDSCAPE.
  - REFERENCE ARCHITECT PLANS FOR EXACT BUILDING DIMENSIONS.
  - ALL DIMENSIONS ARE TO FACE OF CURB, FACE OF BUILDING OR AS OTHERWISE NOTED.
  - ALL CURB RADII NOT LISTED ARE 3' FACE OF CURB.
  - MECHANICAL EQUIPMENT TO BE LOCATED ON ROOF.
  - THE OVERALL HEIGHT OF THE BUILDING NOT TO EXCEED A TOPOGRAPHIC ELEVATION OF 566-FEET (PER ORD. NO. 17-38).
  - NO TREES WITHIN 5' OF ANY UTILITY.

SITE SUMMARY TABLE	
County	ROCKWALL
Project Name	HYATT PLACE
Zoning District	'C' W/ SUP
Proposed use	HOTEL
Site Area:	2.681 Acres 116,789 S.F.
Building Area	63,856 S.F. (TOTAL)
Building Height:	60' - 4 STORY
Lot Coverage:	16,862/116,789 = 14.4%
Floor Area Ratio:	63,856/116,789 = 0.55
Parking Required:	1 SPC/ROOM (100 ROOMS) = 100 SPACES
	1 SPC/100 SF MTG ROOM (50%)
	1792/100 (50%) = 9 SPACES
	Total = 109 SPACES
Parking Provided:	Regular = 104 SPACES
	Handicap = 5 SPACES
	Total = 109 SPACES
Impervious Area:	76,683 / 116,789 SF = 65.7%
Pervious Area:	40,106 / 116,789 SF = 34.3%

BLDG AREA TABLE:	
1st FLOOR	16,862 SF
2ND FLOOR	16,390 SF
3RD FLOOR	15,302 SF
4TH FLOOR	15,302 SF
TOTAL	63,856 SF

LINE TABLE		
NO.	BEARING	DISTANCE
L1	N19°20'22"W	71.61'
L2	N17°57'44"E	39.81'
L3	N19°34'27"W	30.65'
L4	S70°25'33"W	58.34'
L5	S19°34'27"E	32.50'
L6	S70°25'33"W	82.04'
L7	S60°13'11"W	115.87'
L8	N29°46'49"W	240.17'

CURVE TABLE						
NO.	RADIUS	LENGTH	DELTA	TANGENT	CH. BEARING	CH. LENGTH
C1	42.00'	27.34'	37°18'06"	14.18'	N0°41'19"W	26.86'
C2	42.00'	27.52'	37°32'10"	14.27'	N0°48'21"W	27.03'
C3	42.00'	65.97'	90°00'00"	42.00'	S64°34'27"E	59.40'

**RECORD DRAWING**

TO THE BEST OF OUR KNOWLEDGE THE IMPROVEMENTS SHOWN ON THIS PLAN WERE COMPLETED IN GENERAL CONFORMANCE WITH THE DESIGN PLANS. THIS DETERMINATION WAS MADE BASED ON POST-CONSTRUCTION SURVEY DATA AND INFORMATION PROVIDED BY THE CONTRACTOR

Juan J. Vasquez, P.E. 09/04/2020

SIGNED DATE

VASQUEZ ENGINEERING, LLC  
TEXAS REG. F-12266

ENGINEER:  
VASQUEZ ENGINEERING, L.L.C.  
1919 S. SHILOH ROAD, SUITE 440  
GARLAND, TEXAS 75042  
TELE: 972-272-4610  
CONTACT: JUAN J. VASQUEZ, P.E.

OWNER/DEVELOPER:  
ROCKWALL INN KEEPERS I, LTD.  
6176 FM 2011  
LONGVIEW, TEXAS 75603  
TELE: 214-455-5254  
CONTACT: DEEPAK GANDHI

**SITE PLAN**  
**LA JOLLA POINTE ADDITION**  
**LOT 18, BLOCK A**  
**2.681 ACRES**  
**ROCKWALL, ROCKWALL COUNTY, TEXAS**  
**OCTOBER 11, 2018**  
**CASE #SP2017-033**

VASQUEZ ENGINEERING, L.L.C.  
1919 S. Shiloh Road  
Suite 440, LB 44  
Garland, Texas 75042  
Ph: 972-272-2948  
TX Registration # F-12266



THE SEAL APPEARING ON THIS DOCUMENT WAS AUTHORIZED BY JUAN J. VASQUEZ, P.E. ON 10/11/2018

DEVELOPER:  
ROCKWALL INN KEEPERS I, LTD.  
6176 FM 2011  
LONGVIEW, TX 75603


SITE PLAN

LOT 18, BLOCK A  
LA JOLLA POINTE ADDITION  
ROCKWALL, TEXAS

Scale: 1" = 40'  
Designed by: JUV  
Drawn by: JUV  
Checked by: JUV  
ES&P/omg/SP1-SITE PLAN.dwg  
Date: 10/11/2018

SHEET  
**SP1**



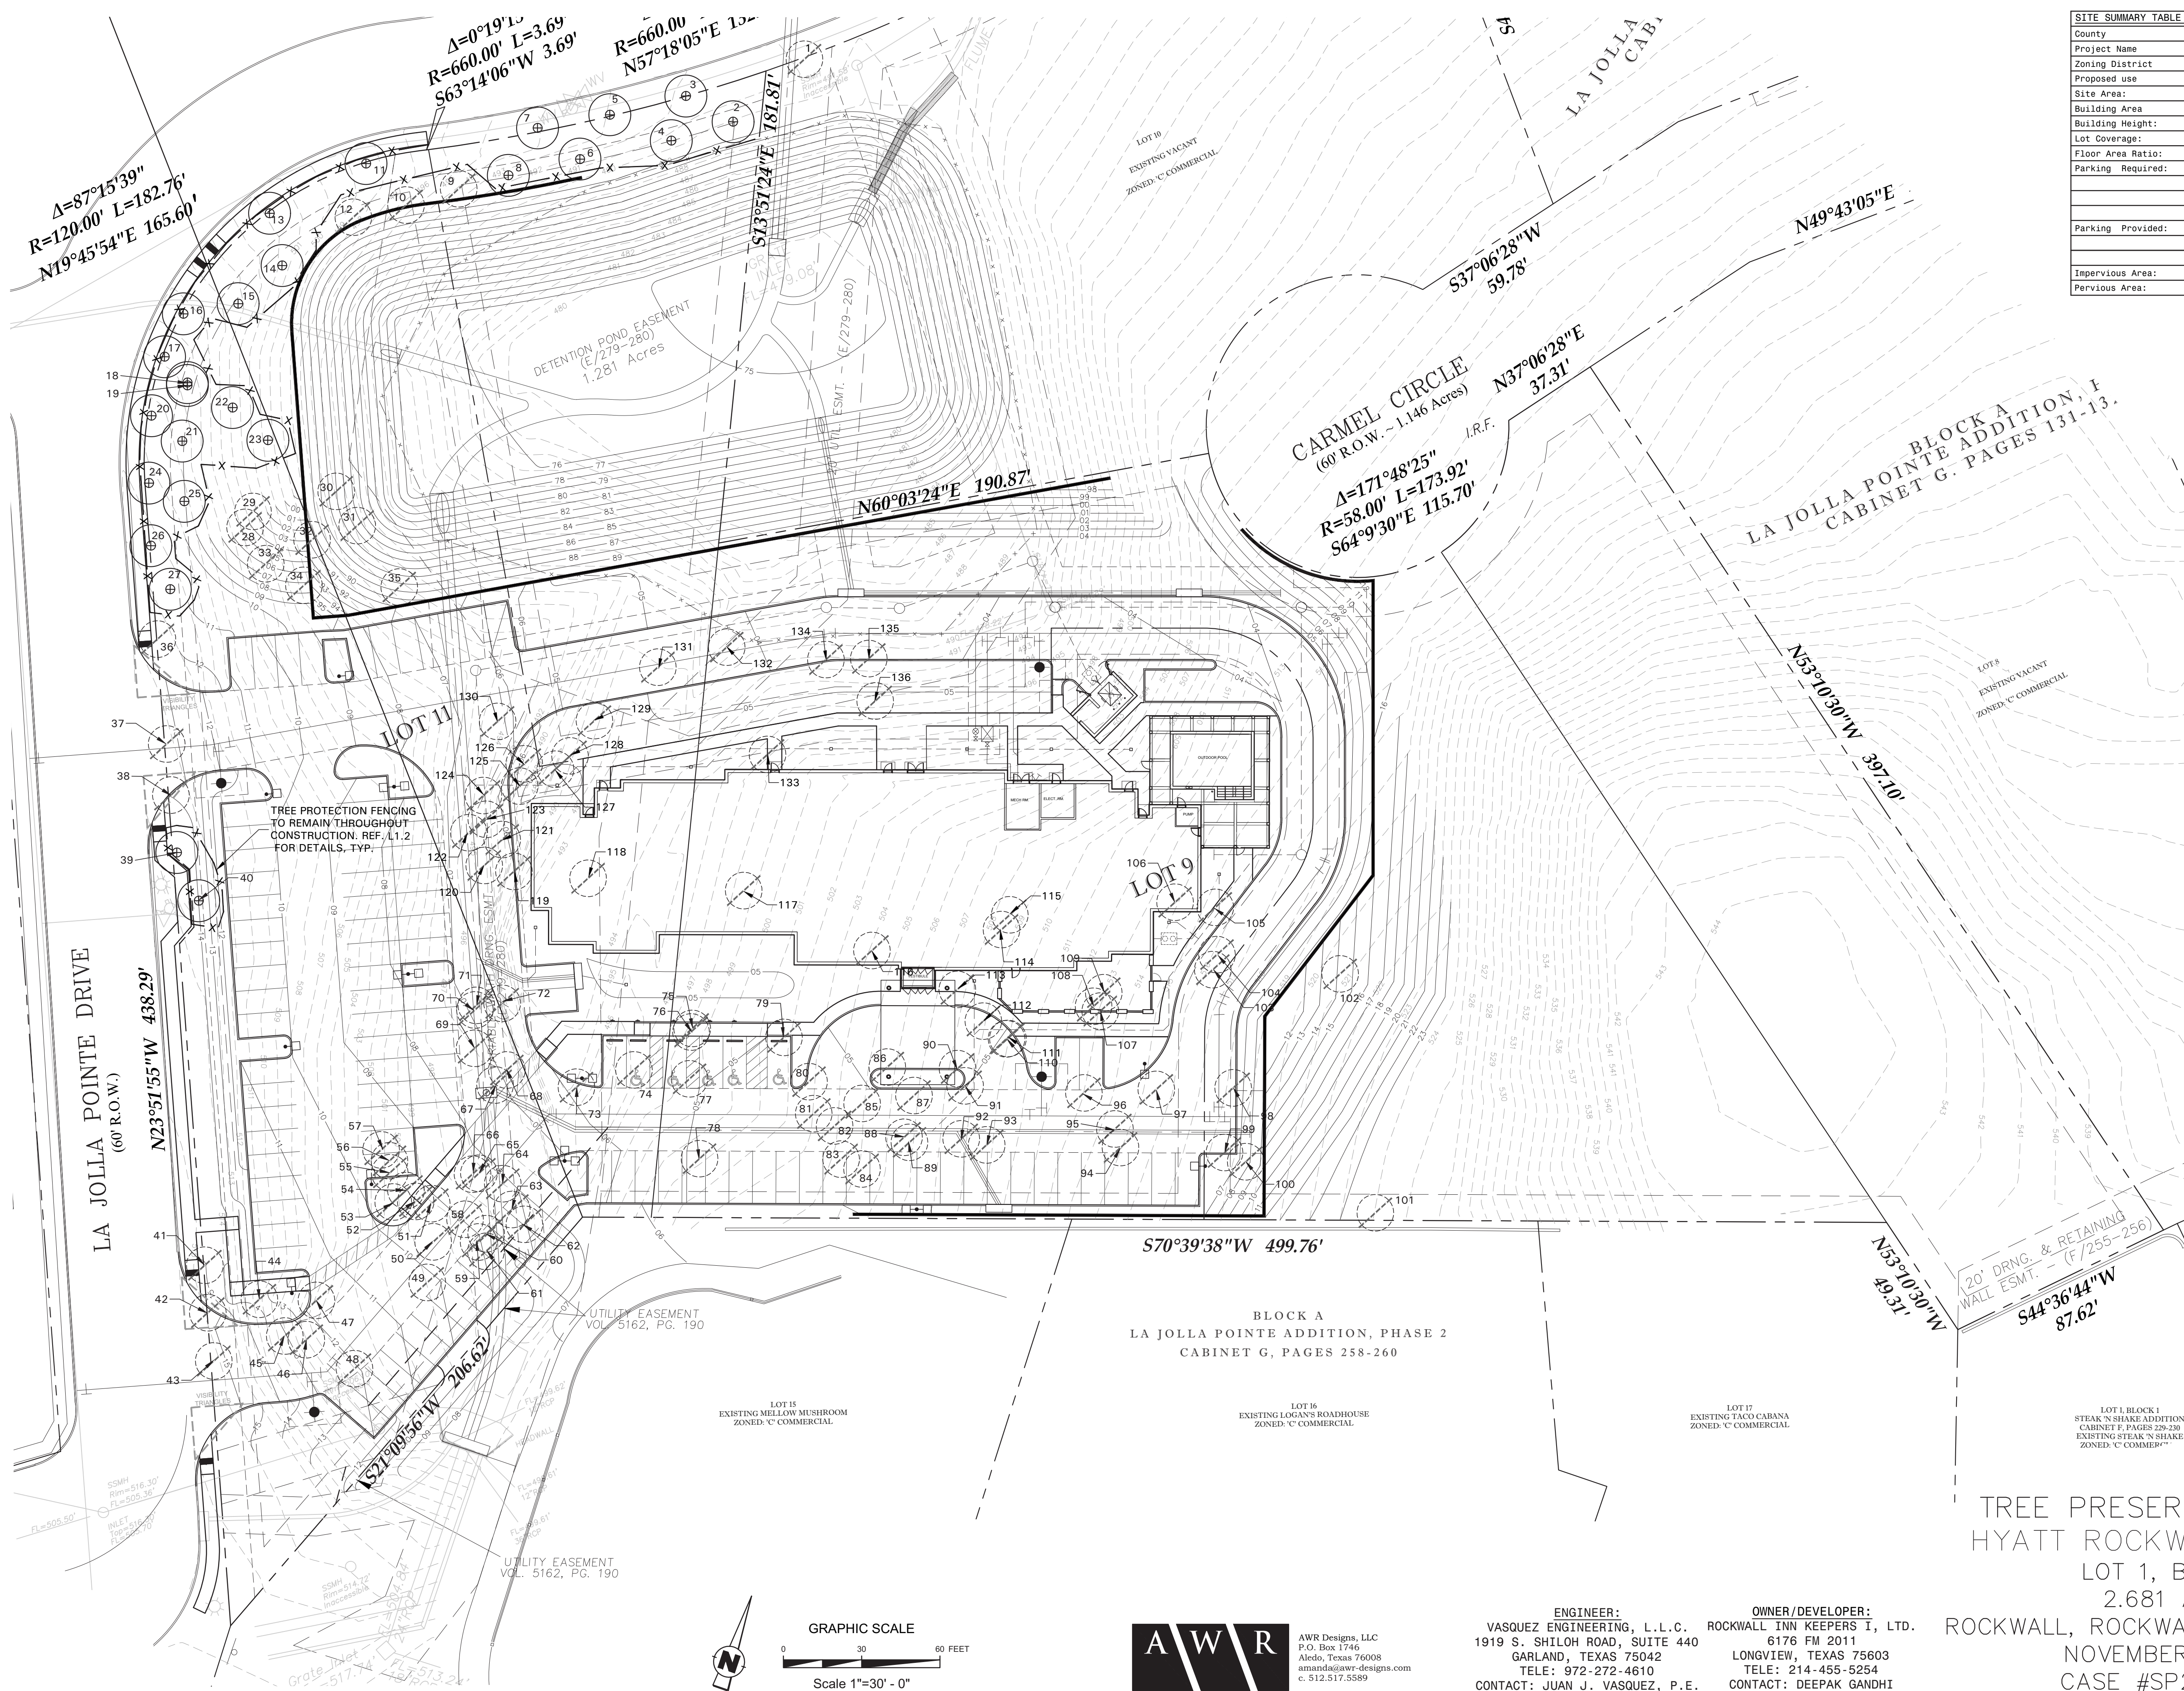

SITE SUMMARY TABLE	
County	ROCKWALL
Project Name	HYATT PLACE
Zoning District	C / W / SUP
Proposed use	HOTEL
Site Area:	2.681 Acres 116,789 S.F.
Building Area	63,856 S.F. (TOTAL)
Building Height:	60' - 4 STORY
Lot Coverage:	16,862/116,789 = 14.4%
Floor Area Ratio:	63,856/116,789 = 0.55
Parking Required:	1 SPC/ROOM (100 ROOMS) = 100 SPACES
	1 SPC/100 SF MTG ROOM (50%) = 9 SPACES
	1782/100 (50%) = 109 SPACES
	Total = 109 SPACES
Parking Provided:	Regular = 104 SPACES
	Handicap = 5 SPACES
	Total = 109 SPACES
Impervious Area:	76,683 / 116,789 SF = 65.7%
Pervious Area:	40,106 / 116,789 SF = 34.3%

- TREE PRESERVATION LEGEND
- TREE TO BE REMOVED
  - TREE TO REMAIN
  - TREE PRESERVATION FENCING

TREE PRESERVATION PLAN  
 HYATT ROCKWALL ADDITION  
 LOT 1, BLOCK A  
 2.681 ACRES  
 ROCKWALL, ROCKWALL COUNTY, TEXAS  
 NOVEMBER 7, 2017  
 CASE #SP2017-033

**VASQUEZ ENGINEERING, L.L.C.**  
 1919 S. Shiloh Road  
 Suite 440, LB 44  
 Garland, Texas 75042  
 Ph: 972-278-2948  
 TX Registration # F-12286



**DEVELOPER:**  
 ROCKWALL INN KEEPERS I, LTD.  
 6176 FM 2011  
 LONGVIEW, TX 75603

**TREE PRESERVATION PLAN**  
 LOT 1, BLOCK A  
 HYATT ROCKWALL ADDITION  
 ROCKWALL, TEXAS



Scale: 1" = 30'  
 Designed by: AWR  
 Drawn by: AWR  
 Checked by: AWR  
 63170\mg\sp2 SITE PLAN.dwg  
 Date: 11.7.2017

SHEET  
**L1.1**

**ENGINEER:**  
 VASQUEZ ENGINEERING, L.L.C.  
 1919 S. SHILOH ROAD, SUITE 440  
 GARLAND, TEXAS 75042  
 TELE: 972-272-4610  
 CONTACT: JUAN J. VASQUEZ, P.E.

**OWNER/DEVELOPER:**  
 ROCKWALL INN KEEPERS I, LTD.  
 6176 FM 2011  
 LONGVIEW, TEXAS 75603  
 TELE: 214-455-5254  
 CONTACT: DEEPAK GANDHI

**AWR**  
 AWR Designs, LLC  
 P.O. Box 1746  
 Alledo, Texas 76008  
 amand@awr-designs.com  
 c. 512.517.5589

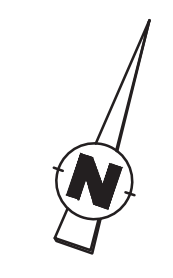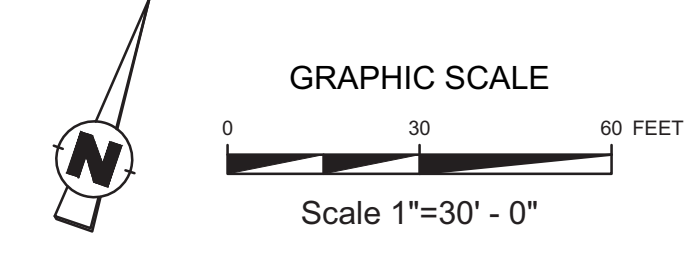




EXISTING TREE				
NO.	CALIPER	TREE SPECIES	REMAIN/REMOVE	NOTES
1	8	LIVE OAK	TO BE REMOVED	MITIGATION 1:1
2	6	LIVE OAK	REMAIN	
3	9	LIVE OAK	REMAIN	
4	8	ELM	REMAIN	
5	10	ELM	REMAIN	
6	12	ELM	REMAIN	
7	14	ELM	REMAIN	
8	7	ELM	REMAIN	
9	8	ELM	TO BE REMOVED	
10	7	LIVE OAK	TO BE REMOVED	
11	8	LIVE OAK	REMAIN	
12	8	LIVE OAK	TO BE REMOVED	
13	10	ELM	REMAIN	
14	9	ELM	REMAIN	
15	9	ELM	REMAIN	
16	7	LIVE OAK	REMAIN	
17	9	LIVE OAK	REMAIN	
18	8	LIVE OAK	REMAIN	
19	12	ELM	REMAIN	
20	7	ELM	REMAIN	
21	7	ELM	REMAIN	
22	8	ELM	REMAIN	
23	9	ELM	REMAIN	
24	4	ELM	REMAIN	
25	8	ELM	REMAIN	
26	10	ELM	REMAIN	
27	6	LIVE OAK	REMAIN	
28	10	ELM	TO BE REMOVED	MITIGATION 1:1
29	10	ELM	TO BE REMOVED	MITIGATION 1:1
30	8	LIVE OAK	TO BE REMOVED	MITIGATION 1:1
31	5	LIVE OAK	TO BE REMOVED	MITIGATION 1:1
32	5	ELM	TO BE REMOVED	MITIGATION 1:1
33	6	LIVE OAK	TO BE REMOVED	MITIGATION 1:1
34	9	LIVE OAK	TO BE REMOVED	MITIGATION 1:1
35	7	LIVE OAK	TO BE REMOVED	MITIGATION 1:1
36	8	LIVE OAK	TO BE REMOVED	MITIGATION 1:1
37	5	LIVE OAK	TO BE REMOVED	MITIGATION 1:1
38	8	LIVE OAK	TO BE REMOVED	MITIGATION 1:1
121	6	ELM	TO BE REMOVED	MITIGATION 1:1
122	6	ELM	TO BE REMOVED	MITIGATION 1:1
123	11	CEDAR	TO BE REMOVED	MITIGATION AT 50%
124	14	ELM	TO BE REMOVED	MITIGATION 1:1
125	7	ELM	TO BE REMOVED	MITIGATION 1:1
126	16	ELM	TO BE REMOVED	MITIGATION 1:1
127	7	ELM	TO BE REMOVED	MITIGATION 1:1
128	11	ELM	TO BE REMOVED	MITIGATION 1:1
129	6	ELM	TO BE REMOVED	MITIGATION 1:1
130	12	OAK	TO BE REMOVED	MITIGATION 1:1
131	36	OAK	TO BE REMOVED	MITIGATION 2:1
132	11	ELM	TO BE REMOVED	MITIGATION 1:1
133	28	OAK	TO BE REMOVED	MITIGATION 1:1
134	7	ELM	TO BE REMOVED	MITIGATION 1:1
135	7	ELM	TO BE REMOVED	MITIGATION 1:1
136	9	ELM	TO BE REMOVED	MITIGATION 1:1

TOTAL ON SITE	1596
TOTAL TO REMAIN	238
TOTAL TO BE REMOVED	1358
CALIPER INCHES TO BE MITIGATED LESS SITE PLANTINGS	1,465
TOTAL CALIPER TO BE PAID INTO TREE FUND (1465" * 2) * 125	\$36,625
REMAINDER OF MITIGATION TO BE COORDINATED WITH PARKS DEPARTMENT FOR A TREE DELIVERY METHOD	


\*\*no credits were given since no trees larger than 24" were kept

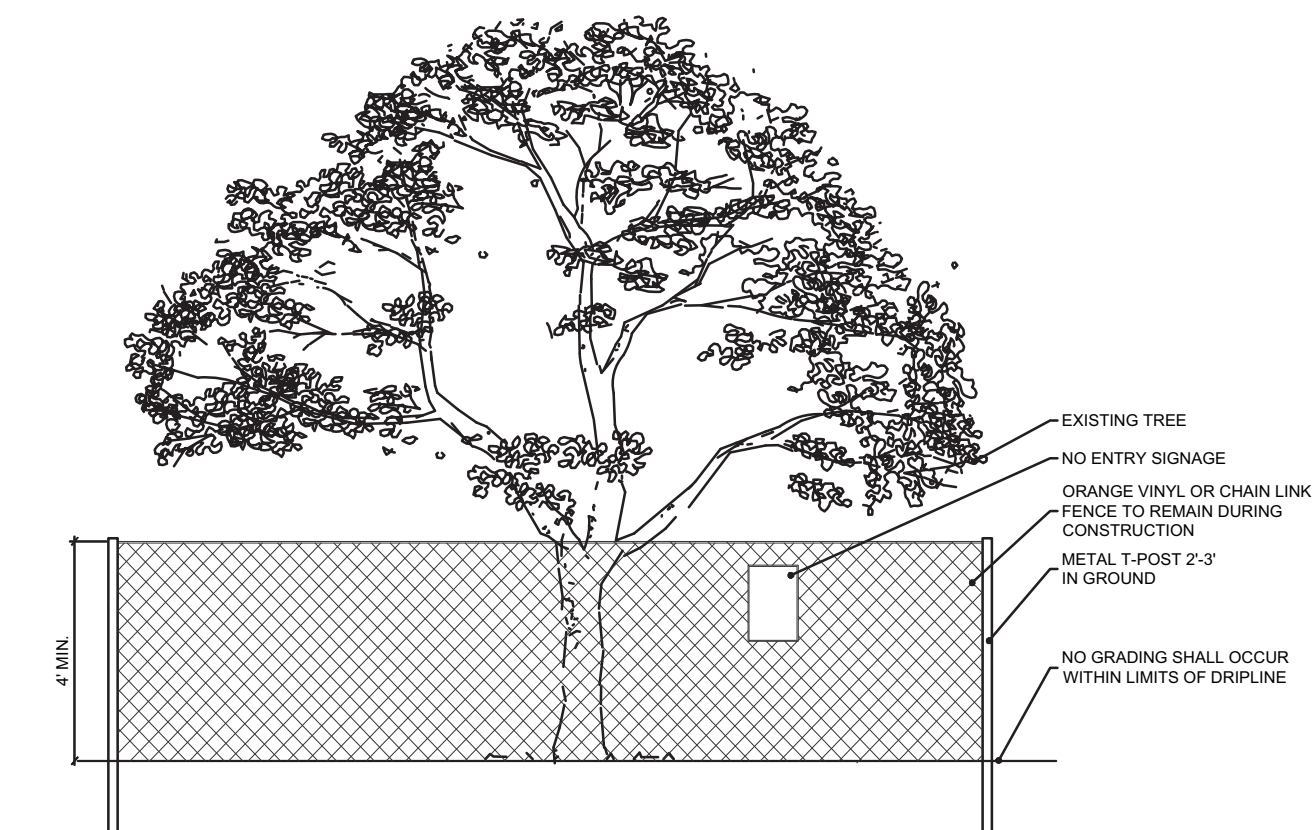


1 TREE PROTECTION FENCING  
N.T.S.

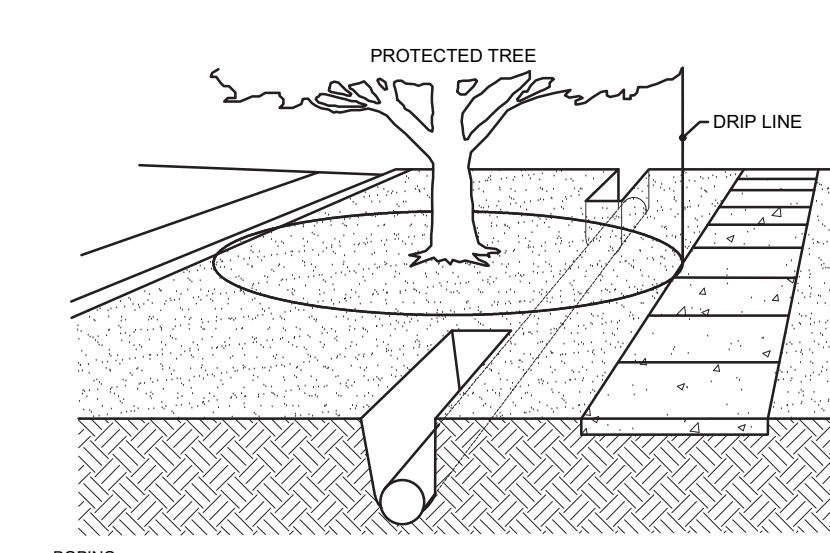

2 BORING AND TUNNELING  
N.T.S.

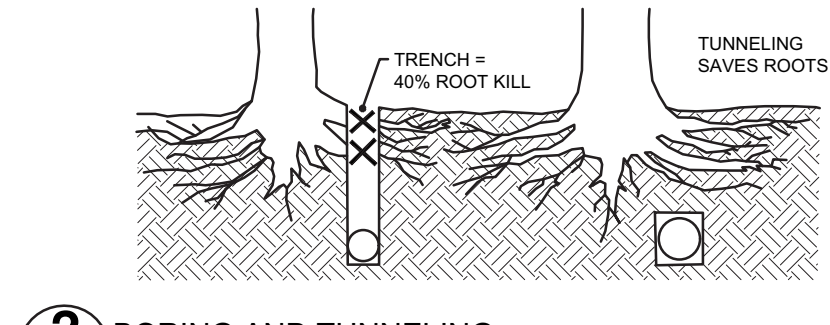

3 BARK PROTECTION  
N.T.S.

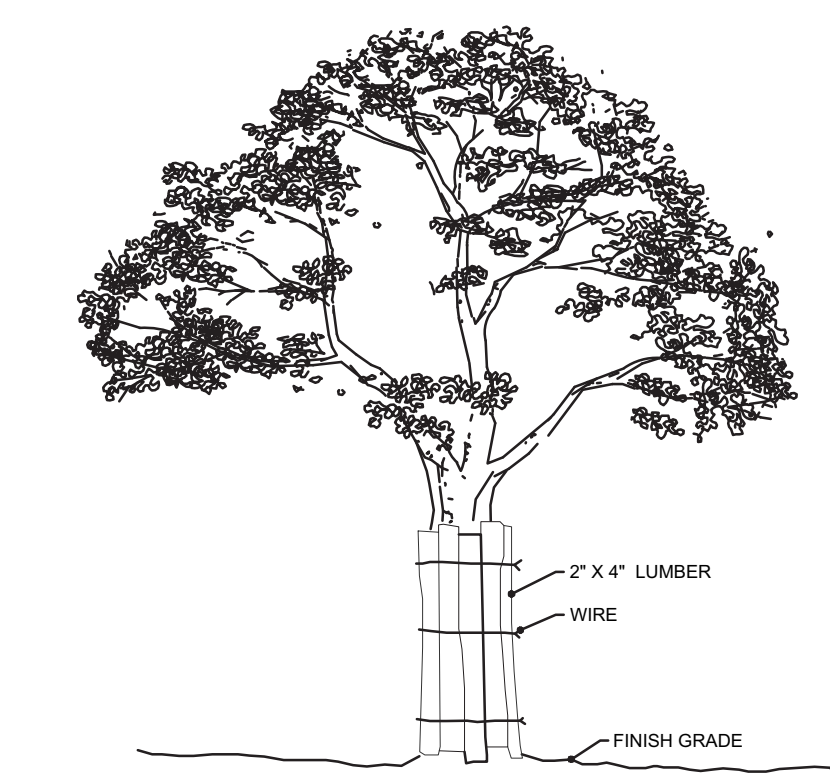

WHERE A PROTECTED TREE REMAINS IN THE IMMEDIATE AREA OF INTENDED CONSTRUCTION, AND THE TREE MAY BE IN DANGER OF BEING DAMAGED BY CONSTRUCTION EQUIPMENT OR OTHER ACTIVITY, THE CONTRACTOR OR SUBCONTRACTOR SHALL PROTECT THE TREE WITH 2\"/>

3 BARK PROTECTION  
N.T.S.

TREE PRESERVATION NOTES

CONSTRUCTION METHODS:

BORING: BORING OF UTILITIES UNDER PROTECTED TREES MAY BE REQUIRED. WHEN REQUIRED, THE MINIMUM LENGTH OF THE BORE SHALL BE THE WIDTH OF THE CRITICAL ROOT ZONE AND SHALL BE A MINIMUM DEPTH OF FORTY (48) INCHES.

TRENCHING: ALL TRENCHING SHALL BE DESIGNED TO AVOID TRENCHING ACROSS CRITICAL ROOT ZONES OF ANY PROTECTED TREE. THE PLACEMENT OF UNDERGROUND UTILITY LINES SUCH AS ELECTRIC, PHONE, GAS, ETC., IS ENCOURAGED TO BE LOCATED OUTSIDE THE CRITICAL ROOT ZONE. TRENCHING FOR IRRIGATION SYSTEMS SHALL BE PLACED OUTSIDE THE CRITICAL ROOT ZONE EXCEPT THE MINIMUM REQUIRED SINGLE HEAD SUPPLY LINE. THIS LINE IS ALLOWED TO EXTEND INTO THE CRITICAL ROOT ZONE PERPENDICULAR TO THE TREE TRUNK WITH THE LEAST POSSIBLE DISTURBANCE.

TREES TO BE REMOVED: ALL TREES TO BE REMOVED FROM THE SITE SHALL BE FLAGGED BY THE CONTRACTOR WITH BRIGHT RED VINYL TAPE WRAPPED AROUND THE MAIN TRUNK AT A HEIGHT OF FOUR (4) FEET ABOVE GRADE.

TREES TO REMAIN: ALL TREES TO REMAIN, AS NOTED ON DRAWINGS, SHALL HAVE PROTECTIVE FENCING LOCATED AT THE TREES DRIP LINE. THE PROTECTIVE FENCING SHALL BE LOCATED AS INDICATED ON THE TREE PROTECTION DETAIL.

EXISTING TREES NOTED TO REMAIN SHALL BE PROTECTED DURING CONSTRUCTION FROM DAMAGE AND COMPACTION OF SOIL UNDER AND AROUND DRIP LINE OF TREE.

UNDER NO CIRCUMSTANCE SHALL THE CONTRACTOR PRUNE ANY PORTION OF THE DAMAGED TREE WITHOUT THE PRIOR APPROVAL BY THE OWNER'S AUTHORIZED REPRESENTATIVE.

PROHIBITED ACTIVITIES IN CRITICAL ROOT ZONE: THE FOLLOWING ACTIVITIES ARE PROHIBITED IN THE AREAS NOTED AS THE CRITICAL ROOT ZONE:

MATERIAL STORAGE: NO MATERIALS INTENDED FOR USE IN CONSTRUCTION, OR WASTE MATERIALS ACCUMULATED DUE TO EXCAVATION OR DEMOLITION, SHALL BE PLACED WITHIN THE LIMITS OF THE CRITICAL ROOT ZONE OF ANY PROTECTED TREE.

EQUIPMENT CLEANING/LIQUID DISPOSAL: NO EQUIPMENT SHALL BE CLEANED, OR OTHER LIQUIDS DEPOSITED OR ALLOWED WITHIN THE LIMITS OF THE CRITICAL ROOT ZONE OF A PROTECTED TREE. THIS INCLUDES, WITHOUT LIMITATION: PAINT, OIL, SOLVENTS, ASPHALT, CONCRETE, MORTAR OR SIMILAR MATERIALS.

TREE ATTACHMENTS: NO SIGNS, WIRES, OR OTHER ATTACHMENTS, OTHER THAN THOSE OF A PROTECTIVE NATURE, SHALL BE ATTACHED TO ANY PROTECTED TREE.

VEHICULAR TRAFFIC: NO VEHICULAR AND/OR CONSTRUCTION EQUIPMENT, TRAFFIC, OR PARKING SHALL TAKE PLACE WITHIN THE LIMITS OF THE CRITICAL ROOT ZONE OF ANY PROTECTED TREE OTHER THAN ON EXISTING STREET PAVEMENT.



GRADE CHANGES: A MINIMUM OF 75% OF THE DRIP LINE AND ROOT ZONE SHALL BE PRESERVED AT NATURAL GRADE. ANY FINE GRADINGS DONE WITHIN THE CRITICAL ROOT ZONES OF THE PROTECTED TREES MUST BE DONE WITH LIGHT MACHINERY SUCH AS A BOBCAT OR LIGHT TRACTOR. NO EARTH MOVING EQUIPMENT WITH TRACKS IS ALLOWED WITHIN THE CRITICAL ROOT ZONE OF THE TREES.

PROCEDURES REQUIRED PRIOR TO CONSTRUCTION:

PROTECTIVE FENCING: PRIOR TO CONSTRUCTION, THE CONTRACTOR OR SUBCONTRACTOR SHALL CONSTRUCT AND MAINTAIN, FOR EACH PROTECTED TREE ON A CONSTRUCTION SITE, A PROTECTIVE FENCING WHICH ENCIRCLES THE OUTER LIMITS OF THE CRITICAL ROOT ZONE OF THE TREE TO PROTECT IT FROM CONSTRUCTION ACTIVITY. ALL PROTECTIVE FENCINGS SHALL BE IN PLACE PRIOR TO COMMENCEMENT OF ANY SITE WORK, AND REMAIN IN PLACE UNTIL ALL EXTERIOR WORK HAS BEEN COMPLETED.

BARK PROTECTION: IN SITUATIONS WHERE A PROTECTED TREE REMAINS IN THE IMMEDIATE AREA OF INTENDED CONSTRUCTION, AND THE LANDSCAPE ARCHITECT OR OWNER'S REPRESENTATIVE DETERMINES THE TREE BARK TO BE IN DANGER OF DAMAGE BY CONSTRUCTION EQUIPMENT OR OTHER ACTIVITY, THE CONTRACTOR OR SUBCONTRACTOR SHALL PROTECT THE TREE BY ENVELOPING THE ENTIRE CIRCUMFERENCE OF THE TREE WITH 2\"/>

VASQUEZ ENGINEERING, L.L.C.  
1919 S. Shiloh Road  
Suite 440, LB 44  
Garland, Texas 75042  
Ph: 972-278-2948  
TX Registration # F-12266

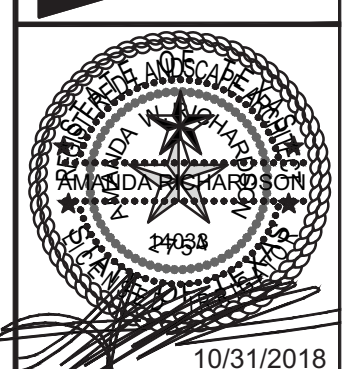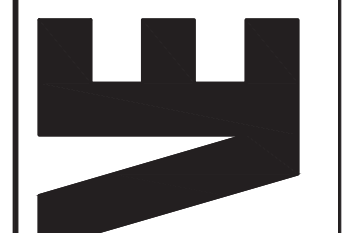

DEVELOPER:  
ROCKWALL INN KEEPERS I, LTD.  
6176 FM 2011  
LONGVIEW, TX 75603

TREE PRESERVATION NOTES  
LOT 1, BLOCK A  
HYATT ROCKWALL ADDITION  
ROCKWALL, TEXAS

Scale: 1" = 30'  
Designed by: AWR  
Drawn by: AWR  
Checked by: AWR  
631-0106@sp1-site-plan.dwg  
Date: 11.7.2017

SHEET  
L1.2


TREE PRESERVATION NOTES  
HYATT ROCKWALL ADDITION  
LOT 1, BLOCK A  
2.681 ACRES  
ROCKWALL, ROCKWALL COUNTY, TEXAS  
NOVEMBER 7, 2017  
CASE #SP2017-033

AWR  
AWR Designs, LLC  
P.O. Box 1746  
Aledo, Texas 76008  
amand@awr-designs.com  
c. 512.517.5589

ENGINEER:  
VASQUEZ ENGINEERING, L.L.C.  
1919 S. SHILOH ROAD, SUITE 440  
GARLAND, TEXAS 75042  
TELE: 972-272-4610  
CONTACT: JUAN J. VASQUEZ, P.E.

OWNER/DEVELOPER:  
ROCKWALL INN KEEPERS I, LTD.  
6176 FM 2011  
LONGVIEW, TEXAS 75603  
TELE: 214-455-5254  
CONTACT: DEEPAK GANDHI



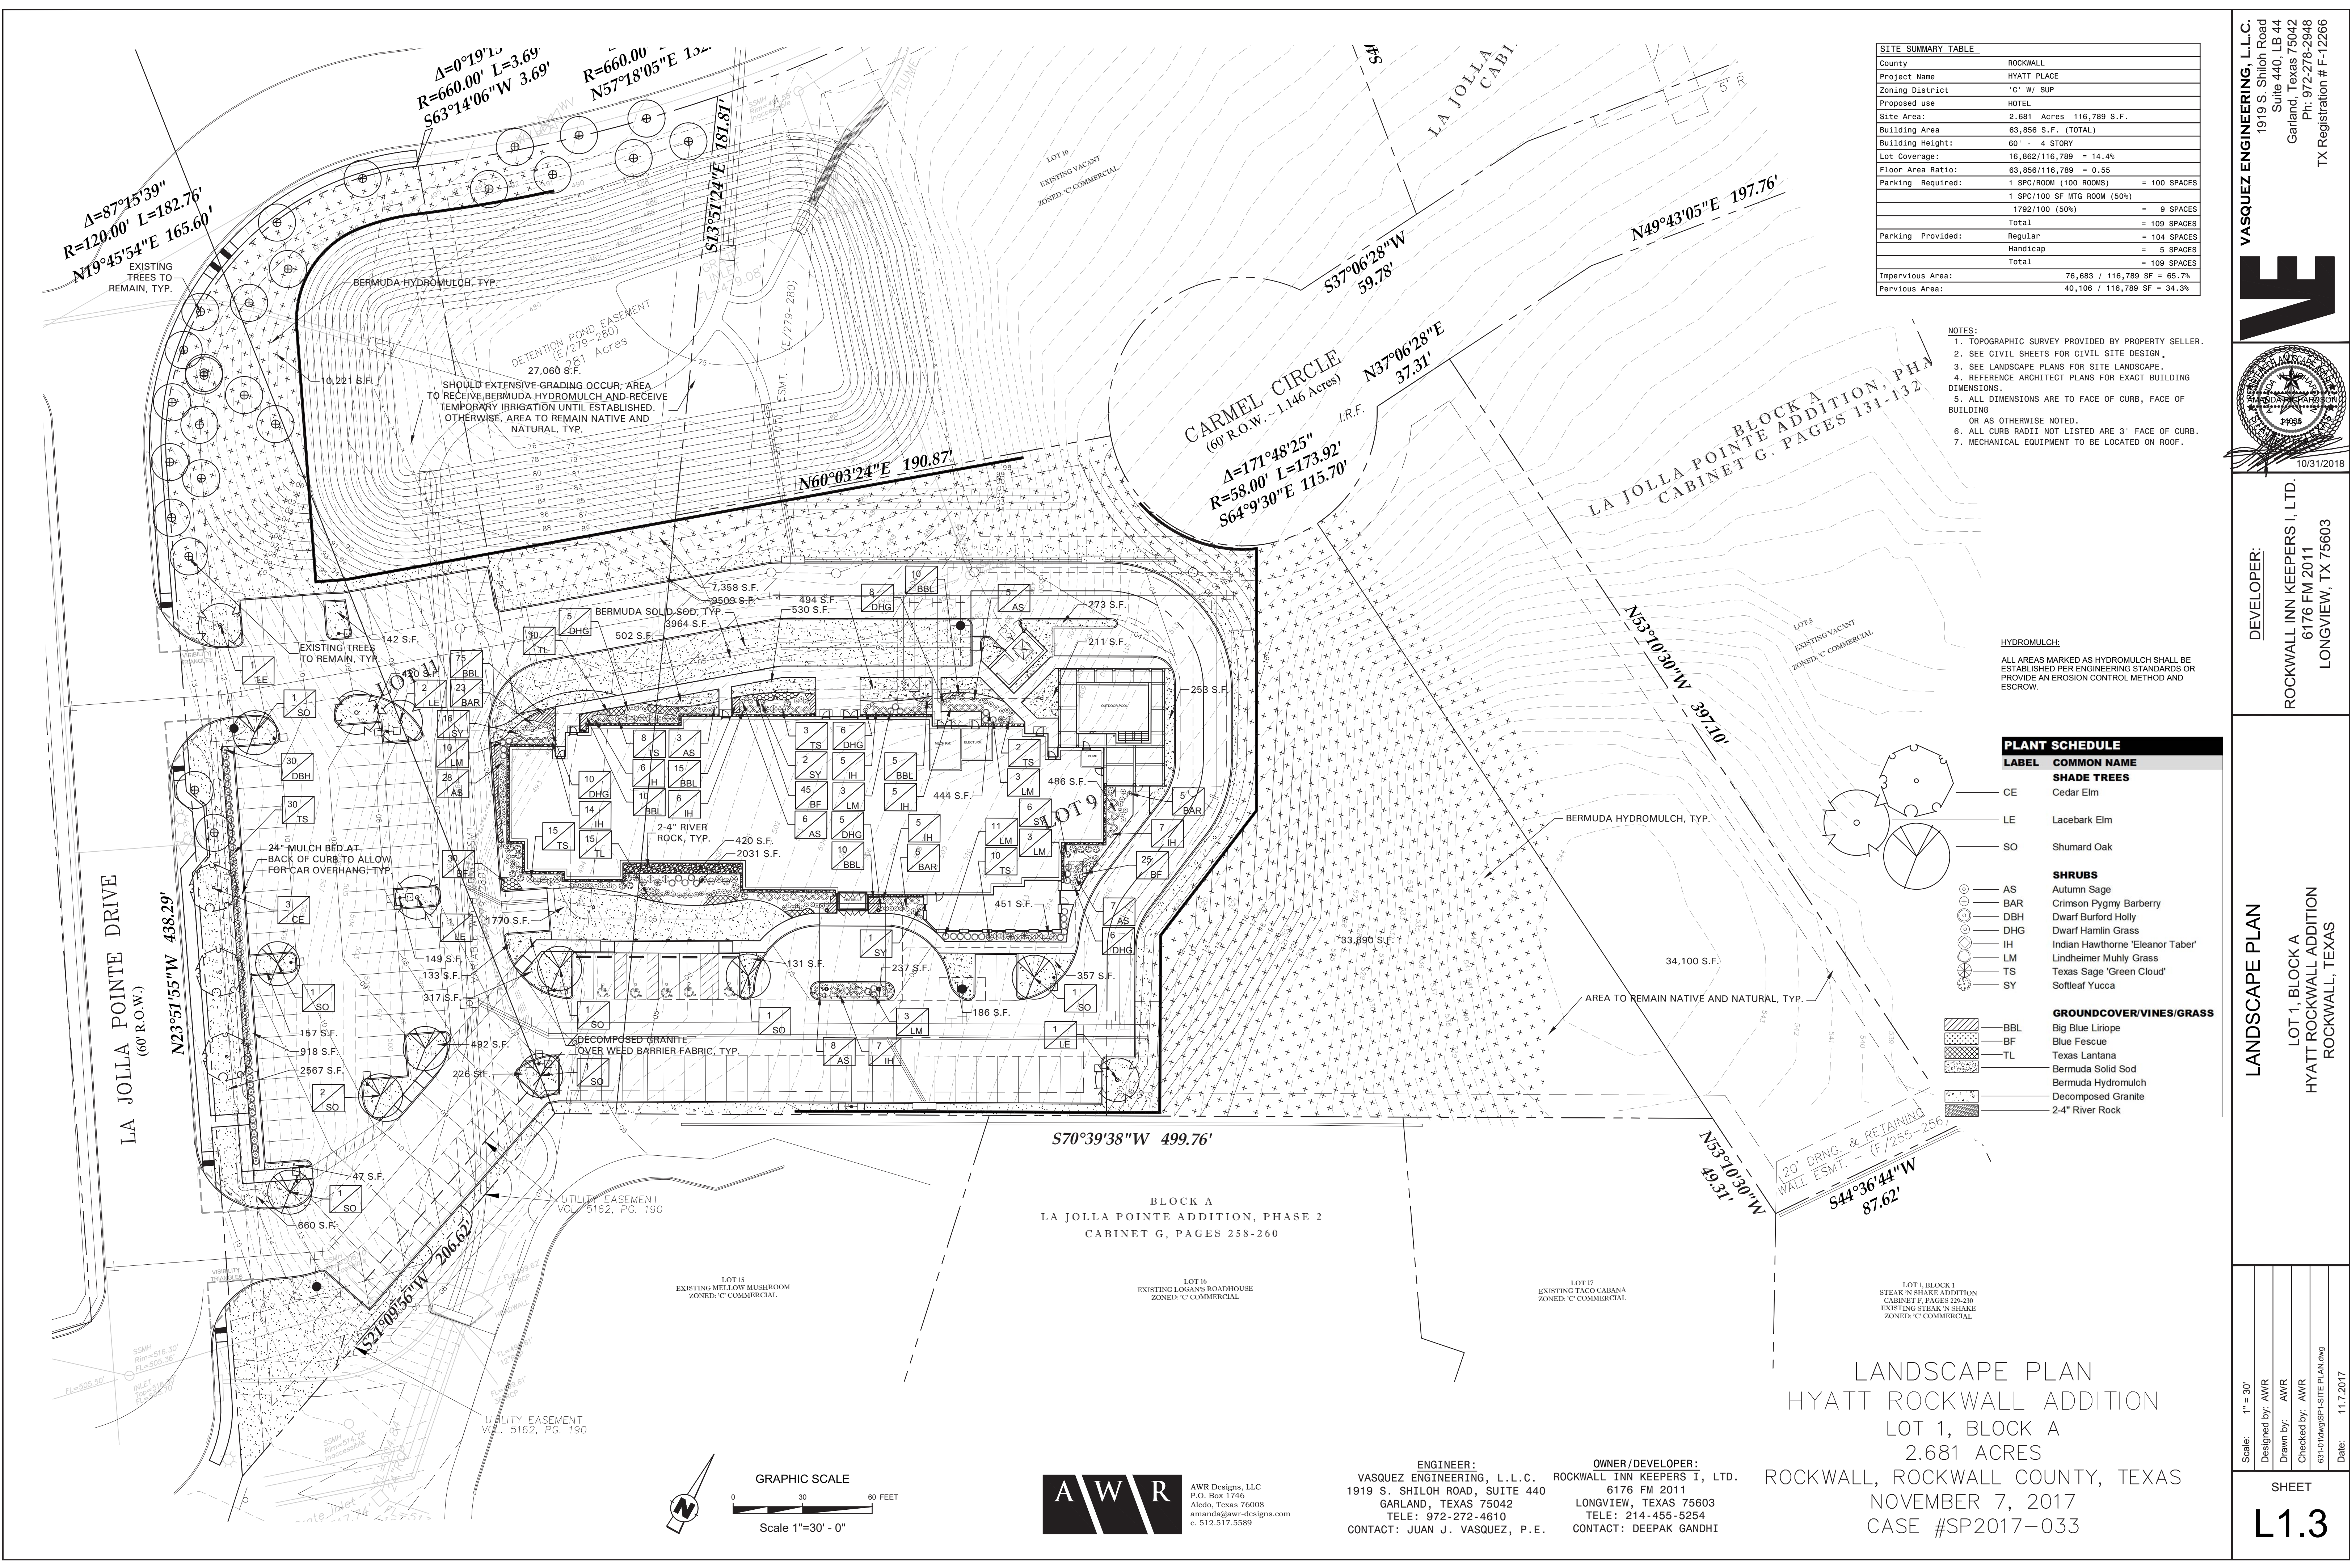

SITE SUMMARY TABLE	
County	ROCKWALL
Project Name	HYATT PLACE
Zoning District	'C' W/ SUP
Proposed use	HOTEL
Site Area:	2.681 Acres 116,789 S.F.
Building Area	63,856 S.F. (TOTAL)
Building Height:	60' - 4 STORY
Lot Coverage:	16,862/116,789 = 14.4%
Floor Area Ratio:	63,856/116,789 = 0.55
Parking Required:	1 SPC/ROOM (100 ROOMS) = 100 SPACES
	1 SPC/100 SF MTG ROOM (50%) = 9 SPACES
	1782/100 (50%) = 109 SPACES
	Total = 109 SPACES
Parking Provided:	Regular = 104 SPACES
	Handicap = 5 SPACES
	Total = 109 SPACES
Impervious Area:	76,683 / 116,789 SF = 65.7%
Pervious Area:	40,106 / 116,789 SF = 34.3%

- NOTES:
1. TOPOGRAPHIC SURVEY PROVIDED BY PROPERTY SELLER.
  2. SEE CIVIL SHEETS FOR CIVIL SITE DESIGN.
  3. SEE LANDSCAPE PLANS FOR SITE LANDSCAPE.
  4. REFERENCE ARCHITECT PLANS FOR EXACT BUILDING DIMENSIONS.
  5. ALL DIMENSIONS ARE TO FACE OF CURB, FACE OF BUILDING OR AS OTHERWISE NOTED.
  6. ALL CURB RADII NOT LISTED ARE 3' FACE OF CURB.
  7. MECHANICAL EQUIPMENT TO BE LOCATED ON ROOF.


**HYDROMULCH:**  
ALL AREAS MARKED AS HYDROMULCH SHALL BE ESTABLISHED PER ENGINEERING STANDARDS OR PROVIDE AN EROSION CONTROL METHOD AND ESCROW.

**PLANT SCHEDULE**

LABEL	COMMON NAME
<b>SHADE TREES</b>	
CE	Cedar Elm
LE	Lacebark Elm
SO	Shumard Oak
<b>SHRUBS</b>	
AS	Autumn Sage
BAR	Crimson Pygmy Barberry
DBH	Dwarf Burford Holly
DHG	Dwarf Hamlin Grass
IH	Indian Hawthorne 'Eleanor Taber'
LM	Lindheimer Muhly Grass
TS	Texas Sage 'Green Cloud'
SY	Softleaf Yucca
<b>GROUNDCOVER/VINES/GRASS</b>	
BBL	Big Blue Liriope
BF	Blue Fescue
TL	Texas Lantana
	Bermuda Solid Sod
	Bermuda Hydromulch
	Decomposed Granite
	2-4" River Rock

LANDSCAPE PLAN  
HYATT ROCKWALL ADDITION  
LOT 1, BLOCK A  
2.681 ACRES  
ROCKWALL, ROCKWALL COUNTY, TEXAS  
NOVEMBER 7, 2017  
CASE #SP2017-033

**VASQUEZ ENGINEERING, L.L.C.**  
1919 S. Shiloh Road  
Suite 440, LB 44  
Garland, Texas 75042  
Ph: 972-278-2948  
TX Registration # F-12286

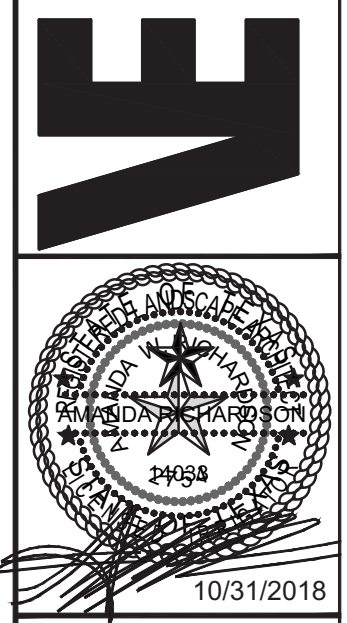

**DEVELOPER:**  
ROCKWALL INN KEEPERS I, LTD.  
6176 FM 2011  
LONGVIEW, TX 75603

**LANDSCAPE PLAN**  
LOT 1, BLOCK A  
HYATT ROCKWALL ADDITION  
ROCKWALL, TEXAS


Scale: 1" = 30'  
Designed by: AWR  
Drawn by: AWR  
Checked by: AWR  
6310\mangsp1 SITE PLAN.dwg  
Date: 11.7.2017

SHEET  
**L1.3**

**AWR**  
AWR Designs, LLC  
P.O. Box 1746  
Aledo, Texas 76008  
amand@awr-designs.com  
c. 512.517.5589

**ENGINEER:**  
VASQUEZ ENGINEERING, L.L.C.  
1919 S. SHILOH ROAD, SUITE 440  
GARLAND, TEXAS 75042  
TELE: 972-272-4610  
CONTACT: JUAN J. VASQUEZ, P.E.

**OWNER/DEVELOPER:**  
ROCKWALL INN KEEPERS I, LTD.  
6176 FM 2011  
LONGVIEW, TEXAS 75603  
TELE: 214-455-5254  
CONTACT: DEEPAK GANDHI

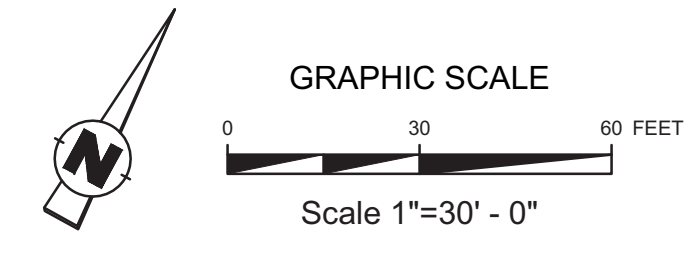



LANDSCAPE TABULATIONS ROCKWALL, TEXAS	
<b>SITE LANDSCAPE REQUIREMENTS</b>	
1. A minimum of 15% of the site shall be landscaped.	
2. No more than 50% of the total requirement shall be located in the front of and along side buildings with street frontage.	
Site: 116,789 s.f.	
REQUIRED	PROVIDED
17,518 s.f. (15%)	40,106 s.f. (34.3%)
<b>STREET LANDSCAPING</b>	
1. A 10' wide landscape buffer shall be provided along the perimeter of the property abutting ROW.	
2. One tree shall be provided for every 50 l.f. of frontage.	
La Jolla Pointe Drive and Laguna Drive - 758 l.f.	
REQUIRED	PROVIDED
10 landscape buffer	10' landscape buffer
15 trees, 3" cal.	13 existing trees, 3"+; 3 proposed trees, 3" cal.
<b>PARKING LOT LANDSCAPE</b>	
1. Surface parking shall be screened from all adjacent public streets and neighboring sites. The screen must extend along all edges and be a min. 3' in height, 80% opaque.	
2. There shall be a landscape island every 10 parking spaces. One shade tree shall be provided for every 10 cars. No parking space shall be located more than 80' from the trunk of a large canopy tree	
Parking spaces: 109	
REQUIRED	PROVIDED
36" screen	36" screen
11 canopy trees, 4" cal.	14 canopy trees, 4" cal.
<b>MITIGATION</b>	
REQUIRED	PROVIDED
1457 caliper inches	owner to pay 125\$ per caliper inch for 20% of the trees. (\$36,425). The remainder to be coordinated with the parks department for a tree delivery method.

**GENERAL LAWN NOTES**

**EROSION CONTROL AND SOIL PREPARATION:**  
THE CONTRACTOR IS RESPONSIBLE FOR MAINTAINING TOP SOIL AT THE CORRECT GRADES. CONTRACTOR TO FINE GRADE AREAS TO REACH FINAL CONTOURS AS SPECIFIED PER CIVIL PLANS. ALL CONTOURS SHOULD ACHIEVE POSITIVE DRAINAGE AWAY FROM BUILDINGS AND STRUCTURES. WATER SHOULD NOT BE ABLE TO POOL IN ANY AREAS UNLESS SPECIFIED OTHERWISE. EROSION FABRIC SUCH AS JUTE MATTING OR OPEN WEAVE TO BE USED WHERE NECESSARY TO PREVENT SOIL EROSION.

ANY LOSS OF TOPSOIL OR GRASS DUE TO EROSION IS THE RESPONSIBILITY OF THE CONTRACTOR UNTIL IT IS 100% ESTABLISHED.

CONTRACTOR TO REMOVE ANY ROCKS 3/4" AND LARGER, STICKS AND DEBRIS PRIOR TO INSTALLATION OF TOPSOIL AND SOD.

FOUR (4) OF TOPSOIL SHALL BE APPLIED TO AREAS DISTURBED BY CONSTRUCTION RECEIVING SOD. IF TOPSOIL IS NOT AVAILABLE ON SITE, THE CONTRACTOR SHALL PROVIDE TOPSOIL AS APPROVED BY THE OWNER OR OWNERS REPRESENTATIVE.

TOPSOIL SHALL BE FRABLE, NATURAL LOAM, FREE OF ROCKS, WEEDS, BRUSH, CLAY LUMPS, ROOTS, TWIGS, LITTER AND ENVIRONMENTAL CONTAMINANTS.

CONTRACTOR SHALL BE RESPONSIBLE FOR SOD UNTIL ACCEPTANCE. THIS SHALL INCLUDE, BUT NOT BE LIMITED TO: MOWING, WATERING, WEEDING, CULTIVATING, CLEANING AND REPLACING DEAD OR BARE AREAS TO KEEP PLANTS IN A VIGOROUS, HEALTHY CONDITION. SOD SHALL BE REPLACED IF NECESSARY.

**SOLID SOD:**  
SOLID SOD SHALL BE PLACED ALONG ALL IMPERVIOUS EDGES, AT A MINIMUM. THIS SHALL INCLUDE CURBS, WALKS, INLETS, MANHOLES AND PLANTING BED AREAS. SOD SHALL COVER OTHER AREAS COMPLETELY AS INDICATED BY PLAN.

SOD SHALL BE STRONGLY ROOTED DROUGHT RESISTANT SOD, NOT LESS THAN 2 YEARS OLD, FREE OF WEEDS AND UNDESIRABLE NATIVE GRASS AND MACHINE CUT TO PAD THICKNESS OF 3/4" (+1/4"), EXCLUDING TOP GROWTH AND THATCH. PROVIDE ONLY SOD CAPABLE OF VIGOROUS GROWTH AND DEVELOPMENT WHEN PLANTED.

DO NOT INSTALL SOD IF IT IS DORMANT OR GROUND IS FROZEN. LAY SOD WITH TIGHTLY FITTING JOINTS. NO OVERLAPS WITH STAGGERED STRIPS TO OFFSET JOINTS.

SOD SHALL BE ROLLED TO CREATE A SMOOTH EVEN SURFACE. SOD SHOULD BE WATERED THOROUGHLY DURING INSTALLATION PROCESS.

SHOULD INSTALLATION OCCUR BETWEEN OCTOBER 1ST AND MARCH 1ST, SOD SHALL INCLUDE AN OVER-SEED OF ANNUAL RYE OR WINTER RYEGRASS AT A RATE OF FOUR POUNDS PER ONE THOUSAND SQUARE FEET FOR A GROWN-IN APPEARANCE. CONTRACTOR SHALL ENSURE CONFORMANCE TO §16.0 OF TITLE 7, PART XXX, HORTICULTURE COMMISSION CHAPTER 1.

**HYDROMULCH:**

SCARIFY SURFACE TO A MINIMUM OF 2" DEPTH PRIOR TO THE IMPORT TOPSOIL APPLICATION. TOP SOIL SHALL BE PLACED 2" IN DEPTH IN ALL AREAS TO BE SEEDED. CONTRACTOR TO SUPPLY HIGH QUALITY IMPORTED TOPSOIL HIGH IN HUMUS AND ORGANIC CONTENT FROM A LOCAL SUPPLY. IMPORTED TOPSOIL SHALL BE REASONABLY FREE OF CLAY LUMPS, COARSE SANDS, STONES, ROOTS AND OTHER FOREIGN DEBRIS.

IF INADEQUATE MOISTURE IS PRESENT IN SOIL, APPLY WATER AS NECESSARY FOR OPTIMUM MOISTURE FOR SEED APPLICATION.

ALL SEED SHALL BE HIGH QUALITY, TREATED LAWN TYPE SEED AND IS FREE OF NOXIOUS GRASS SEEDS. THE SEED APPLICATION SHALL BE UNIFORMLY DISTRIBUTED ON THE AREAS INDICATED ON PLANS. HYDROMULCH WITH BERMUDA GRASS SEED AT A RATE OF TWO POUNDS PER ONE THOUSAND SQUARE FEET.

IF INSTALLATION OCCURS BETWEEN OCTOBER 1ST AND APRIL 1ST, ALL HYDROMULCH AREAS SHALL BE OVER-SEEDED WITH ANNUAL RYE GRASS AT A RATE OF FOUR POUNDS PER ONE THOUSAND SQUARE FEET. CONTRACTOR TO RE-HYDROMULCH WITH BERMUDA GRASS AT THE END OF THE ANNUAL RYE GROWING SEASON.

AFTER APPLICATION, NO EQUIPMENT SHALL OPERATE OVER APPLIED AREAS. WATER SEEDED AREAS IMMEDIATELY AFTER INSTALLATION TO SATURATION.

ALL LAWN AREAS TO BE HYDROMULCHED SHALL ACHIEVE 100% COVERAGE PRIOR TO FINAL ACCEPTANCE.

**HYDROMULCH:**

ALL AREAS MARKED AS HYDROMULCH SHALL BE ESTABLISHED PER ENGINEERING STANDARDS OR PROVIDE AN EROSION CONTROL METHOD AND ESCROW.

**PLANT SCHEDULE**

QTY	LABEL	COMMON NAME	SCIENTIFIC NAME	SIZE	NOTES
<b>SHADE TREES</b>					
3	CE	Cedar Elm	<i>Ulmus crassifolia</i>	3" cal.	12' ht., 4' spread, matching
5	LE	Lacebark Elm	<i>Ulmus parvifolia 'Sempervirens'</i>	4" cal.	14' ht., 4' spread
9	SO	Shumard Oak	<i>Quercus shumardii</i>	4" cal.	14' ht., 5' spread
<b>SHRUBS</b>					
60	AS	Autumn Sage	<i>Salvia greggii</i>	3 gal.	full, 24" o.c.
33	BAR	Crimson Pygmy Barberry	<i>Berberis thunbergii 'Crimson Pygmy'</i>	5 gal.	full, 20" sprd, 24" o.c.
30	DBH	Dwarf Burford Holly	<i>Ilex cornuta 'Burford Nana'</i>	5 gal.	full, 20" spread, 36" o.c.
37	DHG	Dwarf Hamlin Grass	<i>Pennisetum alopecuroides 'Hameln'</i>	5 gal.	full, 18" sprd, 20" ht., 24" o.c.
55	IH	Indian Hawthorne 'Eleanor Taber'	<i>Raphiolepis indica 'Eleanor Taber'</i>	5 gal.	full, 24" spread, 36" o.c.
33	LM	Lindheimer Muhly Grass	<i>Muhlenbergia lindheimeri</i>	5 gal.	full, 24" spread, 36" o.c.
68	TS	Texas Sage 'Green Cloud'	<i>Leucophyllum frutescens 'Green Cloud'</i>	5 gal.	full, 24" sprd, 36" o.c.
25	SY	Softleaf Yucca	<i>Yucca recurvifolia</i>	5 gal.	full, 30" o.c.
<b>GROUNDCOVER/VINES/GRASS</b>					
125	BBL	Big Blue Liriope	<i>Liriope muscari 'Big Blue'</i>	1 gal.	full, 18" o.c.
100	BF	Blue Fescue	<i>Festuca glauca</i>	1 gal.	full, 12" o.c.
25	TL	Texas Lantana	<i>Lantana horrida</i>	1 gal.	full, 18" o.c.
		Bermuda Solid Sod	<i>Cynodon dactylon</i>		
		Bermuda Hydromulch	<i>Cynodon dactylon</i>		
		Decomposed Granite			
		2-4" River Rock			

Plant list is an aid to bidders only. Contractor shall verify all quantities on plan. All heights and spreads are minimums. Trees shall have a strong central leader and be of matching specimens. All plant material shall meet or exceed remarks as indicated.

**LANDSCAPE NOTES**

REFERENCE SITEWORK AND SPECIFICATIONS FOR INFORMATION NEEDED FOR LANDSCAPE WORK.

CONTRACTOR TO VERIFY AND LOCATE ALL PROPOSED AND EXISTING STRUCTURES. NOTIFY LANDSCAPE ARCHITECT OR DESIGNATED REPRESENTATIVE FOR ANY LAYOUT DISCREPANCIES OR ANY CONDITION THAT WOULD PROHIBIT THE INSTALLATION AS SHOWN.

CONTRACTOR SHALL CALL 811 TO VERIFY AND LOCATE ANY AND ALL UTILITIES ON SITE PRIOR TO COMMENCING WORK. LANDSCAPE ARCHITECT SHOULD BE NOTIFIED OF ANY CONFLICTS.

A MINIMUM OF 2% SLOPE SHALL BE PROVIDED AWAY FROM ALL STRUCTURES. LANDSCAPE ISLANDS SHALL BE CROWNED, AND UNIFORM THROUGHOUT THE SITE.

ALL PLANTING AREAS SHALL BE GRADED SMOOTH TO ACHIEVE FINAL CONTOURS AS INDICATED ON PLAN WITH 3" OF TOPSOIL AND 3" OF COMPOST AND CONSISTENTLY BLENDED TO A DEPTH OF 9". ALL BEDS SHALL BE CROWNED TO ANTICIPATE SETTLEMENT AND ENSURE PROPER DRAINAGE.

PLANTING AREAS AND SOD TO BE SEPARATED BY STEEL EDGING. EDGING TO BE GREEN IN COLOR AND A MINIMUM OF 3/16" THICK. EDGING SHALL BE STAKED FROM THE INSIDE OF BED. EDGING NOT TO BE MORE THAN 1/2" ABOVE FINISHED GRADE.

MULCH SHALL BE INSTALLED AT 1/2" BELOW THE TOPS OF SIDEWALKS AND CURBING.

QUANTITIES ON THESE PLANS ARE FOR REFERENCE ONLY. THE SPACING OF PLANTS SHOULD BE AS INDICATED ON PLANS OR OTHERWISE NOTED. ALL TREES AND SHRUBS SHALL BE PLANTED PER DETAILS.

CONTAINER GROWN PLANT MATERIAL IS PREFERRED HOWEVER BURLAP AND BURLAP PLANT MATERIAL CAN BE SUBSTITUTED IF NEEDED AND IS APPROPRIATE TO THE SIZE AND QUALITY INDICATED ON THE PLANT MATERIAL LIST.

TREES SHALL BE PLANTED AT A MINIMUM OF 8' FROM ANY UTILITY LINE, SIDEWALK OR CURB. TREES SHALL ALSO BE 10' CLEAR FROM FIRE HYDRANTS.

4" OF SHREDDED HARDWOOD MULCH (2" SETTLED THICKNESS) SHALL BE PLACED OVER 4:1 OZ WOVEN WEED BARRIER FABRIC OR APPROVED EQUAL WEED BARRIER FABRIC SHALL BE USED IN PLANT BEDS AND AROUND ALL TREES AND SHALL BE DE WITT 'WEED BARRIER' OR APPROVED EQUAL. MULCH SHALL BE SHREDDED BARK OR RUBBER LANDSCAPE MULCH, FINE STRAW MULCH IS PROHIBITED.

CONTRACTOR TO PROVIDE UNIT PRICING OF LANDSCAPE MATERIALS AND BE RESPONSIBLE FOR OBTAINING ALL LANDSCAPE AND IRRIGATION PERMITS.

**IRRIGATION:**  
IN THE ABSENCE OF AN IRRIGATION SYSTEM OR AREAS BEYOND THE COVERAGE LIMITS OF A PERMANENT IRRIGATION SYSTEM, CONTRACTOR SHALL WATER SOD TEMPORARILY, BY ANY MEANS AVAILABLE, TO DEVELOP ADEQUATE GROWTH. TURF SHALL BE IN 100% ESTABLISHMENT AT THE TIME OF ACCEPTANCE.

ALL PLANTING BEDS SHALL HAVE AN AUTOMATIC IRRIGATION SYSTEM WITH A FREEZE/RAIN SENSOR. SYSTEM SHALL ALSO HAVE AN ET WEATHER BASED CONTROLLER AND BE DESIGNED AND INSTALLED BY A LICENSED IRRIGATOR.

**MAINTENANCE REQUIREMENTS:**  
VEGETATION SHOULD BE INSPECTED REGULARLY TO ENSURE THAT PLANT MATERIAL IS ESTABLISHING PROPERLY AND REMAINS IN A HEALTHY GROWING CONDITION APPROPRIATE FOR THE SEASON. IF DAMAGED OR REMOVED, PLANTS MUST BE REPLACED BY A SIMILAR VARIETY AND SIZE.


MOWING, TRIMMING, EDGING AND SUPERVISION OF WATER APPLICATIONS SHALL BE THE RESPONSIBILITY OF THE CONTRACTOR UNTIL THE OWNER OR OWNERS REPRESENTATIVE ACCEPTS AND ASSUMES REGULAR MAINTENANCE.

ALL LANDSCAPE AREAS SHOULD BE CLEANED AND KEPT FREE OF TRASH, DEBRIS, WEEDS AND OTHER MATERIAL.

**MISCELLANEOUS MATERIALS:**

STEEL EDGING SHALL BE 3/16" X 4 X 16" DARK GREEN DURAEDGE STEEL LANDSCAPE EDGING.

**IRRIGATION:**  
IRRIGATION WILL MEET REQUIREMENTS OF UDC.  
**TREES:**  
TREES SHALL BE AT LEAST 5' FROM WATER, SEWER AND STORM LINES.

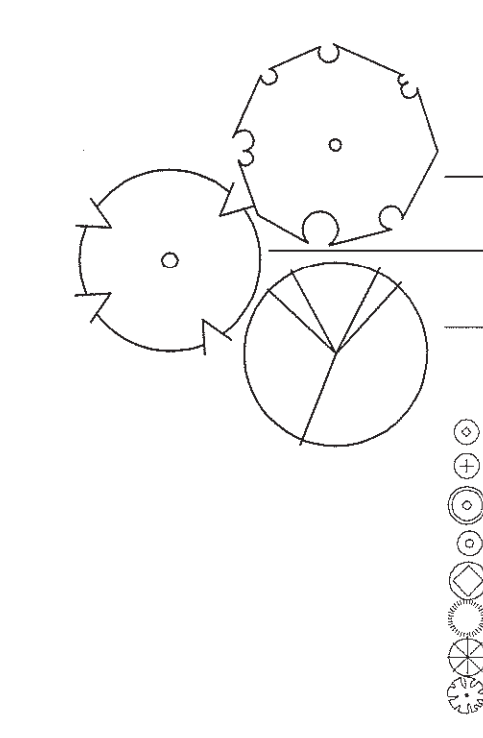

**VASQUEZ ENGINEERING, L.L.C.**  
 1919 S. Shiloh Road  
 Suite 440, LB 44  
 Garland, Texas 75042  
 Ph: 972-275-2948  
 TX Registration # F-12296

**DEVELOPER:**  
**ROCKWALL INN KEEPERS I, LTD.**  
 6176 FM 2011  
 LONGVIEW, TX 75603

**LANDSCAPE NOTES**  
 LOT 1, BLOCK A  
 HYATT ROCKWALL ADDITION  
 ROCKWALL, TEXAS

Scale: 1" = 30'  
 Designed by: AWR  
 Drawn by: AWR  
 Checked by: AWR  
 631-0110avgSP-SITE PLAN.dwg  
 Date: 11.7.2017

SHEET  
**L1.4**

**AWR**  
 AWR Designs, LLC  
 P.O. Box 1746  
 Alledo, Texas 76008  
 amanda@awr-designs.com  
 c. 512.517.5589

**ENGINEER:**  
 VASQUEZ ENGINEERING, L.L.C.  
 1919 S. SHILOH ROAD, SUITE 440  
 GARLAND, TEXAS 75042  
 TELE: 972-272-4610  
 CONTACT: JUAN J. VASQUEZ, P.E.

**OWNER/DEVELOPER:**  
 ROCKWALL INN KEEPERS I, LTD.  
 6176 FM 2011  
 LONGVIEW, TEXAS 75603  
 TELE: 214-455-5254  
 CONTACT: DEEPAK GANDHI

**LANDSCAPE NOTES**  
 HYATT ROCKWALL ADDITION  
 LOT 1, BLOCK A  
 2.681 ACRES  
 ROCKWALL, ROCKWALL COUNTY, TEXAS  
 NOVEMBER 7, 2017  
 CASE #SP2017-033



1.1 QUALIFICATIONS OF THE LANDSCAPE CONTRACTOR.

A. ALL LANDSCAPE WORK SHOWN ON THESE PLANS SHALL BE PERFORMED BY A SINGLE FIRM SPECIALIZING IN LANDSCAPE PLANTING

1.2 REFERENCE DOCUMENTS

A. REFER TO LANDSCAPE PLANS, NOTES, AND DETAILS FOR ADDITIONAL REQUIREMENTS

1.3 SCOPE OF WORK / DESCRIPTION OF WORK

A. WORK COVERED BY THESE SECTIONS INCLUDES THE FURNISHING AND PAYMENT OF ALL MATERIALS, LABOR, SERVICES, EQUIPMENT, LICENSES, TAXES AND ANY OTHER ITEMS THAT ARE NECESSARY FOR THE EXECUTION, INSTALLATION AND COMPLETION OF ALL WORK SPECIFIED HEREIN AND / OR SHOWN ON THE LANDSCAPE PLANS, NOTES, AND DETAILS.

B. ALL WORK SHALL BE PERFORMED IN ACCORDANCE WITH ALL APPLICABLE LAWS, CODES AND REGULATIONS REQUIRED BY AUTHORITIES HAVING JURISDICTION OVER SUCH WORK, INCLUDING ALL INSPECTIONS AND PERMITS REQUIRED BY FEDERAL, STATE AND LOCAL AUTHORITIES IN SUPPLY, TRANSPORTATION AND INSTALLATION OF MATERIALS.

C. THE LANDSCAPE CONTRACTOR SHALL VERIFY THE LOCATION OF ALL UNDERGROUND UTILITY LINES (WATER, SEWER, ELECTRICAL, TELEPHONE, GAS, CABLE, TELEVISION, ETC.) PRIOR TO THE START OF ANY WORK

D. FURNISH ALL LABOR, MATERIALS, EQUIPMENT, AND SERVICES NECESSARY TO PROVIDE ALL WORK COMPLETE IN PLACE AS SHOWN AND SPECIFIED. WORK SHOULD INCLUDE:

- E. PLANTING OF TREES, SHRUBS AND GRASSES
- A. SEEDING
- B. BED PREPARATION AND FERTILIZATION
- C. WATER AND MAINTENANCE UNTIL FINAL ACCEPTANCE
- D. WORK GUARANTEE

1.4 REFERENCES

A. AMERICAN NATIONAL STANDARDS INSTITUTE (ANSI) Z60.1 - NURSERY STOCK

B. TEXAS STATE DEPARTMENT OF AGRICULTURE

C. TEXAS ASSOCIATION OF NURSERYMEN, GRADES AND STANDARDS

1.5 SUBMITTALS

A. PROVIDE REPRESENTATIVE QUANTITIES OF EACH SOIL, MULCH, BED MIX, GRAVEL AND STONE BEFORE INSTALLATION. SAMPLES TO BE APPROVED BY OWNERS REPRESENTATIVE BEFORE USE.

B. SOIL AMENDMENTS AND FERTILIZERS SHOULD BE RESEARCHED AND BASED ON THE SOILS IN THE AREA.

C. BEFORE INSTALLATION, SUBMIT DOCUMENTATION THAT PLANT MATERIALS ARE AVAILABLE AND HAVE BEEN RESERVED. FOR ANY PLANT MATERIAL NOT AVAILABLE, SUBMIT REQUEST FOR SUBSTITUTION.

1.6 JOB CONDITIONS, DELIVERY, STORAGE AND HANDLING

A. GENERAL CONTRACTOR TO COMPLETE WORK BEFORE LANDSCAPE CONTRACTOR TO COMMENCE. ALL PLANTING BED AREAS SHALL BE LEFT THREE INCHES BELOW FINISH GRADE OF SIDEWALKS, DRIVES AND CURBS. ALL AREAS TO RECEIVE SOLID SOD SHALL BE LEFT ONE INCH BELOW THE FINAL GRADE OF WALKS, DRIVES AND CURBS.

B. ALL PACKAGED MATERIALS SHALL BE SEALED IN CONTAINERS SHOWING WEIGHT, ANALYSIS AND NAME OF MANUFACTURER. ALL MATERIALS SHALL BE PROTECTED FROM DETERIORATION IN TRANSIT AND WHILE STORED ON SITE.

C. DELIVER PLANT MATERIALS IMMEDIATELY PRIOR TO INSTALLATION. PLANT MATERIALS SHOULD BE INSTALLED ON THE SAME DAY AS DELIVERED. IF PLANTING CANNOT BE INSTALLED ON THE SAME DAY, PROVIDE ADDITIONAL PROTECTION TO MAINTAIN PLANTS IN A HEALTHY, VIGOROUS CONDITION.

D. STORE PLANT MATERIALS IN SHADE, PROTECT FROM FREEZING AND DRYING

E. KEEP PLANT MATERIALS MOIST AND PROTECT FROM DAMAGE TO ROOT BALLS, TRUNKS AND BRANCHES.

F. PROTECT ROOT BALLS BY HEELING WITH SAWDUST OR OTHER MOISTURE RETAINING MATERIAL IF NOT PLANTED WITHIN 24 HOURS OF DELIVERY.

G. NOTIFY OWNERS REPRESENTATIVE OF DELIVERY SCHEDULE 72 HOURS IN ADVANCE.

H. FOR BALLED AND BURLAPPED PLANTS - DIG AND PREPARE SHIMMENT IN A MANNER THAT WILL NOT DAMAGE ROOTS, BRANCHES, SHAPE, AND FUTURE DEVELOPMENT.

I. CONTAINER GROWN PLANTS - DELIVER PLANTS IN CONTAINER TO HOLD BALL SHAPE AND PROTECT ROOTMASS.

J. STORAGE OF ALL MATERIALS AND EQUIPMENT WILL BE AT THE RISK OF THE LANDSCAPE CONTRACTOR. OWNER WILL NOT BE HELD RESPONSIBLE FOR THEFT OR DAMAGE.

1.7 SEQUENCING

A. INSTALL TREES, SHRUBS, AND LINER STOCK PLANT MATERIALS PRIOR TO INSTALLATION OF LAWN/SOLID SOD.

B. WHERE EXISTING TURF AREAS ARE BEING CONVERTED TO PLANTING BEDS, THE TURF SHALL BE CHEMICALLY ERADICATED TO MINIMIZE REGRASS IN THE FUTURE. AREAS SHALL BE PROPERLY PREPARED WITH AMENDED ORGANIC MATTER.

1.8 WARRANTIES PERIOD, PLANT GUARANTEE, REPLACEMENTS

A. PROVIDE A MINIMUM OF (2) COPIES OF RECORD DRAWINGS TO THE OWNER UPON COMPLETION OF WORK. A RECORD DRAWING IS A RECORD OF ALL CHANGES THAT OCCURRED IN THE FIELD AND THAT ARE DOCUMENTED THROUGH CHANGE ORDERS, ADDENDA, OR CONTRACTOR/CONSULTANT DRAWING MARKUPS.

B. FURNISH WRITTEN WARRANTY THAT PLANT MATERIALS WILL BE IN A HEALTHY, VIGOROUS GROWING CONDITION FOR ONE YEAR (TWELVE MONTHS) AFTER FINAL ACCEPTANCE. DAMAGE DUE TO ACTS OF GOD, VANDALISM, OR NEGLIGENCE BY OWNER IS EXCLUDED.

C. REPLACE DEAD, UNHEALTHY, AND UNSIGHTLY PLANT MATERIAL WITHIN WARRANTY PERIOD UPON NOTIFICATION BY OWNER OR OWNERS REPRESENTATIVE. PLANTS USED FOR REPLACEMENT SHALL BE OF THE SAME SIZE AND KIND AS THOSE ORIGINALLY PLANTED OR SPECIFIED.

D. THE OWNER AGREES THAT FOR THE ONE YEAR WARRANTY PERIOD TO BE EFFECTIVE, HE WILL WATER PLANTS AT LEAST TWICE A WEEK DURING DRY PERIODS.

E. NOTIFY OWNER OR OWNERS REPRESENTATIVE SEVEN DAYS PRIOR TO THE EXPIRATION OF THE WARRANTY PERIOD.

A. REMOVE DEAD, UNHEALTHY AND UNSIGHTLY PLANTS

B. REMOVE GUYING AND STAKING MATERIALS.

1.9 MAINTENANCE

A. MAINTAIN PLANT LIFE AND PLANTING BEDS IMMEDIATELY AFTER PLACEMENT AND FOR MINIMUM 90 DAYS AFTER FINAL ACCEPTANCE.

B. ALL LANDSCAPE MUST BE MAINTAINED AND GRASS MOWED/EDGED ON A WEEKLY SCHEDULE UNTIL ACCEPTANCE BY OWNER.

C. REPLACE DEAD OR DYING PLANTS WITH PLANTS OF SAME SIZE AND SPECIES AS SPECIFIED.

D. REMOVE TRASH, DEBRIS, AND LITTER. WATER, PRUNE, RESTAKE TREES, FERTILIZE, WEED AND APPLY HERBICIDES AND FUNGICIDES AS REQUIRED.

E. REMOVE CLIPPINGS AND DEBRIS FROM SITE PROMPTLY.

F. COORDINATE WITH OPERATION OF IRRIGATION SYSTEM TO ENSURE THAT PLANTS ARE ADEQUATELY WATERED. HAND WATER AREAS NOT RECEIVING ADEQUATE WATER FROM AN IRRIGATION SYSTEM.

G. THE LANDSCAPE CONTRACTOR SHALL MAINTAIN THE IRRIGATION SYSTEM IN ACCORDANCE TO THE MAINTENANCE SERVICE TO ENSURE THE SYSTEM IS IN PROPER WORKING ORDER WITH SCHEDULING ADJUSTMENTS BY SEASON TO MAXIMIZE WATER CONSERVATION.

H. RESET SETTLED PLANTS

I. REAPPLY MULCH TO BARE AND THIN AREAS.

J. SHOULD SEEDED AND/OR SODDED AREAS NOT BE COVERED BY AN AUTOMATIC IRRIGATION SYSTEM, THE LANDSCAPE CONTRACTOR SHALL

BE RESPONSIBLE FOR WATERING THESE AREAS AND OBTAINING A FULL, HEALTHY STAND OF GRASS AT NO ADDITIONAL COST TO THE OWNER.

K. TO ACHIEVE FINAL ACCEPTANCE AT THE END OF THE MAINTENANCE PERIOD, ALL OF THE FOLLOWING CONDITIONS MUST OCCUR:

A. THE LANDSCAPE SHALL SHOW ACTIVE, HEALTHY GROWTH (WITH EXCEPTIONS MADE FOR SEASONAL DORMANCY). ALL PLANTS NOT MEETING THIS CONDITION SHALL BE REJECTED AND REPLACED BY HEALTHY PLANT MATERIAL PRIOR TO FINAL ACCEPTANCE.

B. ALL HARDSCAPE SHALL BE CLEANED PRIOR TO FINAL ACCEPTANCE.

C. SODDED AREAS MUST BE ACTIVELY GROWING AND MUST REACH A MINIMUM HEIGHT OF 1 1/2 INCHES BEFORE FIRST MOWING. HYDROMULCHED AREAS SHALL SHOW ACTIVE, HEALTHY GROWTH. BARE AREAS LARGER THAN TWELVE SQUARE INCHES MUST BE RESEED (AS APPROPRIATE) PRIOR TO FINAL ACCEPTANCE. ALL SODDED TURF SHALL BE NEATLY MOWED.

2.2 ACCESSORIES/MISCELLANEOUS MATERIALS

A. MULCH - DOUBLE SHARDED HARDWOOD MULCH, PARTIALLY DECOMPOSED BY LIVING EARTH TECHNOLOGIES OR APPROVED SUBSTITUTE. MULCH SHOULD BE FREE OF STICKS, STONES, CLAY, GROWTH AND GERMINATION INHIBITING INGREDIENTS.

B. FERTILIZER - COMMERCIAL FERTILIZER CONTAINING 10-20-10 OR SIMILAR ANALYSIS.

C. SOIL PREPARATION - SHALL BE FERTILE, LOAMY SOIL. ORGANIC MATTER SHALL ENCOMPASS BETWEEN 3% AND 10% OF THE TOTAL DRY WEIGHT. SOIL SHALL BE FREE FROM SUBSOIL, REFUSE, ROOTS, HEAVY OR STIFF CLAY, STONES LARGER THAN 1", NOXIOUS WEEDS, STICKS, BRUSH, LITTER AND OTHER SUBSTANCES. IT SHOULD BE SUITABLE FOR THE GERMINATION OF SEEDS AND THE SUPPORT OF VEGETATIVE GROWTH. THE PH VALUE SHOULD BE BETWEEN 4 AND 7.

D. EXISTING TOPSOIL - MAY BE USED IF IT MEETS THE REQUIREMENTS FOR THE IMPORTED TOPSOIL OR IF APPROVED BY THE LANDSCAPE ARCHITECT OR OWNERS REPRESENTATIVE. TOPSOIL SHALL NOT BE STRIPPED, TRANSPORTED OR GRADED IF MOISTURE CONTENT EXCEEDS FIELD CAPACITY. TOPSOIL STOCKPILES SHALL BE PROTECTED FROM EROSION OR CONTAMINATION.

E. ALL NEW TURF AREAS LOCATED ON THE FRONT, SIDES, REAR, AND INSIDE THE FIRE LANE SHALL BE SODDED AND SHALL BE AMENDED WITH QUALITY TOPSOIL AT A MINIMUM DEPTH OF FOUR INCHES.

F. STEEL EDGING - SHALL BE 3/16" X 4" X 16" DARK GREEN LANDSCAPE EDGING.

G. TREE STAKING - TREE STAKING SOLUTIONS OR APPROVED SUBSTITUTE; REFER TO DETAILS.

H. FILTER FABRIC - MIRAFI 1405 BY MIRAFI INC. OR APPROVED SUBSTITUTE. I. SAND - UNIFORMLY GRADED, WASHED, CLEAN BANK RUN SAND.

J. DECOMPOSED GRANITE - BASE MATERIAL OF NATURAL MATERIAL MIX OF GRANITE AGGREGATE NOT TO EXCEED 1/8" IN DIAMETER.

K. RIVER ROCK - LOCALLY ARIZONA RIVER ROCK BETWEEN 2"-4" IN DIAMETER.

L. PRE-EMERGENT HERBICIDES - ANY GRANULAR, NON-STAINING PRE-EMERGENT HERBICIDE THAT IS LABELED FOR THE SPECIFIC ORNAMENTALS OR TURF ON WHICH IT WILL BE UTILIZED.

PRE-EMERGENT HERBICIDES SHALL BE APPLIED PER THE MANUFACTURERS LABELED RATES.

PART 3 - EXECUTION

3.1 PREPARATION

A. BEFORE STARTING WORK, THE LANDSCAPE CONTRACTOR SHALL VERIFY THAT THE GRADE OF ALL LANDSCAPE AREAS ARE WITHIN +/- 0.1% OF FINISH GRADE. THE CONTRACTOR SHALL NOTIFY THE OWNER IMMEDIATELY SHOULD ANY DISCREPANCIES EXIST.

B. SOIL TESTING

A. AFTER FINISH GRADES HAVE BEEN ESTABLISHED, CONTRACTOR SHALL HAVE SOIL SAMPLES TESTED BY AN ESTABLISHED SOIL TESTING LABORATORY FOR THE FOLLOWING: SOIL TEXTURAL CLASS, GENERAL SOIL FERTILITY, PH, ORGANIC MATTER CONTENT, SALT (EC), LIME, SODIUM ADSORPTION RATIO (SAR) AND BORON CONTENT. EACH SAMPLE SUBMITTED SHALL CONTAIN NO LESS THAN ONE QUART OF SOIL.

B. CONTRACTOR SHALL ALSO SUBMIT THE PROJECTS PLANT LIST TO THE LABORATORY ALONG WITH THE SOIL SAMPLES.

C. THE SOIL REPORT PRODUCED BY THE LABORATORY SHALL CONTAIN RECOMMENDATIONS FOR THE FOLLOWING (AS APPROPRIATE): GENERAL SOIL PREPARATION AND BACKFILL MIXES, PRE-PLANT FERTILIZER APPLICATIONS, AND ANY OTHER SOIL RELATED ISSUES. THE REPORT SHALL ALSO PROVIDE A FERTILIZER PROGRAM FOR THE ESTABLISHMENT PERIOD AND FOR LONG-TERM MAINTENANCE.

D. THE CONTRACTOR SHALL INSTALL SOIL AMENDMENTS AND FERTILIZERS PER THE SOIL REPORT RECOMMENDATIONS. ANY CHANGE IN COST DUE TO THE SOIL REPORT RECOMMENDATIONS, EITHER INCREASE OR DECREASE, SHALL BE SUBMITTED TO THE OWNER WITH THE REPORT.

E. WEEDS ARE GROWING IN PLANTING AREAS, APPLY HERBICIDE RECOMMENDED BY MANUFACTURER AND APPLIED BY AN APPROVED LICENSED APPLICATOR. ALLOW WEEDS TO DIE, AND THEN GRUB OUT ROOTS TO A MINIMUM OF 1/2 INCH DEPTH.

F. PREPARE NEW PLANTING BEDS BY TILLING EXISTING SOIL TO A DEPTH OF SIX INCHES PRIOR TO PLACING COMPOST AND FERTILIZER. ADD SIX INCHES OF COMPOST AND TILL INTO A DEPTH OF SIX INCHES OF THE TOPSOIL.

G. POSITION TREES AND SHRUBS AS DESIGNED ON PLAN. OBTAIN OWNERS REPRESENTATIVE'S APPROVAL PRIOR TO PROCEEDING.

H. ALL PLANTING AREAS SHALL RECEIVE A MINIMUM OF 2 INCH LAYER OF MULCH (SEE DETAIL THICKNESS).

3.2 EXCAVATING

A. EXCAVATE PITS FOR PLANTING. TREE PITS SHALL BE LARGE ENOUGH TO PERMIT THE HANDLING OF THE ROOT BALL WITHOUT DAMAGE TO THE ROOTS. TREES SHALL BE PLANTED AT A DEPTH THAT WHEN SETTLED, THE CROWN OF THE PLANT SHALL BEAR THE SAME RELATIONSHIP TO THE FINISH GRADE AS IT DID TO THE SOIL SURFACE IN ORIGINAL PLACE OF GROWTH.

B. TREE PITS PERCOLATION TEST: FILL PIT WITH WATER AND ALLOW TO STAND FOR 24 HOURS. IF PIT DOES NOT DRAIN, THE TREE NEEDS TO BE MOVED TO ANOTHER LOCATION OR HAVE DRAINAGE ADDED.

C. SHRUB AND TREE PITS SHALL BE NO LESS THAN 24" WIDER THAN THE ROOT BALL AND 6" DEEPER THAN ITS VERTICAL DIMENSION. HOLES SHOULD BE ROUGH, NOT SMOOTH OR GLAZED.

3.3 PLANTING

A. REMOVE NURSERY TAGS AND STAKES FROM ALL PLANTS

B. REMOVE CONTAINERS WITHOUT DAMAGE TO ROOTS.

C. REMOVE BOTTOM OF PLANT BOXES PRIOR TO PLACING PLANTS. REMOVE SIDES AFTER PLACEMENT AND PARTIAL BACKFILLING.

D. REMOVE UPPER THIRD OF BURLAP FROM BALLED AND BURLAPPED TREES AFTER PLACEMENT.

E. PLACE PLANT UPRIGHT AND PLUMB IN CENTER OF HOLE. ORIENT PLANTS FOR BEST APPEARANCE.

F. SET PLANTS WITH TOP OF ROOT BALLS FLUSH WITH ADJACENT GRADE AFTER COMPACTION. ADJUST PLANT HEIGHT IF SETTLEMENT OCCURS AFTER BACKFILLING.

G. BACKFILL HOLES IMMEDIATELY AFTER PLANT IS PLACED USING BACKFILL MIX. BACKFILL TO ONE HALF DEPTH. FILL HOLE WITH WATER AND LIGHTLY TAMP SOIL TO REMOVE VOIDS AND AIR POCKETS.

H. TRIM PLANTS TO REMOVE DEAD AND INJURED BRANCHES ONLY. BRACE PLANTS OVER 45 GALLONS IN SIZE.

I. MULCH TO THE TOP OF THE ROOT BALL. DO NOT PLANT GRASS ALL THE WAY TO TRUNK OF THE TREE. MULCH WITH AT LEAST 2" OF SPECIFIED MULCH.

J. DO NOT WRAP TREES.

K. DO NOT OVER PRUNE.

L. BLOCKS OF SOD SHOULD BE LAID JOINT TO JOINT AFTER FERTILIZING THE GROUND FIRST. ROLL GRASS AREAS TO ACHIEVE A SMOOTH, EVEN SURFACE. THE JOINTS BETWEEN BLOCKS SHOULD BE FILLED WITH TOPSOIL AND THEN WATERED THOROUGHLY.

3.4 STEEL EDGING

A. STEEL EDGING SHALL BE INSTALLED AND ALIGNED AS INDICATED ON PLANS. OWNERS REPRESENTATIVE TO APPROVE THE STAKED OR PAINTED LOCATION OF STEEL EDGE PRIOR TO INSTALLATION

B. ALL STEEL EDGING SHALL BE FREE OF BENDS OR KINKS.

C. TOP OF EDGING SHALL BE 1/2" MAXIMUM HEIGHT ABOVE FINAL FINISHED GRADE.

D. STAKES ARE TO BE INSTALLED ON THE PLANTING BED SIDE OF THE EDGING, NOT THE GRASS SIDE.

E. STEEL EDGING SHALL NOT BE INSTALLED ALONG SIDEWALKS OR CURBS.

F. EDGING SHOULD BE CUT AT A 45 DEGREE ANGLE WHERE IT MEETS SIDEWALKS OR CURBS.

3.5 CLEANUP

A. REMOVE CONTAINERS, TRASH, RUBBISH AND EXCESS SOILS FROM SITE AS WORK PROGRESSES.

B. REPAIR RUTS, HOLES AND SCARES IN GROUND SURFACES.

C. PREMISES SHALL BE KEPT NEAT AT ALL TIMES AND ORGANIZED.

D. ALL PAVED AREAS SHOULD BE CLEANED AT THE END OF EACH WORK DAY.

3.6 ACCEPTANCE







A. ENSURE THAT WORK IS COMPLETE AND PLANT MATERIALS ARE IN VIGOROUS AND HEALTHY GROWING CONDITION.

B. UPON COMPLETION OF THE WORK, THE LANDSCAPE CONTRACTOR SHALL PROVIDE THE SITE CLEAN, FREE OF DEBRIS AND TRASH, AND SUITABLE FOR USE AS INTENDED. THE LANDSCAPE CONTRACTOR SHALL THEN REQUEST AN INSPECTION BY THE OWNER TO DETERMINE FINAL ACCEPTABILITY.

C. WHENIF THE INSPECTED PLANTING WORK DOES NOT COMPLY WITH THE CONTRACT DOCUMENTS, THE LANDSCAPE CONTRACTOR SHALL REPLACE AND/OR REPAIR THE REJECTED WORK TO THE OWNERS SATISFACTION WITHIN 24 HOURS.

D. THE LANDSCAPE MAINTENANCE PERIOD WILL NOT COMMENCE UNTIL THE LANDSCAPE WORK HAS BEEN REINSPECTED BY THE OWNER AND FOUND TO BE ACCEPTABLE. AT THAT TIME, A WRITTEN NOTICE OF FINAL ACCEPTANCE WILL BE ISSUED BY THE OWNER, AND THE MAINTENANCE AND GUARANTEE PERIODS WILL COMMENCE.

END OF SECTION

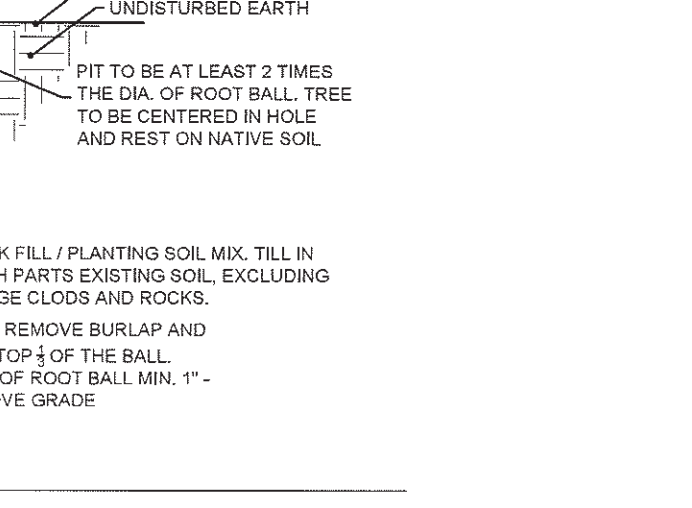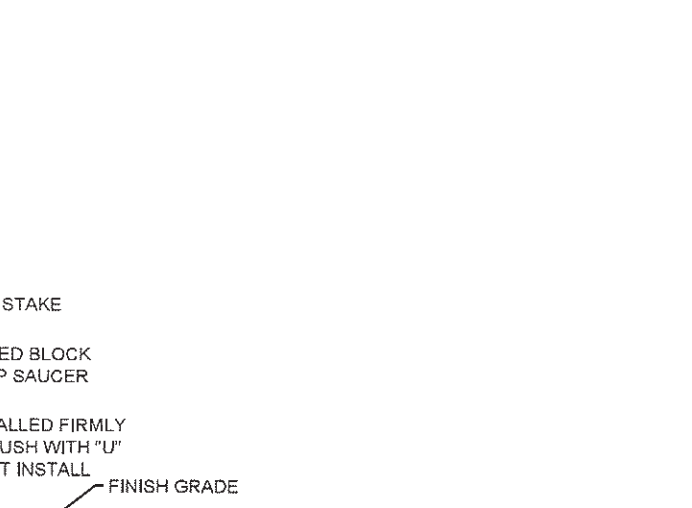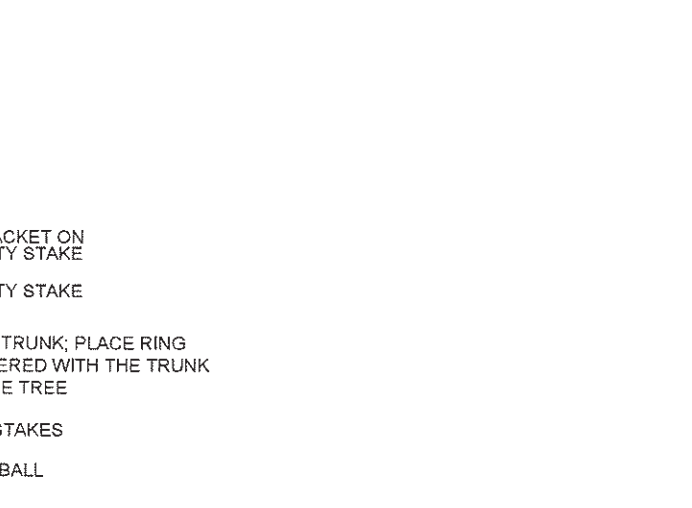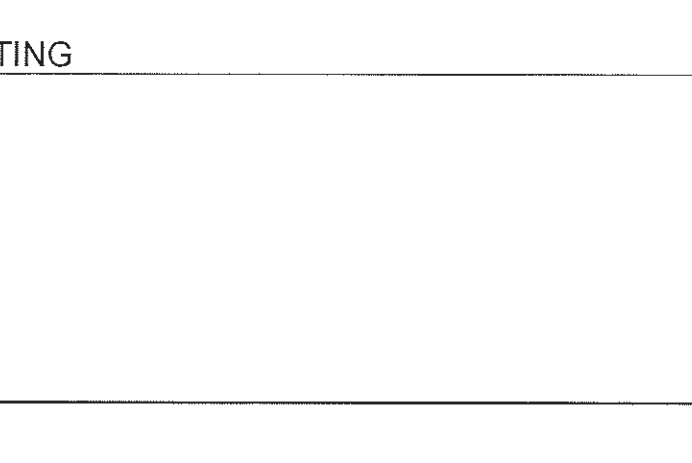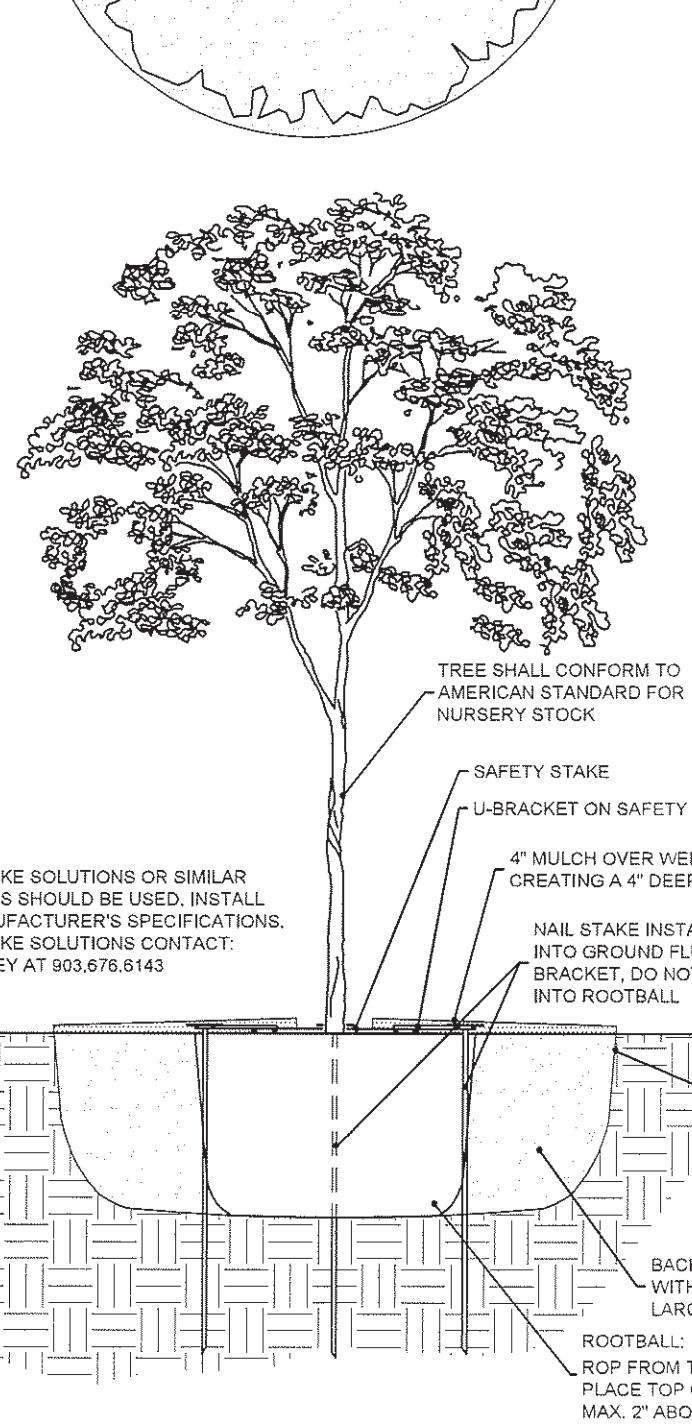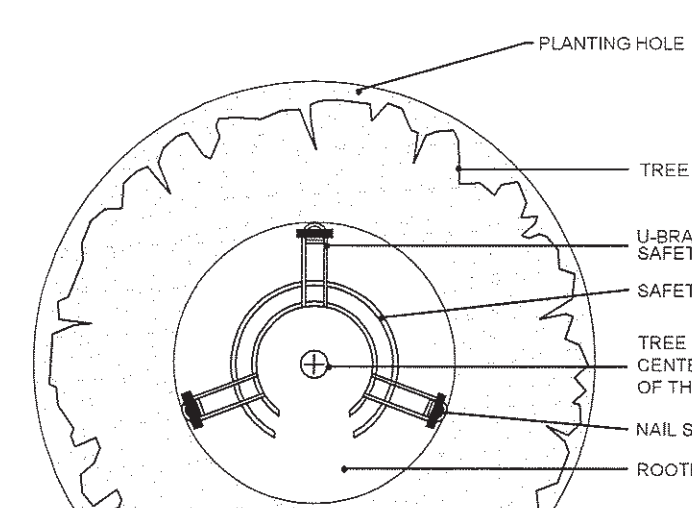

SECTION 32 3000 - LANDSCAPE  
PART 1 - GENERAL  
1.1 QUALIFICATIONS OF THE LANDSCAPE CONTRACTOR.  
A. ALL LANDSCAPE WORK SHOWN ON THESE PLANS SHALL BE PERFORMED BY A SINGLE FIRM SPECIALIZING IN LANDSCAPE PLANTING  
1.2 REFERENCE DOCUMENTS  
A. REFER TO LANDSCAPE PLANS, NOTES, AND DETAILS FOR ADDITIONAL REQUIREMENTS  
1.3 SCOPE OF WORK / DESCRIPTION OF WORK  
A. WORK COVERED BY THESE SECTIONS INCLUDES THE FURNISHING AND PAYMENT OF ALL MATERIALS, LABOR, SERVICES, EQUIPMENT, LICENSES, TAXES AND ANY OTHER ITEMS THAT ARE NECESSARY FOR THE EXECUTION, INSTALLATION AND COMPLETION OF ALL WORK SPECIFIED HEREIN AND / OR SHOWN ON THE LANDSCAPE PLANS, NOTES, AND DETAILS.  
B. ALL WORK SHALL BE PERFORMED IN ACCORDANCE WITH ALL APPLICABLE LAWS, CODES AND REGULATIONS REQUIRED BY AUTHORITIES HAVING JURISDICTION OVER SUCH WORK, INCLUDING ALL INSPECTIONS AND PERMITS REQUIRED BY FEDERAL, STATE AND LOCAL AUTHORITIES IN SUPPLY, TRANSPORTATION AND INSTALLATION OF MATERIALS.  
C. THE LANDSCAPE CONTRACTOR SHALL VERIFY THE LOCATION OF ALL UNDERGROUND UTILITY LINES (WATER, SEWER, ELECTRICAL, TELEPHONE, GAS, CABLE, TELEVISION, ETC.) PRIOR TO THE START OF ANY WORK  
D. FURNISH ALL LABOR, MATERIALS, EQUIPMENT, AND SERVICES NECESSARY TO PROVIDE ALL WORK COMPLETE IN PLACE AS SHOWN AND SPECIFIED. WORK SHOULD INCLUDE:  
E. PLANTING OF TREES, SHRUBS AND GRASSES  
A. SEEDING  
B. BED PREPARATION AND FERTILIZATION  
C. WATER AND MAINTENANCE UNTIL FINAL ACCEPTANCE  
D. WORK GUARANTEE  
1.4 REFERENCES  
A. AMERICAN NATIONAL STANDARDS INSTITUTE (ANSI) Z60.1 - NURSERY STOCK  
B. TEXAS STATE DEPARTMENT OF AGRICULTURE  
C. TEXAS ASSOCIATION OF NURSERYMEN, GRADES AND STANDARDS  
1.5 SUBMITTALS  
A. PROVIDE REPRESENTATIVE QUANTITIES OF EACH SOIL, MULCH, BED MIX, GRAVEL AND STONE BEFORE INSTALLATION. SAMPLES TO BE APPROVED BY OWNERS REPRESENTATIVE BEFORE USE.  
B. SOIL AMENDMENTS AND FERTILIZERS SHOULD BE RESEARCHED AND BASED ON THE SOILS IN THE AREA.  
C. BEFORE INSTALLATION, SUBMIT DOCUMENTATION THAT PLANT MATERIALS ARE AVAILABLE AND HAVE BEEN RESERVED. FOR ANY PLANT MATERIAL NOT AVAILABLE, SUBMIT REQUEST FOR SUBSTITUTION.  
1.6 JOB CONDITIONS, DELIVERY, STORAGE AND HANDLING  
A. GENERAL CONTRACTOR TO COMPLETE WORK BEFORE LANDSCAPE CONTRACTOR TO COMMENCE. ALL PLANTING BED AREAS SHALL BE LEFT THREE INCHES BELOW FINISH GRADE OF SIDEWALKS, DRIVES AND CURBS. ALL AREAS TO RECEIVE SOLID SOD SHALL BE LEFT ONE INCH BELOW THE FINAL GRADE OF WALKS, DRIVES AND CURBS. CONSTRUCTION DEBRIS SHALL BE REMOVED PRIOR TO LANDSCAPE CONTRACTOR BEGINNING WORK.  
B. ALL PACKAGED MATERIALS SHALL BE SEALED IN CONTAINERS SHOWING WEIGHT, ANALYSIS AND NAME OF MANUFACTURER. ALL MATERIALS SHALL BE PROTECTED FROM DETERIORATION IN TRANSIT AND WHILE STORED ON SITE.  
C. DELIVER PLANT MATERIALS IMMEDIATELY PRIOR TO INSTALLATION. PLANT MATERIALS SHOULD BE INSTALLED ON THE SAME DAY AS DELIVERED. IF PLANTING CANNOT BE INSTALLED ON THE SAME DAY, PROVIDE ADDITIONAL PROTECTION TO MAINTAIN PLANTS IN A HEALTHY, VIGOROUS CONDITION.

1 TREE PLANTING  
N.T.S.

2 SHRUB SPACING AND PLANTING AT B.O.C.  
N.T.S.

3 SHRUB SPACING AND PLANTING AT B.O.C.  
N.T.S.

4 STEEL EDGING DETAIL  
N.T.S.

5 DECOMPOSED GRANITE / RIVER ROCK  
N.T.S.

VASQUEZ ENGINEERING, L.L.C.  
1919 S. Shiloh Road  
Suite 440, LB 44  
Garland, Texas 75042  
Ph. 972-278-2948  
TX Registration # F-12266



DEVELOPER:  
ROCKWALL INN KEEPERS I, LTD.  
6176 FM 2011  
LONGVIEW, TX 75603

LANDSCAPE SPECIFICATIONS AND DETAILS  
LOT 1, BLOCK A  
HYATT ROCKWALL ADDITION  
ROCKWALL, TEXAS  
Scale: 1" = 30"  
Designed by: AWR  
Drawn by: AWR  
Checked by: AWR  
631-0170wsp-site-plan.dwg  
Date: 11.7.2017


LANDSCAPE SPECIFICATIONS AND DETAILS  
HYATT ROCKWALL ADDITION  
LOT 1, BLOCK A  
2.681 ACRES  
ROCKWALL, ROCKWALL COUNTY, TEXAS  
NOVEMBER 7, 2017  
CASE #SP2017-033  
SHEET  
L1.5

AWR  
AWR Design, LLC  
P.O. Box 1746  
Aledo, Texas 75042  
amanda@awr-designs.com  
c. 512.517.5589


ENGINEER:  
VASQUEZ ENGINEERING, L.L.C.  
1919 S. SHILOH ROAD, SUITE 440  
GARLAND, TEXAS 75042  
TELE: 972-272-4610  
CONTACT: JUAN J. VASQUEZ, P.E.

OWNER/DEVELOPER:  
ROCKWALL INN KEEPERS I, LTD.  
6176 FM 2011  
LONGVIEW, TEXAS 75603  
TELE: 214-455-5254  
CONTACT: DEEPAK GANDHI



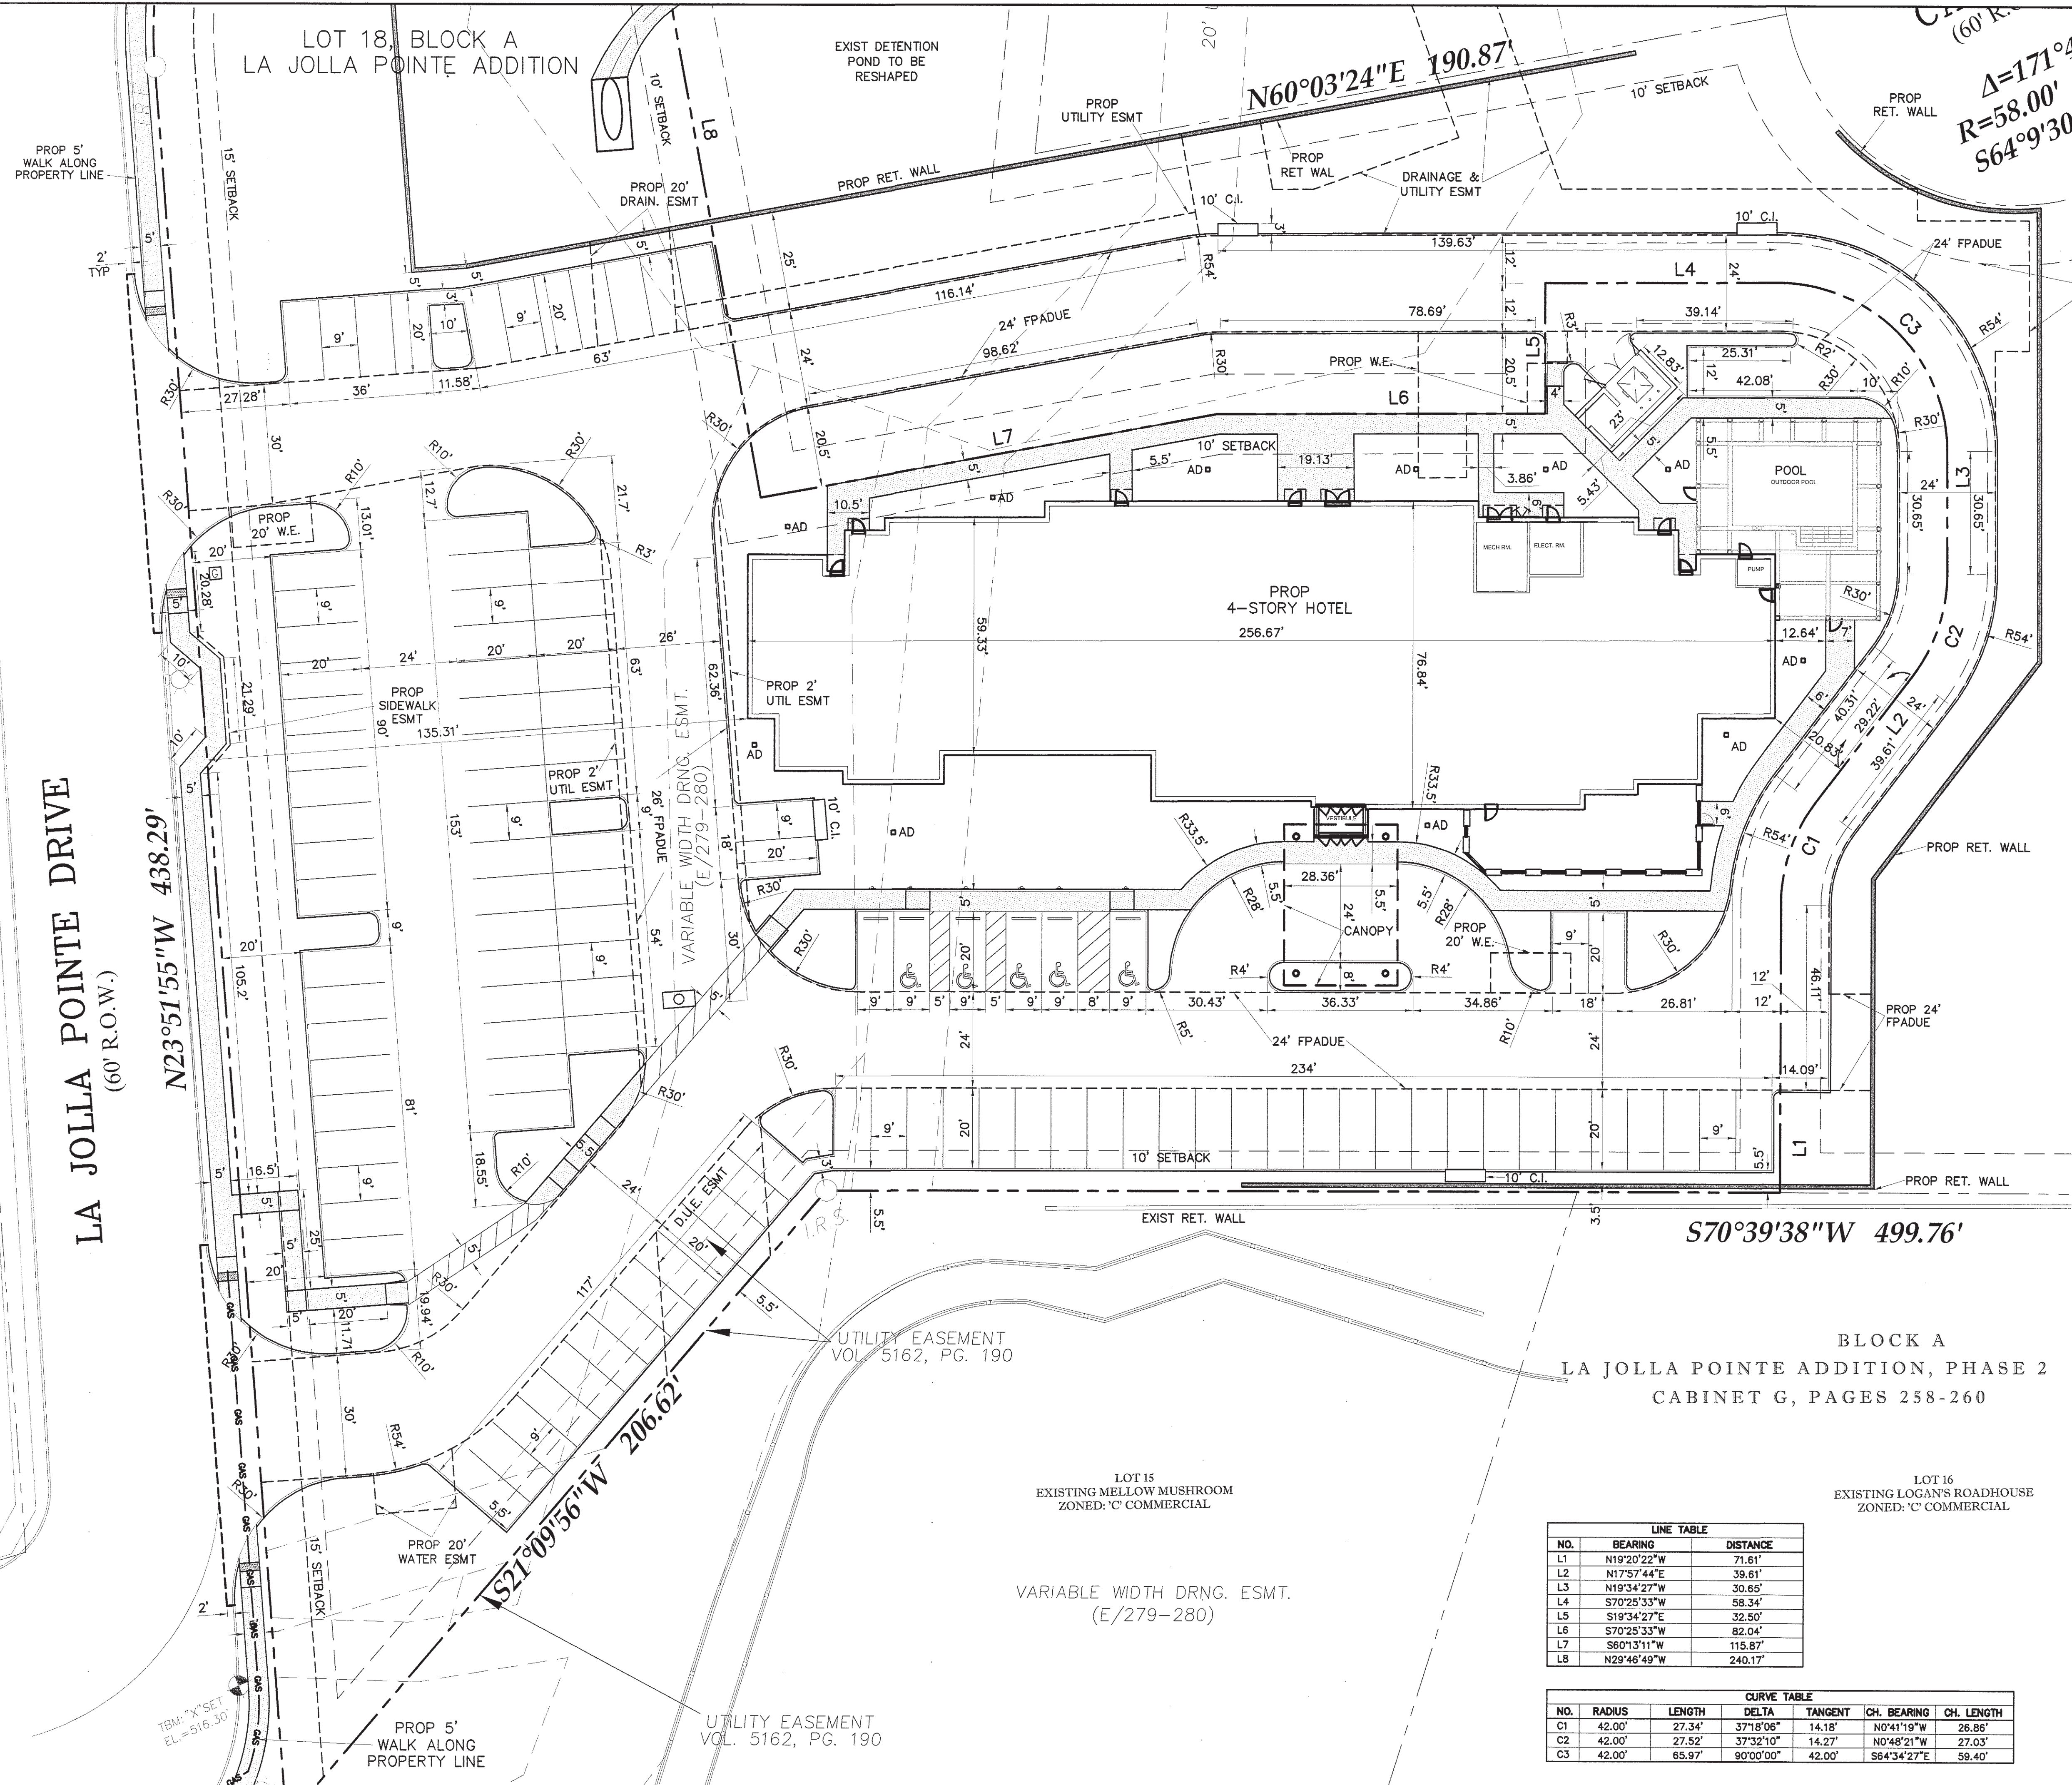

$\Delta=171^{\circ}48'25''$   
 $R=58.00'$   $L=173.92'$   
 $S64^{\circ}9'30''E$   $115.70'$

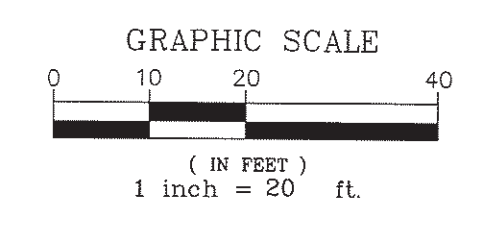

- EXISTING CURB/PAVEMENT
- PROPERTY LINE
- 4" CONC SIDEWALK
- PROP RETAINING WALL
- F.P.A.D.U.E. FIRE LANE, PUBLIC ACCESS, DRAINAGE & UTILITY EASEMENT
- AD AREA DRAIN
- C.I. CURB INLET

- NOTES:
1. TOPOGRAPHIC SURVEY PROVIDED BY SELLER.
  2. SEE SHEET C2 FOR PAVING PLAN.
  3. SEE SHEETS C3-1 - C3.2 FOR GRADING PLAN.
  4. REFERENCE ARCHITECT PLANS FOR EXACT BUILDING DIMENSIONS.
  5. ALL DIMENSIONS ARE TO FACE OF CURB, FACE OF BUILDING OR AS OTHERWISE NOTED.
  6. ALL CURB RADIUS NOT LISTED ARE 3' FACE OF CURB.

BENCHMARK -- TBM1	
ELEV.	516.30
MON.	CUT X IN CONC
LOC.	CUT X IN TOP OF INLET NEAR S.W. CORNER OF LOT 18, BLOCK A OF LA JOLLA POINTE ADDITION

LINE TABLE		
NO.	BEARING	DISTANCE
L1	N19°20'22"W	71.61'
L2	N17°57'44"E	39.61'
L3	N19°34'27"W	30.65'
L4	S70°25'33"W	58.34'
L5	S19°34'27"E	32.50'
L6	S70°25'33"W	82.04'
L7	S60°13'11"W	115.87'
L8	N29°46'49"W	240.17'

CURVE TABLE						
NO.	RADIUS	LENGTH	DELTA	TANGENT	CH. BEARING	CH. LENGTH
C1	42.00'	27.34'	37°18'08"	14.18'	N0°41'19"W	26.86'
C2	42.00'	27.52'	37°32'10"	14.27'	N0°48'21"W	27.03'
C3	42.00'	65.97'	90°00'00"	42.00'	S64°34'27"E	59.40'

**RECORD DRAWING**

TO THE BEST OF OUR KNOWLEDGE THE IMPROVEMENTS SHOWN ON THIS PLAN WERE COMPLETED IN GENERAL CONFORMANCE WITH THE DESIGN PLANS. THIS DETERMINATION WAS MADE BASED ON POST-CONSTRUCTION SURVEY DATA AND INFORMATION PROVIDED BY THE CONTRACTOR Juan J. Vasquez, P.E. 09/04/2020

SIGNED \_\_\_\_\_ DATE \_\_\_\_\_  
 VASQUEZ ENGINEERING, LLC  
 TEXAS REG. F-12266

**VASQUEZ ENGINEERING, L.L.C.**  
 1919 S. Shiloh Road  
 Suite 440, LB 44  
 Garland, Texas 75042  
 Ph: 972-278-2948  
 TX Registration # F-12266



THE SEAL APPEARING ON THIS DOCUMENT WAS AUTHORIZED BY JUAN J. VASQUEZ, P.E. 05/07/2018


**DEVELOPER:**  
 ROCKWALL INN KEEPERS I, LTD.  
 6176 FM 2011  
 LONGVIEW, TX 75603

**DIMENSIONAL CONTROL PLAN**  
 LOT 18, BLOCK A  
 LA JOLLA POINTE ADDITION  
 ROCKWALL, TEXAS

Scale: 1" = 20'  
 Designed by: JJV  
 Drawn by: JJV  
 Checked by: JJV  
 636-010610-DIMENSIONAL CONTROL PLAN.dwg  
 Date: 10/11/2018


SHEET  
**C1**



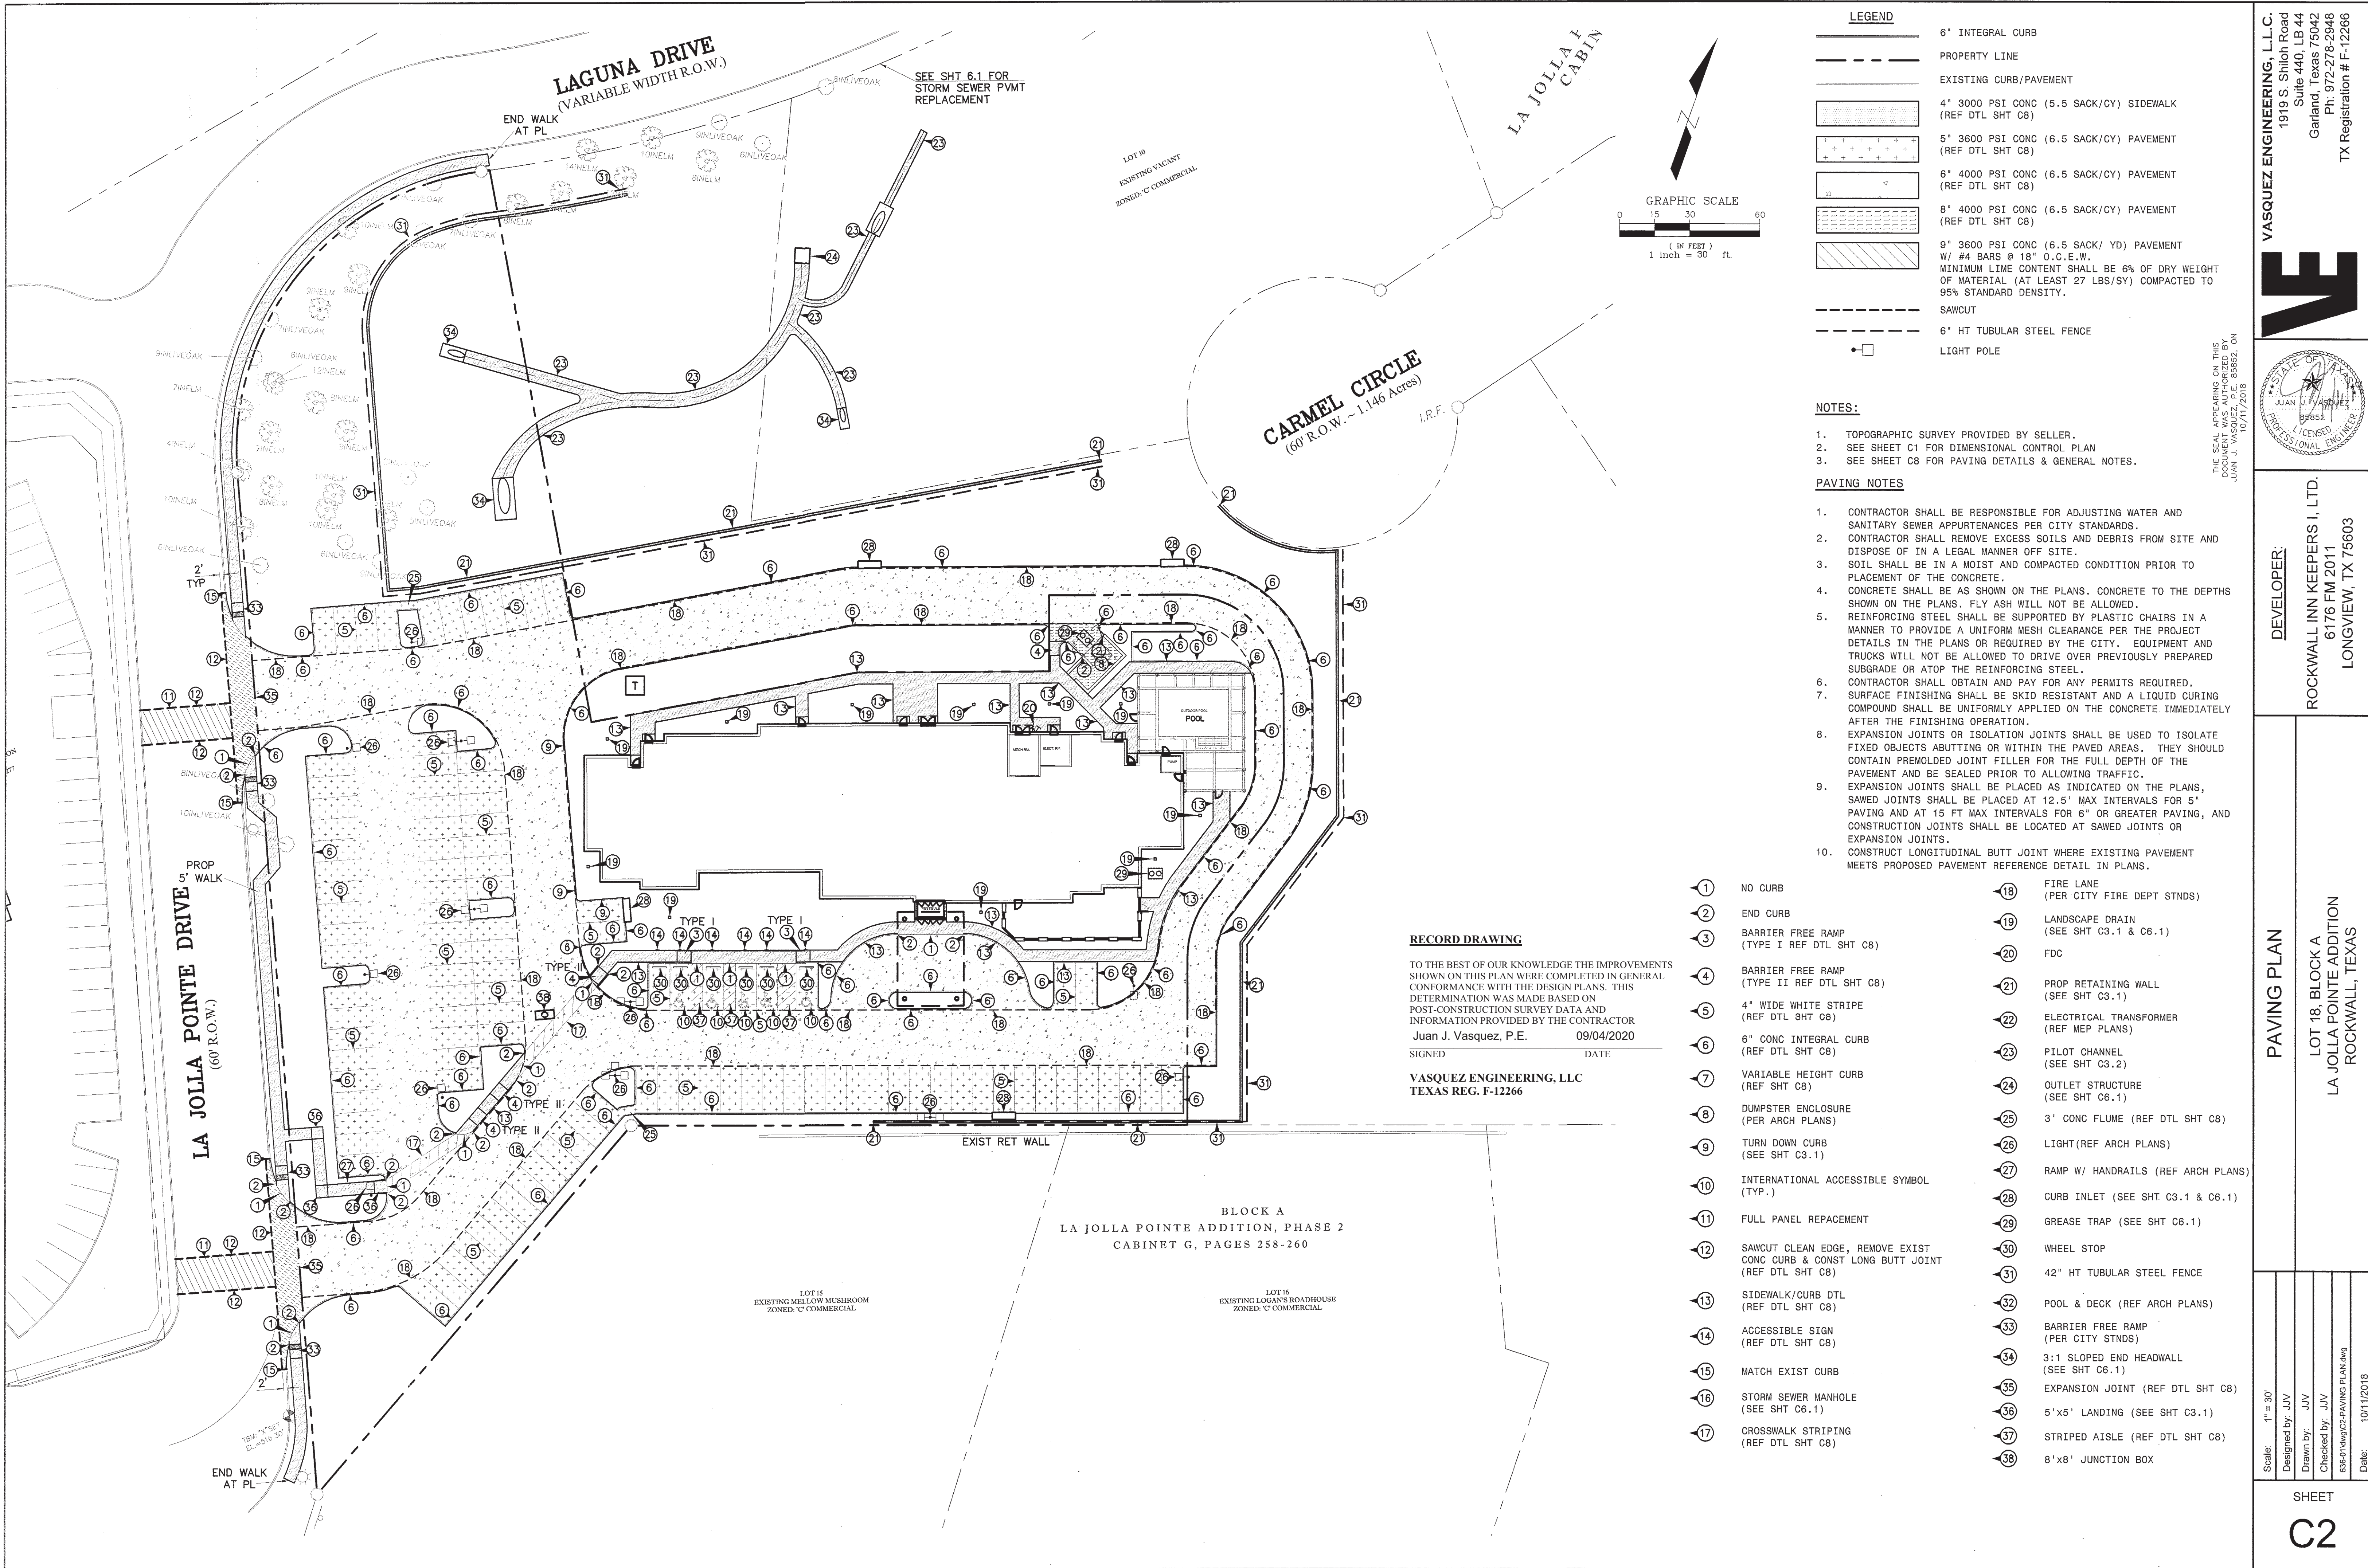

**LEGEND**

	6" INTEGRAL CURB
	PROPERTY LINE
	EXISTING CURB/PAVEMENT
	4" 3000 PSI CONC (5.5 SACK/CY) SIDEWALK (REF DTL SHT C8)
	5" 3600 PSI CONC (6.5 SACK/CY) PAVEMENT (REF DTL SHT C8)
	6" 4000 PSI CONC (6.5 SACK/CY) PAVEMENT (REF DTL SHT C8)
	8" 4000 PSI CONC (6.5 SACK/CY) PAVEMENT (REF DTL SHT C8)
	9" 3600 PSI CONC (6.5 SACK/ YD) PAVEMENT W/ #4 BARS @ 18" O.C.E.W. MINIMUM LIME CONTENT SHALL BE 6% OF DRY WEIGHT OF MATERIAL (AT LEAST 27 LBS/SY) COMPACTED TO 95% STANDARD DENSITY.
	SAWCUT
	6" HT TUBULAR STEEL FENCE
	LIGHT POLE

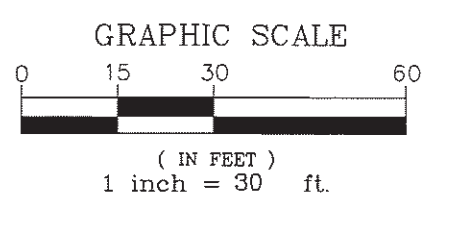

- NOTES:**
- TOPOGRAPHIC SURVEY PROVIDED BY SELLER.
  - SEE SHEET C1 FOR DIMENSIONAL CONTROL PLAN
  - SEE SHEET C8 FOR PAVING DETAILS & GENERAL NOTES.

- PAVING NOTES**
- CONTRACTOR SHALL BE RESPONSIBLE FOR ADJUSTING WATER AND SANITARY SEWER APPURTENANCES PER CITY STANDARDS.
  - CONTRACTOR SHALL REMOVE EXCESS SOILS AND DEBRIS FROM SITE AND DISPOSE OF IN A LEGAL MANNER OFF SITE.
  - SOIL SHALL BE IN A MOIST AND COMPACTED CONDITION PRIOR TO PLACEMENT OF THE CONCRETE.
  - CONCRETE SHALL BE AS SHOWN ON THE PLANS. CONCRETE TO THE DEPTHS SHOWN ON THE PLANS. FLY ASH WILL NOT BE ALLOWED.
  - REINFORCING STEEL SHALL BE SUPPORTED BY PLASTIC CHAIRS IN A MANNER TO PROVIDE A UNIFORM MESH CLEARANCE PER THE PROJECT DETAILS IN THE PLANS OR REQUIRED BY THE CITY. EQUIPMENT AND TRUCKS WILL NOT BE ALLOWED TO DRIVE OVER PREVIOUSLY PREPARED SUBGRADE OR ATOP THE REINFORCING STEEL.
  - CONTRACTOR SHALL OBTAIN AND PAY FOR ANY PERMITS REQUIRED.
  - SURFACE FINISHING SHALL BE SKID RESISTANT AND A LIQUID CURING COMPOUND SHALL BE UNIFORMLY APPLIED ON THE CONCRETE IMMEDIATELY AFTER THE FINISHING OPERATION.
  - EXPANSION JOINTS OR ISOLATION JOINTS SHALL BE USED TO ISOLATE FIXED OBJECTS ABUTTING OR WITHIN THE PAVED AREAS. THEY SHOULD CONTAIN PREMOLDED JOINT FILLER FOR THE FULL DEPTH OF THE PAVEMENT AND BE SEALED PRIOR TO ALLOWING TRAFFIC.
  - EXPANSION JOINTS SHALL BE PLACED AS INDICATED ON THE PLANS, SAWED JOINTS SHALL BE PLACED AT 12.5' MAX INTERVALS FOR 5" PAVING AND AT 15 FT MAX INTERVALS FOR 6" OR GREATER PAVING, AND CONSTRUCTION JOINTS SHALL BE LOCATED AT SAWED JOINTS OR EXPANSION JOINTS.
  - CONSTRUCT LONGITUDINAL BUTT JOINT WHERE EXISTING PAVEMENT MEETS PROPOSED PAVEMENT REFERENCE DETAIL IN PLANS.

**RECORD DRAWING**

TO THE BEST OF OUR KNOWLEDGE THE IMPROVEMENTS SHOWN ON THIS PLAN WERE COMPLETED IN GENERAL CONFORMANCE WITH THE DESIGN PLANS. THIS DETERMINATION WAS MADE BASED ON POST-CONSTRUCTION SURVEY DATA AND INFORMATION PROVIDED BY THE CONTRACTOR

Juan J. Vasquez, P.E. 09/04/2020  
SIGNED DATE

VASQUEZ ENGINEERING, LLC  
TEXAS REG. F-12266

- |   |   |
|---|---|
| 1 NO CURB   | 18 FIRE LANE (PER CITY FIRE DEPT STNDS)   |
| 2 END CURB  | 19 LANDSCAPE DRAIN (SEE SHT C3.1 & C6.1)  |
| 3 BARRIER FREE RAMP (TYPE I REF DTL SHT C8)   | 20 FDC                                    |
| 4 BARRIER FREE RAMP (TYPE II REF DTL SHT C8)  | 21 PROP RETAINING WALL (SEE SHT C3.1)     |
| 5 4" WIDE WHITE STRIPE (REF DTL SHT C8)   | 22 ELECTRICAL TRANSFORMER (REF MEP PLANS) |
| 6 6" CONC INTEGRAL CURB (REF DTL SHT C8)  | 23 PILOT CHANNEL (SEE SHT C3.2)           |
| 7 VARIABLE HEIGHT CURB (REF SHT C8)   | 24 OUTLET STRUCTURE (SEE SHT C6.1)        |
| 8 DUMPSTER ENCLOSURE (PER ARCH PLANS)   | 25 3' CONC FLUME (REF DTL SHT C8)         |
| 9 TURN DOWN CURB (SEE SHT C3.1)   | 26 LIGHT (REF ARCH PLANS)                 |
| 10 INTERNATIONAL ACCESSIBLE SYMBOL (TYP.)   | 27 RAMP W/ HANDRAILS (REF ARCH PLANS)     |
| 11 FULL PANEL REPLACEMENT   | 28 CURB INLET (SEE SHT C3.1 & C6.1)       |
| 12 SAWCUT CLEAN EDGE, REMOVE EXIST CONC CURB & CONST LONG BUTT JOINT (REF DTL SHT C8) | 29 GREASE TRAP (SEE SHT C6.1)             |
| 13 SIDEWALK/CURB DTL (REF DTL SHT C8)   | 30 WHEEL STOP                             |
| 14 ACCESSIBLE SIGN (REF DTL SHT C8)   | 31 42" HT TUBULAR STEEL FENCE             |
| 15 MATCH EXIST CURB   | 32 POOL & DECK (REF ARCH PLANS)           |
| 16 STORM SEWER MANHOLE (SEE SHT C6.1)   | 33 BARRIER FREE RAMP (PER CITY STNDS)     |
| 17 CROSSWALK STRIPING (REF DTL SHT C8)  | 34 3:1 SLOPED END HEADWALL (SEE SHT C6.1) |
|   | 35 EXPANSION JOINT (REF DTL SHT C8)       |
|   | 36 5'x5' LANDING (SEE SHT C3.1)           |
|   | 37 STRIPED AISLE (REF DTL SHT C8)         |
|   | 38 8'x8' JUNCTION BOX                     |

**BLOCK A**  
LA JOLLA POINTE ADDITION, PHASE 2  
CABINET G, PAGES 258-260

**VASQUEZ ENGINEERING, L.L.C.**  
1919 S. Shiloh Road  
Suite 440, LB 44  
Garland, Texas 75042  
Ph: 972-278-2948  
TX Registration # F-12266


**DEVELOPER:**  
ROCKWALL INN KEEPERS I, LTD.  
6176 FM 2011  
LONGVIEW, TX 75063

**PAVING PLAN**  
LOT 18, BLOCK A  
LA JOLLA POINTE ADDITION  
ROCKWALL, TEXAS

Scale: 1" = 30'  
Designed by: JJV  
Drawn by: JJV  
Checked by: JJV  
698-d1/dwg/c2-paving PLAN.dwg  
Date: 10/11/2018


SHEET  
**C2**



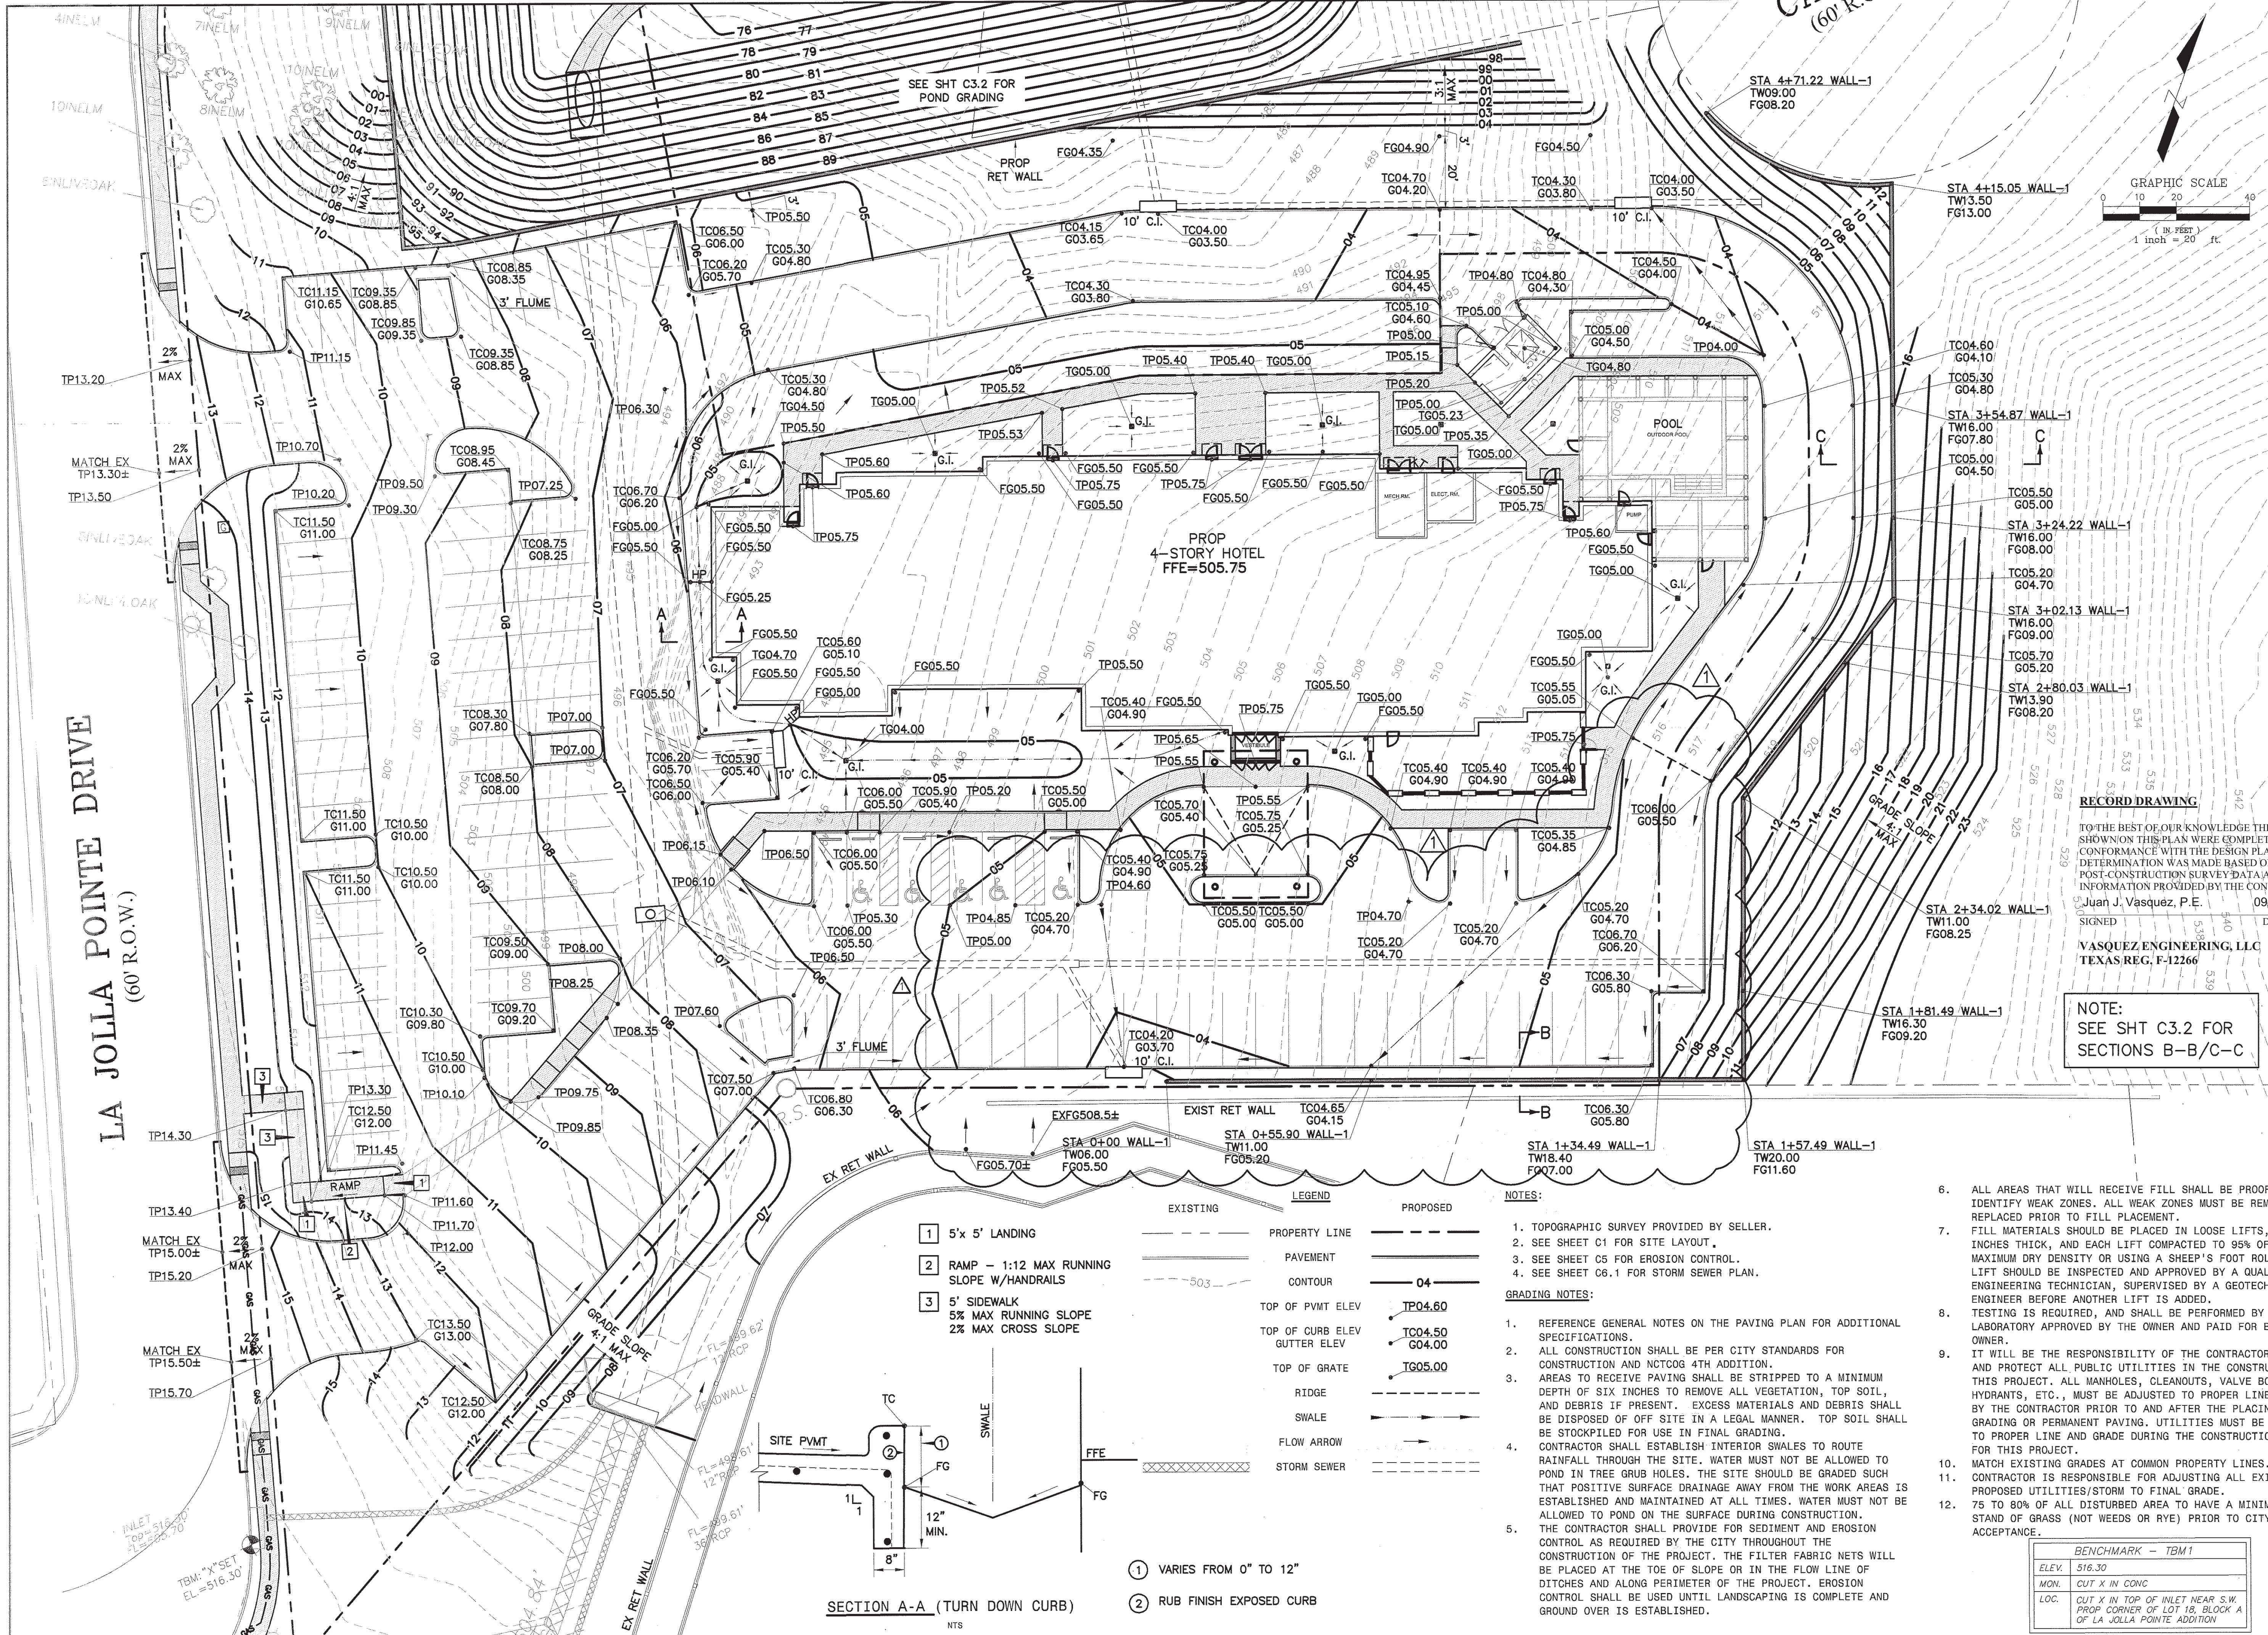

NO.	DATE	REVISION	APP.
1	01/04/19	CURB INLET	JUV

**VASQUEZ ENGINEERING, L.L.C.**  
 1919 S. Spillsh Road  
 Suite 440, LB 44  
 Garland, Texas 75042  
 Ph. 972-278-2848  
 TX Registration # F-12266

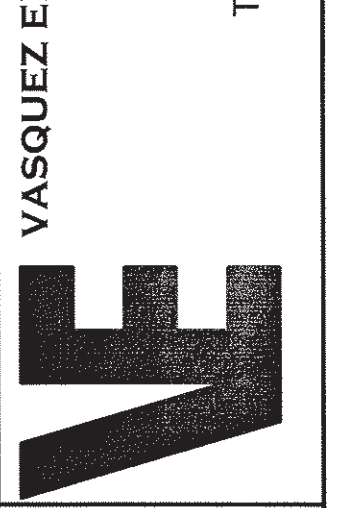


**DEVELOPER:**  
**ROCKWALL INN KEEPERS I, LTD.**  
 6176 FM 2011  
 LONGVIEW, TX 75603

**GRADING PLAN**  
 LOT 18, BLOCK A  
 LA JOLLA POINTE ADDITION  
 ROCKWALL, TEXAS

Scale: 1" = 20'  
 Designed by: JUV  
 Drawn by: JUV  
 Checked by: JUV  
 638-010Way/C3.1-GRADING PLAN.dwg  
 Date: 12/19/2018

**SHEET**  
**C3.1**

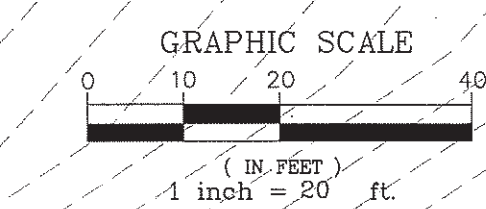

**RECORD DRAWING**  
 TO THE BEST OF OUR KNOWLEDGE THE IMPROVEMENTS SHOWN ON THIS PLAN WERE COMPLETED IN GENERAL CONFORMANCE WITH THE DESIGN PLANS. THIS DETERMINATION WAS MADE BASED ON POST-CONSTRUCTION SURVEY DATA AND INFORMATION PROVIDED BY THE CONTRACTOR  
 Juan J. Vasquez, P.E. 09/04/2020  
 SIGNED DATE


**VASQUEZ ENGINEERING, LLC**  
 TEXAS REG. F-12266

**NOTE:**  
 SEE SHT C3.2 FOR SECTIONS B-B/C-C

- 1 5' x 5' LANDING
- 2 RAMP - 1:12 MAX RUNNING SLOPE W/HANDRAILS
- 3 5' SIDEWALK 5% MAX RUNNING SLOPE 2% MAX CROSS SLOPE

EXISTING	LEGEND	PROPOSED
---	PROPERTY LINE	---
---	PAVEMENT	---
---	CONTOUR	---
---	TOP OF PVMT ELEV	TP04.60
---	TOP OF CURB ELEV	TC04.50
---	GUTTER ELEV	G04.00
---	TOP OF GRATE	TG05.00
---	RIDGE	---
---	SWALE	---
---	FLOW ARROW	---
---	STORM SEWER	---

- NOTES:**
- TOPOGRAPHIC SURVEY PROVIDED BY SELLER.
  - SEE SHEET C1 FOR SITE LAYOUT.
  - SEE SHEET C5 FOR EROSION CONTROL.
  - SEE SHEET C6.1 FOR STORM SEWER PLAN.
- GRADING NOTES:**
- REFERENCE GENERAL NOTES ON THE PAVING PLAN FOR ADDITIONAL SPECIFICATIONS.
  - ALL CONSTRUCTION SHALL BE PER CITY STANDARDS FOR CONSTRUCTION AND NCTCOG 4TH ADDITION.
  - AREAS TO RECEIVE PAVING SHALL BE STRIPPED TO A MINIMUM DEPTH OF SIX INCHES TO REMOVE ALL VEGETATION, TOP SOIL, AND DEBRIS IF PRESENT. EXCESS MATERIALS AND DEBRIS SHALL BE DISPOSED OF OFF SITE IN A LEGAL MANNER. TOP SOIL SHALL BE STOCKPILED FOR USE IN FINAL GRADING.
  - CONTRACTOR SHALL ESTABLISH INTERIOR SWALES TO ROUTE RAINFALL THROUGH THE SITE. WATER MUST NOT BE ALLOWED TO POND IN TREE GRUB HOLES. THE SITE SHOULD BE GRADED SUCH THAT POSITIVE SURFACE DRAINAGE AWAY FROM THE WORK AREAS IS ESTABLISHED AND MAINTAINED AT ALL TIMES. WATER MUST NOT BE ALLOWED TO POND ON THE SURFACE DURING CONSTRUCTION. THE CONTRACTOR SHALL PROVIDE FOR SEDIMENT AND EROSION CONTROL AS REQUIRED BY THE CITY THROUGHOUT THE CONSTRUCTION OF THE PROJECT. THE FILTER FABRIC NETS WILL BE PLACED AT THE TOE OF SLOPE OR IN THE FLOW LINE OF DITCHES AND ALONG PERIMETER OF THE PROJECT. EROSION CONTROL SHALL BE USED UNTIL LANDSCAPING IS COMPLETE AND GROUND COVER IS ESTABLISHED.




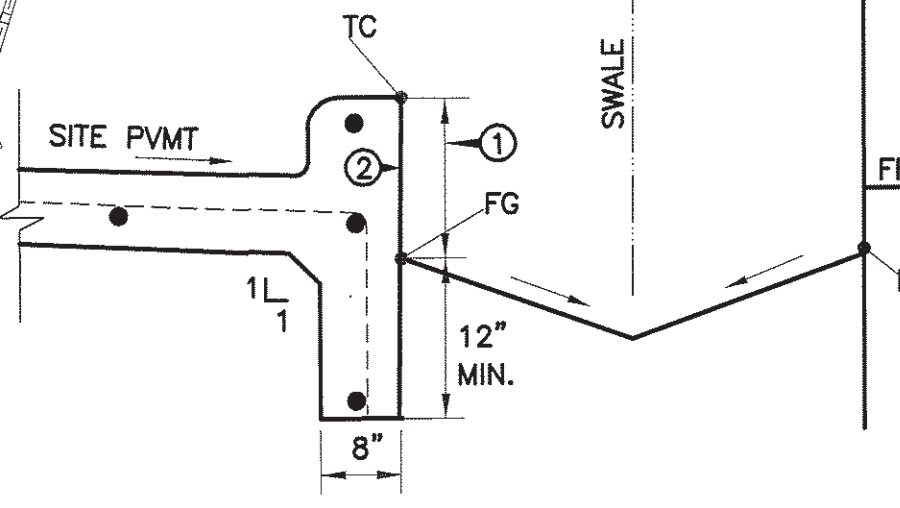


**SECTION A-A (TURN DOWN CURB)**  
 NTS

- 1 VARIES FROM 0" TO 12"
- 2 RUB FINISH EXPOSED CURB


<b>BENCHMARK - TBM1</b>	
ELEV.	516.30
MON.	CUT X IN CONC
LOC.	CUT X IN TOP OF INLET NEAR S.W. PROP. CORNER OF LOT 18, BLOCK A OF LA JOLLA POINTE ADDITION



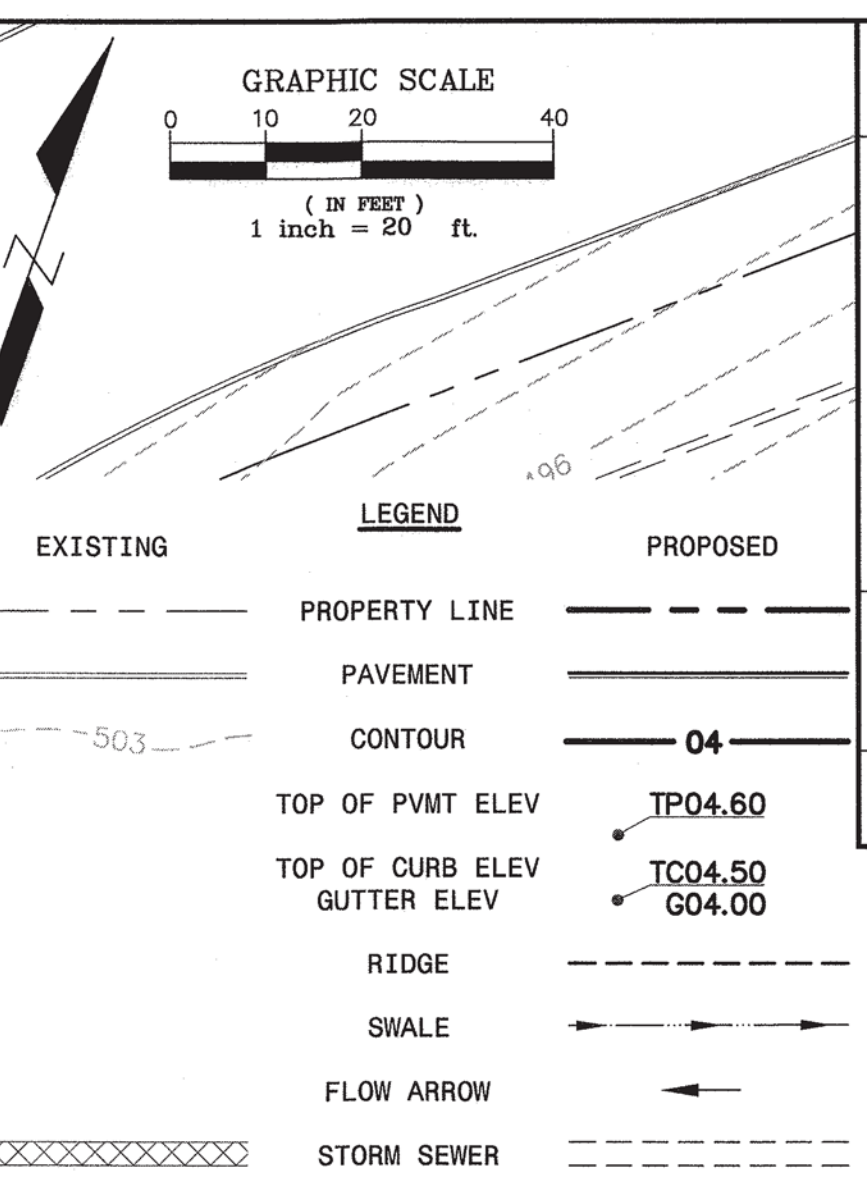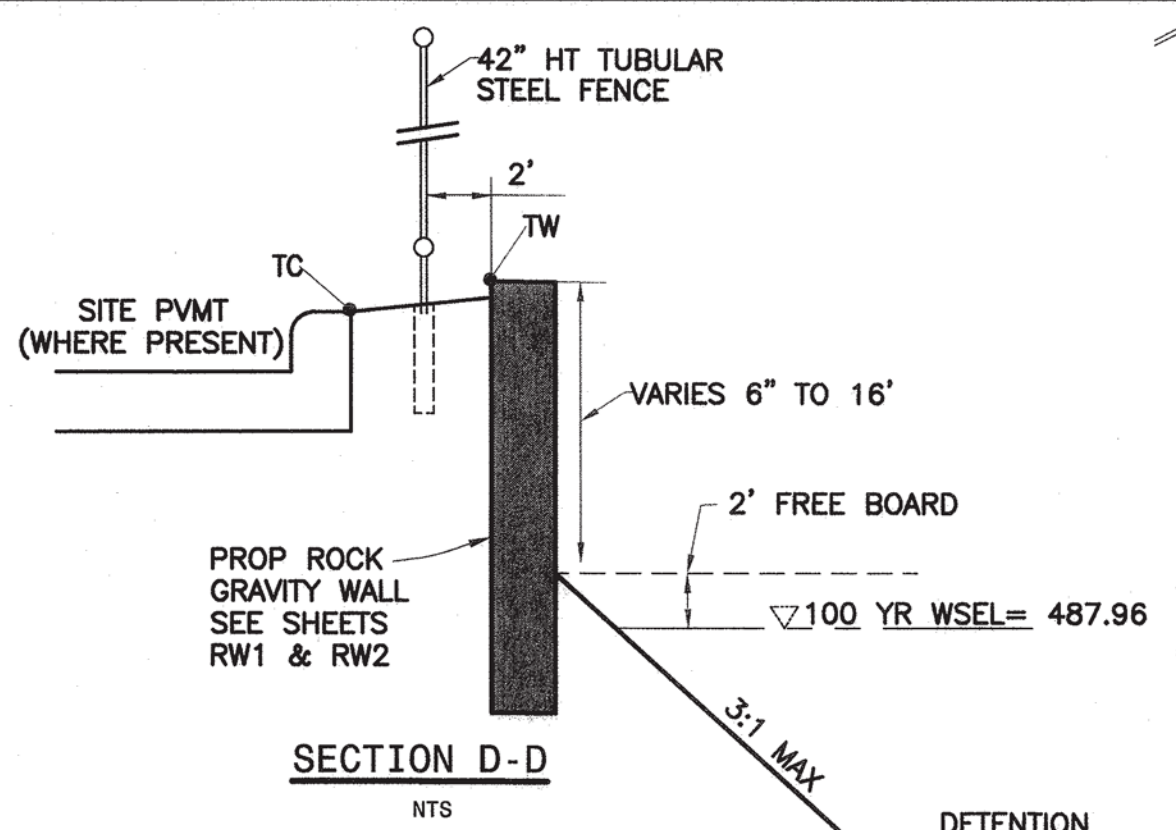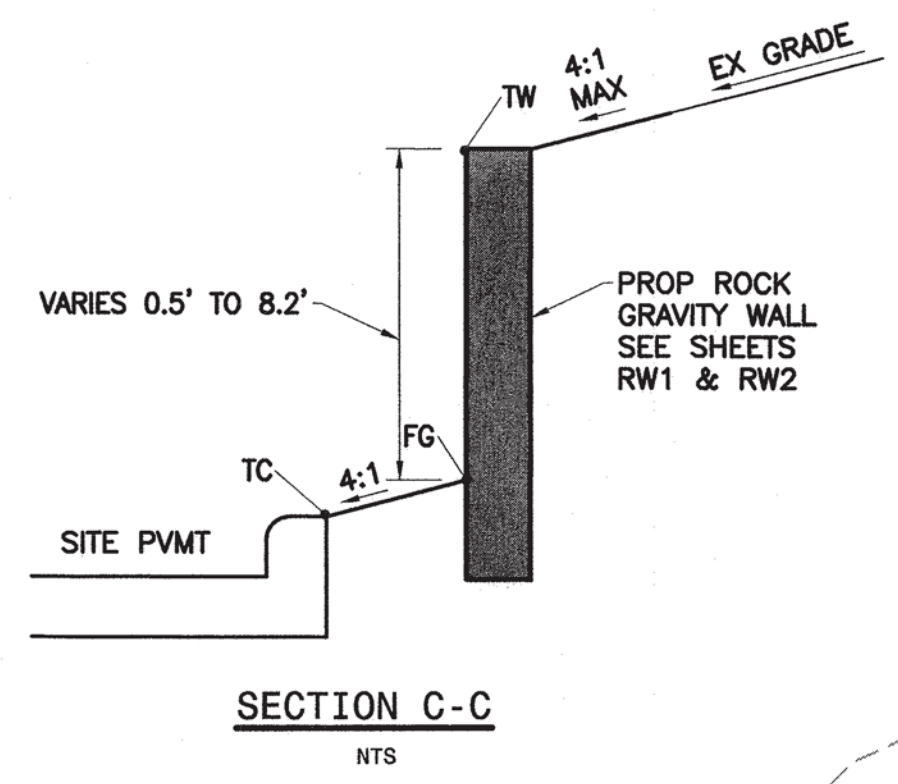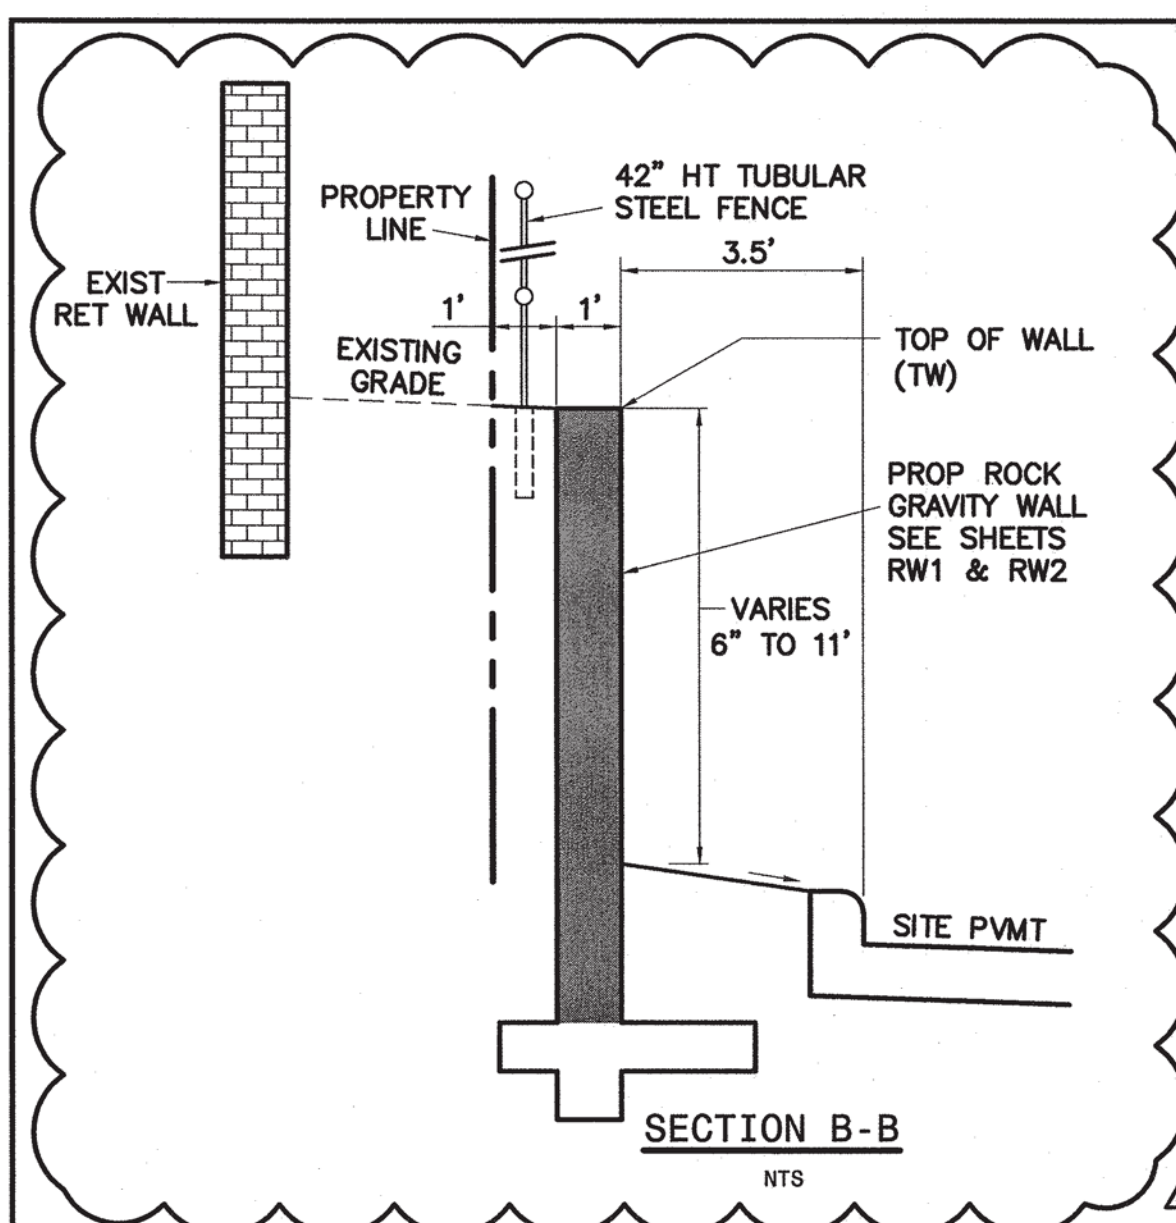

NO.	DATE	RECORD DRAWINGS	APP.
1	09/04/20	ADDED ROCK RIP RAP	JUV
2	07/24/19		JUV

**VASQUEZ ENGINEERING, L.L.C.**  
 1919 S. Shiloh Road  
 Suite 440, LB 44  
 Garland, Texas 75042  
 Ph: 972-278-2948  
 TX Registration # F-12266

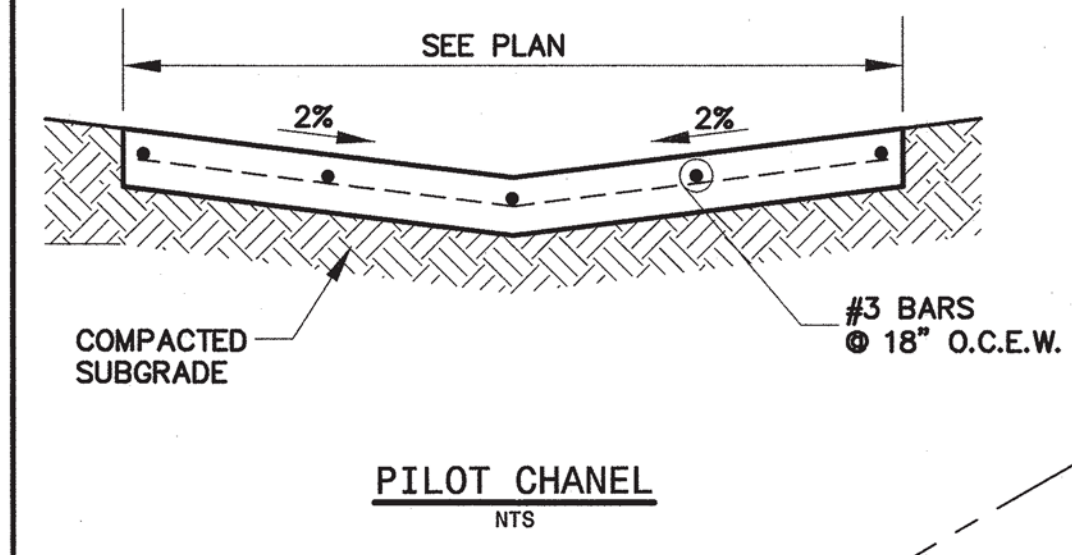

NOTE:  
 SEE SHT C3.1 FOR  
 SECTION LINES  
 B-B/C-C

BENCHMARK - TBM1	
ELEV.	516.30
MON.	CUT X IN CONC
LOC.	CUT X IN TOP OF INLET NEAR S.W. CORNER OF LOT 18, BLOCK A OF LA JOLLA POINTE ADDITION

**NOTES:**

1. TOPOGRAPHIC SURVEY PROVIDED BY SELLER.
2. SEE SHEET C1 FOR SITE LAYOUT.
3. SEE SHEET C5 FOR EROSION CONTROL.
4. SEE SHEET C6.1 FOR STORM SEWER PLAN.

**GRADING NOTES:**

1. REFERENCE GENERAL NOTES ON THE PAVING PLAN FOR ADDITIONAL SPECIFICATIONS.
2. ALL CONSTRUCTION SHALL BE PER CITY STANDARDS FOR CONSTRUCTION AND NCTCOG 4TH ADDITION.
3. AREAS TO RECEIVE PAVING SHALL BE STRIPPED TO A MINIMUM DEPTH OF SIX INCHES TO REMOVE ALL VEGETATION, TOP SOIL, AND DEBRIS IF PRESENT. EXCESS MATERIALS AND DEBRIS SHALL BE DISPOSED OF OFF SITE IN A LEGAL MANNER. TOP SOIL SHALL BE STOCKPILED FOR USE IN FINAL GRADING.
4. CONTRACTOR SHALL ESTABLISH INTERIOR SWALES TO ROUTE RAINFALL THROUGH THE SITE. WATER MUST NOT BE ALLOWED TO POND IN TREE GRUB HOLES. THE SITE SHOULD BE GRADED SUCH THAT POSITIVE SURFACE DRAINAGE AWAY FROM THE WORK AREAS IS ESTABLISHED AND MAINTAINED AT ALL TIMES. WATER MUST NOT BE ALLOWED TO POND ON THE SURFACE DURING CONSTRUCTION.
5. THE CONTRACTOR SHALL PROVIDE FOR SEDIMENT AND EROSION CONTROL AS REQUIRED BY THE CITY THROUGHOUT THE CONSTRUCTION OF THE PROJECT. THE FILTER FABRIC NETS WILL BE PLACED AT THE TOE OF SLOPE OR IN THE FLOW LINE OF DITCHES AND ALONG PERIMETER OF THE PROJECT. EROSION CONTROL SHALL BE USED UNTIL LANDSCAPING IS COMPLETE AND GROUND OVER IS ESTABLISHED.
6. ALL AREAS THAT WILL RECEIVE FILL SHALL BE PROOF-ROLLED TO IDENTIFY WEAK ZONES. ALL WEAK ZONES MUST BE REMOVED AND REPLACED PRIOR TO FILL PLACEMENT.
7. FILL MATERIALS SHOULD BE PLACED IN LOOSE LIFTS, MAX. 8 INCHES THICK, AND EACH LIFT COMPACTED TO 95% OF THE MAXIMUM DRY DENSITY OR USING A SHEEP'S FOOT ROLLER. EACH LIFT SHOULD BE INSPECTED AND APPROVED BY A QUALIFIED ENGINEERING TECHNICIAN, SUPERVISED BY A GEOTECHNICAL ENGINEER BEFORE ANOTHER LIFT IS ADDED.
8. TESTING IS REQUIRED, AND SHALL BE PERFORMED BY A LABORATORY APPROVED BY THE OWNER AND PAID FOR BY THE OWNER.
9. IT WILL BE THE RESPONSIBILITY OF THE CONTRACTOR TO LOCATE AND PROTECT ALL PUBLIC UTILITIES IN THE CONSTRUCTION OF THIS PROJECT. ALL MANHOLES, CLEANOUTS, VALVE BOXES, FIRE HYDRANTS, ETC., MUST BE ADJUSTED TO PROPER LINE AND GRADE BY THE CONTRACTOR PRIOR TO AND AFTER THE PLACING OF FINAL GRADING OR PERMANENT PAVING. UTILITIES MUST BE MAINTAINED TO PROPER LINE AND GRADE DURING THE CONSTRUCTION OF PAVING FOR THIS PROJECT.
10. MATCH EXISTING GRADES AT COMMON PROPERTY LINES.
11. CONTRACTOR IS RESPONSIBLE FOR ADJUSTING ALL EXISTING AND PROPOSED UTILITIES/STORM TO FINAL GRADE.
12. PRIOR TO PLACING ANY PAVING (INCLUDING SLAB) THE DETENTION SYSTEM MUST BE FULLY INSTALLED AND FUNCTIONING PER APPROVED PLAN ANCHORED SEED (NOT WEEDS OR RYE). CURLEX OR SOD ON THE SIDES AND BOTTOM OF THE DETENTION SYSTEM.

**RECORD DRAWING**

TO THE BEST OF OUR KNOWLEDGE THE IMPROVEMENTS SHOWN ON THIS PLAN WERE COMPLETED IN GENERAL CONFORMANCE WITH THE DESIGN PLANS. THIS DETERMINATION WAS MADE BASED ON POST-CONSTRUCTION SURVEY DATA AND INFORMATION PROVIDED BY THE CONTRACTOR  
 Juan J. Vasquez, P.E. 09/04/2020  
 SIGNED DATE

VASQUEZ ENGINEERING, LLC  
 TEXAS REG. F-12266

**DEVELOPER:**


ROCKWALL INN KEEPERS I, LTD.  
 6176 FM 2011  
 LONGVIEW, TX 75603

**GRADING PLAN**


LOT 18, BLOCK A  
 LA JOLLA POINTE ADDITION  
 ROCKWALL, TEXAS

Scale:	1" = 20'
Designed by:	JUV
Drawn by:	JUV
Checked by:	JUV
ES&P/1909/C3.2-GRADING PLAN.dwg	
Date:	10/11/2018

SHEET  
**C3.2**

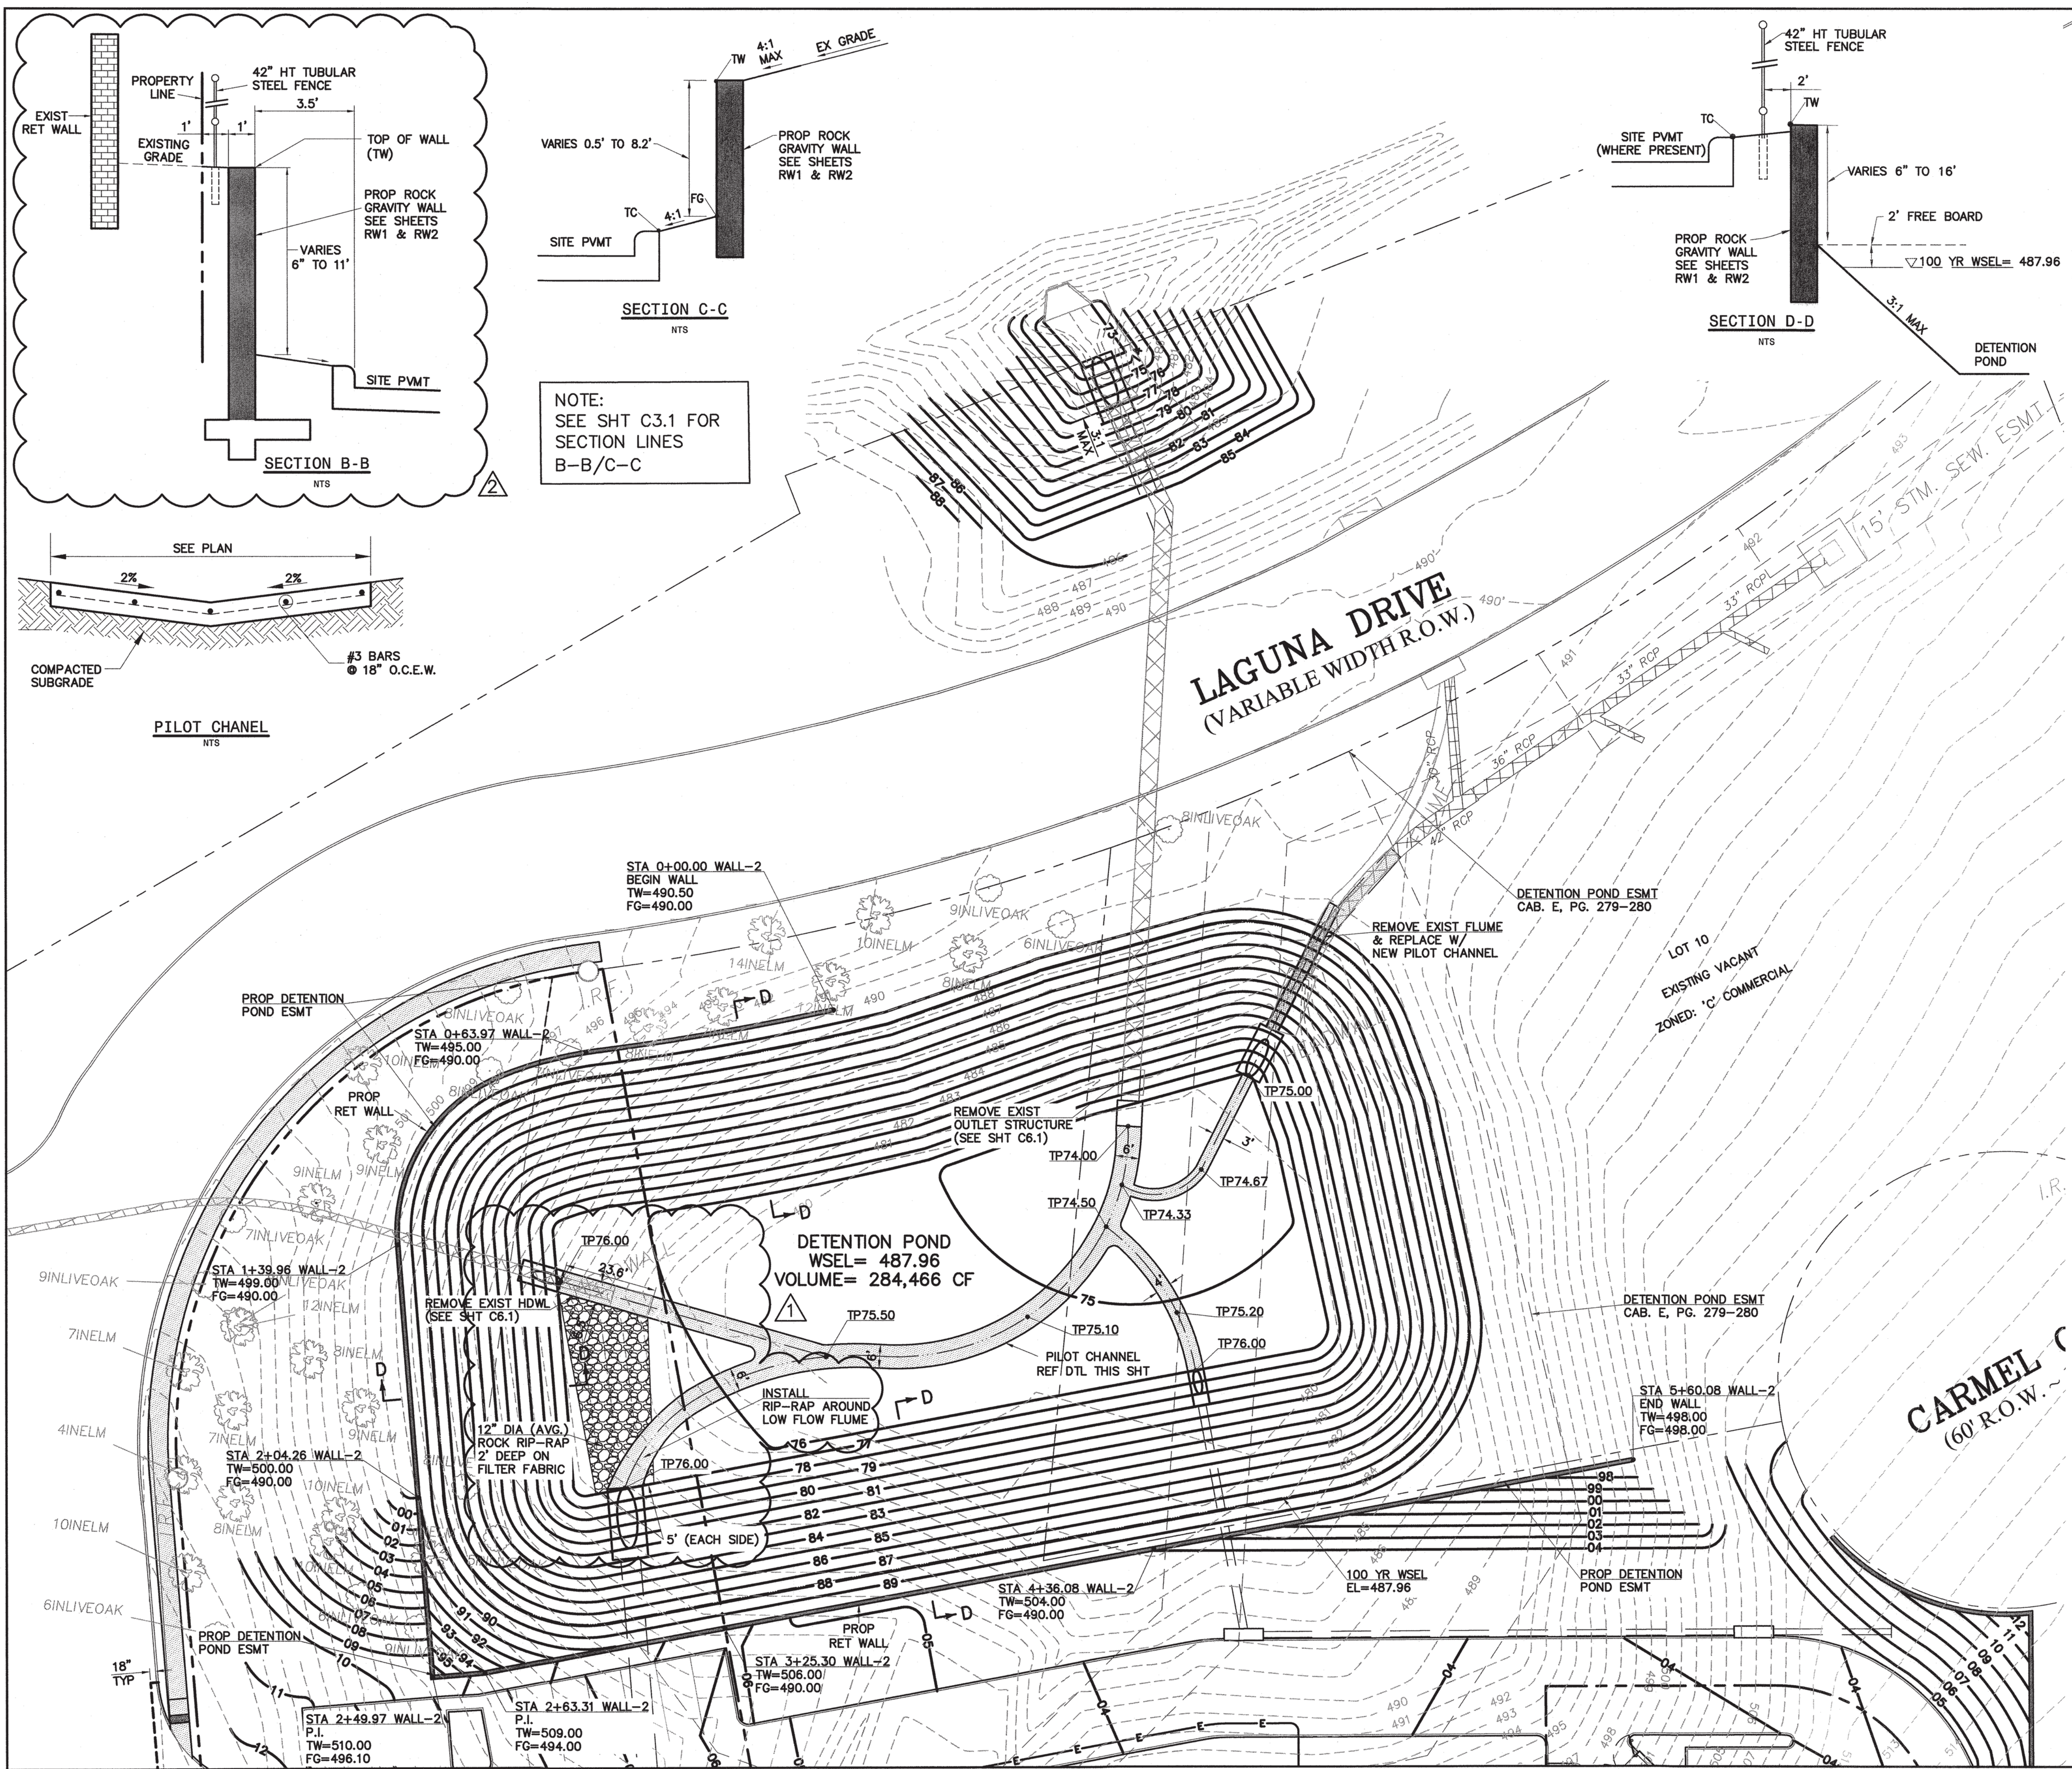



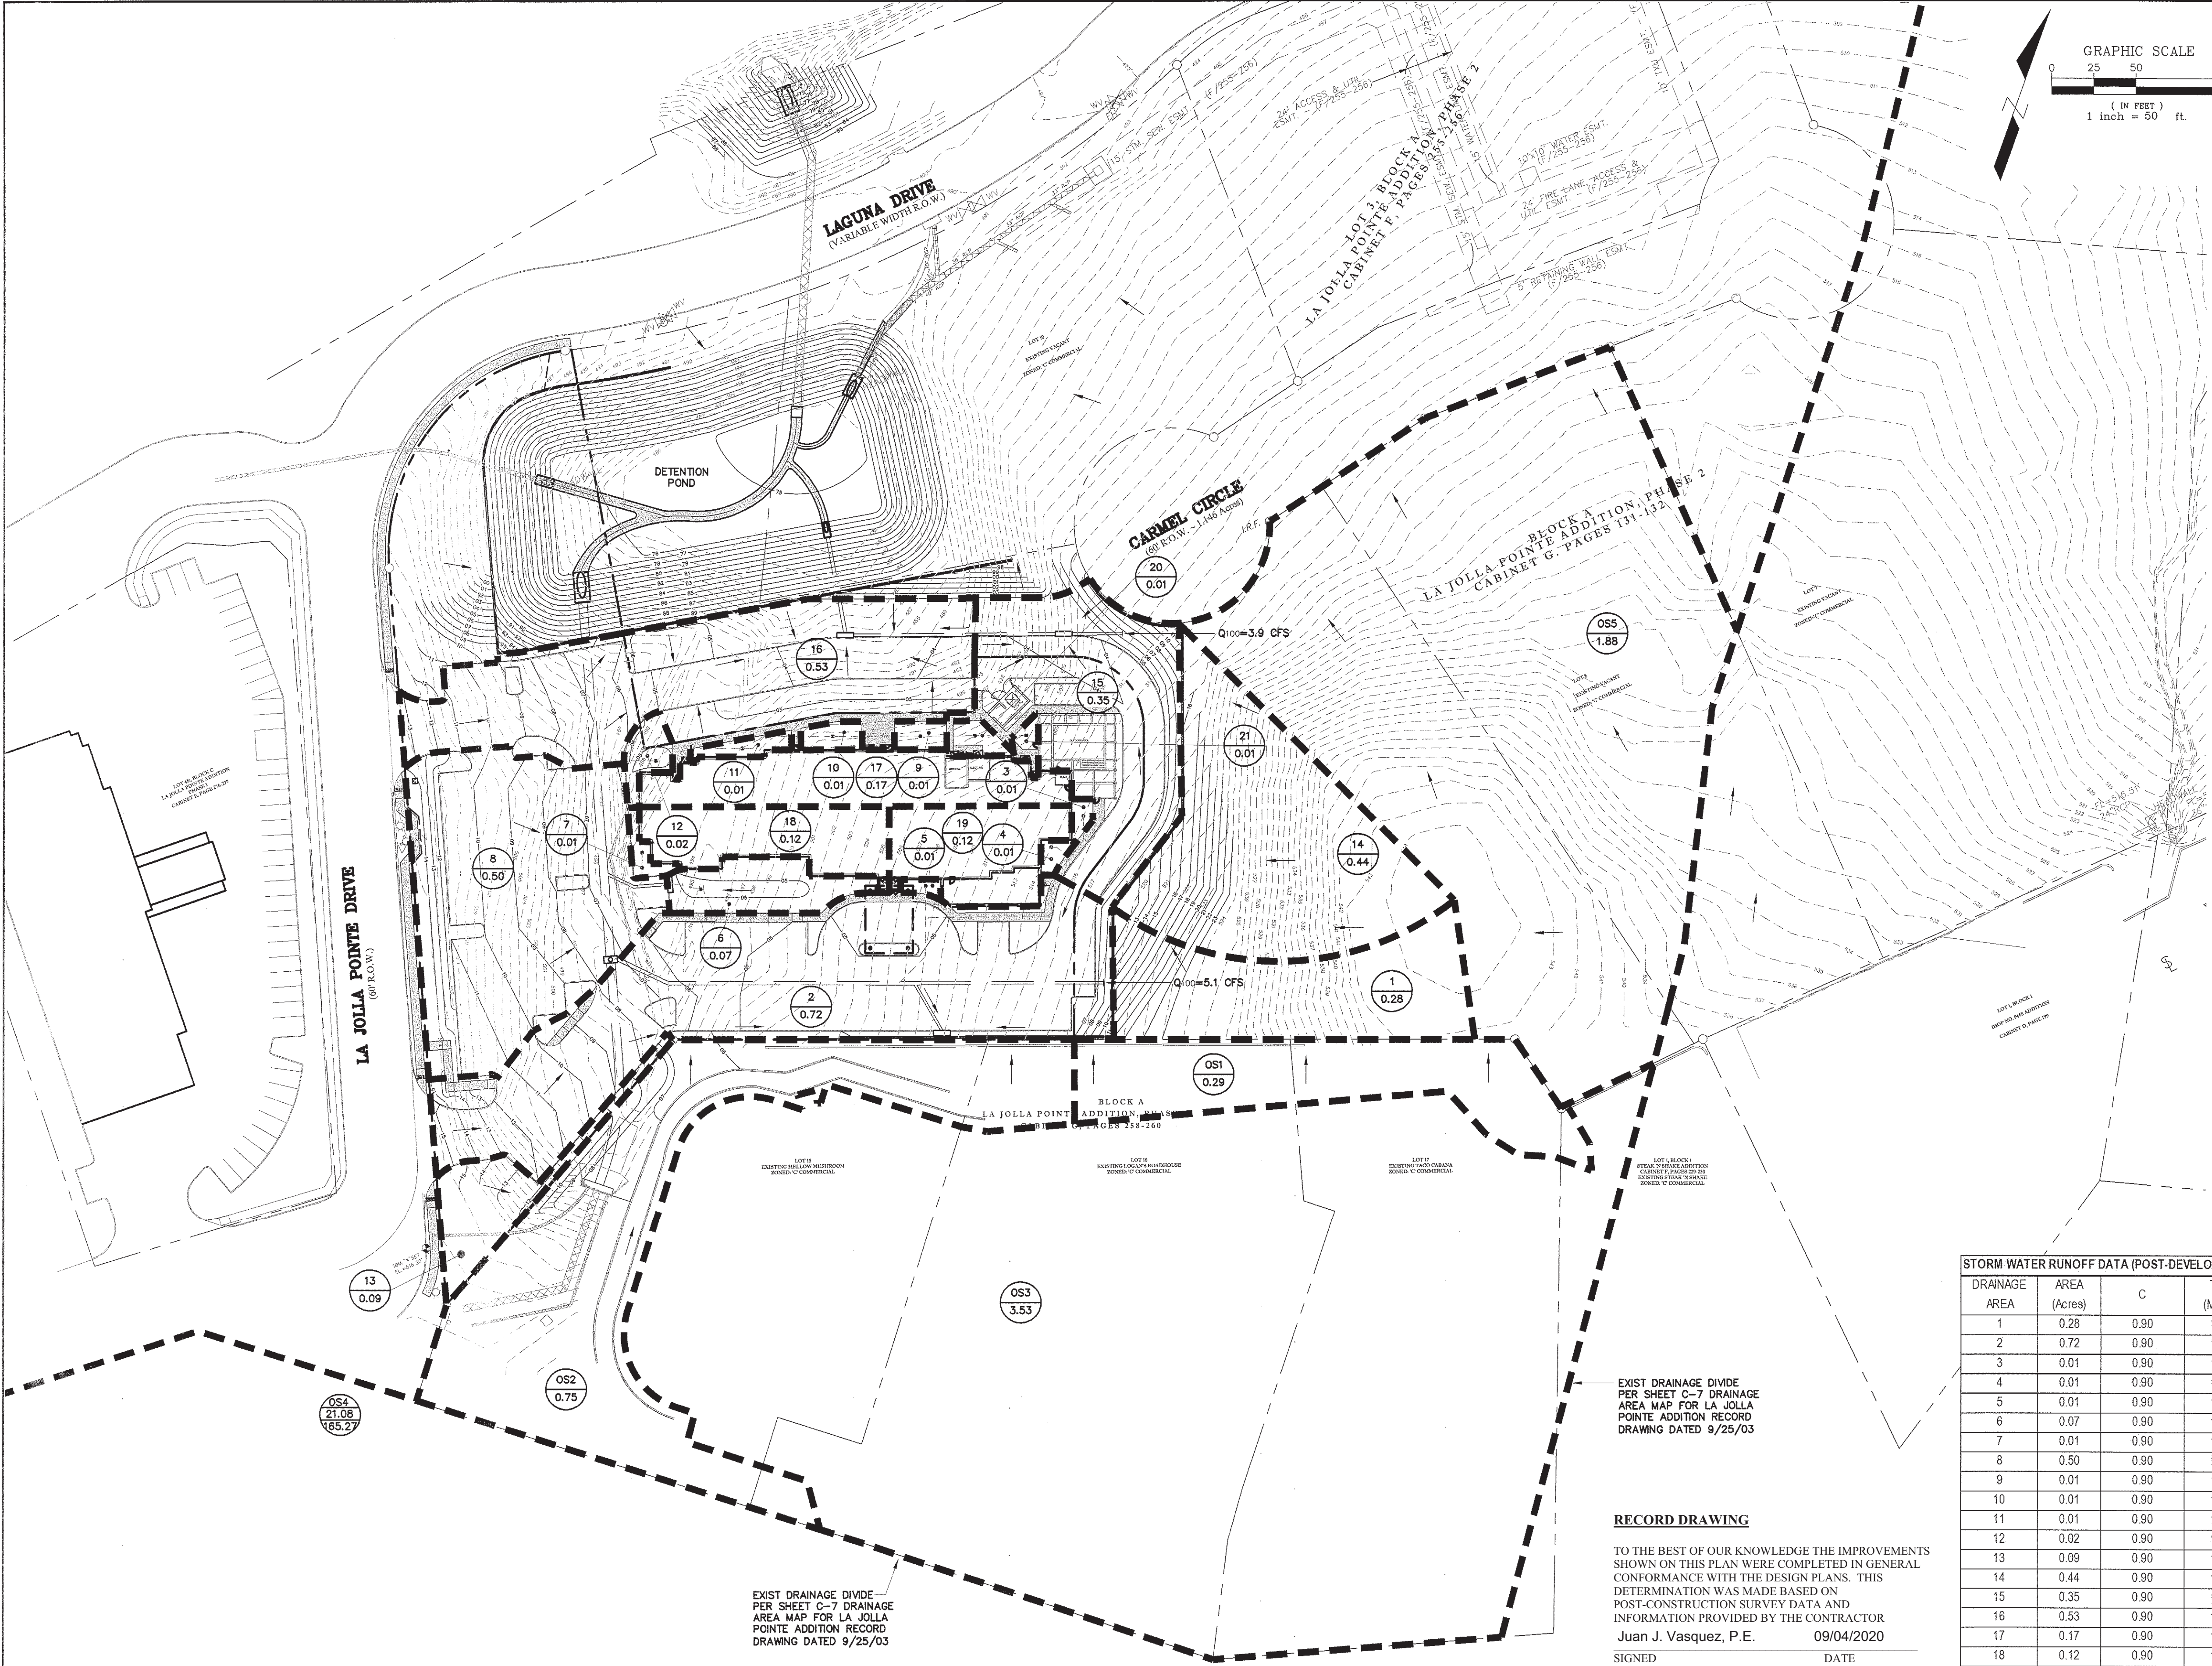

**LEGEND**

EXISTING: PROPERTY LINE, PAVEMENT, CONTOUR, FLOW, DRAINAGE DIVIDE, DRAINAGE AREA #, ACREAGE

PROPOSED: PROPERTY LINE, PAVEMENT, CONTOUR, FLOW, DRAINAGE DIVIDE, DRAINAGE AREA #, ACREAGE

4'x4' REINF CONC BOX W/GRATE. CONTRACTOR TO SUBMIT SHOP DWG FOR ENGR'S APPROVAL.


TOP= 488.00  
100-YR= 487.96  
50-YR= 487.50  
25-YR= 486.92  
10-YR= 486.44  
5-YR= 485.76  
2-YR= 484.88

FACE TOWARD DETENTION POND

FL "V"= 480.50

PIPE BEYOND 15" DIA ORIFICE

FL= 474.00

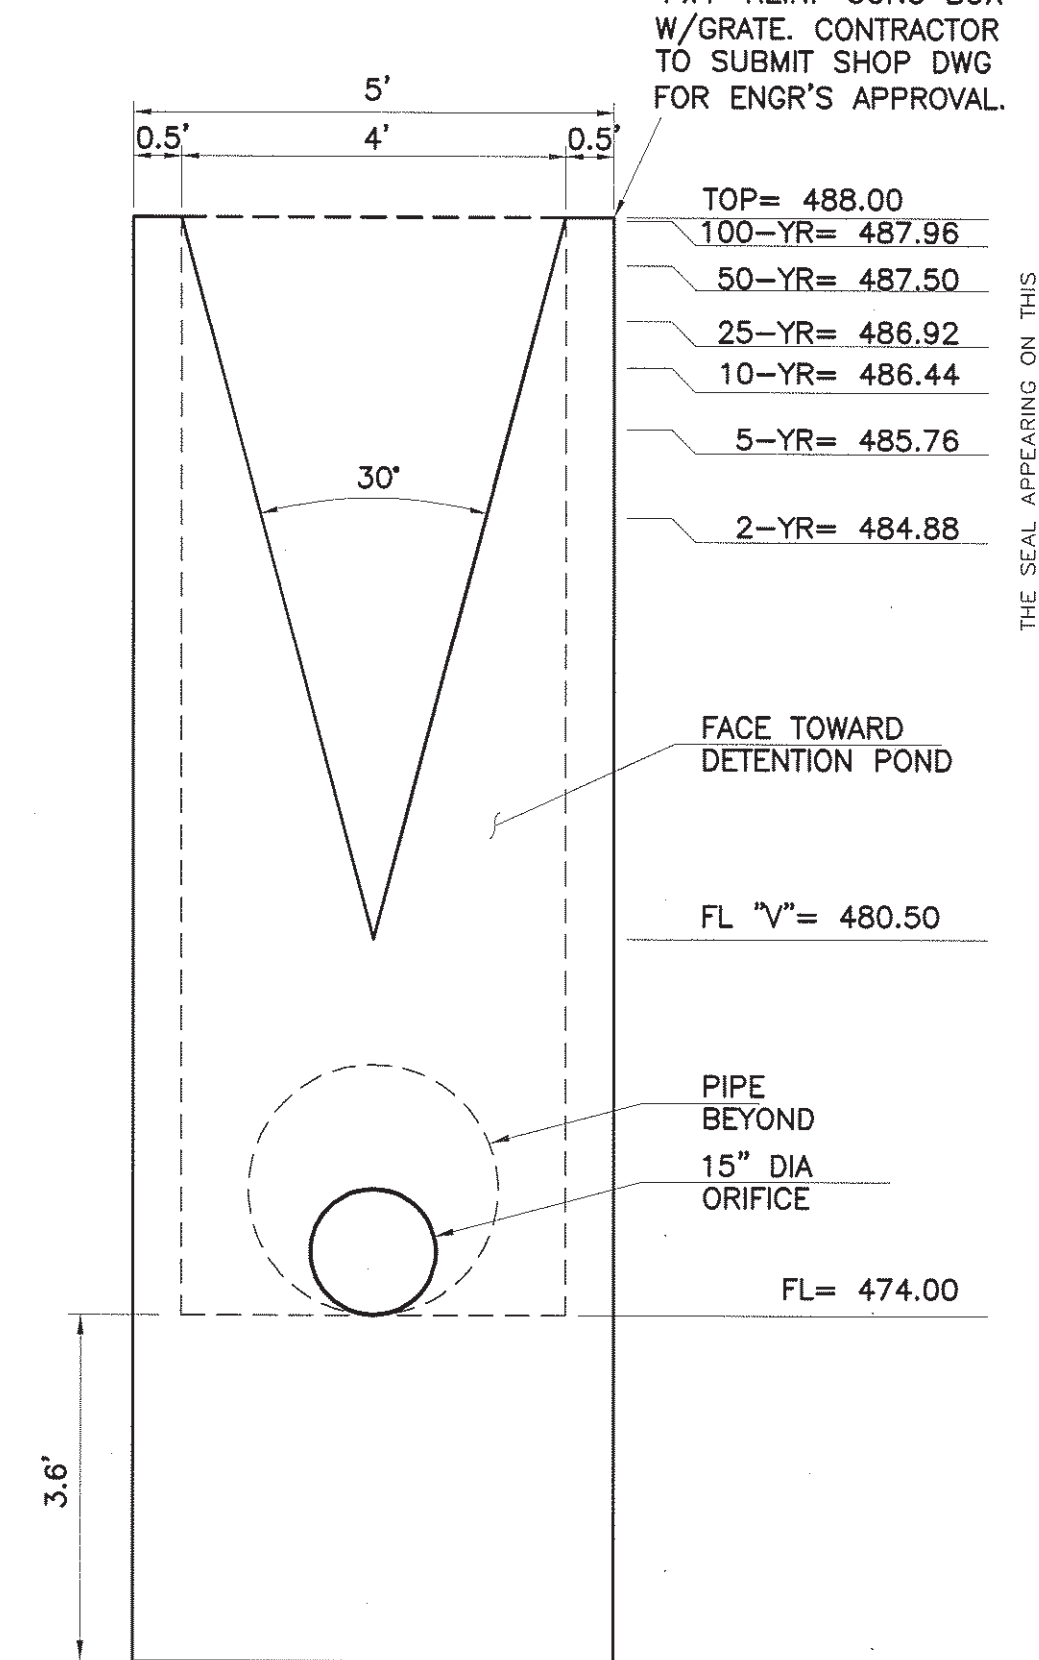

**OUTLET STRUCTURE DETAIL**  
NTS

**BUOYANCY CALCULATION:**

VOLUME OF CONCRETE=VC  
 BUOYANCY FORCE= Fb= 126CF(62.4LB/CF)= 7,863LB  
 EFFECTIVE WEIGHT OF CONCRETE= Sc= 150LB/CF  
 SPECIFIC WEIGHT OF WATER= γ= 62.4LB/CF

$$VC = \frac{Fb}{Sc - \gamma} = \frac{7,863}{150 - 62.4} = 90CF$$

DEPTH OF FOOTING=  $\frac{90CF}{5FT \times 5FT} = 3.6FT$

**STORM WATER RUNOFF DATA (POST-DEVELOPED CONDITIONS)**

DRAINAGE AREA	AREA (Acres)	C	Tc (Min)	1100 (in/hr)	Q100 (cfs)	COMMENT
1	0.28	0.90	10	9.80	2.5	TO AREA2
2	0.72	0.90	10	9.80	6.4	TO 10' CURB INLET
3	0.01	0.90	10	9.80	0.1	TO AREADRAIN INLET
4	0.01	0.90	10	9.80	0.1	TO AREADRAIN INLET
5	0.01	0.90	10	9.80	0.1	TO AREADRAIN INLET
6	0.07	0.90	10	9.80	0.6	TO AREADRAIN INLET
7	0.01	0.90	10	9.80	0.1	TO AREADRAIN INLET
8	0.50	0.90	10	9.80	4.4	TO 10' CURB INLET
9	0.01	0.90	10	9.80	0.1	TO AREADRAIN INLET
10	0.01	0.90	10	9.80	0.1	TO AREADRAIN INLET
11	0.01	0.90	10	9.80	0.1	TO AREADRAIN INLET
12	0.02	0.90	10	9.80	0.2	TO AREADRAIN INLET
13	0.09	0.90	10	9.80	0.8	TO OS2
14	0.44	0.90	10	9.80	3.9	TO AREA15
15	0.35	0.90	10	9.80	3.1	TO 10' CURB INLET
16	0.53	0.90	10	9.80	4.7	TO 10' CURB INLET
17	0.17	0.90	10	9.80	1.5	TO BLDG ROOF DRAINS
18	0.12	0.90	10	9.80	1.1	TO BLDG ROOF DRAINS
19	0.12	0.90	10	9.80	1.1	TO BLDG ROOF DRAINS
20	0.01	0.90	10	9.80	0.1	TO AREADRAIN INLET
21	0.01	0.90	10	9.80	0.1	TO AREADRAIN INLET
OS1*	0.29	0.90	10	9.80	2.6	TO AREA1
OS2*	0.75	0.90	10	9.80	6.6	TO AREA2
OS3*	3.53	0.90	10	9.80	31.1	REMAINDER OF EXIST DRNG AREA7
OS4*	21.08	0.80	10	9.80	165.3	EXIST DRNG AREA18
OS5*	1.88	0.90	10	9.80	16.6	TO FUTURE CARMEL CIRCLE STORM SYSTEM

**BENCHMARK - TBM1**

ELEV.	516.30
MON.	CUT X IN CONC
LOC.	CUT X IN TOP OF INLET NEAR S.W. PROP CORNER OF LOT 18, BLOCK A OF LA JOLLA POINTE ADDITION

EXIST DRAINAGE DIVIDE PER SHEET C-7 DRAINAGE AREA MAP FOR LA JOLLA POINTE ADDITION RECORD DRAWING DATED 9/25/03

**RECORD DRAWING**

TO THE BEST OF OUR KNOWLEDGE THE IMPROVEMENTS SHOWN ON THIS PLAN WERE COMPLETED IN GENERAL CONFORMANCE WITH THE DESIGN PLANS. THIS DETERMINATION WAS MADE BASED ON POST-CONSTRUCTION SURVEY DATA AND INFORMATION PROVIDED BY THE CONTRACTOR

Juan J. Vasquez, P.E. 09/04/2020  
SIGNED DATE

VASQUEZ ENGINEERING, LLC  
TEXAS REG. F-12266

- NOTES:**
- TOPOGRAPHIC SURVEY PROVIDED BY SELLER.
  - SEE SHEET C3.1 & C3.2 GRADING PLAN.
  - SEE SHEET C6.1 & C6.2 FOR DRAINAGE DESIGN.

VASQUEZ ENGINEERING, L.L.C.  
1919 S. Shiloh Road  
Suite 440, LB 44  
Garland, Texas 75042  
Ph: 972-278-2948  
TX Registration # F-12266



DEVELOPER:  
ROCKWALL INN KEEPERS I, LTD.  
6176 FM 2011  
LONGVIEW, TX 75603

POST-DEVELOPED DRAINAGE AREA MAP  
LOT 18, BLOCK A  
LA JOLLA POINTE ADDITION  
ROCKWALL, TEXAS

Scale: 1" = 40'  
Designed by: JUV  
Drawn by: JUV  
Checked by: JUV  
Date: 10/11/2018

SHEET  
**C4.1**

\* OFFSITE AREA OBTAINED FROM INFORMATIONAL SHEET C-7 LOCATED IN THIS PLAN SET ALONG WITH DRAINAGE AREA MAPS FROM RECORD DRAWINGS FOR MELLOW MUSHROOM, DATED 05/22/14, LOGAN'S ROADHOUSE, DATED 09/10/09, TACO CABANA, DATED 06/12/09 AND STEAK N SHAKE, DATED 08/02/05.



COMPUTATION SHEET																																							
HYDRAULIC COMPUTATIONS FOR STORM DRAINS																																							
Design Point ID	Upstream Location (Design Point)	Downstream Location	Distance	Drainage Area			Rainfall Intensity				Design Flow			Design Conduit				Friction Loss		Hydraulic Grade Line			Velocity		Minor Loss			Ground/HGL Elev				Comments							
				Drainage Area	Total Drainage Area "A"	Runoff Coefficient "C"	Incremental "CA"	Total "CA"	Design Flood	Inlet Time	Travel Time in Conduit	Time of Concentration	Rainfall Intensity "I"	Design Runoff "Q"	Inlet Bypass "Q"	Pipe Discharge "Q"	No. of Conduits	Span Box Culvert	Pipe Diameter (Culvert Rise)	Slope of Conduit	Pipe Discharge "Q"	Friction Slope (Sf)	Friction Loss	Upstream HGL Elevation	Downstream HGL Elevation	Design Point Elevation	Upstream Velocity (V1)	Downstream Velocity (V2)	Upstream Velocity Head (V1 <sup>2</sup> /2g)	Downstream Velocity Head (V2 <sup>2</sup> /2g)	Minor Loss Coefficient K		K (V1 <sup>2</sup> /2g)	Total Minor Loss	Upstream Ground Elev (Top of Curb)	Elev Difference Ground-HGL	Upstream Pipe Flowline	Downstream Pipe Flowline	
1	2	3	4	5	6	7	8	9	10	11	12	13	14	15	16	17	18	19	20	21	22	23	24	25	26	27	28	29	30	31	32	33	34	35	36	37	38	39	
<b>LINE SD-1</b>																																							
	364.84	300.00	64.84	22.32	22.32	0.90	20.09	20.09	100	10	0	10	9.80	196.87	0	196.87	1	-	60	0.0060	196.87	0.0057	0.37	504.59	504.22	506.15	497.07	10.03	10.03	0.00	1.56	0.55	0.00	1.56	509.20	3.05	499.61	499.22	18"x4" JUNCTION BOX
	300.00	230.41	69.59	0.00	22.32	0.90	20.09	40.18	100	10	0	10	9.80	196.87	0	196.87	1	-	60	0.1086	196.87	0.0057	0.40	495.51	495.11	497.07	10.03	10.03	1.56	1.90	0.55	0.00	1.56	507.00	9.93	499.22	491.66	PVI	
	230.41	178.71	51.70	2.28	24.60	0.90	22.14	62.32	100	10	0	10	9.80	216.98	0	216.98	1	-	60	0.1086	216.98	0.0069	0.36	494.08	493.72	495.11	10.03	11.05	1.56	1.90	0.55	0.86	1.04	507.30	12.19	491.66	486.05	18"x4" JUNCTION BOX	
	178.71	107.68	71.03	0.70	25.30	0.90	22.77	85.09	100	10	0	10	9.80	223.15	0	223.15	1	-	60	0.1086	223.15	0.0073	0.52	492.37	491.85	493.72	11.05	11.37	1.90	2.01	0.35	0.66	1.34	507.20	13.48	486.05	478.33	60"x18"x60" WYE	
	107.68	100.00	7.68	0.24	25.54	0.90	22.99	108.08	100	10	0	10	9.80	225.27	0	225.27	1	-	60	0.1086	225.27	0.0075	0.06	490.81	490.75	491.85	11.37	11.48	2.01	2.04	0.50	1.00	1.04	507.10	15.25	478.33	477.50	60"x8" LATERAL	
	100.00	0.00	100.00	0.00	25.54	0.90	22.99	131.06	100	10	0	10	9.80	225.27	0	225.27	1	-	60	0.0050	225.27	0.0075	0.75	488.71	487.96	490.75	11.48	11.48	2.04	2.04	0.00	0.00	2.04	506.80	16.05	477.50	477.00	PVI	
<b>LINE SD-2</b>																																							
	192.45	47.19	145.26	16.19	16.19	0.90	14.57	14.57	100	10	0	10	9.80	142.81	0	142.81	1	-	54	0.0083	142.81	0.0053	0.77	478.27	477.50	479.52	0.00	8.98	0.00	1.25	0.55	0.00	1.25	488.00	8.48	474.10	472.89	POND OUTLET STRUCTURE	
	47.19	0.00	47.19	0.00	16.19	0.90	14.57	29.14	100	10	0	10	9.80	142.81	0	142.81	1	-	54	0.0083	142.81	0.0053	0.25	477.25	477.00	477.50	8.98	8.98	1.25	1.25	0.25	1.00	0.25	487.30	9.80	472.89	472.50	54"x30" BEND	
<b>LINE SD-3</b>																																							
	66.69	50.00	16.69	1.32	1.32	0.90	1.19	1.19	100	10	0	10	9.80	11.64	0	11.64	1	-	24	0.8990	11.64	0.0026	0.04	491.32	491.27	491.53	0.00	3.71	0.00	0.21	1.50	0.00	0.21	503.50	11.97	494.00	479.00	10' CURB INLET	
	50.00	0.00	50.00	0.00	1.32	0.90	1.19	2.38	100	10	0	10	9.80	11.64	0	11.64	1	-	24	0.0600	11.64	0.0254	1.27	489.23	487.96	491.27	3.71	11.48	0.21	2.04	0.00	0.00	2.04	504.40	13.13	479.00	476.00	PVI	
<b>LATERALS</b>																																							
SD-3A	119.63	0.00	119.63	0.79	0.79	0.90	0.71	0.71	100	10	0	10	9.80	6.97	0	6.97	1	-	18	0.0334	6.97	0.0044	0.53	496.03	495.50	495.50	3.94	0.00	0.24	0.00	1.50	0.36	0.00	504.00	8.50	498.00	494.00	10' CURB INLET	
SD-3B	30.00	0.00	30.00	0.44	0.44	0.90	0.40	0.40	100	10	0	10	9.80	3.88	0	3.88	1	-	18	0.0100	3.88	0.0014	0.04	499.64	499.60	499.60	2.20	0.00	0.07	0.00	0.00	0.00	0.00	506.50	6.86	498.40	498.10	END & PLUG	
<b>LATERAL SD-1B</b>																																							
	39.63	21.80	17.83	0.69	0.69	0.90	0.62	0.62	100	10	0	10	9.80	6.09	0	6.09	1	-	18	0.2945	6.09	0.0034	0.06	493.85	493.79	494.04	0.00	3.44	0.00	0.18	1.50	0.00	0.18	505.10	11.06	499.50	494.25	10' CURB INLET	
	21.80	0.00	21.80	0.01	0.70	0.90	0.63	1.25	100	10	0	10	9.80	6.17	0	6.17	1	-	18	0.2945	6.17	0.0035	0.08	493.79	493.72	493.79	3.44	3.49	0.18	0.19	0.50	1.00	0.00	507.40	13.61	494.25	487.83	18"x45" BEND	
<b>LATERAL SD-1C</b>																																							
	291.95	170.21	121.74	0.57	0.57	0.90	0.51	0.51	100	10	0	10	9.80	5.03	0	5.03	1	-	18	0.0150	5.03	0.0023	0.28	497.39	497.11	497.52	0.00	2.85	0.00	0.13	0.00	0.00	0.13	507.90	10.38	498.04	496.21	END & PLUG	
	170.21	112.20	58.01	0.15	0.72	0.90	0.65	1.16	100	10	0	10	9.80	6.35	0	6.35	1	-	18	0.0150	6.35	0.0037	0.21	497.11	496.90	497.11	2.85	3.59	0.13	0.20	0.35	1.00	0.00	504.70	7.59	495.71	494.84	18"x8" LATERAL	
	112.20	33.30	78.90	1.56	2.28	0.90	2.05	3.21	100	10	0	10	9.80	20.11	0	20.11	1	-	24	0.0150	20.11	0.0079	0.62	496.37	495.74	496.90	3.59	6.40	0.20	0.64	0.50	0.10	0.54	504.70	7.80	494.84	493.66	24"x18"x60" WYE	
	33.30	0.00	33.30	0.00	2.28	0.90	2.05	5.27	100	10	0	10	9.80	20.11	0	20.11	1	-	24	0.0150	20.11	0.0079	0.26	495.42	495.16	495.74	6.40	6.40	0.64	0.64	0.50	0.32	0.32	507.00	11.26	493.66	493.16	24"x45" BEND	

INLET CALCULATIONS (100-YR)																			
HYDRAULIC COMPUTATIONS FOR STORM DRAINS																			
Design Point ID	INLET		STORM	DRAINAGE AREA CHARACTERISTICS				FLOW					SAG INLET		INLET LENGTH				Comments
	Storm Line	Station		Type "S" = Sag "G" = On Grade	Design Flood	Runoff Coefficient "C"	Intensity "I"	Area "A"	Street "Qs"	Pipe "Qp"	Carryover Flow to Inlet "Qco"	Total Flow to Inlet "Qt"	Gutter or ROW Capacity	Weir (W) Orifice (O) Flow	Sag Depth	Inlet Bypass Flow/Carryover "Qco"	Flow Intercept by Inlet "Qi"	Inlet Flow Bypass to Design Point	
1	2	3	4	5	6	7	8	9	10	11	12	13	14	15	16	17	18	19	
1	LAT SD-1B	0+39.63	S	100	0.90	9.80	0.50	4.41	4.41	0.00	4.41	-	W	0.50	0.00	4.41	0.00	11.06	10' CURB INLET
2	LAT SD-1C1	0+32.33	S	100	0.90	9.80	0.72	6.35	6.35	0.00	6.35	-	W	0.50	0.00	6.35	0.00	11.06	10' CURB INLET
3	LAT SD-3	0+66.69	S	100	0.90	9.80	0.53	4.67	4.67	0.00	4.67	-	W	0.50	0.00	4.67	0.00	11.06	10' CURB INLET
4	LAT SD-3A	1+19.63	S	100	0.90	9.80	0.35	3.09	3.09	0.00	3.09	-	W	0.50	0.00	3.09	0.00	11.06	10' CURB INLET

\*Inlet capacities according to Figure 3.10 for Curb Inlet in sag from City of Rockwall Standards of Design and Construction

**RECORD DRAWING**


TO THE BEST OF OUR KNOWLEDGE THE IMPROVEMENTS SHOWN ON THIS PLAN WERE COMPLETED IN GENERAL CONFORMANCE WITH THE DESIGN PLANS. THIS DETERMINATION WAS MADE BASED ON POST-CONSTRUCTION SURVEY DATA AND INFORMATION PROVIDED BY THE CONTRACTOR  
 Juan J. Vasquez, P.E. 09/04/2020

SIGNED DATE

VASQUEZ ENGINEERING, LLC  
 TEXAS REG. F-12266

VASQUEZ ENGINEERING, L.L.C.  
 1919 S. Shiloh Road  
 Suite 440, LB 44  
 Garland, Texas 75042  
 Ph: 972-278-2948  
 TX Registration # F-12266

NO. DATE  
 01/04/19 CURB INLET REVISION APP.

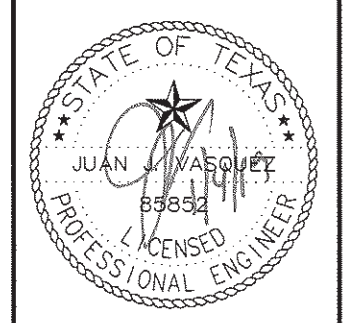

DEVELOPER:  
 ROCKWALL INN KEEPERS I, LTD.  
 6176 FM 2011  
 LONGVIEW, TX 75603

STORM SEWER CALCULATIONS  
 LOT 18, BLOCK A  
 LA JOLLA POINTE ADDITION  
 ROCKWALL, TEXAS

Scale: NO SCALE  
 Designed by: JUV  
 Drawn by: JUV  
 Checked by: JUV  
 638-01wmpc42 STORM SEWER CALCULATIONS  
 Date: 10/17/2018

SHEET  
**C4.2**



100-YEAR STORM BASIN CALCULATION

DETENTION CALCULATIONS LESS UNDEVELOPED AREA

Maximum Storage Volume is determined by deducting the volume of runoff released during the time of inflow from the total inflow for each duration.

Inflow = Storm duration X Respective Peak Discharge X 60 sec/minute  
 Outflow = Half of the Respective Inflow Duration x Control Release Discharge X 60 sec/minute

Area, acres	44.69		Area to Detention, acres	44.69	
Present Conditions					
C	0.35		C	0.81	
Tc	20.00		Tc	10.00	
i(100)	8.30		i(100)	9.80	
Q(100)	129.82		Q(100)	354.75	
Q(release)	142.81		Q=CIA		
Proposed Intensities					
Time	Inflow	Outflow	Storage (cu ft)	Tc	Intensity
5	106,425	64,263	42,162	5	9.800
10	212,850	128,526	84,324	10	9.800
15	319,275	192,789	126,486	15	9.000
20	425,700	257,052	168,648	20	8.300
30	644,550	391,578	252,972	30	6.860
40	863,400	526,104	337,296	40	5.740
50	1,082,250	660,630	421,620	50	4.950
60	1,301,100	795,156	505,944	60	4.370
70	1,519,950	929,682	590,268	70	3.910
80	1,738,800	1,064,208	674,592	80	3.700
90	1,957,650	1,198,734	758,916	90	3.500
100	2,176,500	1,333,260	843,240	100	3.000
110	2,395,350	1,467,786	927,564	110	2.700

Q RELEASE OF 142.81 CFS EQUATES TO A POND STORAGE OF 284,466 CF TO MATCH THE RECORD DRAWINGS FOR LAJOLLA POINTE ADDITION BY ALLEN & RIDGE CONSULTING, INC., DATED 03/14/03.

50-YEAR STORM BASIN CALCULATION

DETENTION CALCULATIONS LESS UNDEVELOPED AREA

Maximum Storage Volume is determined by deducting the volume of runoff released during the time of inflow from the total inflow for each duration.

Inflow = Storm duration X Respective Peak Discharge X 60 sec/minute  
 Outflow = Half of the Respective Inflow Duration x Control Release Discharge X 60 sec/minute

Area, acres	44.69		Area to Detention, acres	44.69	
Present Conditions					
C	0.35		C	0.81	
Tc	20.00		Tc	10.00	
i(100)	8.30		i(100)	9.00	
Q(100)	117.31		Q(100)	325.79	
Q(release)	122.37		Q=CIA		
Proposed Intensities					
Time	Inflow	Outflow	Storage (cu ft)	Tc	Intensity
5	97,737	55,065	42,672	5	9.000
10	195,474	110,130	85,344	10	9.000
15	293,211	165,195	128,016	15	8.100
20	390,948	220,260	170,688	20	7.500
30	586,422	331,656	254,766	30	6.100
40	781,900	443,052	338,844	40	5.200
50	977,375	554,448	422,922	50	4.500
60	1,172,850	665,844	507,000	60	3.900
70	1,368,325	777,240	591,078	70	3.700
80	1,563,800	888,636	675,156	80	3.440
90	1,759,275	1,000,032	759,234	90	3.240
100	1,954,750	1,111,428	843,312	100	3.000
110	2,150,225	1,222,824	927,390	110	2.900

Q RELEASE OF 122.37 CFS EQUATES TO A POND STORAGE OF 268,849 CF TO MATCH THE RECORD DRAWINGS FOR LAJOLLA POINTE ADDITION BY ALLEN & RIDGE CONSULTING, INC., DATED 03/14/03.

25-YEAR STORM BASIN CALCULATION

DETENTION CALCULATIONS LESS UNDEVELOPED AREA

Maximum Storage Volume is determined by deducting the volume of runoff released during the time of inflow from the total inflow for each duration.

Inflow = Storm duration X Respective Peak Discharge X 60 sec/minute  
 Outflow = Half of the Respective Inflow Duration x Control Release Discharge X 60 sec/minute

Area, acres	44.69		Area to Detention, acres	44.69	
Present Conditions					
C	0.35		C	0.81	
Tc	20.00		Tc	10.00	
i(100)	6.80		i(100)	8.30	
Q(100)	103.23		Q(100)	300.45	
Q(release)	105.24		Q=CIA		
Proposed Intensities					
Time	Inflow	Outflow	Storage (cu ft)	Tc	Intensity
5	90,135	47,358	42,777	5	8.300
10	180,270	94,716	85,554	10	8.300
15	270,405	142,074	128,331	15	7.500
20	360,540	189,432	171,108	20	6.600
30	540,810	284,148	255,662	30	5.500
40	721,080	378,864	340,216	40	4.600
50	901,350	473,580	424,770	50	4.000
60	1,081,620	568,296	509,324	60	3.500
70	1,261,890	663,012	593,878	70	3.300
80	1,442,160	757,728	678,432	80	3.060
90	1,622,430	852,444	762,986	90	2.870
100	1,802,700	947,160	847,540	100	2.700
110	1,982,970	1,041,876	932,094	110	2.500

Q RELEASE OF 105.24 CFS EQUATES TO A POND STORAGE OF 249,139 CF TO MATCH THE RECORD DRAWINGS FOR LAJOLLA POINTE ADDITION BY ALLEN & RIDGE CONSULTING, INC., DATED 03/14/03.

10-YEAR STORM BASIN CALCULATION

DETENTION CALCULATIONS LESS UNDEVELOPED AREA

Maximum Storage Volume is determined by deducting the volume of runoff released during the time of inflow from the total inflow for each duration.

Inflow = Storm duration X Respective Peak Discharge X 60 sec/minute  
 Outflow = Half of the Respective Inflow Duration x Control Release Discharge X 60 sec/minute

Area, acres	44.69		Area to Detention, acres	44.69	
Present Conditions					
C	0.35		C	0.81	
Tc	20.00		Tc	10.00	
i(100)	5.90		i(100)	7.10	
Q(100)	92.28		Q(100)	257.01	
Q(release)	81.27		Q=CIA		
Proposed Intensities					
Time	Inflow	Outflow	Storage (cu ft)	Tc	Intensity
5	77,104	36,571	40,533	5	7.100
10	154,207	73,142	81,066	10	7.100
15	231,311	109,713	121,599	15	6.500
20	308,414	146,284	162,132	20	5.900
30	462,621	219,426	245,196	30	4.800
40	616,828	292,568	328,260	40	4.000
50	771,035	365,710	411,324	50	3.500
60	925,242	438,852	494,388	60	3.050
70	1,079,449	511,994	577,452	70	2.770
80	1,233,656	585,136	660,516	80	2.560
90	1,387,863	658,278	743,580	90	2.430
100	1,542,070	731,420	826,644	100	2.300
110	1,696,277	804,562	909,708	110	2.190

Q RELEASE OF 81.27 CFS EQUATES TO A POND STORAGE OF 233,806 CF TO MATCH THE RECORD DRAWINGS FOR LAJOLLA POINTE ADDITION BY ALLEN & RIDGE CONSULTING, INC., DATED 03/14/03.

100-YEAR POND VOLUME (CF)

ELEV	AREA (sf)	AVG AREA (sf)	VOL (cu ft)	CUM VOL (cu ft)	100-YEAR VOLUME (cu ft)	100-YEAR WSEL
490	42,302					
		39,844	39,844	361,850		
489	37,386					
		36,267	36,267	322,006		
488	35,148					
		34,058	34,058	285,739		
487	32,967				284,466	487.96
		31,905	31,905	251,682		
486	30,842					
		29,808	29,808	219,777		
485	28,774					
		27,769	27,769	189,969		
484	26,763					
		25,786	25,786	162,201		
483	24,808					
		23,859	23,859	136,415		
482	22,909					
		21,988	21,988	112,557		
481	21,067					
		20,175	20,175	90,569		
480	19,282					
		18,418	18,418	70,394		
479	17,553					
		16,717	16,717	51,977		
478	15,881					
		15,074	15,074	35,260		
477	14,266					
		12,481	12,481	20,186		
476	10,695					
		7,116	7,116	7,706		
475	3,537					
		590	590			
474	0					

50-YEAR POND VOLUME (CF)

ELEV	AREA (sf)	AVG AREA (sf)	VOL (cu ft)	CUM VOL (cu ft)	50-YEAR VOLUME (cu ft)	50-YEAR WSEL
490	42,302					
		39,844	39,844	361,850		
489	37,386					
		36,267	36,267	322,006		
488	35,148					
		34,058	34,058	285,739		
487	32,967				268,849	487.50
		31,905	31,905	251,682		
486	30,842					
		29,808	29,808	219,777		
485	28,774					
		27,769	27,769	189,969		
484	26,763					
		25,786	25,786	162,201		
483	24,808					
		23,859	23,859	136,415		
482	22,909					
		21,988	21,988	112,557		
481	21,067					
		20,175	20,175	90,569		
480	19,282					
		18,418	18,418	70,394		
479	17,553					
		16,717	16,717	51,977		
478	15,881					
		15,074	15,074	35,260		
477	14,266					
		12,481	12,481	20,186		
476	10,695					
		7,116	7,116	7,706		
475	3,537					
		590	590			
474	0					

25-YEAR POND VOLUME (CF)

ELEV	AREA (sf)	AVG AREA (sf)	VOL (cu ft)	CUM VOL (cu ft)	25-YEAR VOLUME (cu ft)	25-YEAR WSEL
490	42,302					
		39,844	39,844	361,850		
489	37,386					
		36,267	36,267	322,006		
488	35,148					
		34,058	34,058	285,739		
487	32,967					
		31,905	31,905	251,682		
486	30,842				249,139	486.92
		29,808	29,808	219,777		
485	28,774					
		27,769	27,769	189,969		
484	26,763					
		25,786	25,786	162,201		
483	24,808					
		23,859	23,859	136,415		
482	22,909					
		21,988	21,988	112,557		
481	21,067					
		20,175	20,175	90,569		
480	19,282					
		18,418	18,418	70,394		
479	17,553					
		16,717	16,717	51,977		
478	15,881					
		15,074	15,074	35,260		
477	14,2					



5-YEAR STORM BASIN CALCULATION									
DETENTION CALCULATIONS LESS UNDEVELOPED AREA									
Maximum Storage Volume is determined by deducting the volume of runoff released during the time of inflow from the total inflow for each duration.									
Inflow = Storm duration X Respective Peak Discharge X 60 sec/minute									
Outflow = Half of the Respective Inflow Duration x Control Release Discharge X 60 sec/minute.									
	Area, acres						Area to Detention, acres		
		44.69					44.69		
	Present Conditions				Proposed Conditions				
	C	0.35			C	0.81			
	Tc	20.00			Tc	10.00			
	i(100)	4.90			i(100)	6.10			
	Q(100)	76.64			Q(100)	220.81			
	Q(release)	63.40			Q=CIA				
	Proposed Intensities								
Time	Inflow	Outflow	Storage (cf)				Tc	Intensity	
5	66,244	28,528	37,716				5	6.100	
10	132,488	57,056	75,432				10	6.100	
15	179,185	85,584	93,601				15	5.500	
20	212,850	114,112	100,738				20	4.900	
30	267,148	148,550	118,598				30	4.100	
40	295,383	171,168	124,215				40	3.400	
50	304,071	177,036	127,035				50	2.800	
60	338,822	169,411	169,411				60	2.600	
70	364,685	152,149	212,536				70	2.400	
80	382,260	133,131	249,129				80	2.200	
90	400,722	111,818	288,904				90	2.050	
100	412,667	90,909	321,758				100	1.900	
110	430,043	72,224	357,819				110	1.800	

Q RELEASE OF 63.40 CFS EQUATES TO A POND STORAGE OF 212,736 CF TO MATCH THE RECORD DRAWINGS FOR LAJOLLA POINTE ADDITION BY ALLEN & RIDGE CONSULTING, INC., DATED 03/14/03.

5-YEAR POND VOLUME (CF)						
ELEV	AREA (sf)	AVG AREA (sf)	VOL (cu ft)	CUM VOL (cu ft)	5-YEAR VOLUME (cu ft)	5-YEAR WSEL
490	42,302					
		39,844	39,844	361,850		
489	37,386					
		36,267	36,267	322,006		
488	35,148					
		34,058	34,058	285,739		
487	32,967					
		31,905	31,905	251,682		
486	30,842					
		29,808	29,808	219,777		
485	28,774				212,736	485.76
		27,769	27,769	189,969		
484	26,763					
		25,786	25,786	162,201		
483	24,808					
		23,859	23,859	136,415		
482	22,909					
		21,988	21,988	112,557		
481	21,067					
		20,175	20,175	90,569		
480	19,282					
		18,418	18,418	70,394		
479	17,553					
		16,717	16,717	51,977		
478	15,881					
		15,074	15,074	35,260		
477	14,266					
		12,481	12,481	20,186		
476	10,695					
		7,116	7,116	7,706		
475	3,537					
		590	590			
474	0					

2-YEAR STORM BASIN CALCULATION									
DETENTION CALCULATIONS LESS UNDEVELOPED AREA									
Maximum Storage Volume is determined by deducting the volume of runoff released during the time of inflow from the total inflow for each duration.									
Inflow = Storm duration X Respective Peak Discharge X 60 sec/minute									
Outflow = Half of the Respective Inflow Duration x Control Release Discharge X 60 sec/minute.									
	Area, acres						Area to Detention, acres		
		44.69					44.69		
	Present Conditions				Proposed Conditions				
	C	0.35			C	0.81			
	Tc	20.00			Tc	10.00			
	i(100)	3.80			i(100)	5.30			
	Q(100)	61.00			Q(100)	191.85			
	Q(release)	36.28			Q=CIA				
	Proposed Intensities								
Time	Inflow	Outflow	Storage (cf)				Tc	Intensity	
5	57,556	16,328	41,228				5	5.300	
10	115,113	32,656	82,456				10	5.300	
15	146,606	48,984	97,622				15	4.500	
20	169,411	64,712	104,699				20	3.900	
30	215,021	90,909	124,112				30	3.300	
40	225,881	117,144	108,737				40	2.600	
50	249,772	143,380	106,392				50	2.300	
60	247,600	169,411	78,189				60	1.900	
70	273,684	195,432	78,252				70	1.800	
80	283,220	221,453	61,767				80	1.630	
90	293,211	247,474	45,737				90	1.500	
100	304,071	273,495	30,576				100	1.400	
110	312,976	300,022	12,954				110	1.310	

Q RELEASE OF 36.28 CFS EQUATES TO A POND STORAGE OF 186,583 CF TO MATCH THE RECORD DRAWINGS FOR LAJOLLA POINTE ADDITION BY ALLEN & RIDGE CONSULTING, INC., DATED 03/14/03.

2-YEAR POND VOLUME (CF)						
ELEV	AREA (sf)	AVG AREA (sf)	VOL (cu ft)	CUM VOL (cu ft)	2-YEAR VOLUME (cu ft)	2-YEAR WSEL
490	42,302					
		39,844	39,844	361,850		
489	37,386					
		36,267	36,267	322,006		
488	35,148					
		34,058	34,058	285,739		
487	32,967					
		31,905	31,905	251,682		
486	30,842					
		29,808	29,808	219,777		
485	28,774					
		27,769	27,769	189,969		
484	26,763				186,583	484.88
		25,786	25,786	162,201		
483	24,808					
		23,859	23,859	136,415		
482	22,909					
		21,988	21,988	112,557		
481	21,067					
		20,175	20,175	90,569		
480	19,282					
		18,418	18,418	70,394		
479	17,553					
		16,717	16,717	51,977		
478	15,881					
		15,074	15,074	35,260		
477	14,266					
		12,481	12,481	20,186		
476	10,695					
		7,116	7,116	7,706		
475	3,537					
		590	590			
474	0					


**RECORD DRAWING**

TO THE BEST OF OUR KNOWLEDGE THE IMPROVEMENTS SHOWN ON THIS PLAN WERE COMPLETED IN GENERAL CONFORMANCE WITH THE DESIGN PLANS. THIS DETERMINATION WAS MADE BASED ON POST-CONSTRUCTION SURVEY DATA AND INFORMATION PROVIDED BY THE CONTRACTOR  
 Juan J. Vasquez, P.E. 09/04/2020


SIGNED DATE

VASQUEZ ENGINEERING, LLC  
 TEXAS REG. F-12266

THE SEAL APPEARING ON THIS DOCUMENT WAS AUTHORIZED BY JUAN J. VASQUEZ, P.E. 09/07/2018

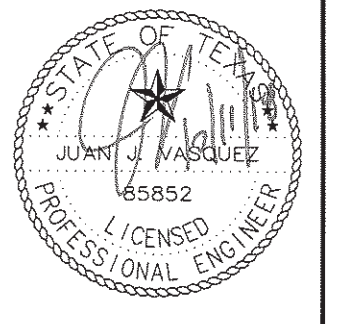

VASQUEZ ENGINEERING, L.L.C.  
 1919 S. Shiloh Road  
 Suite 440, LB 44  
 Garland, Texas 75042  
 Ph: 972-276-2948  
 TX Registration # F-12266

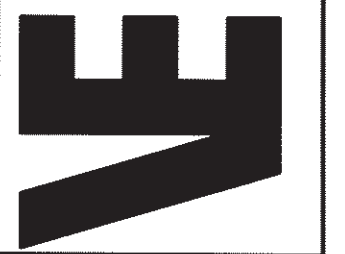

**DEVELOPER:**


ROCKWALL INN KEEPERS I, LTD.  
 6176 FM 2011  
 LONGVIEW, TX 75603

**DETENTION CALCULATIONS**

LOT 18, BLOCK A  
 LA JOLLA POINTE ADDITION  
 ROCKWALL, TEXAS

Scale:	NO SCALE
Designed by:	JJV
Drawn by:	JJV
Checked by:	JJV
656-0104/C4.4 DETENTION CALCULATIONS	
Date:	10/11/2018



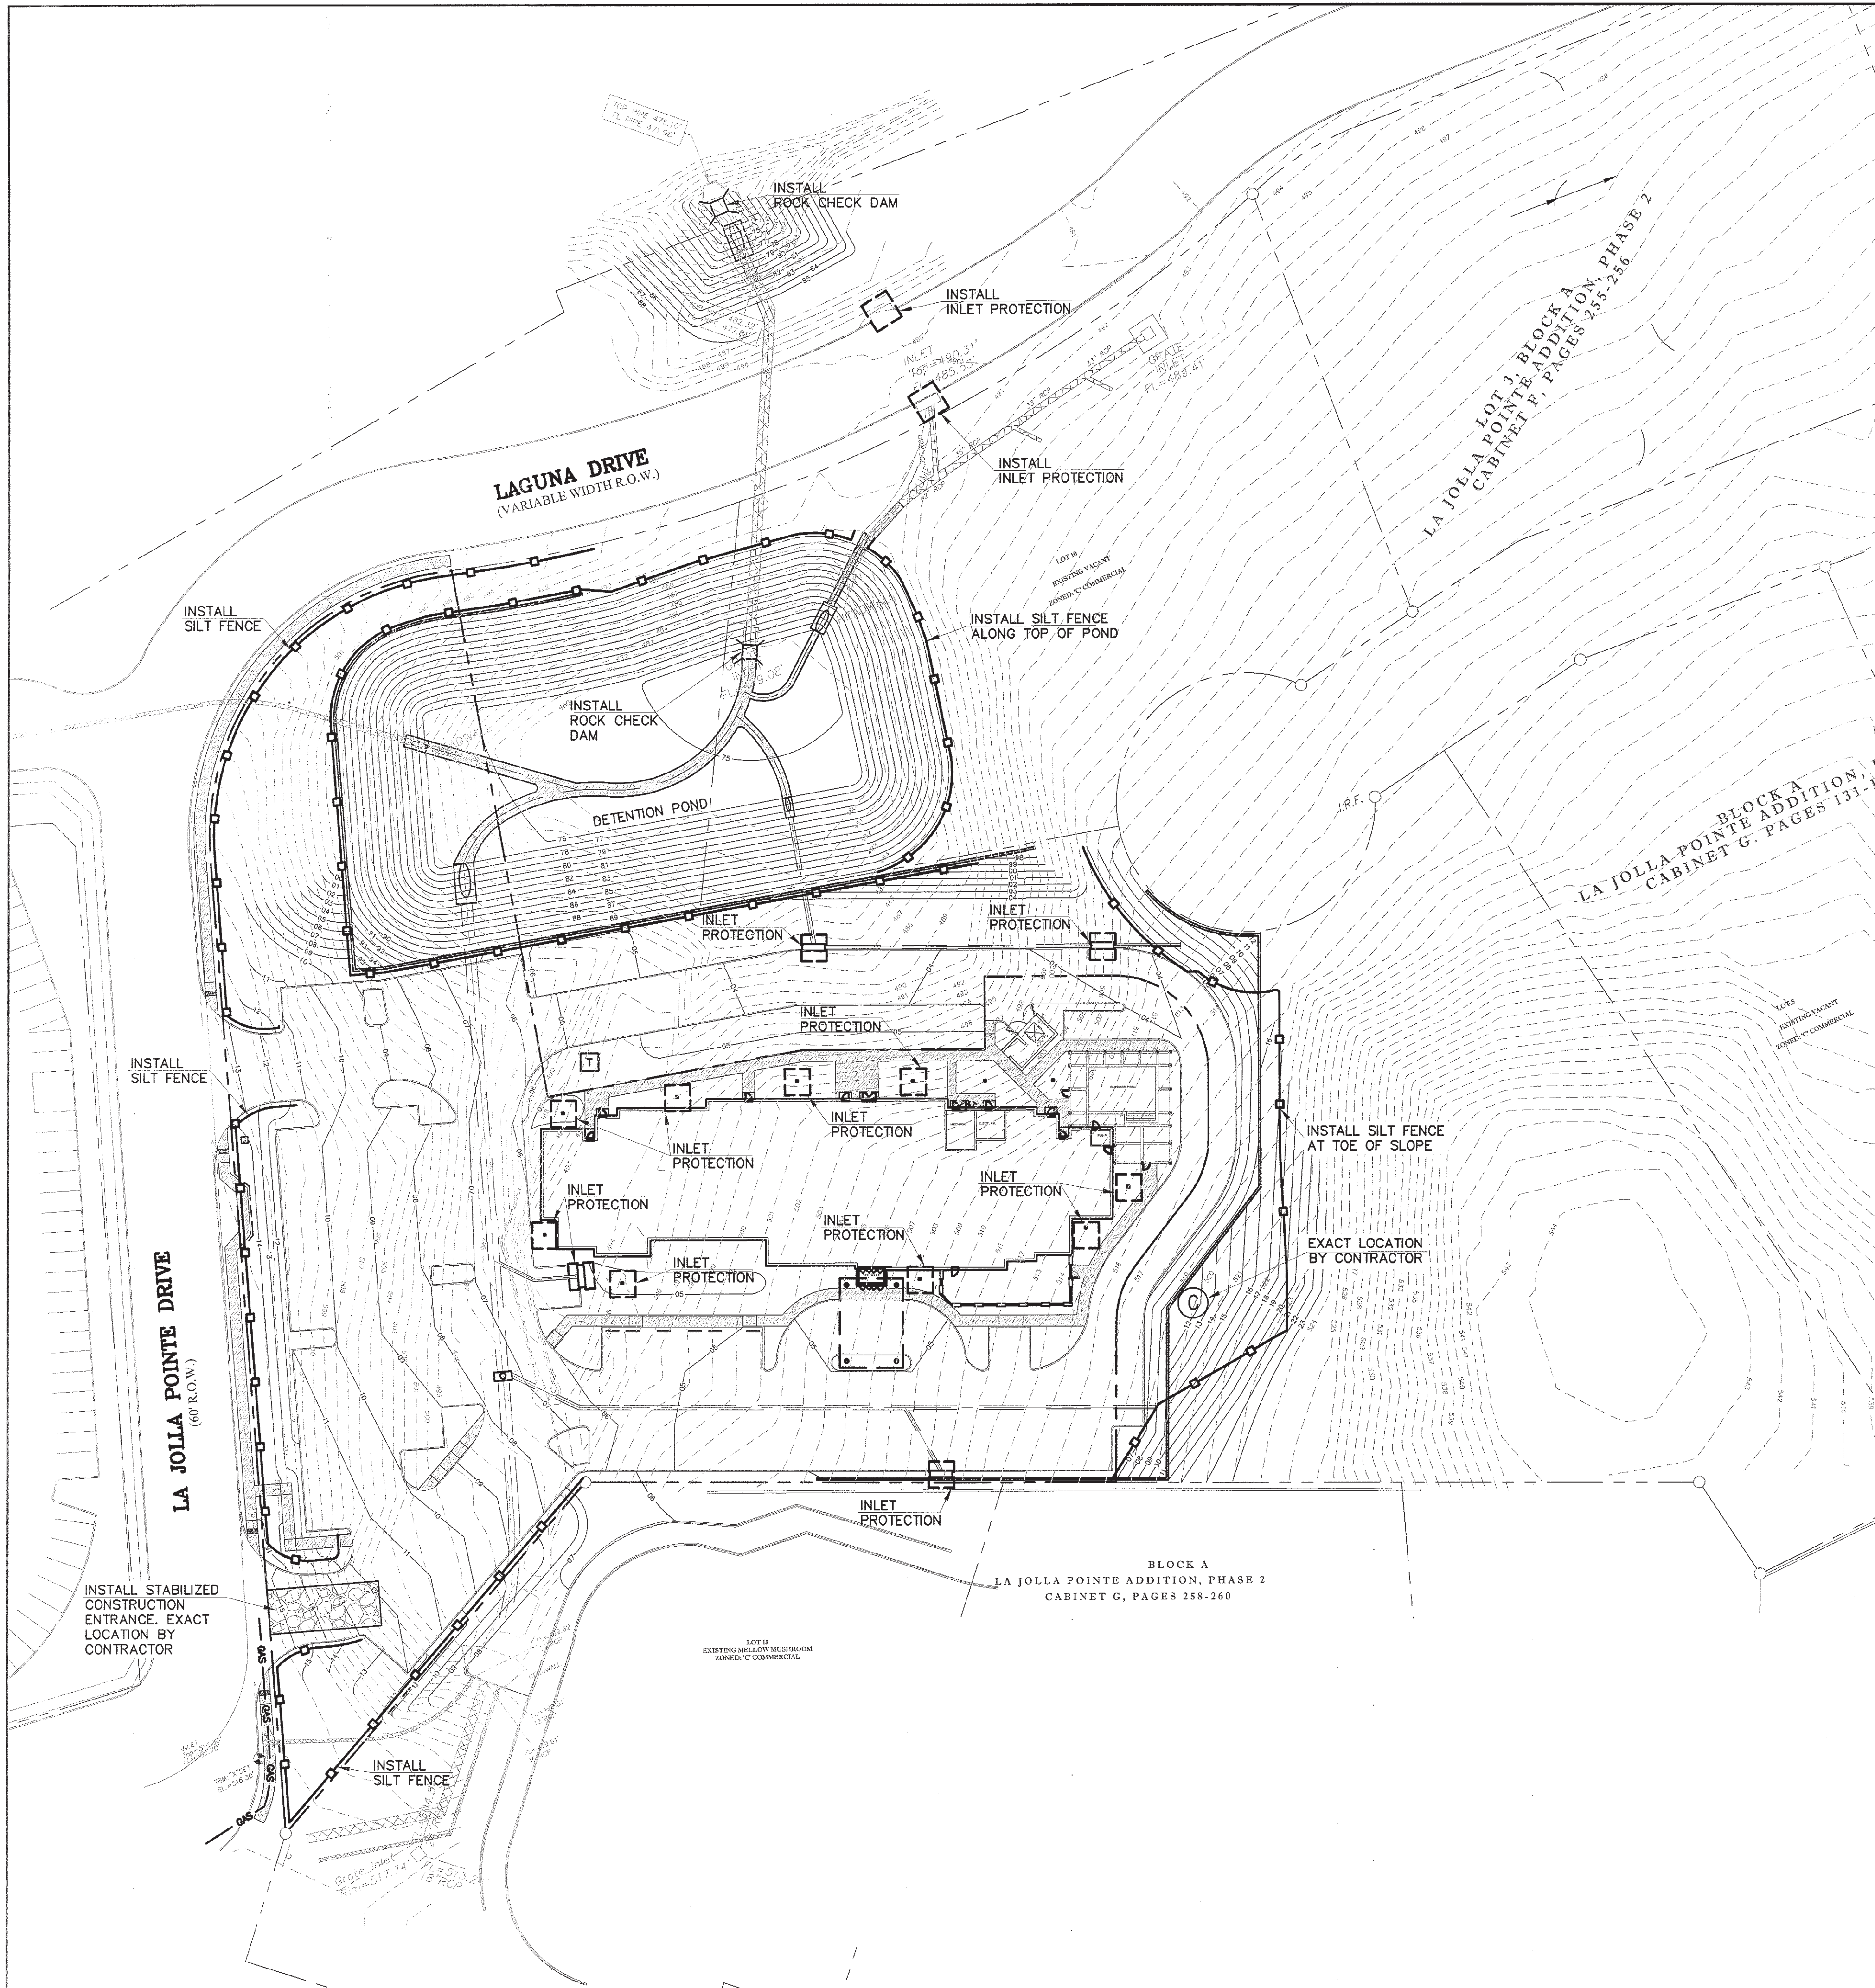


**LEGEND**

- PROPERTY LINE
- PAVEMENT CURB/GUTTER
- 503 EXIST. CONTOUR
- 04 PROP. CONTOUR
- FLOW ARROW
- SILT FENCE
- ▣ STABILIZED CONSTRUCTION ENTRANCE
- INLET PROTECTION
- ⊙ CONCRETE WASHOUT
- ▨ EXISTING STORM SEWER
- ▨ PROPOSED STORM SEWER
- ⊞ ROCK CHECK DAM

TOTAL AREA = 2.681 ACRES  
DISTURBED AREA = 4.8 ACRES

- NOTES:**
1. TOPOGRAPHIC SURVEY PROVIDED BY SELLER.
  2. SEE SHEET C3.1-C3.2 FOR GRADING PLAN.
  3. SEE SHEET C4 FOR DRAINAGE AREA MAP.
  4. SEE SHEET C5.2 FOR EROSION CONTROL DETAILS.
  5. SEE SHEET C6.1 FOR STORM SEWER PLAN.

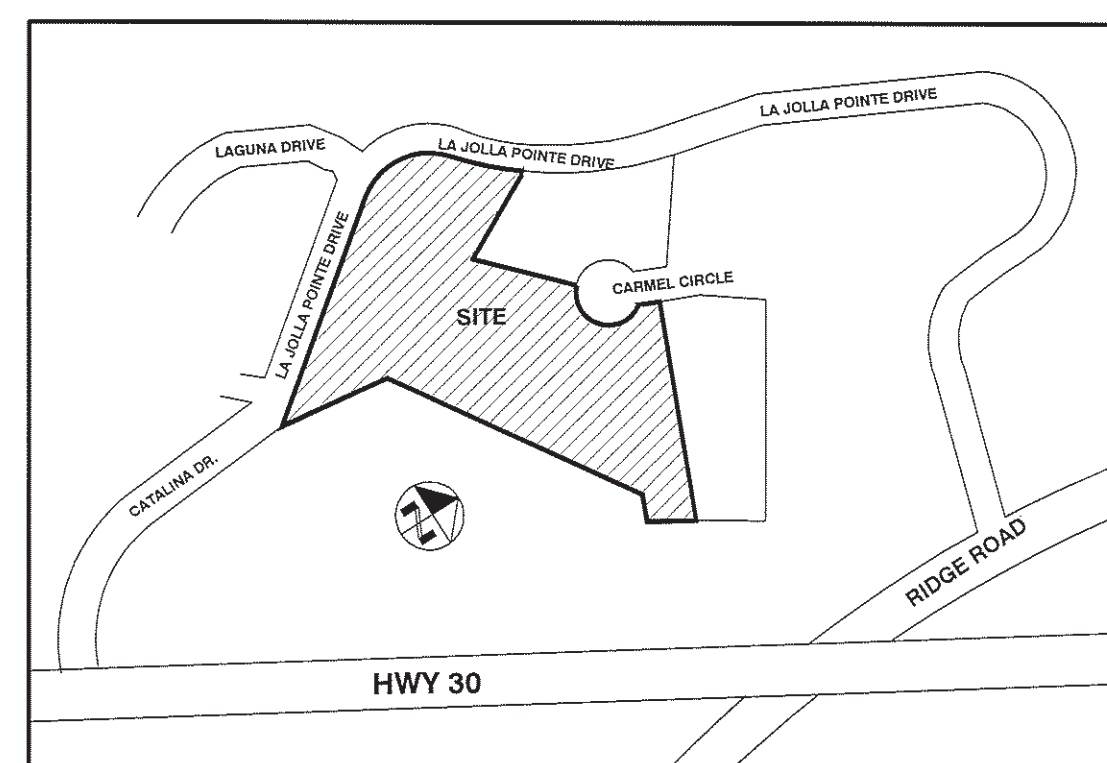

**LOCATION MAP**  
N.T.S.

**GRAPHIC SCALE**  
0 20 40 80  
( IN FEET )  
1 inch = 40 ft

**BENCHMARK - TBM 1**

ELEV.	516.30
MON.	CUT X IN CONC
LOC.	CUT X IN TOP OF INLET NEAR S.W. PROP CORNER OF LOT 18, BLOCK A OF LA JOLLA POINTE ADDITION

THE SEAL APPEARING ON THIS DOCUMENT WAS AUTHORIZED BY  
JUAN J. VASQUEZ, P.E. 65852, ON  
07/17/2018

**VASQUEZ ENGINEERING, L.L.C.**  
1919 S. Shiloh Road  
Suite 440, LB 44  
Garland, Texas 75042  
Ph: 972-278-2948  
TX Registration # F-12266



**DEVELOPER:**  
ROCKWALL INN KEEPERS I, LTD.  
6176 FM 2011  
LONGVIEW, TX 75603

**EROSION CONTROL NOTES**

- A. THE SPECIFIC PLANT MATERIALS PROPOSED TO PROTECT FILL AND EXCAVATED SLOPES SHALL BE AS INDICATED ON THE PLANS. PLANT MATERIALS MUST BE SUITABLE FOR USE UNDER LOCAL CLIMATE AND SOIL CONDITIONS. IN GENERAL, HYDROSEEDING OR SODDING BERMUDA GRASS IS ACCEPTABLE DURING THE SUMMER MONTHS (MAY 1, TO AUGUST 30). WINTER RYE OR FESCUE GRASS MAY BE PLANTED DURING TIMES OTHER THAN THE SUMMER MONTHS AS A TEMPORARY MEASURE UNTIL SUCH TIME AS THE PERMANENT PLANTING CAN BE MADE.
- B. PRIOR TO COMMENCING ANY CONSTRUCTION, A CONSTRUCTION ENTRANCE AND PERIMETER SILT FENCE SHALL BE INSTALLED AT THE LOCATION(S) SHOWN.
- C. AS INLETS ARE COMPLETED, TEMPORARY SEDIMENT BARRIERS SHALL BE INSTALLED.
- D. AT THE COMPLETION OF THE PAVING AND FINAL GRADING, THE DISTURBED AREA(S) SHALL BE REVEGETATED IN ACCORDANCE WITH THE PLANS.
- E. SILT FENCE AND INLET SEDIMENT BARRIERS SHALL REMAIN IN PLACE UNTIL REVEGETATION HAS BEEN COMPLETED.
- F. DISTURBED AREAS THAT ARE SEEDDED OR SODDED SHALL BE CHECKED PERIODICALLY TO SEE THAT GRASS COVERAGE IS PROPERLY MAINTAINED. DISTURBED AREAS SHALL BE WATERED, FERTILIZED, AND RESEEDDED OR RESODDED, IF NECESSARY.

**EROSION PROTECTION DURING CONSTRUCTION**

1. CONTRACTOR SHALL BE RESPONSIBLE FOR IMPLEMENTING EROSION CONTROL TECHNIQUES AND METHODS TO STOP EROSION OF ONSITE SOILS AND PROTECT ADJACENT PROPERTIES FROM POTENTIAL SILT MIGRATION. SILT FENCING SHALL BE INSTALLED AT THE LOCATIONS SHOWN PRIOR TO THE START OF CONSTRUCTION AND SITE GRADING.
2. EROSION CONTROL MEASURES SHALL BE IMPLEMENTED PER CITY AND DEQ REQUIREMENTS. ALL APPLICABLE FEES AND SUBMITTALS SHALL BE MADE PRIOR TO THE START OF CONSTRUCTION.
3. SINCE DISTURBED AREA IS GREATER THAN 1.0 ACRES A SWPPP WILL BE REQUIRED.

**RECORD DRAWING**

TO THE BEST OF OUR KNOWLEDGE THE IMPROVEMENTS SHOWN ON THIS PLAN WERE COMPLETED IN GENERAL CONFORMANCE WITH THE DESIGN PLANS. THIS DETERMINATION WAS MADE BASED ON POST-CONSTRUCTION SURVEY DATA AND INFORMATION PROVIDED BY THE CONTRACTOR

Juan J. Vasquez, P.E. 09/04/2020

SIGNED \_\_\_\_\_ DATE \_\_\_\_\_

VASQUEZ ENGINEERING, LLC  
TEXAS REG. F-12266


**EROSION CONTROL PLAN**

LOT 18, BLOCK A  
LA JOLLA POINTE ADDITION  
ROCKWALL, TEXAS


Scale: 1" = 40'  
Designed by: JJV  
Drawn by: JJV  
Checked by: JJV  
658-0176w05-1-EROSION CONTROL PLAN.dwg  
Date: 10/11/2018

SHEET  
**C5.1**




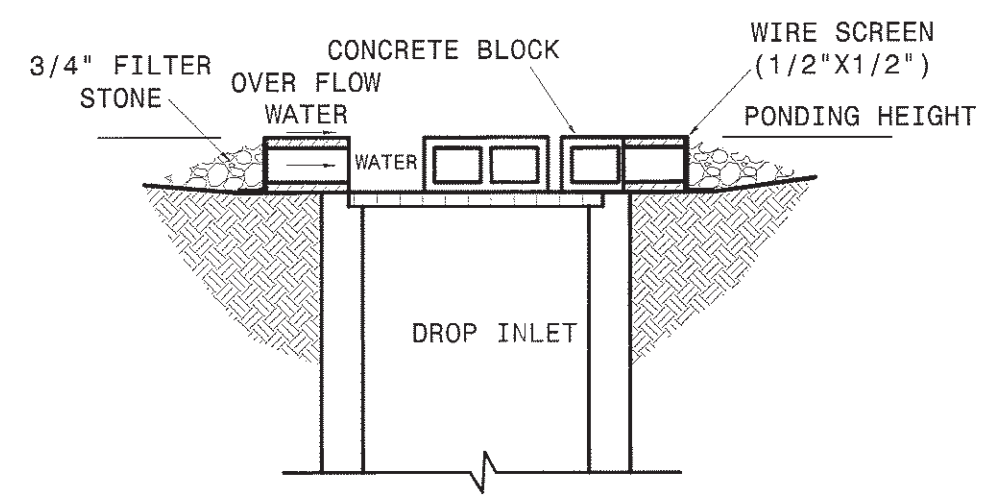


CROSS SECTION  
N.T.S.

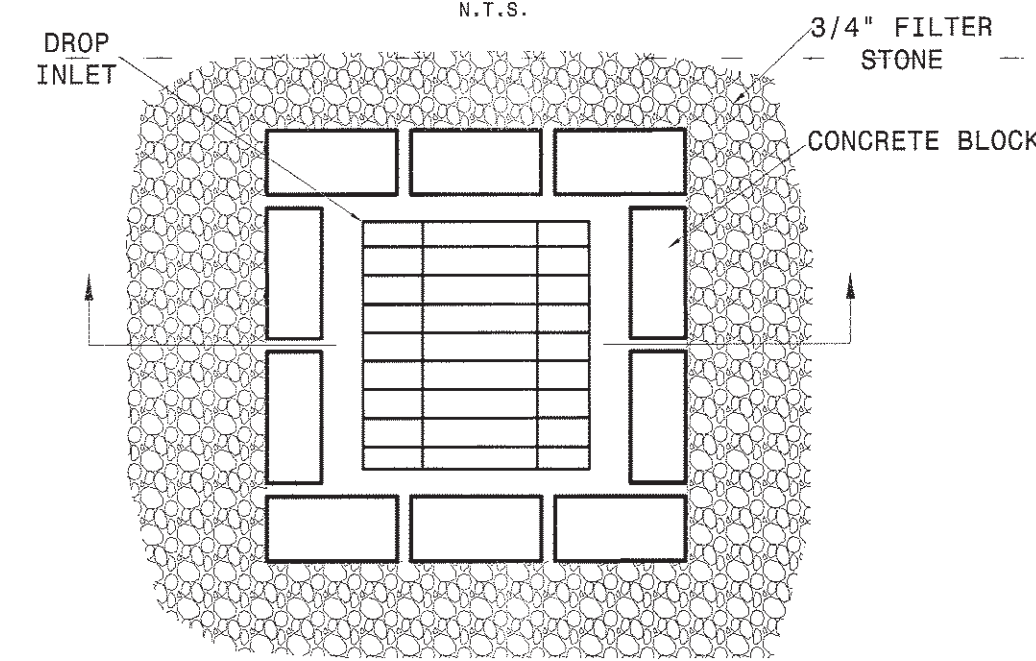

INLET PROTECTION  
N.T.S.

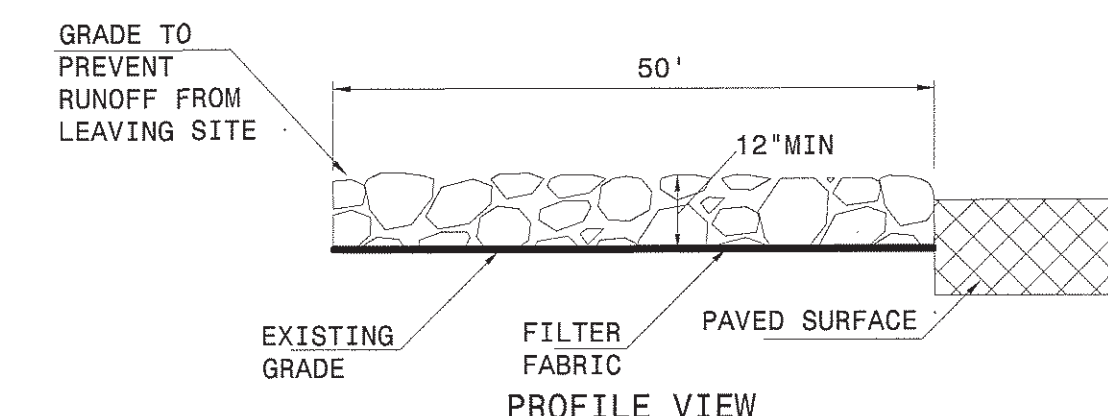

PROFILE VIEW  
N.T.S.

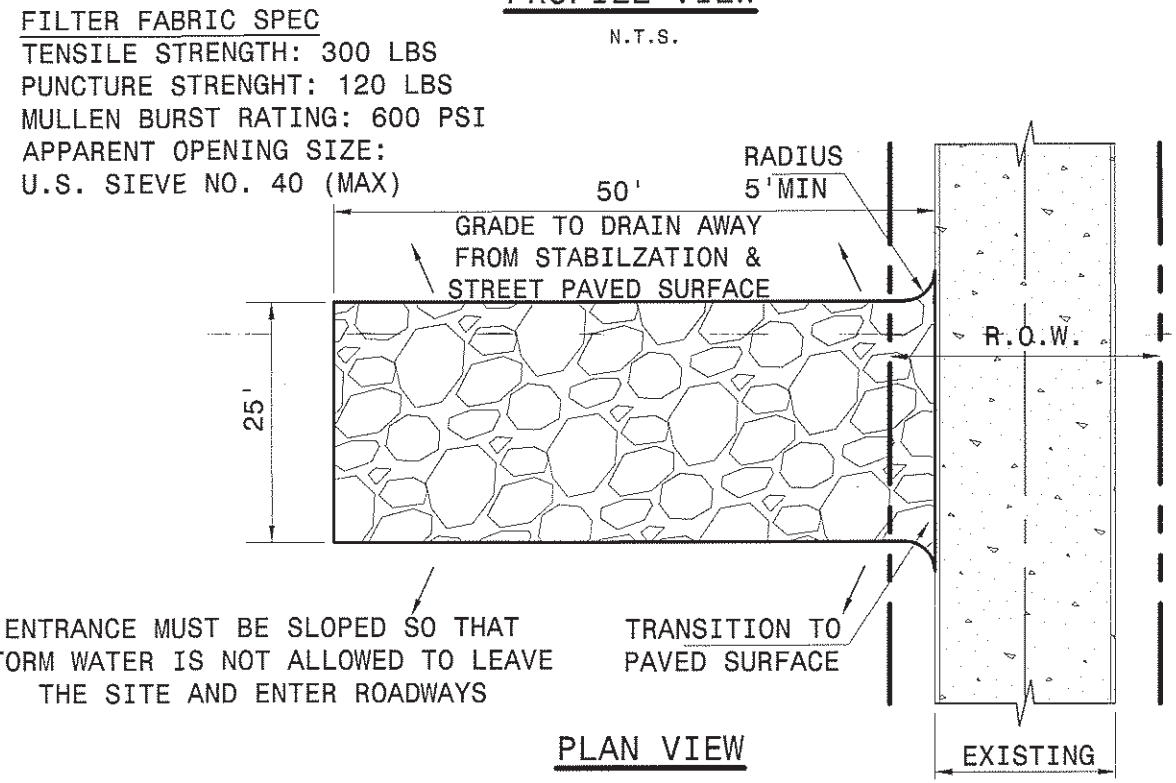


PLAN VIEW  
N.T.S.

NOTE:  
INSTALL SILT FENCE, CONSTRUCTION SAFETY FENCING, OR SIMILAR BARRIER ALONG THE EXIT TO DIRECT TRAFFIC INTO THE EXIT.

STABILIZED CONSTRUCTION ENTRANCE  
N.T.S.

**STABILIZED CONSTRUCTION ENTRANCE NOTES:**

1. STONE SIZE - 4 TO 6 INCHES STONE. NO RECYCLED CONCRETE ALLOWED.
2. LENGTH-AS EFFECTIVE, BUT NOT LESS THAN 50 FEET.
3. THICKNESS-NOT LESS THAN 12-INCHES.
4. WIDTH-NOT LESS THAN FULL WIDTH OF ALL POINTS OF INGRESS OR EGRESS.
5. WASHING-WHEN NECESSARY, WHEELS SHALL BE CLEANED TO REMOVE SEDIMENT PRIOR TO ENTRANCE ONTO PUBLIC ROADWAY. WHEN WASHING IS REQUIRED, IT SHALL BE DONE ON AN AREA STABILIZED WITH CRUSHED STONE WHICH DRAINS INTO AN APPROVED TRAP OR SEDIMENT BASIN. ALL SEDIMENT SHALL BE PREVENTED FROM ENTERING ANY STORM DRAIN, DITCH, OR WATERCOURSE USING APPROVED METHODS.
6. MAINTENANCE-THE ENTRANCE SHALL BE MAINTAINED IN A CONDITION WHICH WILL PREVENT TRACKING OR FLOWING OF SEDIMENT ONTO PUBLIC ROADWAYS. THIS MAY REQUIRE PERIODIC TOP DRESSING WITH ADDITIONAL STONE AS CONDITIONS DEMAND, AND REPAIR AND/OR CLEANOUT OF ANY MEASURES USED TO TRAP SEDIMENT. ALL SEDIMENT SPILLED DROPPED, WASHED OR TRACKED ONTO PUBLIC ROADWAY MUST BE REMOVED IMMEDIATELY.
7. DRAINAGE-ENTRANCE MUST BE PROPERLY GRADED OR INCORPORATE A DRAINAGE SWALE TO PREVENT RUNOFF FROM LEAVING THE CONSTRUCTION SITE.
8. PREVENT SHORTCUTTING OF THE FULL LENGTH OF THE CONSTRUCTION ENTRANCE BY INSTALLING BARRIERS AS NECESSARY.

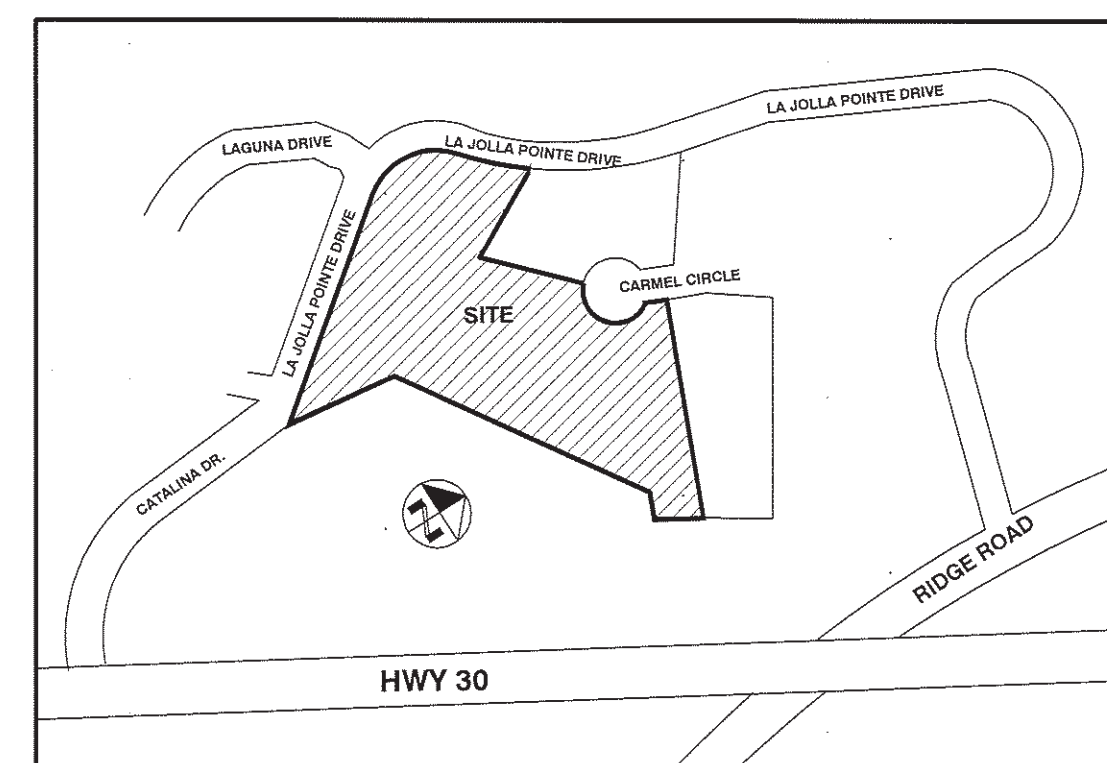

LOCATION MAP  
N.T.S.

BENCHMARK - TBM  
ELEV: 516.30  
MON. CUT X IN CONC.  
LOC. CUT X IN TOP OF INLET NEAR S.W. CORNER OF LOT 18, BLOCK A OF LA JOLLA PONTE ADDITION

THE SEAL APPEARING ON THIS DOCUMENT WAS AUTHORIZED BY  
JUAN J. VASQUEZ, P.E. 85852, ON  
10/11/2018

VASQUEZ ENGINEERING, L.L.C.  
1919 S. Shiloh Road  
Suite 440, LB 44  
Garland, Texas 75042  
Ph: 972-278-2948  
TX Registration # F-12266



DEVELOPER:  
ROCKWALL INN KEEPERS I, LTD.  
6176 FM 2011  
LONGVIEW, TX 75063

EROSION CONTROL DETAILS  
LOT 18, BLOCK A  
LA JOLLA PONTE ADDITION  
ROCKWALL, TEXAS

Scale: NONE  
Designed by: JJV  
Drawn by: JJV  
Checked by: JJV  
Date: 10/11/2018

SHEET

C5.2


**RECORD DRAWING**

TO THE BEST OF OUR KNOWLEDGE THE IMPROVEMENTS SHOWN ON THIS PLAN WERE COMPLETED IN GENERAL CONFORMANCE WITH THE DESIGN PLANS. THIS DETERMINATION WAS MADE BASED ON POST-CONSTRUCTION SURVEY DATA AND INFORMATION PROVIDED BY THE CONTRACTOR  
Juan J. Vasquez, P.E. 09/04/2020  
SIGNED DATE

VASQUEZ ENGINEERING, LLC  
TEXAS REG. F-12266

**SILT FENCE NOTES:**


1. STEEL POST WHICH SUPPORT THE SILT FENCE SHALL BE INSTALLED ON A SLIGHT ANGLE TOWARD THE ANTICIPATED RUNOFF SOURCE. POST MUST BE EMBEDDED A MINIMUM OF ONE FOOT.
2. THE TOE OF THE SILT FENCE SHALL BE TRENCHED IN WITH A SPADE OR MECHANICAL TRENCHER, SO THAT THE DOWN SLOPE FACE OF THE TRENCH IS FLAT AND PERPENDICULAR TO THE LINE OF FLOW. WHERE FENCE CANNOT BE TRENCHED IN (E.G. PAVEMENT), WEIGHT FABRIC FLAP WITH ROCK ON UPHILL SIDE TO PREVENT FLOW FROM SEEPING UNDER FENCE.
3. THE TRENCH MUST BE A MINIMUM OF 6 INCHES DEEP AND 6 INCHES WIDE TO ALLOW FOR THE SILT FENCE FABRIC TO BE LAID IN THE GROUND AND BACKFILLED WITH COMPACTED MATERIAL.
4. SILT FENCE SHOULD BE SECURELY FASTENED TO EACH STEEL SUPPORT POST OR TO WOVEN WIRE, WHICH IS IN TURN ATTACHED TO THE STEEL FENCE POST. THERE SHALL BE A 3 FOOT OVERLAP, SECURELY FASTENED WHERE ENDS OF FABRIC MEET.
5. INSPECTION SHALL BE MADE WEEKLY AND AFTER EACH RAINFALL. REPAIR OR REPLACEMENT SHALL BE MADE PROMPTLY AS NEEDED.
6. SILT FENCE SHALL BE REMOVED WHEN THE SITE IS COMPLETELY STABILIZED SO AS NOT TO BLOCK OR IMPEDE STORM FLOW OR DRAINAGE.
7. ACCUMULATED SILT SHALL BE REMOVED WHEN IT REACHES A DEPTH OF HALF THE HEIGHT OF THE FENCE. THE SILT SHALL BE DISPOSED OF AT AN APPROVED SITE AND IN SUCH A MANNER AS TO NOT CONTRIBUTE TO ADDITIONAL SILTATION.

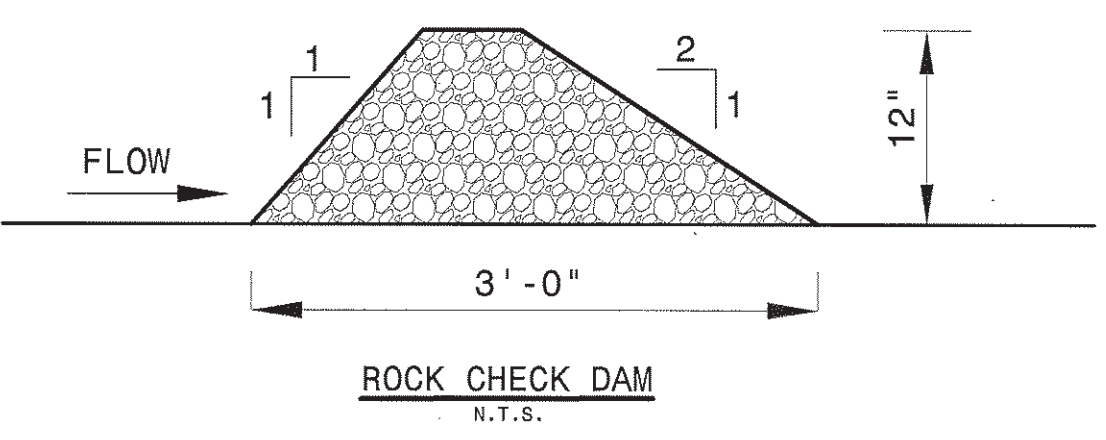


ROCK CHECK DAM  
N.T.S.

**ROCK CHECK DAM GENERAL NOTES:**

1. STONE SHALL BE WELL GRADED WITH SIZE RANGE FROM 1-1/2" TO 3-1/2" INCHES IN DIAMETER DEPENDING ON EXPECTED FLOWS.
2. THE CHECK DAM SHALL BE INSPECTED AS SPECIFIED IN THE SWPPP AND SHALL BE REPLACED WHEN THE STRUCTURE CEASES TO FUNCTION AS INTENDED DUE TO SILT ACCUMULATION AMONG THE ROCKS, WASHOUT, CONSTRUCTION TRAFFIC DAMAGE, ETC.
3. WHEN SILT REACHES A DEPTH EQUAL TO ONE-THIRD OF THE HEIGHT OF THE CHECK DAM OR ONE FOOT, WHICHEVER IS LESS, THE SILT SHALL BE REMOVED AND DISPOSED OF PROPERLY.
4. WHEN THE SITE HAS ACHIEVED FINAL STABILIZATION OR ANOTHER EROSION OR SEDIMENT CONTROL DEVICE IS EMPLOYED, THE CHECK DAM AND ACCUMULATED SILT SHALL BE REMOVED AND DISPOSED OF IN AN APPROVED MANNER.


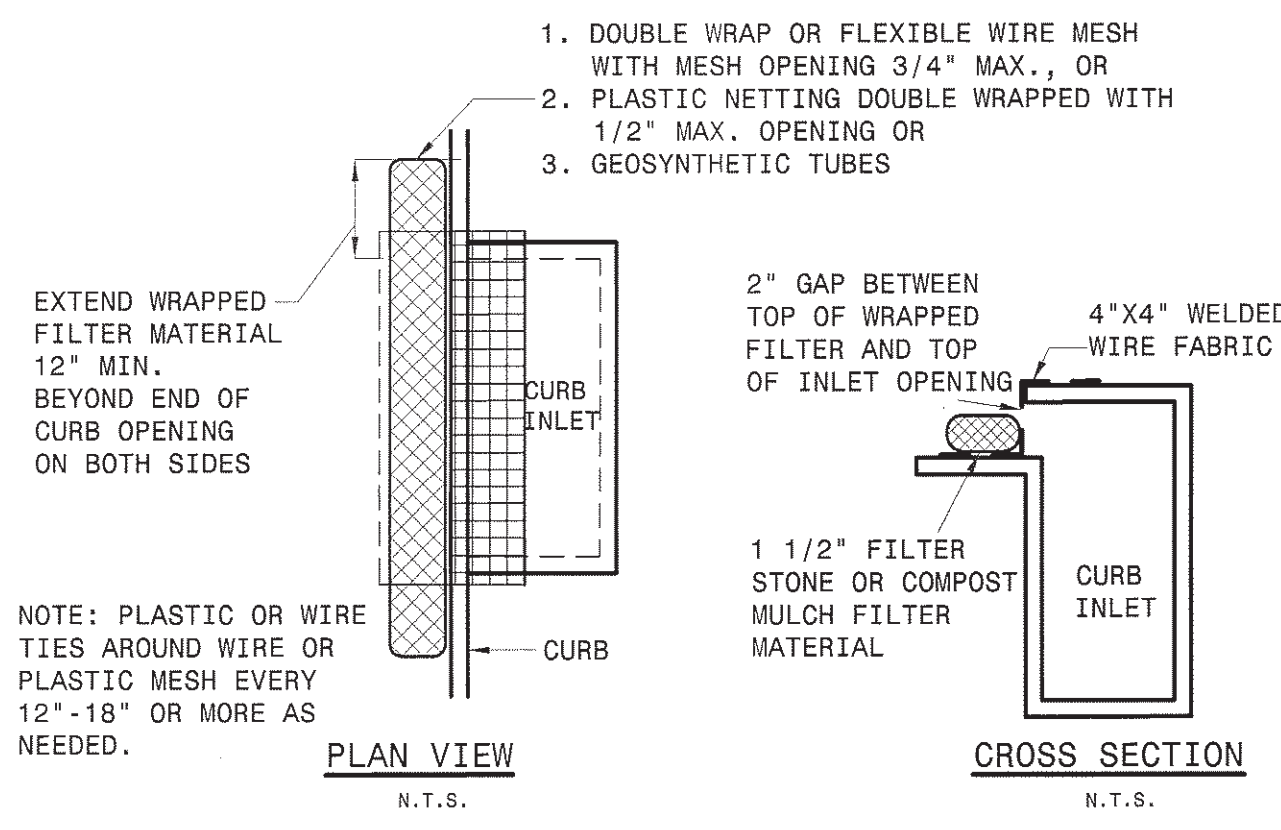


INLET PROTECTION  
N.T.S.

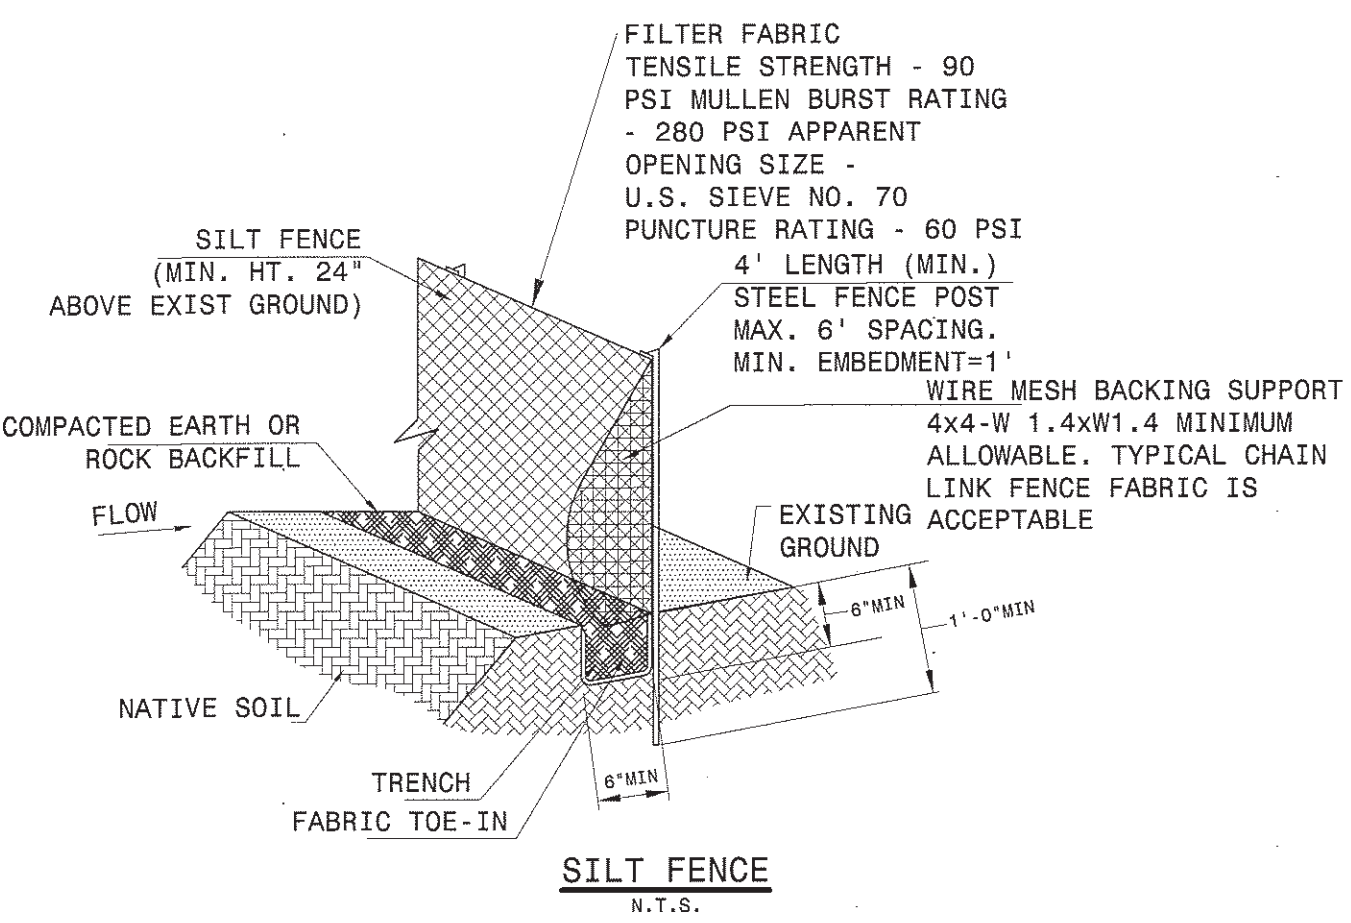

SILT FENCE  
N.T.S.



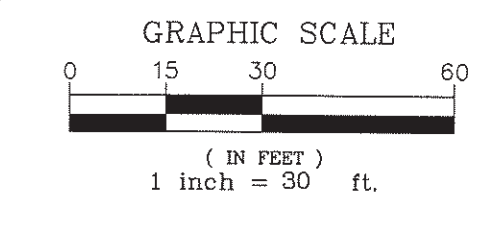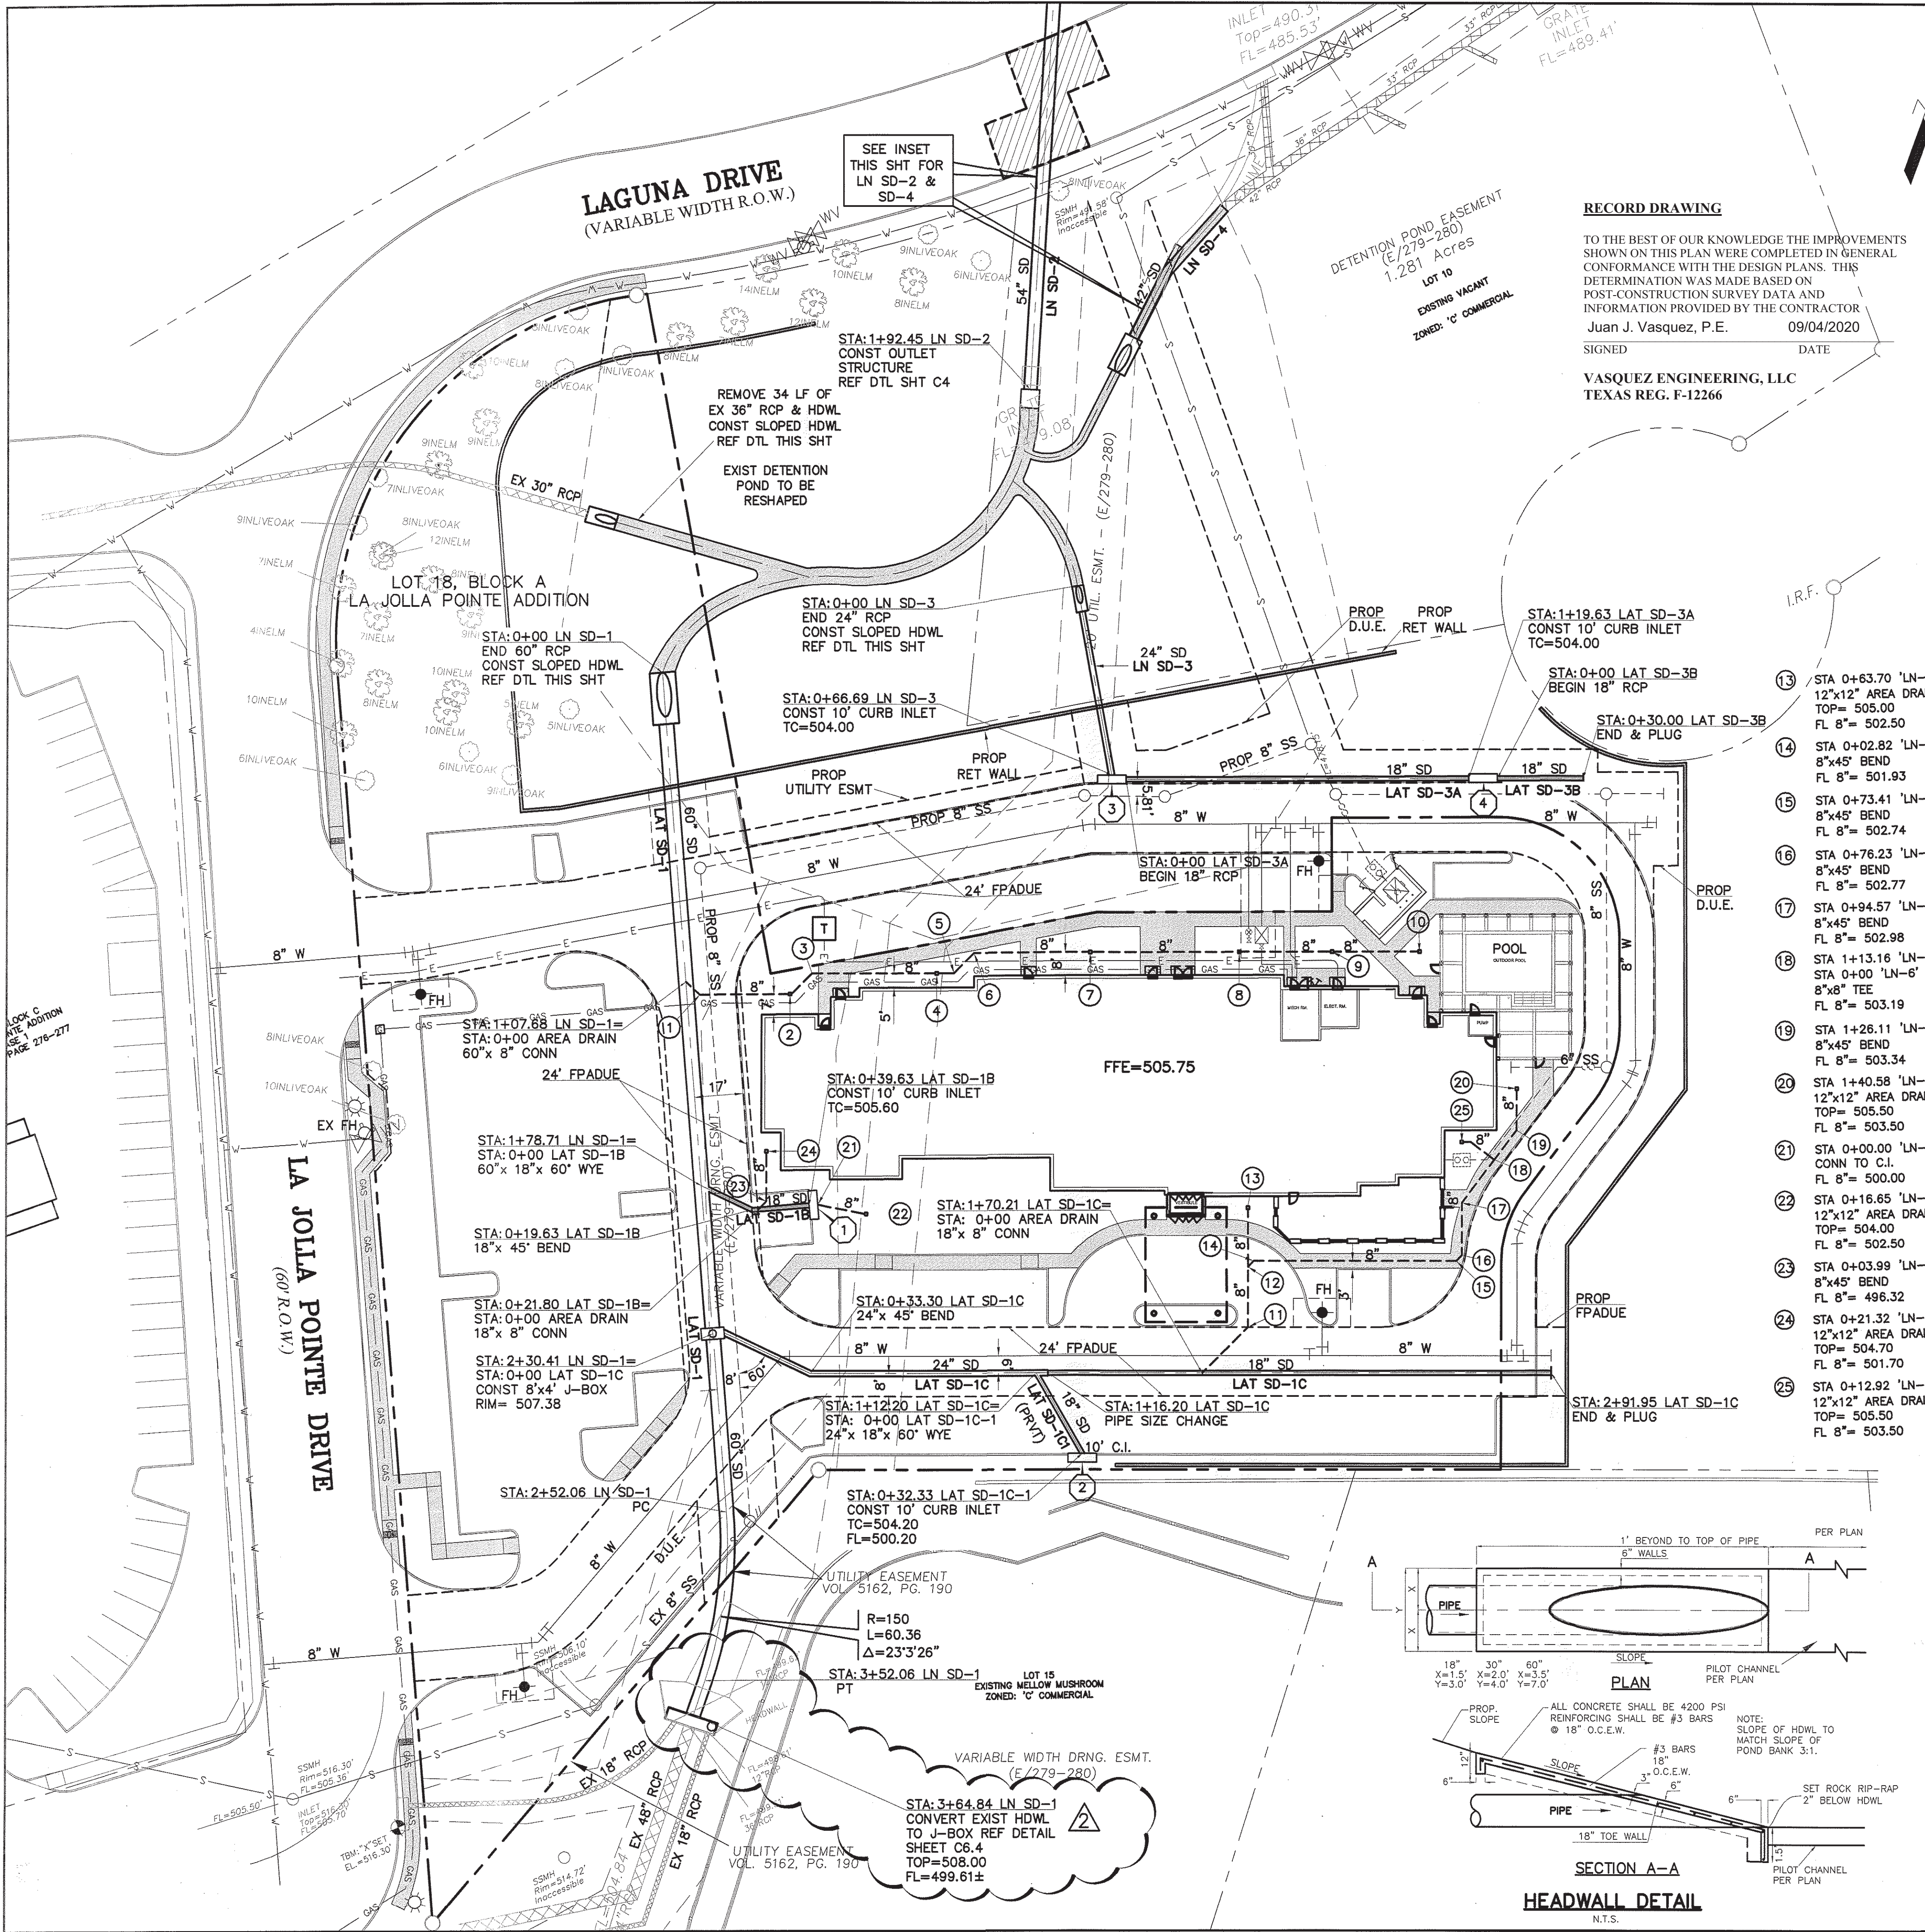

EXISTING	LEGEND	PROPOSED
---	PROPERTY LINE	---
---	PAVEMENT	---
W	WATER LINE	---
S	WASTE WATER	---
---	UNDERGROUND ELEC	---
OHU	OVERHEAD ELEC	---
G	GAS LINE	---
---	STORM SEWER	---
	INLET #	①


**STORM SEWER NOTE SCHEDULE:**

- ① STA 0+06.62 'LN-1' 8"x45" BEND FL 8"= 483.72
- ② STA 0+38.11 'LN-1' 12"x12" AREA DRAIN TOP= 505.00 FL 8"= 498.99
- ③ STA 0+48.75 'LN-1' 8"x45" BEND FL 8"= 499.20
- ④ STA 0+92.33 'LN-1' 12"x12" AREA DRAIN TOP= 505.00 FL 8"= 500.07
- ⑤ STA 0+98.33 'LN-1' 8"x45" BEND FL 8"= 500.19
- ⑥ STA 1+08.23 'LN-1' 8"x45" BEND FL 8"= 500.39
- ⑦ STA 1+48.92 'LN-1' 12"x12" AREA DRAIN TOP= 505.00 FL 8"= 501.20
- ⑧ STA 2+00.97 'LN-1' 12"x12" AREA DRAIN TOP= 505.00 FL 8"= 502.24
- ⑨ STA 2+33.35 'LN-1' 12"x12" AREA DRAIN TOP= 505.00 FL 8"= 502.89
- ⑩ STA 2+63.85 'LN-1' 12"x12" AREA DRAIN TOP= 505.00 FL 8"= 503.50
- ⑪ STA 0+22.57 'LN-2' 8"x45" BEND FL 8"= 501.26
- ⑫ STA 0+43.59 'LN-2' STA 0+00.00 'LN-3' 8"x45" WYE FL 8"= 501.90
- ⑬ STA 0+63.70 'LN-2' 12"x12" AREA DRAIN TOP= 505.00 FL 8"= 502.50
- ⑭ STA 0+02.82 'LN-3' 8"x45" BEND FL 8"= 501.93
- ⑮ STA 0+73.41 'LN-3' 8"x45" BEND FL 8"= 502.74
- ⑯ STA 0+76.23 'LN-3' 8"x45" BEND FL 8"= 502.77
- ⑰ STA 0+94.57 'LN-3' 8"x45" BEND FL 8"= 502.98
- ⑱ STA 1+13.16 'LN-3' STA 0+00 'LN-6' 8"x8" TEE FL 8"= 503.19
- ⑲ STA 1+26.11 'LN-3' 8"x45" BEND FL 8"= 503.34
- ⑳ STA 1+40.56 'LN-3' 12"x12" AREA DRAIN TOP= 505.50 FL 8"= 503.50
- ㉑ STA 0+00.00 'LN-4' CONN TO C.I. FL 8"= 500.00
- ㉒ STA 0+16.65 'LN-4' 12"x12" AREA DRAIN TOP= 504.00 FL 8"= 502.50
- ㉓ STA 0+03.99 'LN-5' 8"x45" BEND FL 8"= 496.32
- ㉔ STA 0+21.32 'LN-5' 12"x12" AREA DRAIN TOP= 504.70 FL 8"= 501.70
- ㉕ STA 0+12.92 'LN-6' 12"x12" AREA DRAIN TOP= 505.50 FL 8"= 503.50

BENCHMARK - TBM1	
ELEV.	516.30
MON.	CUT X IN CONC
LOC.	CUT X IN TOP OF INLET NEAR S.W. PROP CORNER OF LOT 18, BLOCK A OF LA JOLLA POINTE ADDITION


- NOTES:**
1. TOPOGRAPHIC SURVEY PROVIDED BY SELLER.
  2. SEE SHEET C6.1 - C6.3 FOR GRADING PLAN.
  3. SEE SHEETS C6.2 - C6.3 FOR STORM SEWER PROFILES.
  4. SEE SHEET C7.1 FOR OTHER SITE UTILITIES.

- STORM SEWER NOTES:**
1. ALL CONSTRUCTION SHALL BE PER THE CITY'S AND NCTCOG (4TH EDITION) REQUIREMENTS.
  2. ALL STORM SEWER SHALL 18" AND GREATER SHALL BE CL III RCP. STORM SEWER LESS THAN 18" SHALL PVC/HDPE UNLESS OTHERWISE NOTED ON THE PLANS.
  4. ALL TRENCHING SHALL BE IN ACCORDANCE WITH THE LATEST OSHA STANDARDS AND SPECIFICATIONS.
  5. ALL CONCRETE PIPE JOINTS SHALL BE SEALED WITH RAMMEKOR OR EQUIVALENT.
  6. CONTRACTOR SHALL VERIFY LOCATIONS AND ELEVATIONS PRIOR TO CONNECTING TO EXISTING STRUCTURES.
  7. GROUT ALL PIPE CONNECTIONS AT STRUCTURES TO PROVIDE A WATER TIGHT SEAL.
  8. ADJUST ALL UTILITY APPURTENANCES TO FINAL GRADE.
  9. ALL PRIVATE STORM SEWER TO BE MAINTAINED AND REPAIRED BY THE OWNER.

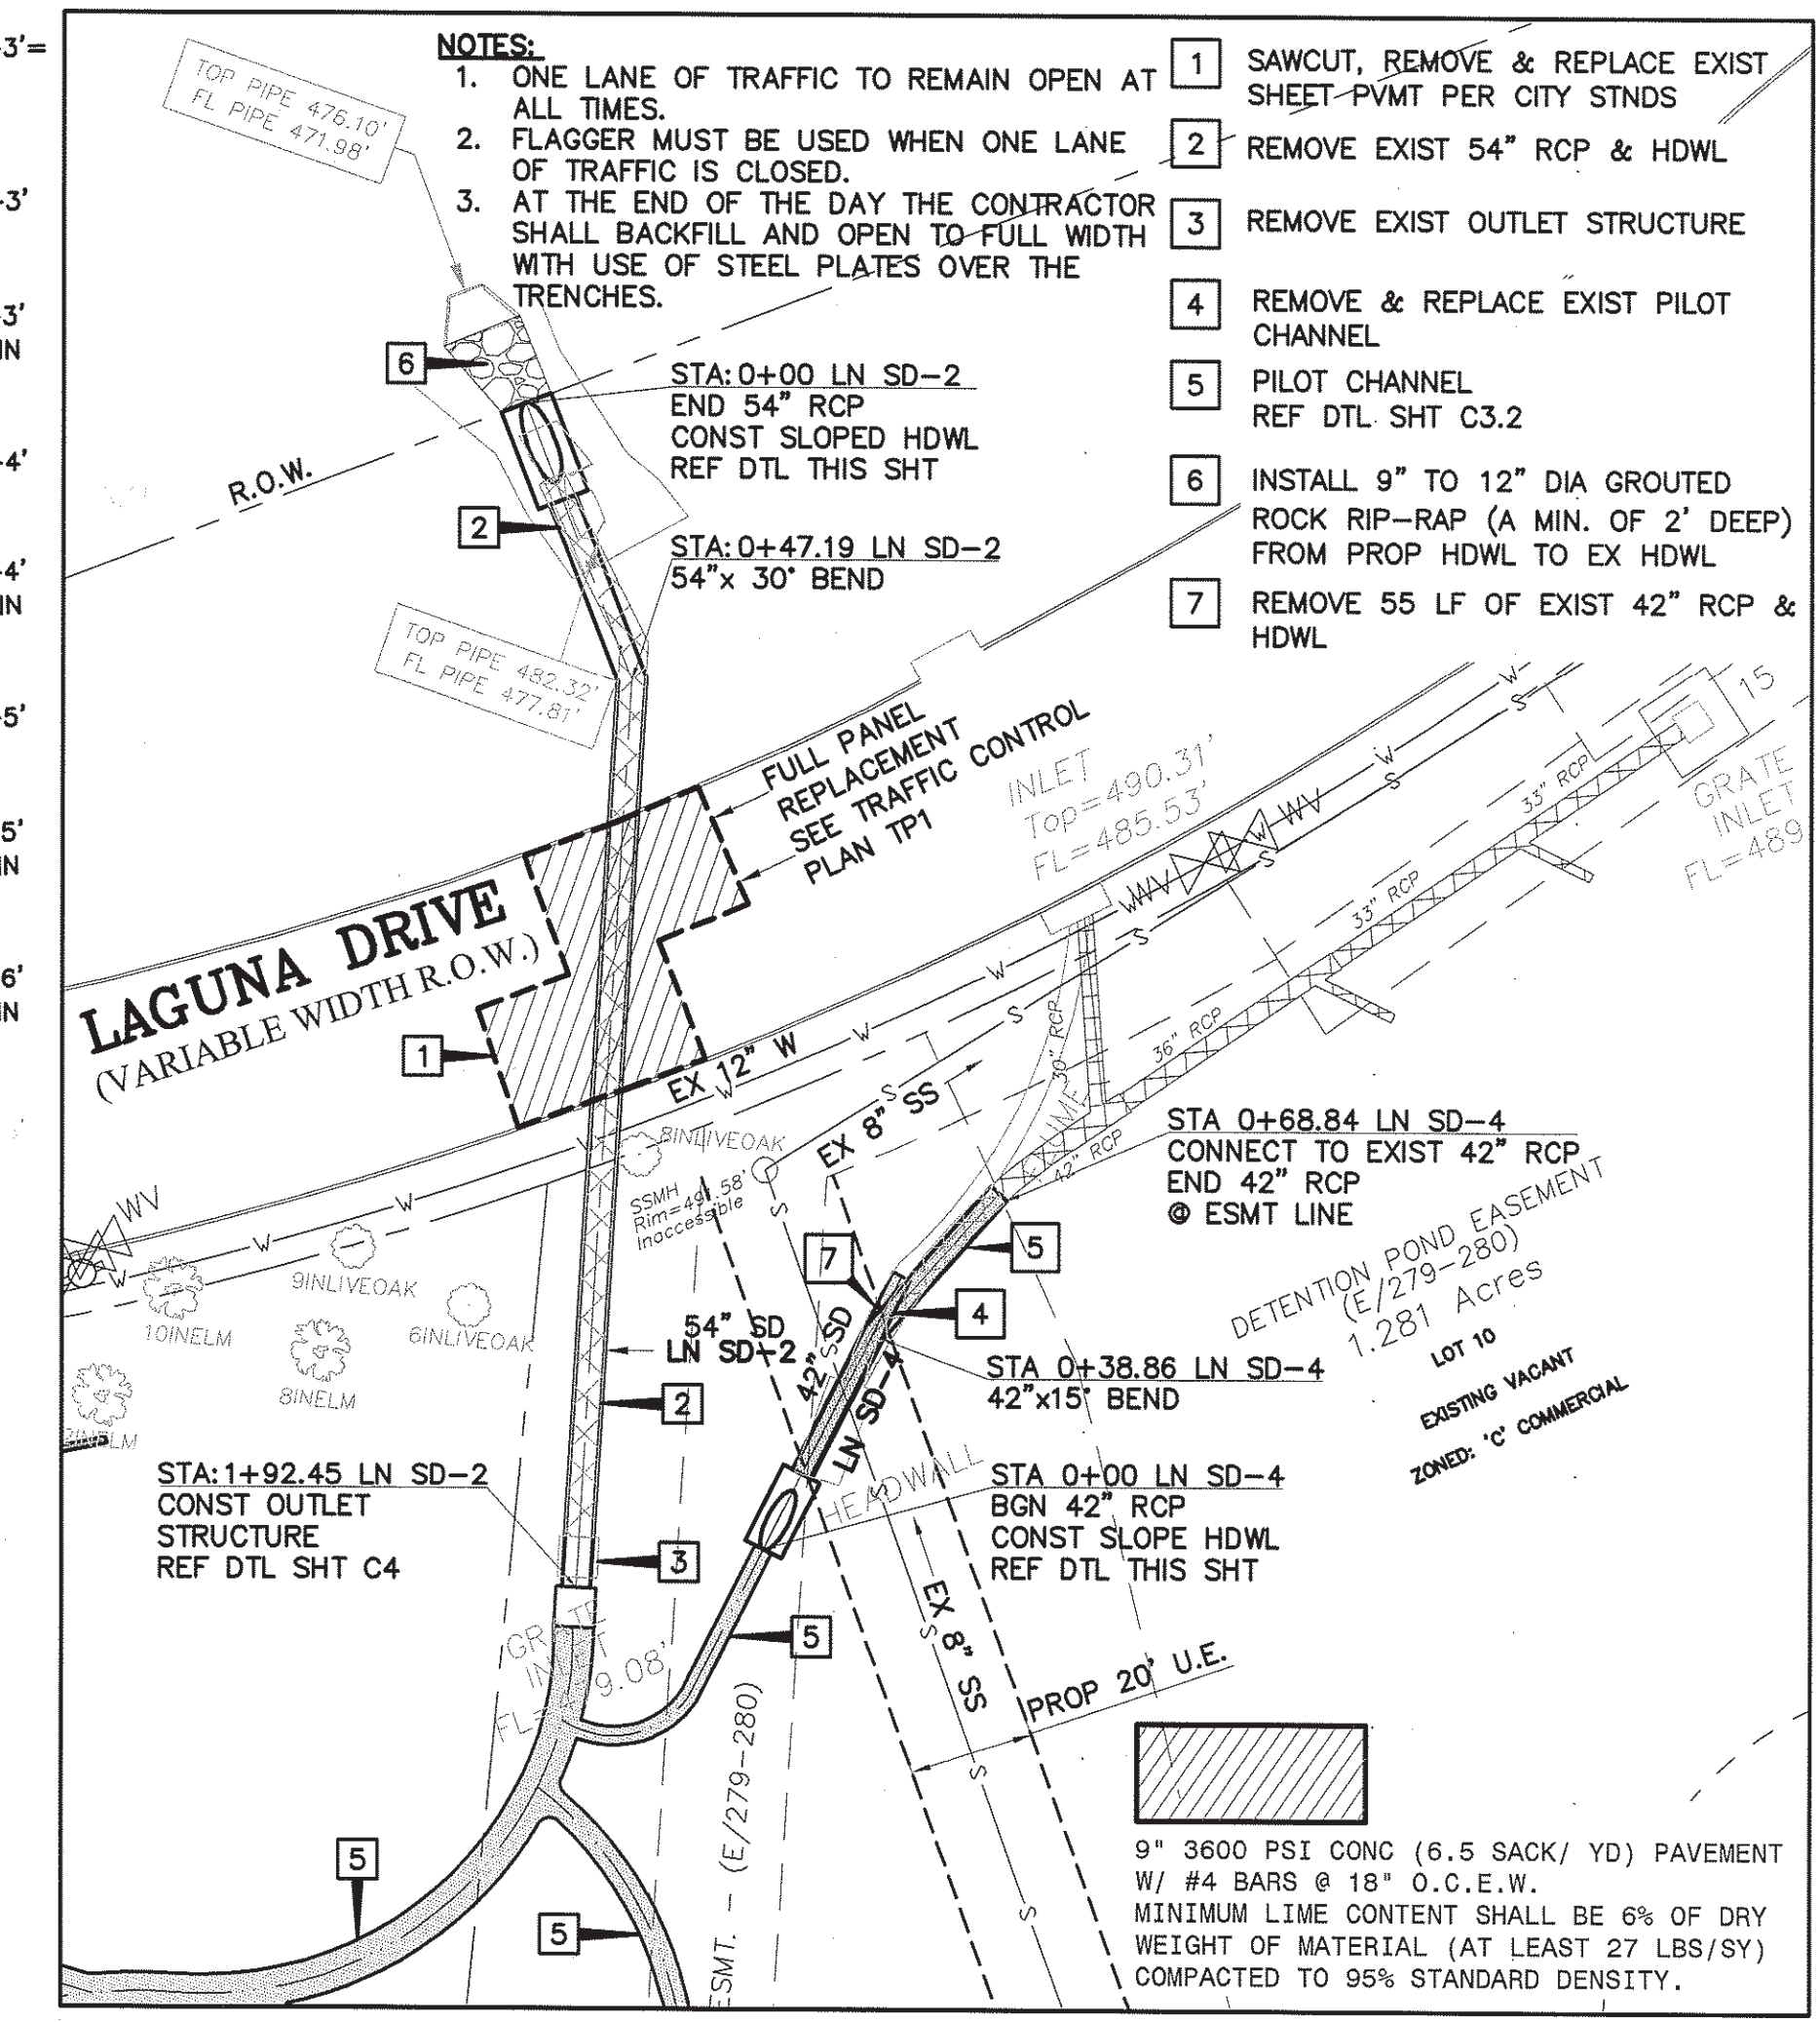

- NOTES:**
1. ONE LANE OF TRAFFIC TO REMAIN OPEN AT ALL TIMES.
  2. FLAGGER MUST BE USED WHEN ONE LANE OF TRAFFIC IS CLOSED.
  3. AT THE END OF THE DAY THE CONTRACTOR SHALL BACKFILL AND OPEN TO-FULL WIDTH WITH USE OF STEEL PLATES OVER THE TRENCHES.

- 1 SAWCUT, REMOVE & REPLACE EXIST SHEET-PVMT PER CITY STNDS
- 2 REMOVE EXIST 54" RCP & HDWL
- 3 REMOVE EXIST OUTLET STRUCTURE
- 4 REMOVE & REPLACE EXIST PILOT CHANNEL
- 5 PILOT CHANNEL REF DTL SHT C3.2
- 6 INSTALL 9" TO 12" DIA GROUTED ROCK RIP-RAP (A MIN. OF 2' DEEP) FROM PROP HDWL TO EX HDWL
- 7 REMOVE 55 LF OF EXIST 42" RCP & HDWL

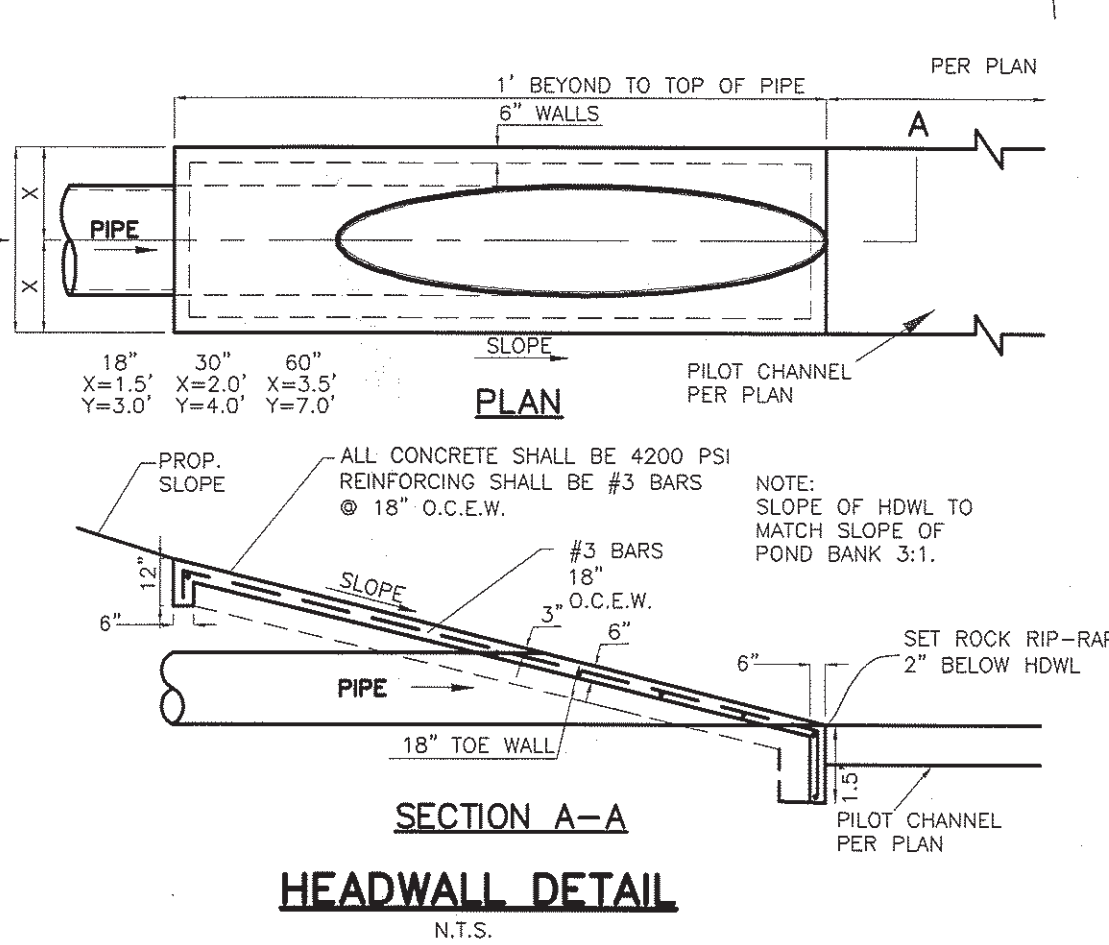

**RECORD DRAWING**


TO THE BEST OF OUR KNOWLEDGE THE IMPROVEMENTS SHOWN ON THIS PLAN WERE COMPLETED IN GENERAL CONFORMANCE WITH THE DESIGN PLANS. THIS DETERMINATION WAS MADE BASED ON POST-CONSTRUCTION SURVEY DATA AND INFORMATION PROVIDED BY THE CONTRACTOR Juan J. Vasquez, P.E. 09/04/2020

SIGNED \_\_\_\_\_ DATE \_\_\_\_\_

VASQUEZ ENGINEERING, LLC  
TEXAS REG. F-12266

JUV	NO.	DATE	APP.
01/23/19	CONVERT HEADWALL TO BOX		
01/04/19	CURB INLET REVISION		

**VASQUEZ ENGINEERING, L.L.C.**  
1919 S. Shiloh Road  
Suite 440, LB 44  
Garland, Texas 75042  
Ph: 972-278-2948  
TX Registration # F-12266

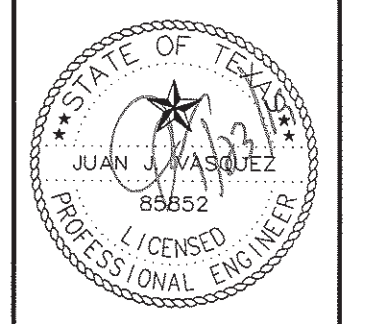


**DEVELOPER:**  
ROCKWALL INN KEEPERS I, LTD.  
6176 FM 2011  
LONGVIEW, TX 75603

**STORM SEWER PLAN**  
LOT 18, BLOCK A  
LA JOLLA POINTE ADDITION  
ROCKWALL, TEXAS

Scale: 1" = 30'  
Designed by: JUV  
Drawn by: JUV  
Checked by: JUV  
636-01049/C6.1 STORM SEWER PLAN.dwg  
Date: 12/19/2018

**SHEET**  
**C6.1**



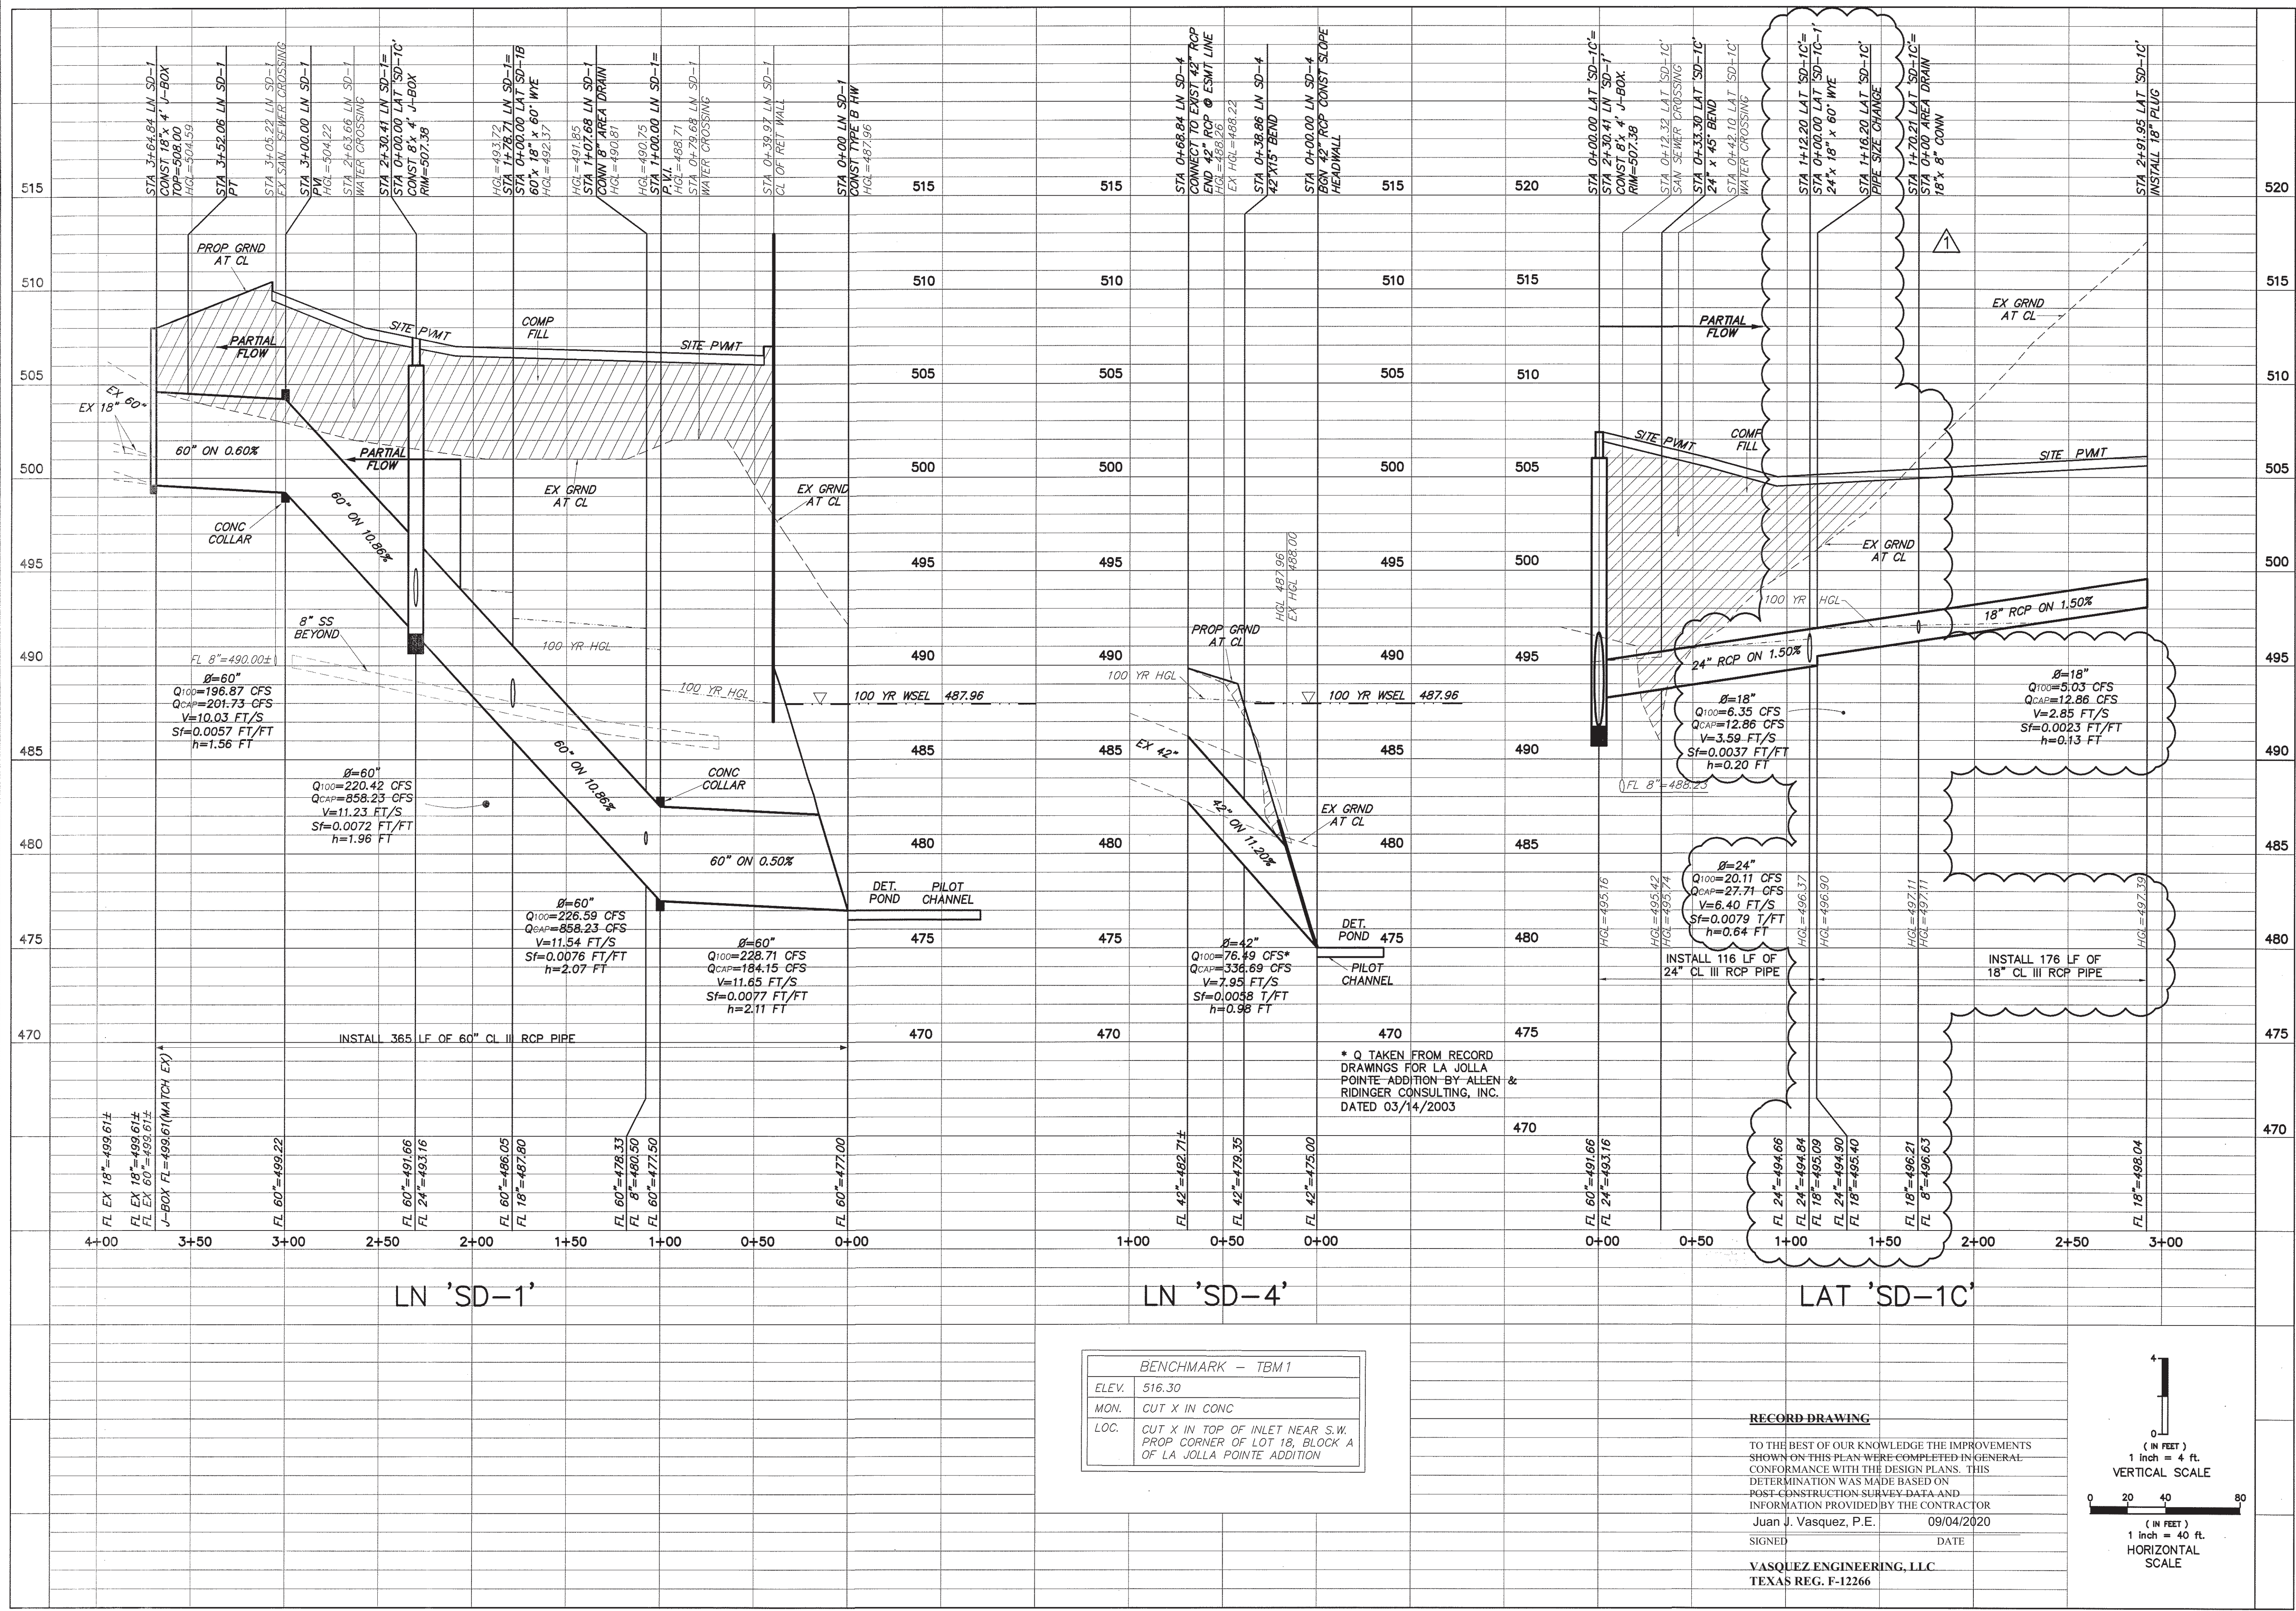

BENCHMARK - TBM 1

ELEV.	516.30
MON.	CUT X IN CONC
LOC.	CUT X IN TOP OF INLET NEAR S.W. PROP CORNER OF LOT 18, BLOCK A OF LA JOLLA POINTE ADDITION


**RECORD DRAWING**

TO THE BEST OF OUR KNOWLEDGE THE IMPROVEMENTS SHOWN ON THIS PLAN WERE COMPLETED IN GENERAL CONFORMANCE WITH THE DESIGN PLANS. THIS DETERMINATION WAS MADE BASED ON POST-CONSTRUCTION SURVEY DATA AND INFORMATION PROVIDED BY THE CONTRACTOR


Juan J. Vasquez, P.E. 09/04/2020

SIGNED \_\_\_\_\_ DATE \_\_\_\_\_

VASQUEZ ENGINEERING, LLC  
TEXAS REG. F-12266

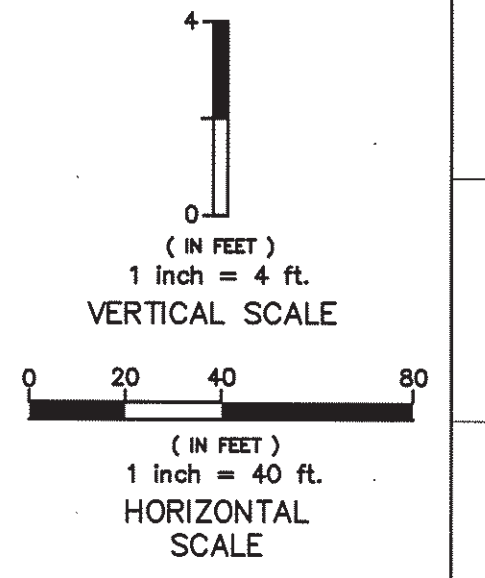

NO.	DATE	REVISION
1	01/04/19	CURB INLET

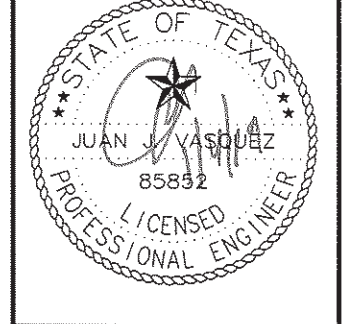

DEVELOPER:  
ROCKWALL INN KEEPERS I, LTD.  
6176 FM 2011  
LONGVIEW, TX 75603


STORM SEWER PROFILES  
LOT 18, BLOCK A  
LA JOLLA POINTE ADDITION  
ROCKWALL, TEXAS

Scale: AS NOTED  
Designed by: JVV  
Drawn by: JVV  
Checked by: JVV  
638-0119wpc6.2 STORM SEWER PROFILES.dwg  
Date: 12/19/2018

SHEET  
**C6.2**

VASQUEZ ENGINEERING, L.L.C.  
1919 S. Shiloh Road  
Suite 440, LB 44  
Garland, Texas 75042  
Ph: 972-278-2948  
TX Registration # F-12266



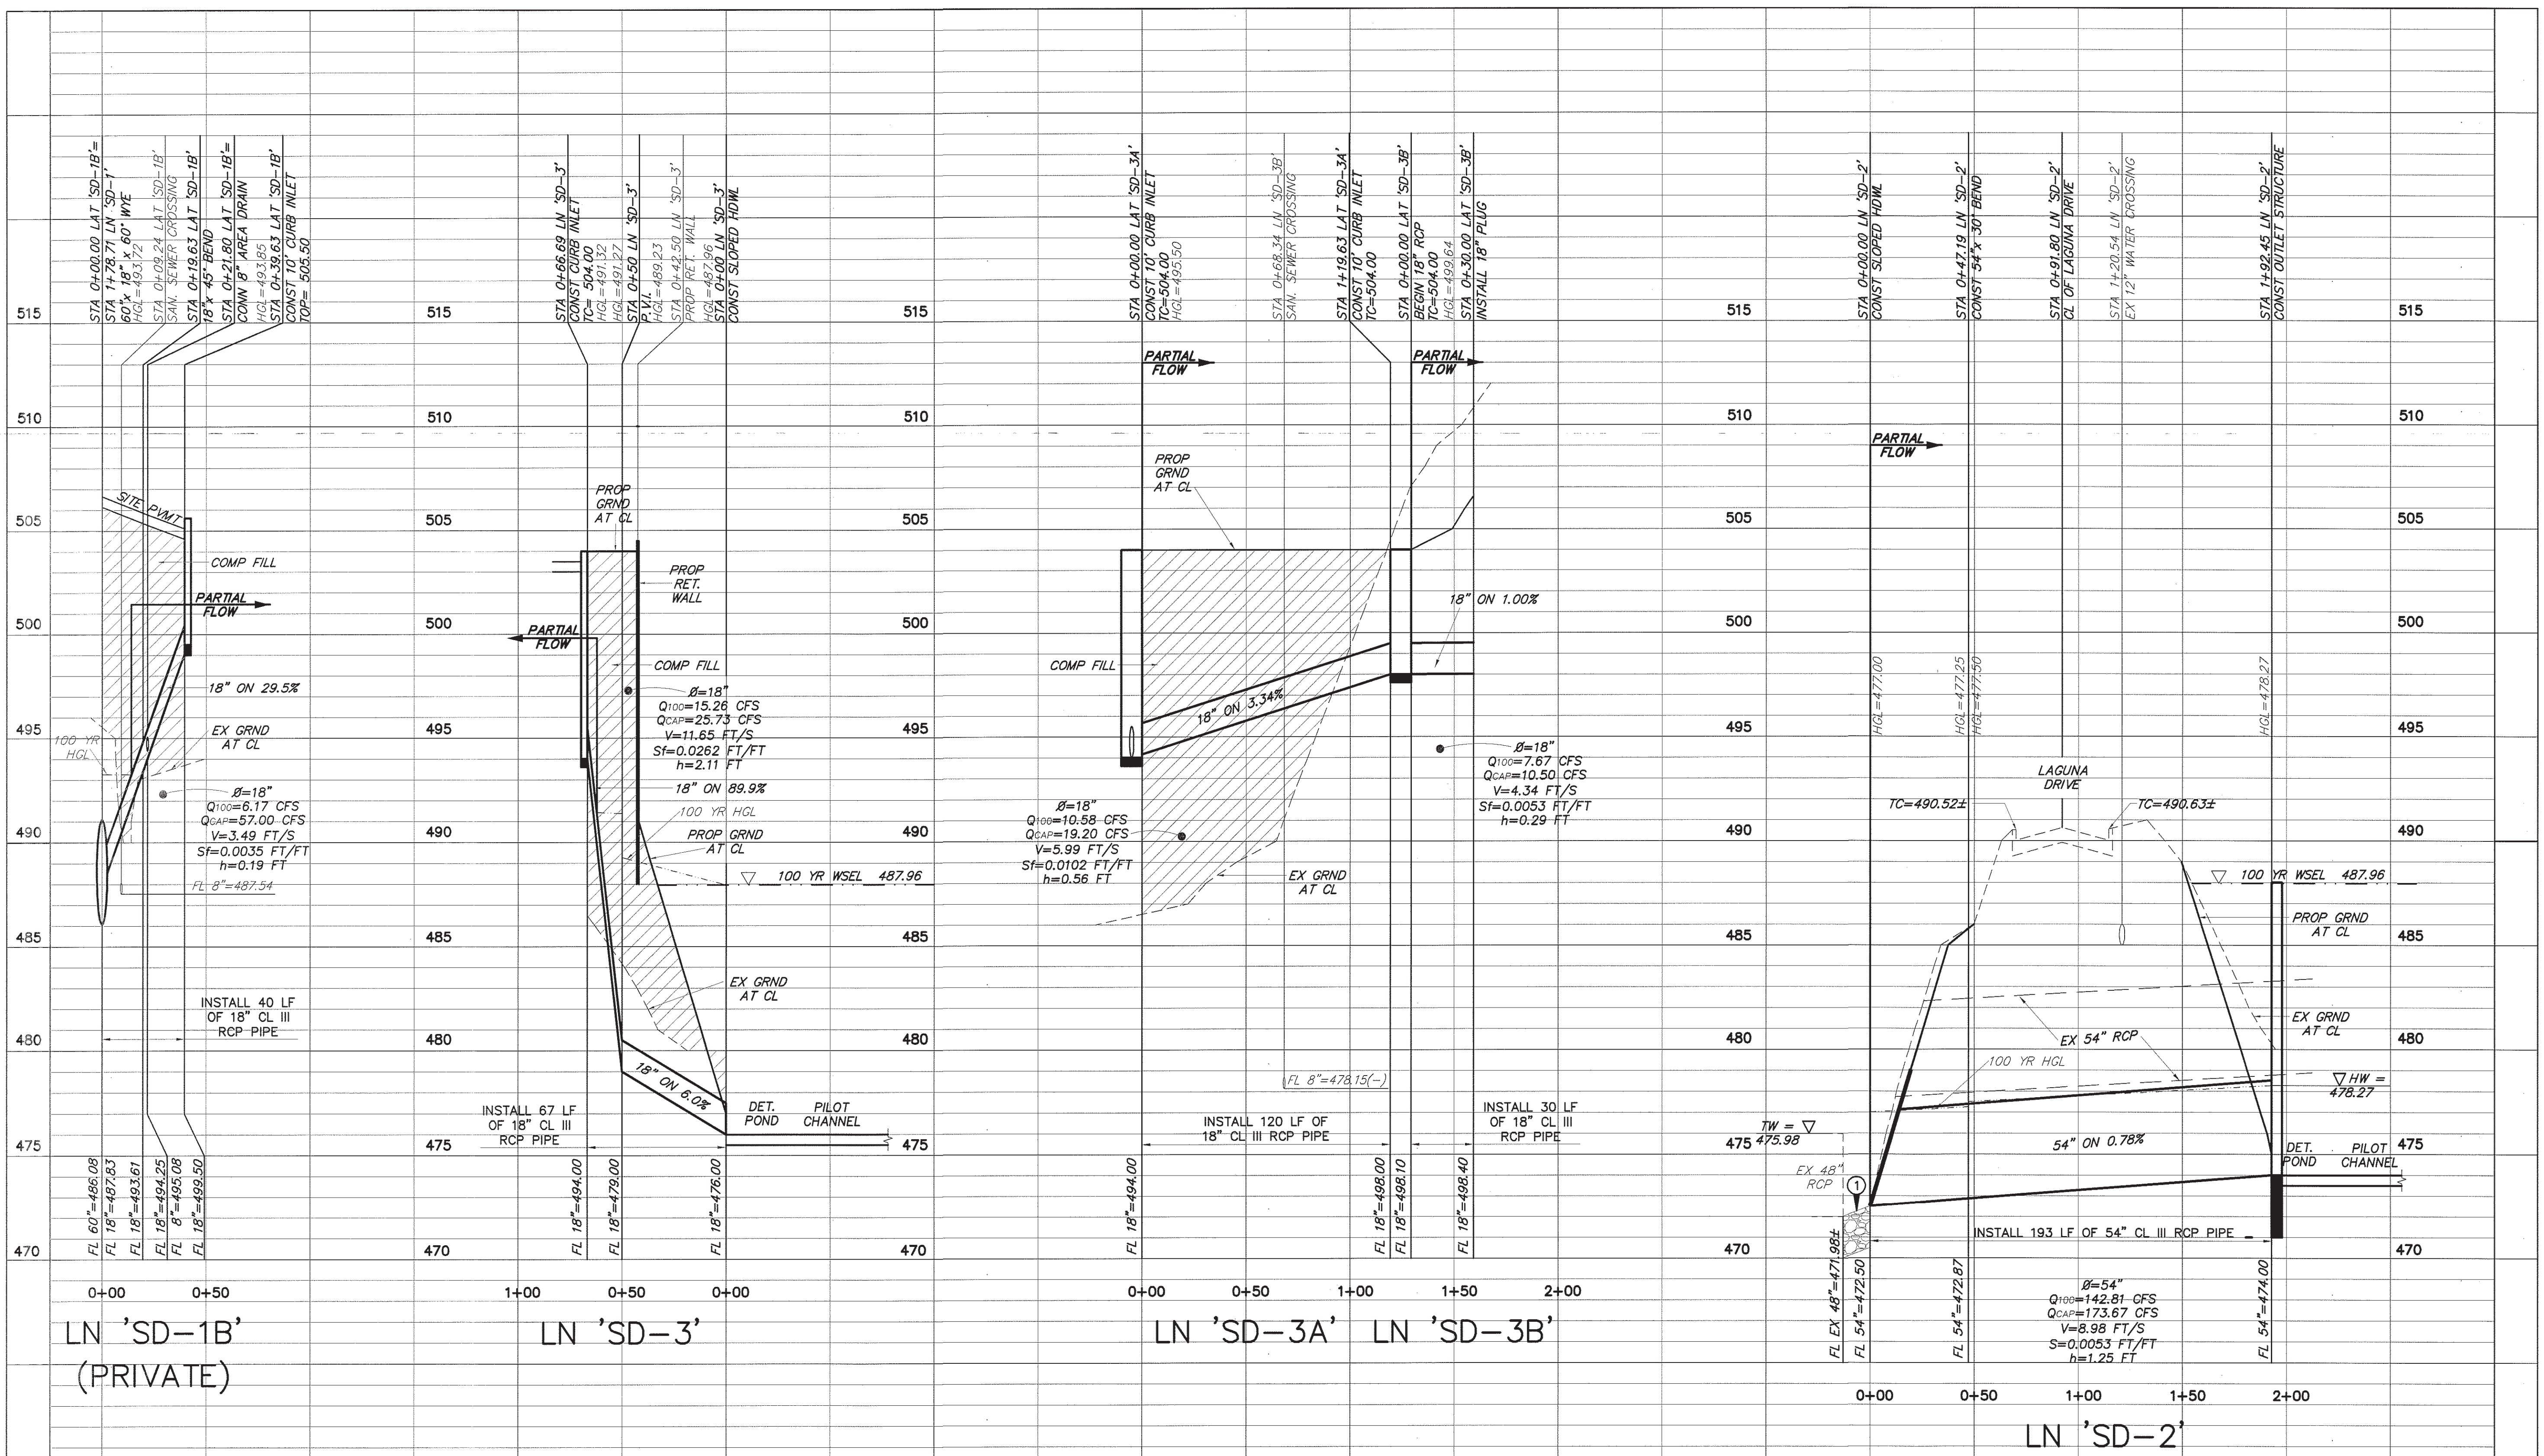


BENCHMARK - TBM1  
 ELEV. 516.30  
 MON. CUT X IN CONC  
 LOC. CUT X IN TOP OF INLET NEAR S.W. PROP CORNER OF LOT 18, BLOCK A OF LA JOLLA POINTE ADDITION

① INSTALL 9" TO 12" DIA GROUTED ROCK RIP RAP (A MIN. OF 2' DEEP) FROM PROP HDWL TO EXIST HDWL = 13 LF


**RECORD DRAWING**

TO THE BEST OF OUR KNOWLEDGE THE IMPROVEMENTS SHOWN ON THIS PLAN WERE COMPLETED IN GENERAL CONFORMANCE WITH THE DESIGN PLANS. THIS DETERMINATION WAS MADE BASED ON POST-CONSTRUCTION SURVEY DATA AND INFORMATION PROVIDED BY THE CONTRACTOR  
 Juan J. Vasquez, P.E. 09/04/2020  
 SIGNED DATE

VASQUEZ ENGINEERING, LLC  
 TEXAS REG. F-12266

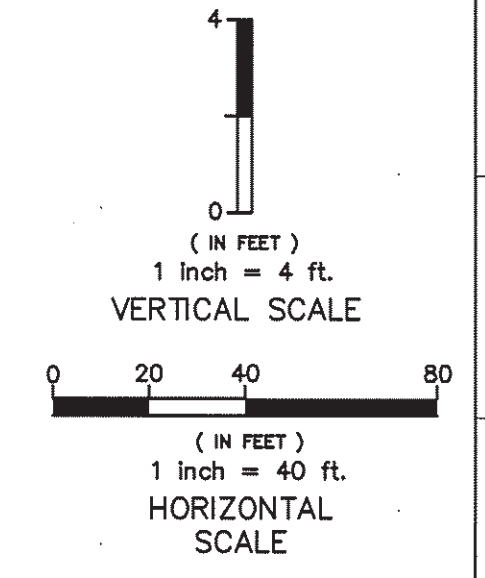

THE SEAL APPEARING ON THIS DOCUMENT WAS AUTHORIZED BY JUAN J. VASQUEZ, P.E. 65852, ON 10/11/2018

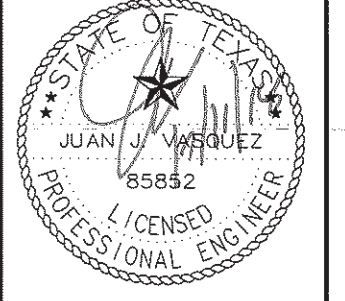

DEVELOPER:  
 ROCKWALL INN KEEPERS I, LTD.  
 6176 FM 2011  
 LONGVIEW, TX 75603


STORM SEWER PROFILES  
 LOT 18, BLOCK A  
 LA JOLLA POINTE ADDITION  
 ROCKWALL, TEXAS

Scale: 1" = 40 FT NOTED  
 Designed by: JJV  
 Drawn by: JJV  
 Checked by: JJV  
 638-01\wv\c6.3 STORM SEWER PROFILES.dwg  
 Date: 10/11/2018


SHEET  
**C6.3**

VASQUEZ ENGINEERING, L.L.C.  
 1919 S. Shiloh Road  
 Suite 440, LB 44  
 Garland, Texas 75042  
 Ph: 972-278-2948  
 TX Registration # F-12266




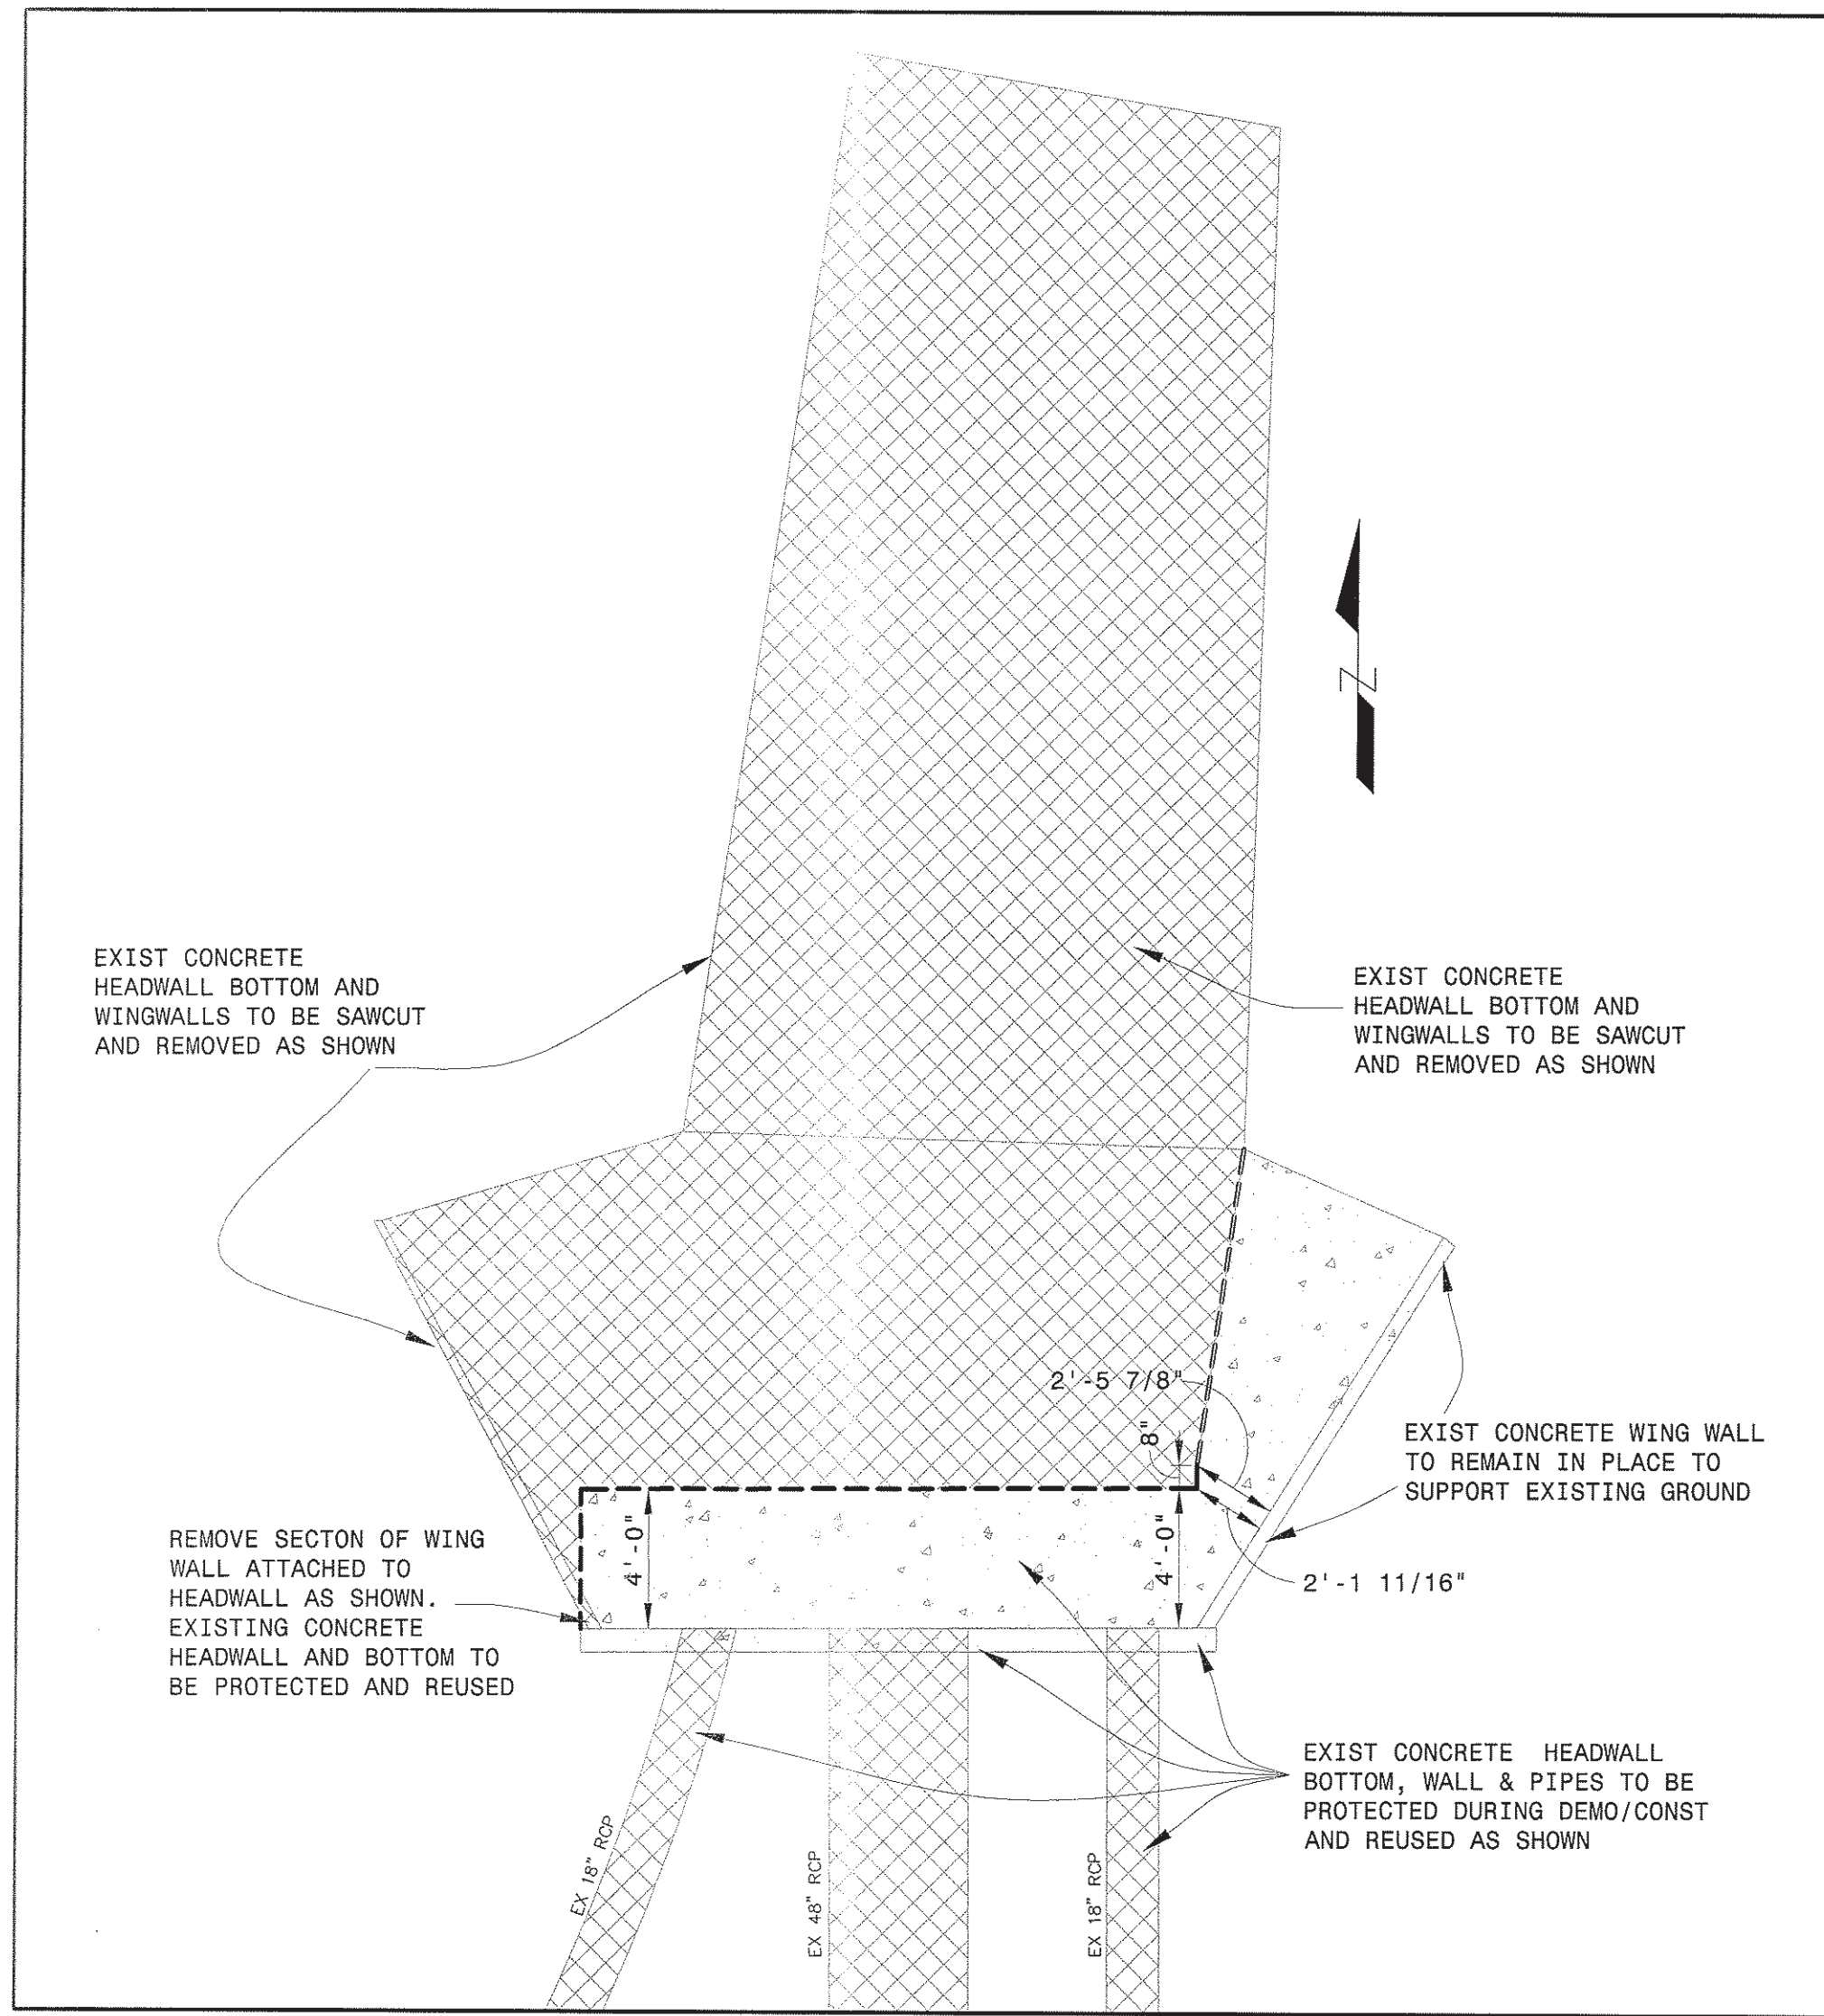


**EXIST HEADWALL DEMOLITION DETAIL**  
1" = 5'

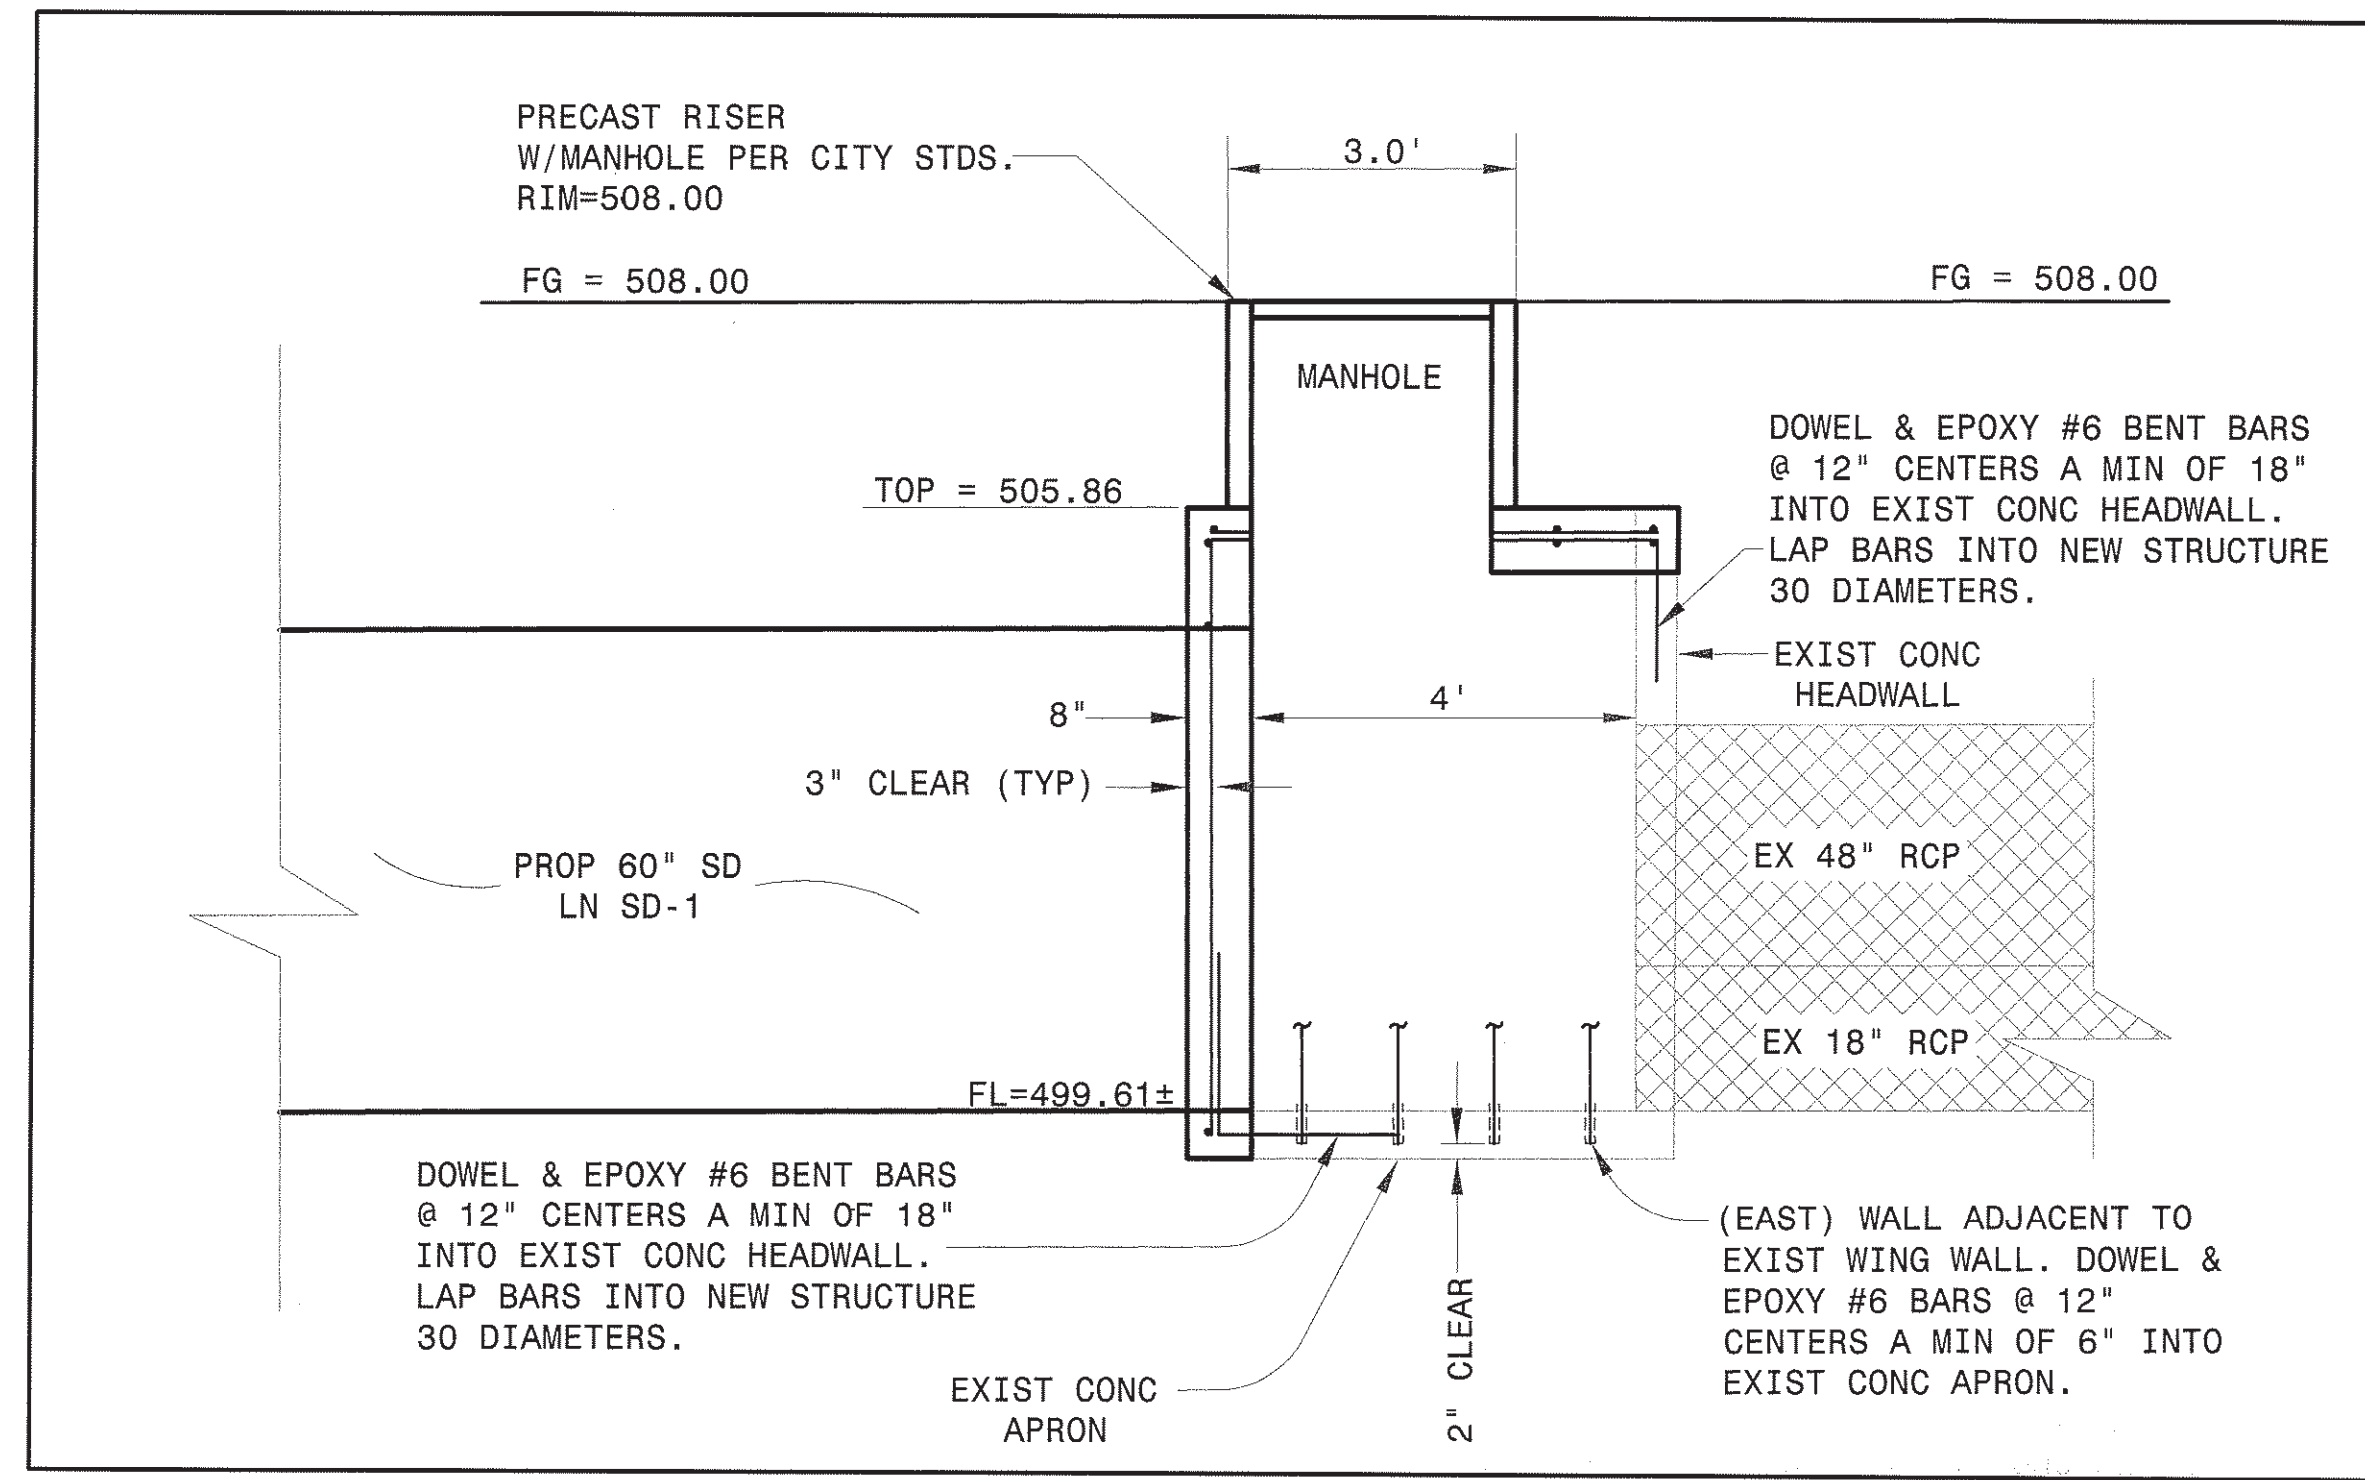


**SECTION B-B**  
1" = 2'

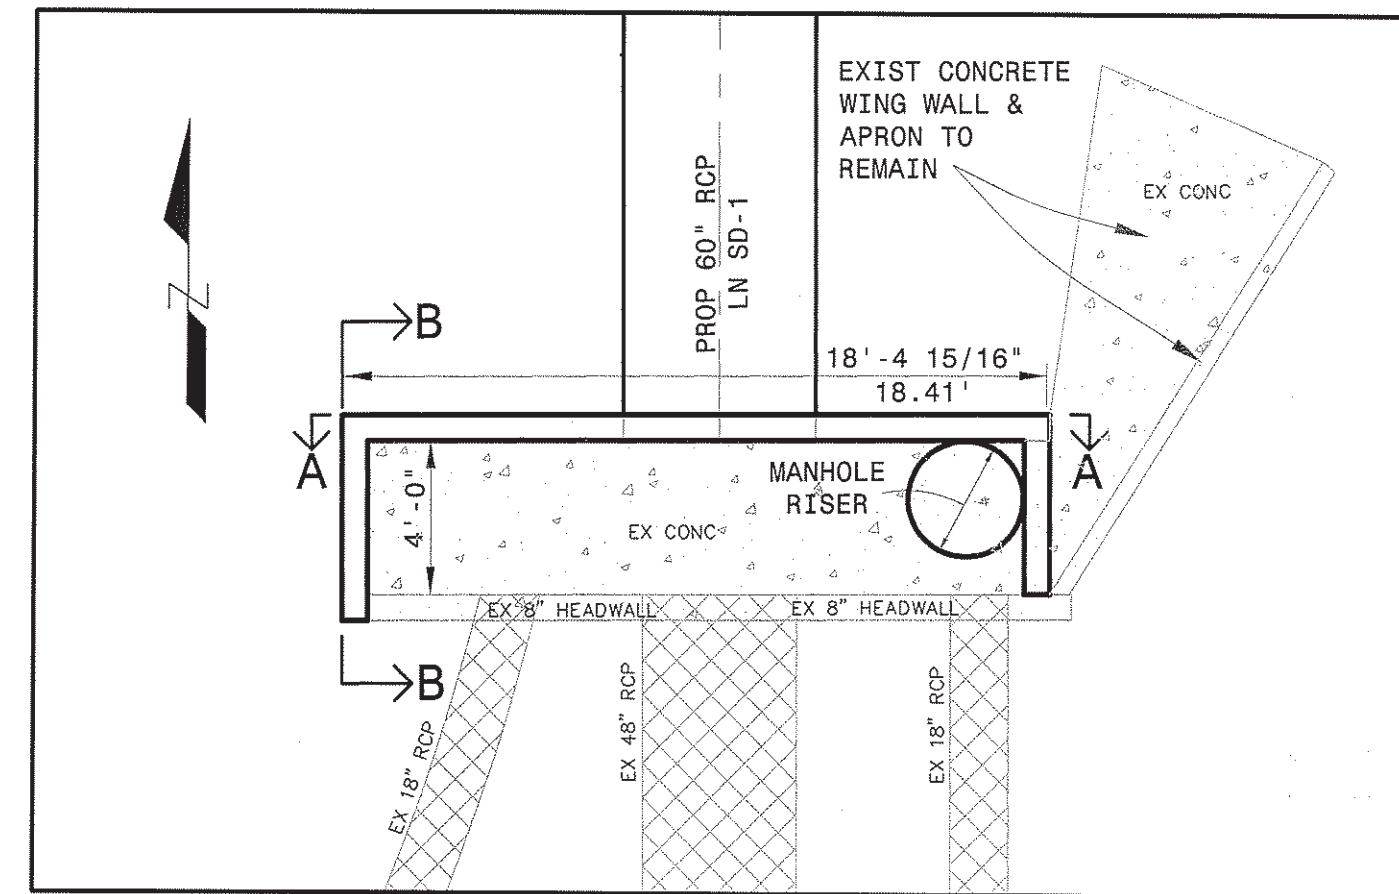


**PLAN VIEW**  
1" = 5'

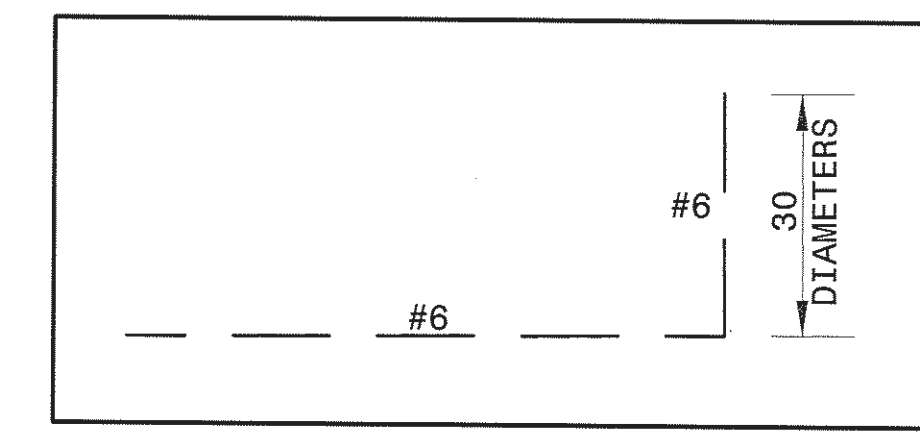

**LAP BAR DETAIL**  
N.T.S.

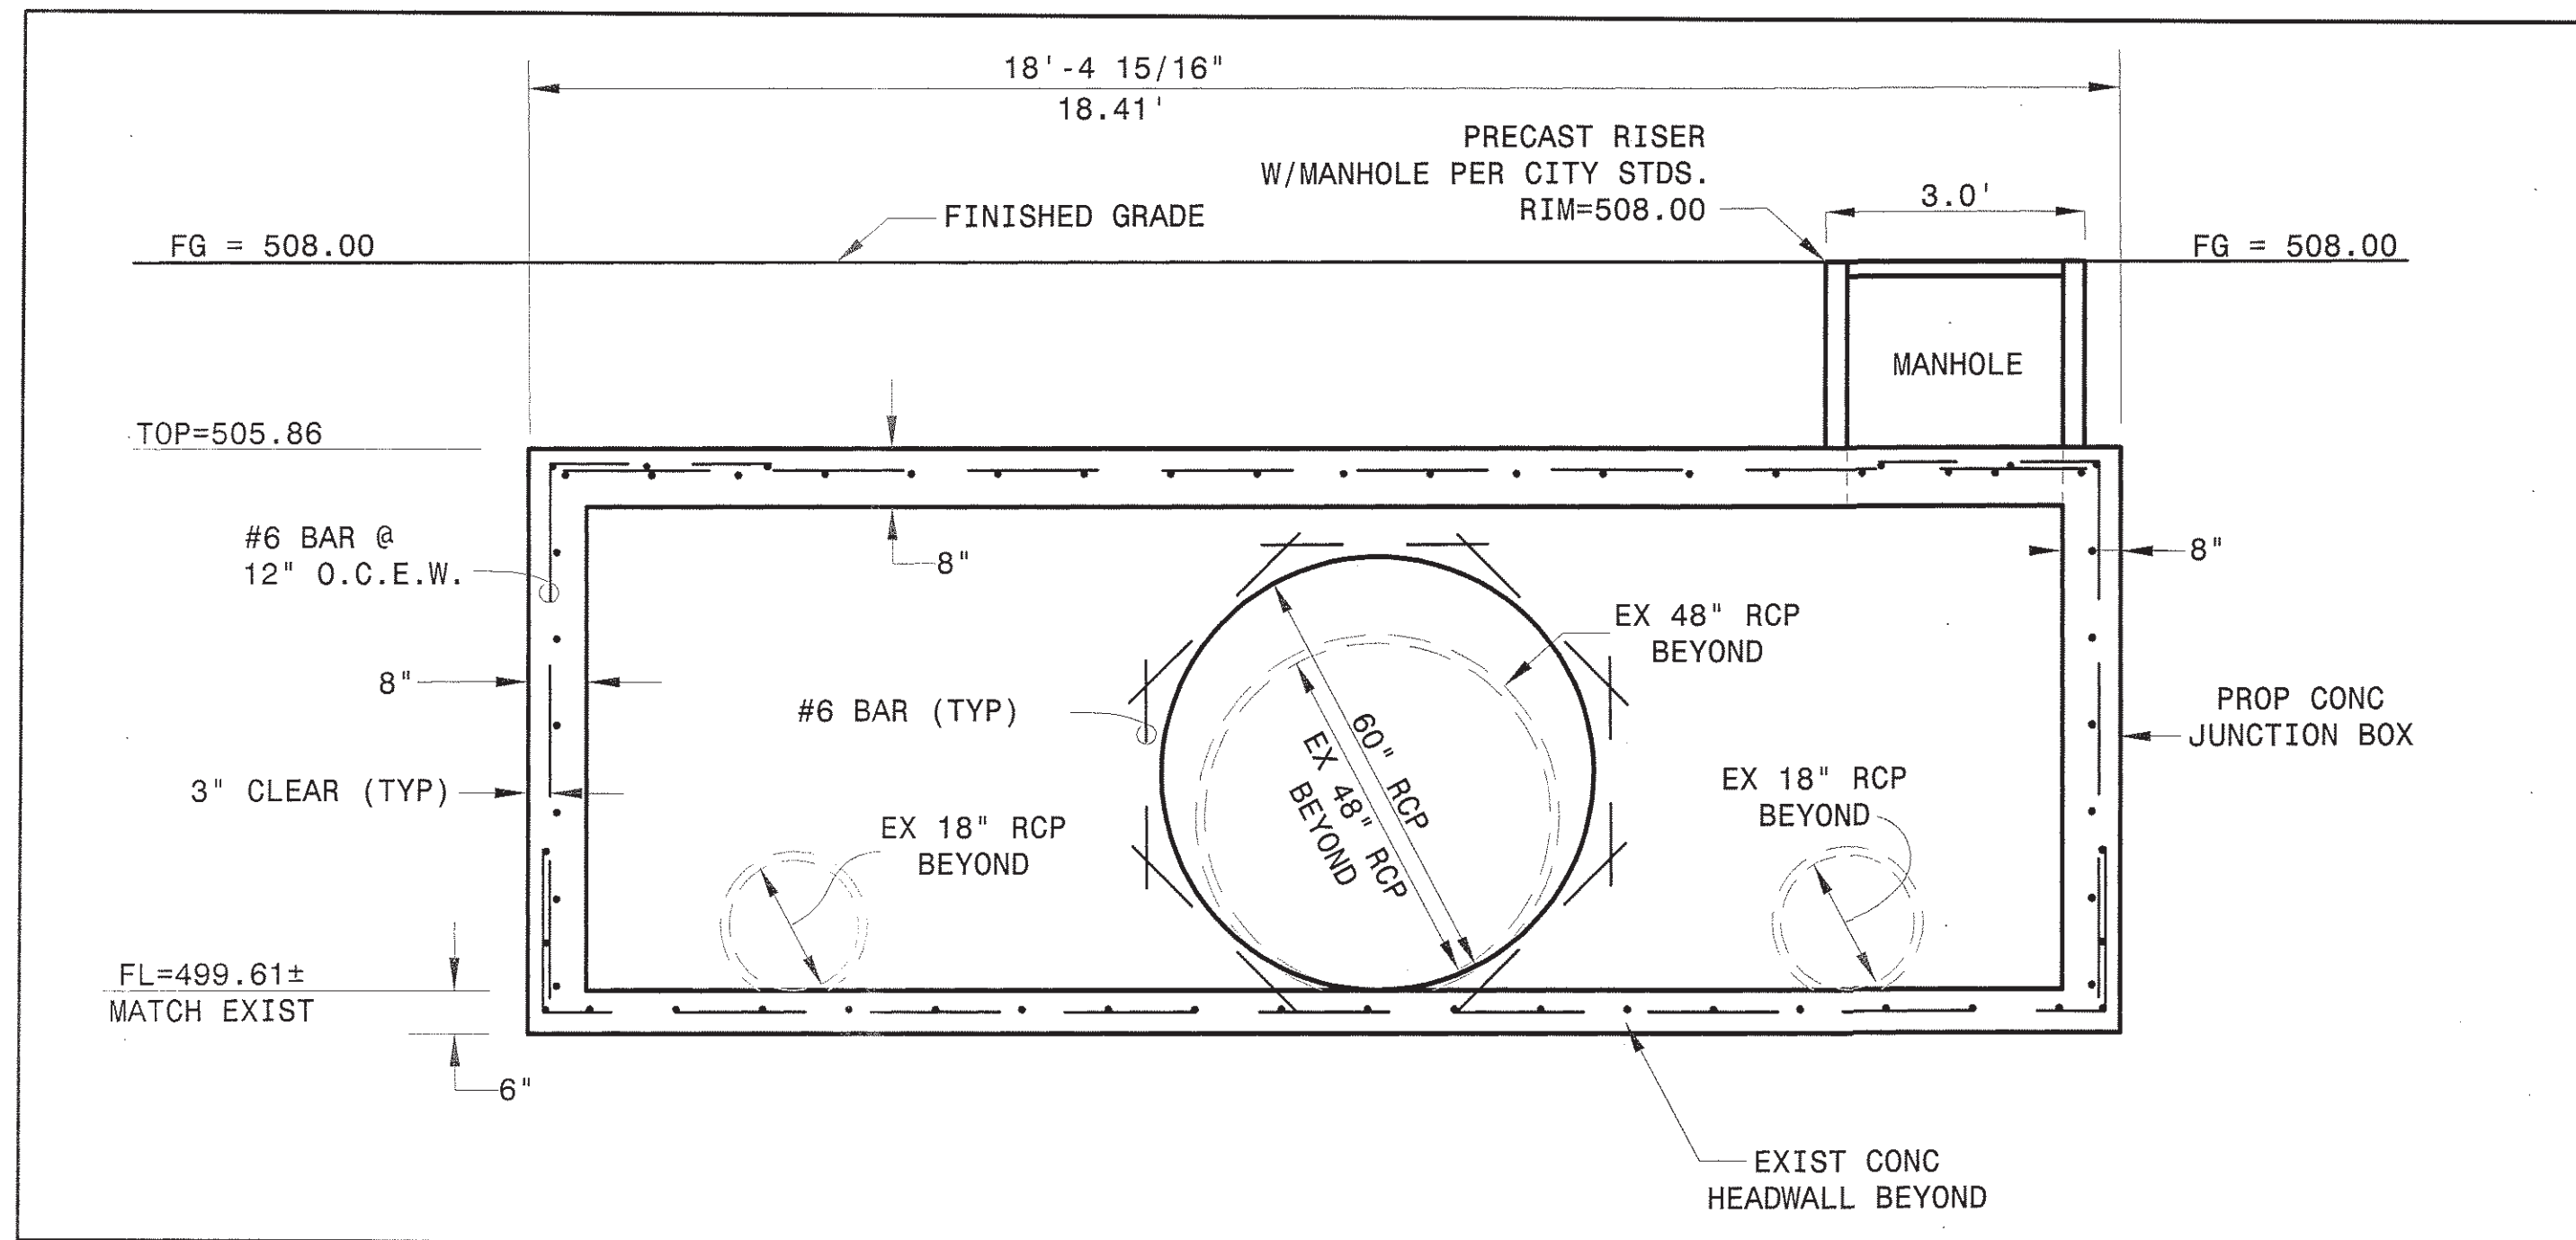

**SECTION A-A**  
1" = 2'

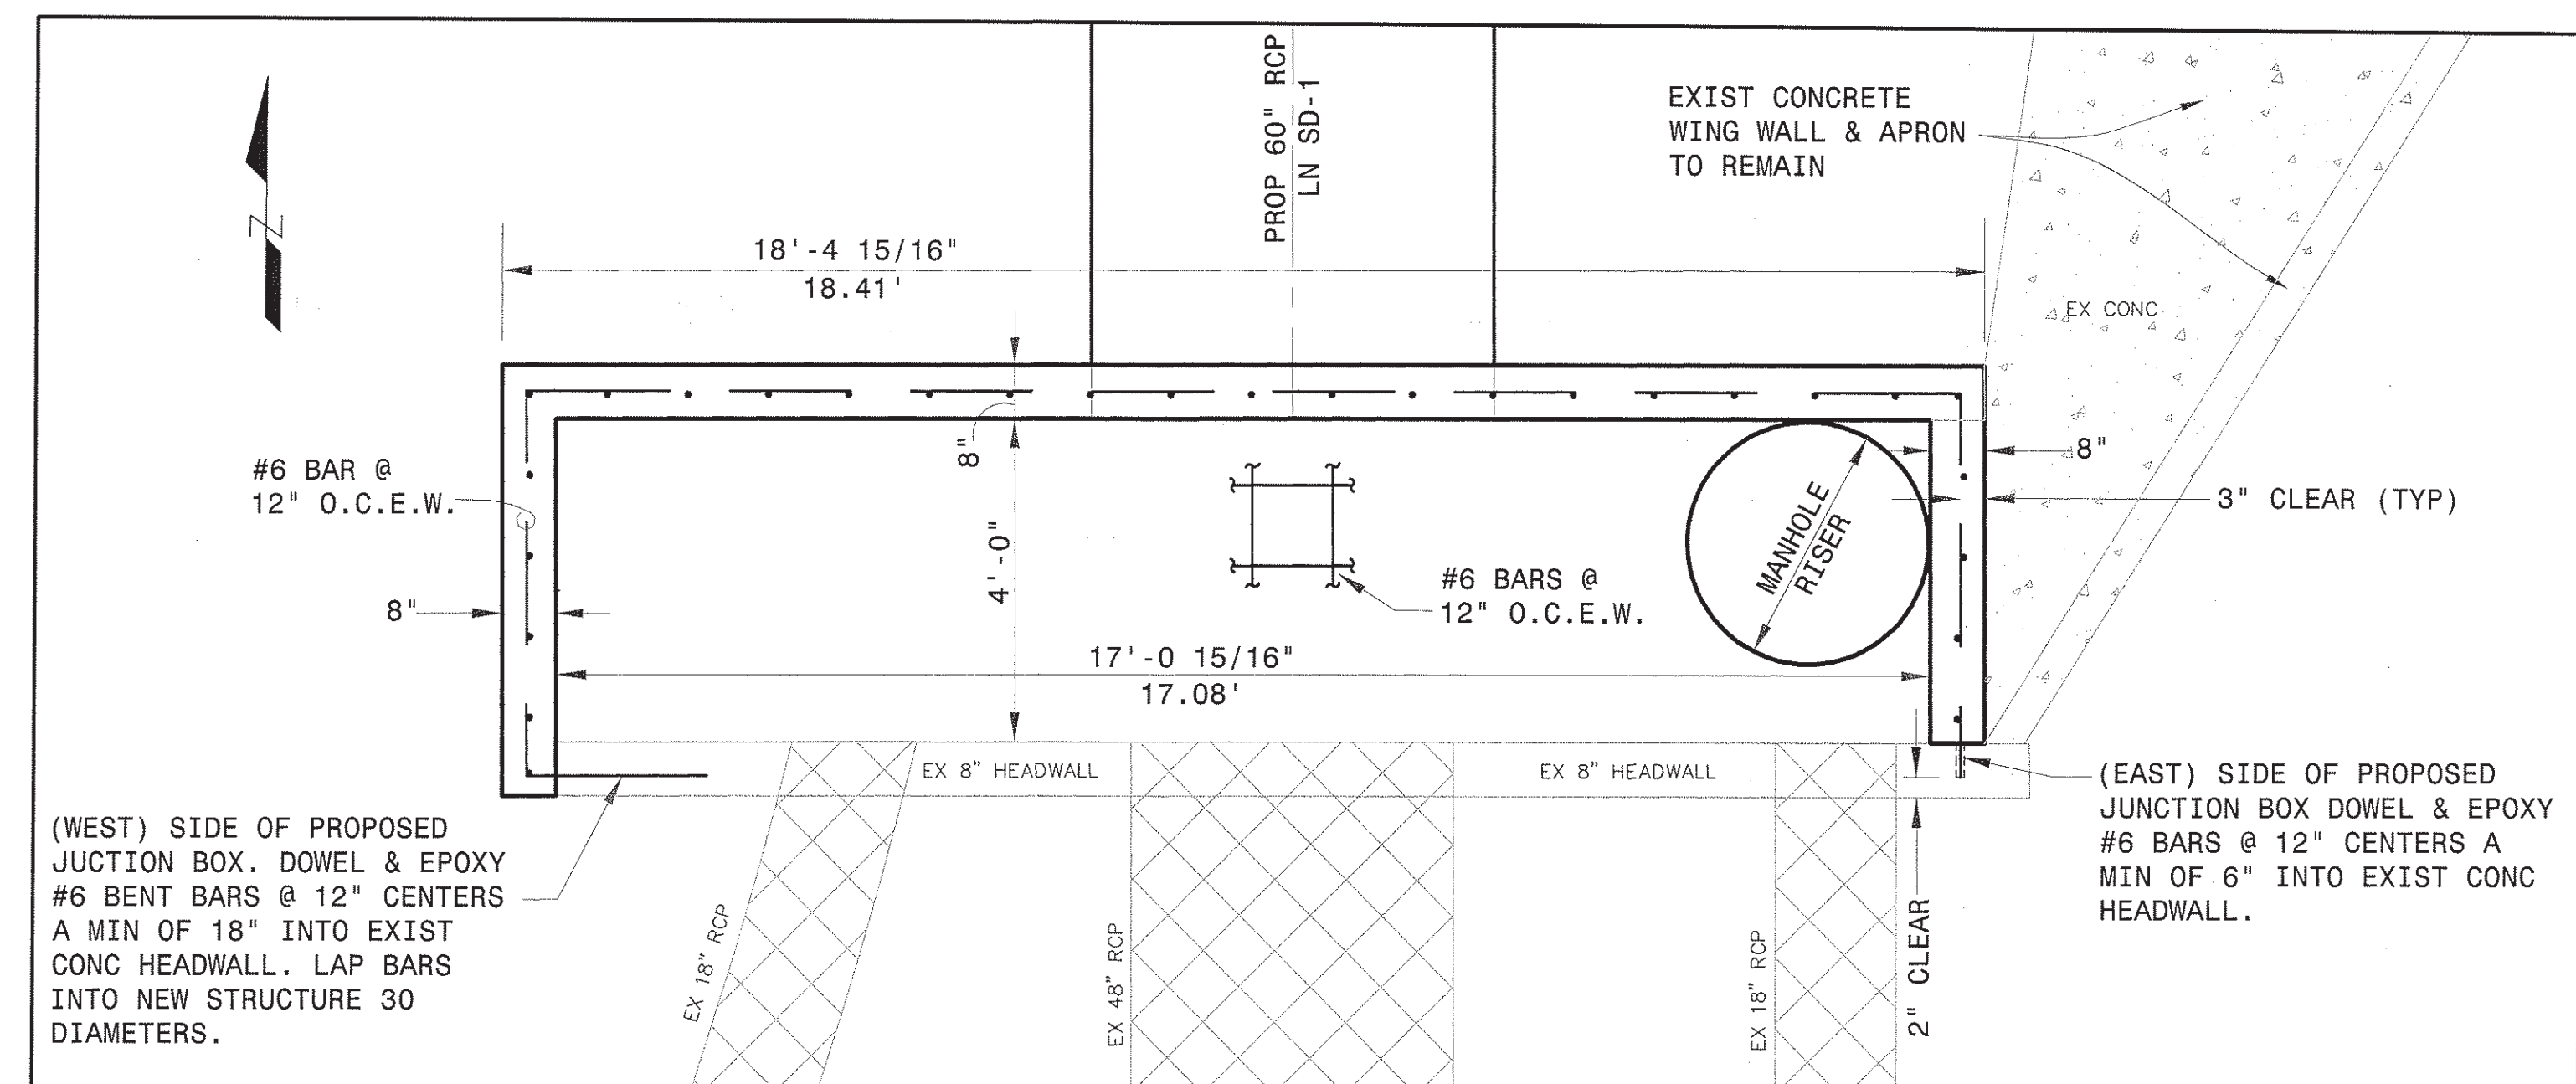

**TOP VIEW**  
1" = 2'

EXISTING	LEGEND	PROPOSED
	STORM SEWER	
	CONCRETE/WINGWALL REMOVAL	

BENCHMARK - TBM	
ELEV.	516.30
MON.	CUT X IN CONC
LOC.	CUT X IN TOP OF INLET NEAR S.W. PROP CORNER OF LOT 18, BLOCK A OF LA JOLLA POINTE ADDITION

- NOTES:
- TOPOGRAPHIC SURVEY PROVIDED BY SELLER.
  - SEE SHEET C3.1 - C3.2 FOR GRADING PLAN.
  - SEE SHEETS C6.1 - C6.3 FOR STORM SEWER PLAN & PROFILES.

- CONCRETE NOTES:
- CONCRETE SHALL BE 4,500 PSI CLASS A.
  - ALL REINFORCING STEEL SHALL BE GRADE 60.

**RECORD DRAWING**


TO THE BEST OF OUR KNOWLEDGE THE IMPROVEMENTS SHOWN ON THIS PLAN WERE COMPLETED IN GENERAL CONFORMANCE WITH THE DESIGN PLANS. THIS DETERMINATION WAS MADE BASED ON POST-CONSTRUCTION SURVEY DATA AND INFORMATION PROVIDED BY THE CONTRACTOR  
 Juan J. Vasquez, P.E. 09/04/2020  
 SIGNED DATE

VASQUEZ ENGINEERING, LLC  
 TEXAS REG. F-12266

JUV	APP.
01/28/19	
NO.	DATE
CONVERT HEADWALL TO JBOX	

THE SEAL APPEARING ON THIS DOCUMENT WAS AUTHORIZED BY  
 JUAN J. VASQUEZ, P.E. 85652, ON  
 01/28/2019

VASQUEZ ENGINEERING, L.L.C.  
 1919 S. Shiloh Road  
 Suite 440, LB 44  
 Garland, Texas 75042  
 Ph: 972-276-2948  
 TX Registration # F-12266

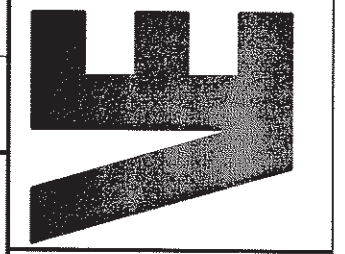


DEVELOPER:  
 ROCKWALL INN KEEPERS I, LTD.  
 6176 FM 2011  
 LONGVIEW, TX 75603

STORM SEWER DETAILS  
 LOT 18, BLOCK A  
 LA JOLLA POINTE ADDITION  
 ROCKWALL, TEXAS


Scale:	AS SHOWN
Designed by:	JJV
Drawn by:	JJV
Checked by:	JJV
Date:	01/28/2019

SHEET  
**C6.4**



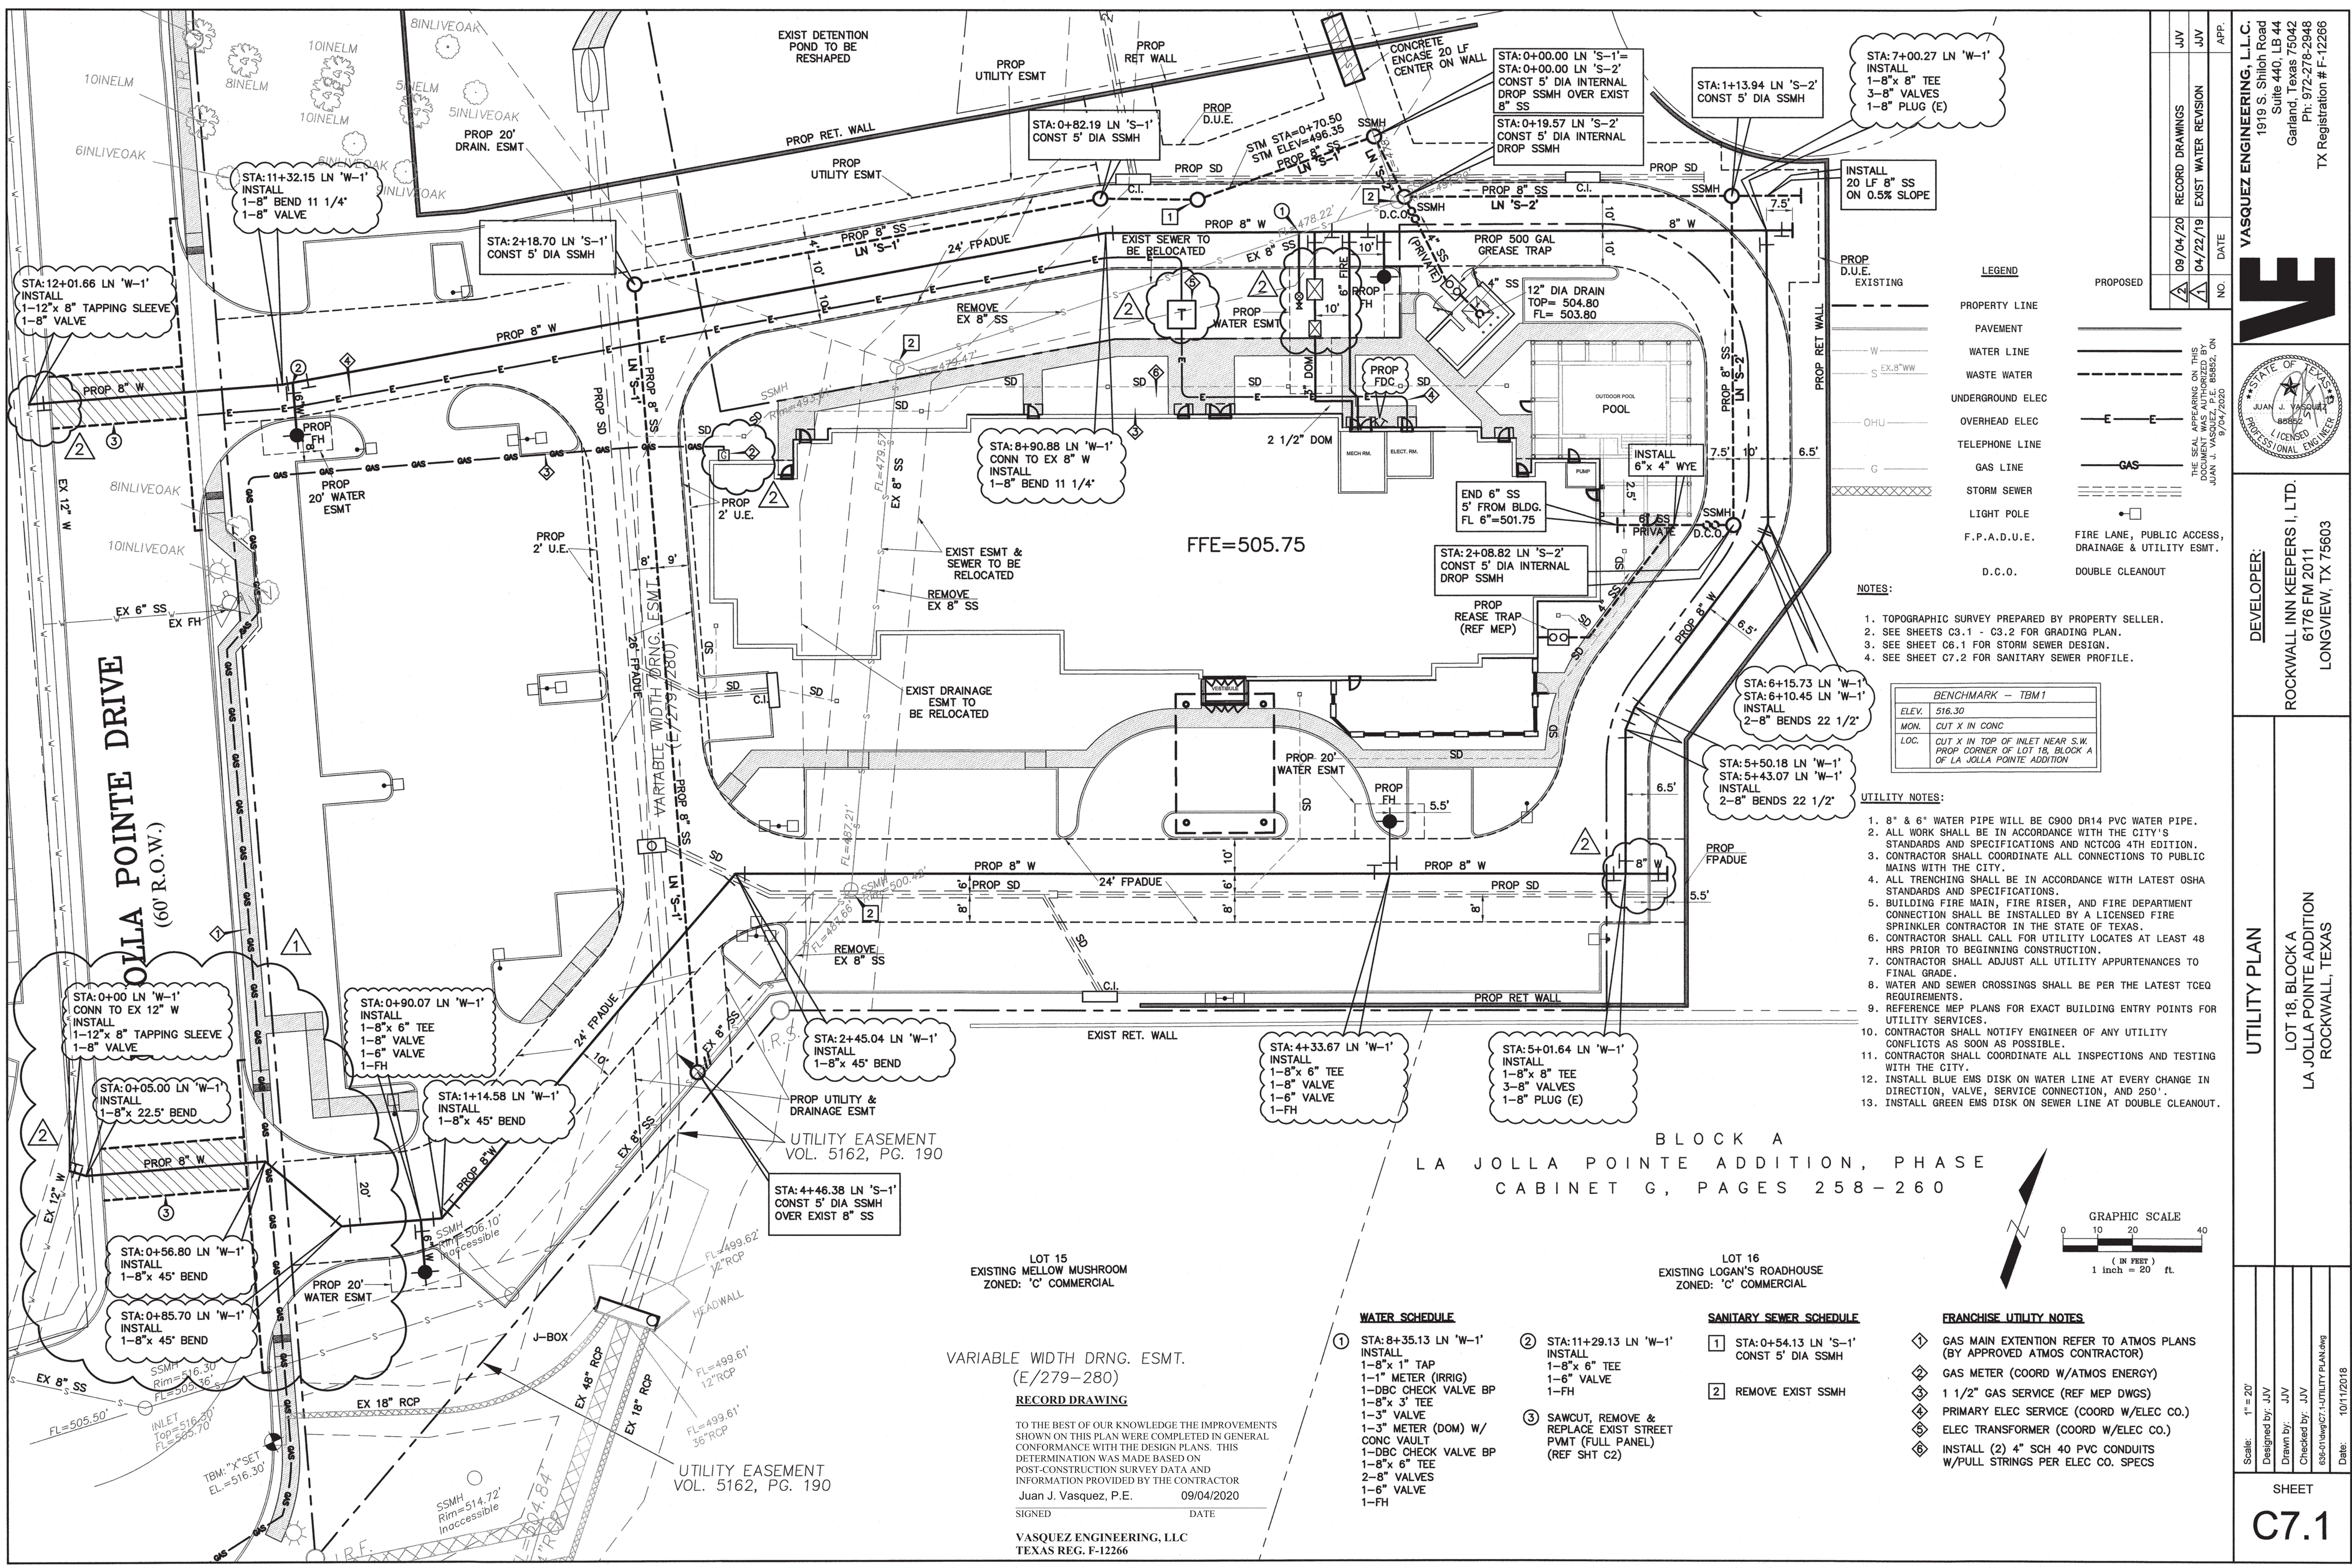

NO.	DATE	REVISION
2	04/22/19	EXIST WATER REVISION
1	08/04/20	RECORD DRAWINGS

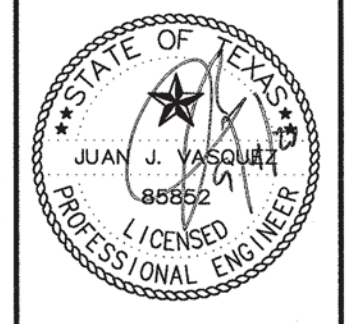

**DEVELOPER:**  
 ROCKWALL INN KEEPERS I, LTD.  
 6176 FM 2011  
 LONGVIEW, TX 75603

**UTILITY PLAN**  
 LOT 18, BLOCK A  
 LA JOLLA POINTE ADDITION  
 ROCKWALL, TEXAS

Scale: 1" = 20'  
 Designed by: JUV  
 Drawn by: JUV  
 Checked by: JUV  
 888-511-1111/UTILITY.PLAN.dwg  
 Date: 10/11/2018

SHEET  
**C7.1**

**VASQUEZ ENGINEERING, L.L.C.**  
 1919 S. Shiloh Road  
 Suite 440, LB 44  
 Garland, Texas 75042  
 Ph: 972-278-2948  
 TX Registration # F-12266

**LEGEND**

---	PROPERTY LINE
---	PAVEMENT
---	WATER LINE
---	WASTE WATER
---	UNDERGROUND ELEC
---	OVERHEAD ELEC
---	TELEPHONE LINE
---	GAS LINE
---	STORM SEWER
---	LIGHT POLE
---	F.P.A.D.U.E.
---	DOUBLE CLEANOUT


- NOTES:**
1. TOPOGRAPHIC SURVEY PREPARED BY PROPERTY SELLER.
  2. SEE SHEETS C3.1 - C3.2 FOR GRADING PLAN.
  3. SEE SHEET C6.1 FOR STORM SEWER DESIGN.
  4. SEE SHEET C7.2 FOR SANITARY SEWER PROFILE.

**BENCHMARK -- TBM1**

ELEV.	516.30
MON.	CUT X IN CONC
LOC.	CUT X IN TOP OF INLET NEAR S.W. PROP CORNER OF LOT 18, BLOCK A OF LA JOLLA POINTE ADDITION

- UTILITY NOTES:**
1. 8" & 6" WATER PIPE WILL BE C900 DR14 PVC WATER PIPE.
  2. ALL WORK SHALL BE IN ACCORDANCE WITH THE CITY'S STANDARDS AND SPECIFICATIONS AND NCTCOG 4TH EDITION.
  3. CONTRACTOR SHALL COORDINATE ALL CONNECTIONS TO PUBLIC MAINS WITH THE CITY.
  4. ALL TRENCHING SHALL BE IN ACCORDANCE WITH LATEST OSHA STANDARDS AND SPECIFICATIONS.
  5. BUILDING FIRE MAIN, FIRE RISER, AND FIRE DEPARTMENT CONNECTION SHALL BE INSTALLED BY A LICENSED FIRE SPRINKLER CONTRACTOR IN THE STATE OF TEXAS.
  6. CONTRACTOR SHALL CALL FOR UTILITY LOCATES AT LEAST 48 HRS PRIOR TO BEGINNING CONSTRUCTION.
  7. CONTRACTOR SHALL ADJUST ALL UTILITY APPURTENANCES TO FINAL GRADE.
  8. WATER AND SEWER CROSSINGS SHALL BE PER THE LATEST TCEQ REQUIREMENTS.
  9. REFERENCE MEP PLANS FOR EXACT BUILDING ENTRY POINTS FOR UTILITY SERVICES.
  10. CONTRACTOR SHALL NOTIFY ENGINEER OF ANY UTILITY CONFLICTS AS SOON AS POSSIBLE.
  11. CONTRACTOR SHALL COORDINATE ALL INSPECTIONS AND TESTING WITH THE CITY.
  12. INSTALL BLUE EMS DISK ON WATER LINE AT EVERY CHANGE IN DIRECTION, VALVE, SERVICE CONNECTION, AND 250'.
  13. INSTALL GREEN EMS DISK ON SEWER LINE AT DOUBLE CLEANOUT.

**BLOCK A**  
 LA JOLLA POINTE ADDITION, PHASE  
 CABINET G, PAGES 258-260

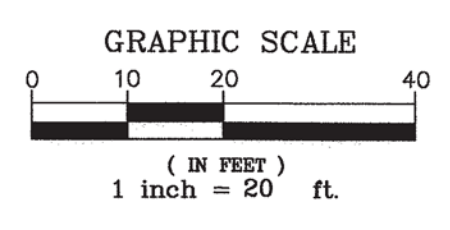

LOT 15  
 EXISTING MELLOW MUSHROOM  
 ZONED: 'C' COMMERCIAL

LOT 16  
 EXISTING LOGAN'S ROADHOUSE  
 ZONED: 'C' COMMERCIAL

VARIABLE WIDTH DRNG. ESMT.  
 (E/279-280)  
**RECORD DRAWING**

TO THE BEST OF OUR KNOWLEDGE THE IMPROVEMENTS SHOWN ON THIS PLAN WERE COMPLETED IN GENERAL CONFORMANCE WITH THE DESIGN PLANS. THIS DETERMINATION WAS MADE BASED ON POST-CONSTRUCTION SURVEY DATA AND INFORMATION PROVIDED BY THE CONTRACTOR  
 Juan J. Vasquez, P.E. 09/04/2020


SIGNED \_\_\_\_\_ DATE \_\_\_\_\_  
 VASQUEZ ENGINEERING, LLC  
 TEXAS REG. F-12266

- WATER SCHEDULE**
1. STA: 8+35.13 LN 'W-1' INSTALL 1-8"x 1" TAP 1-1" METER (IRRIG) 1-DBC CHECK VALVE BP 1-8"x 3" TEE 1-3" VALVE 1-3" METER (DOM) W/ CONC VAULT 1-DBC CHECK VALVE BP 1-8"x 6" TEE 2-8" VALVES 1-6" VALVE 1-FH
  2. STA: 11+29.13 LN 'W-1' INSTALL 1-8"x 6" TEE 1-6" VALVE 1-FH
  3. SAWCUT, REMOVE & REPLACE EXIST STREET PVMT (FULL PANEL) (REF SHT C2)

- SANITARY SEWER SCHEDULE**
1. STA: 0+54.13 LN 'S-1' CONST 5" DIA SSMH
  2. REMOVE EXIST SSMH

- FRANCHISE UTILITY NOTES**
- ◆ GAS MAIN EXTENSION REFER TO ATMOS PLANS (BY APPROVED ATMOS CONTRACTOR)
  - ◆ GAS METER (COORD W/ATMOS ENERGY)
  - ◆ 1 1/2" GAS SERVICE (REF MEP DWGS)
  - ◆ ELEC TRANSFORMER (COORD W/ELEC CO.)
  - ◆ INSTALL (2) 4" SCH 40 PVC CONDUITS W/PULL STRINGS PER ELEC CO. SPECS




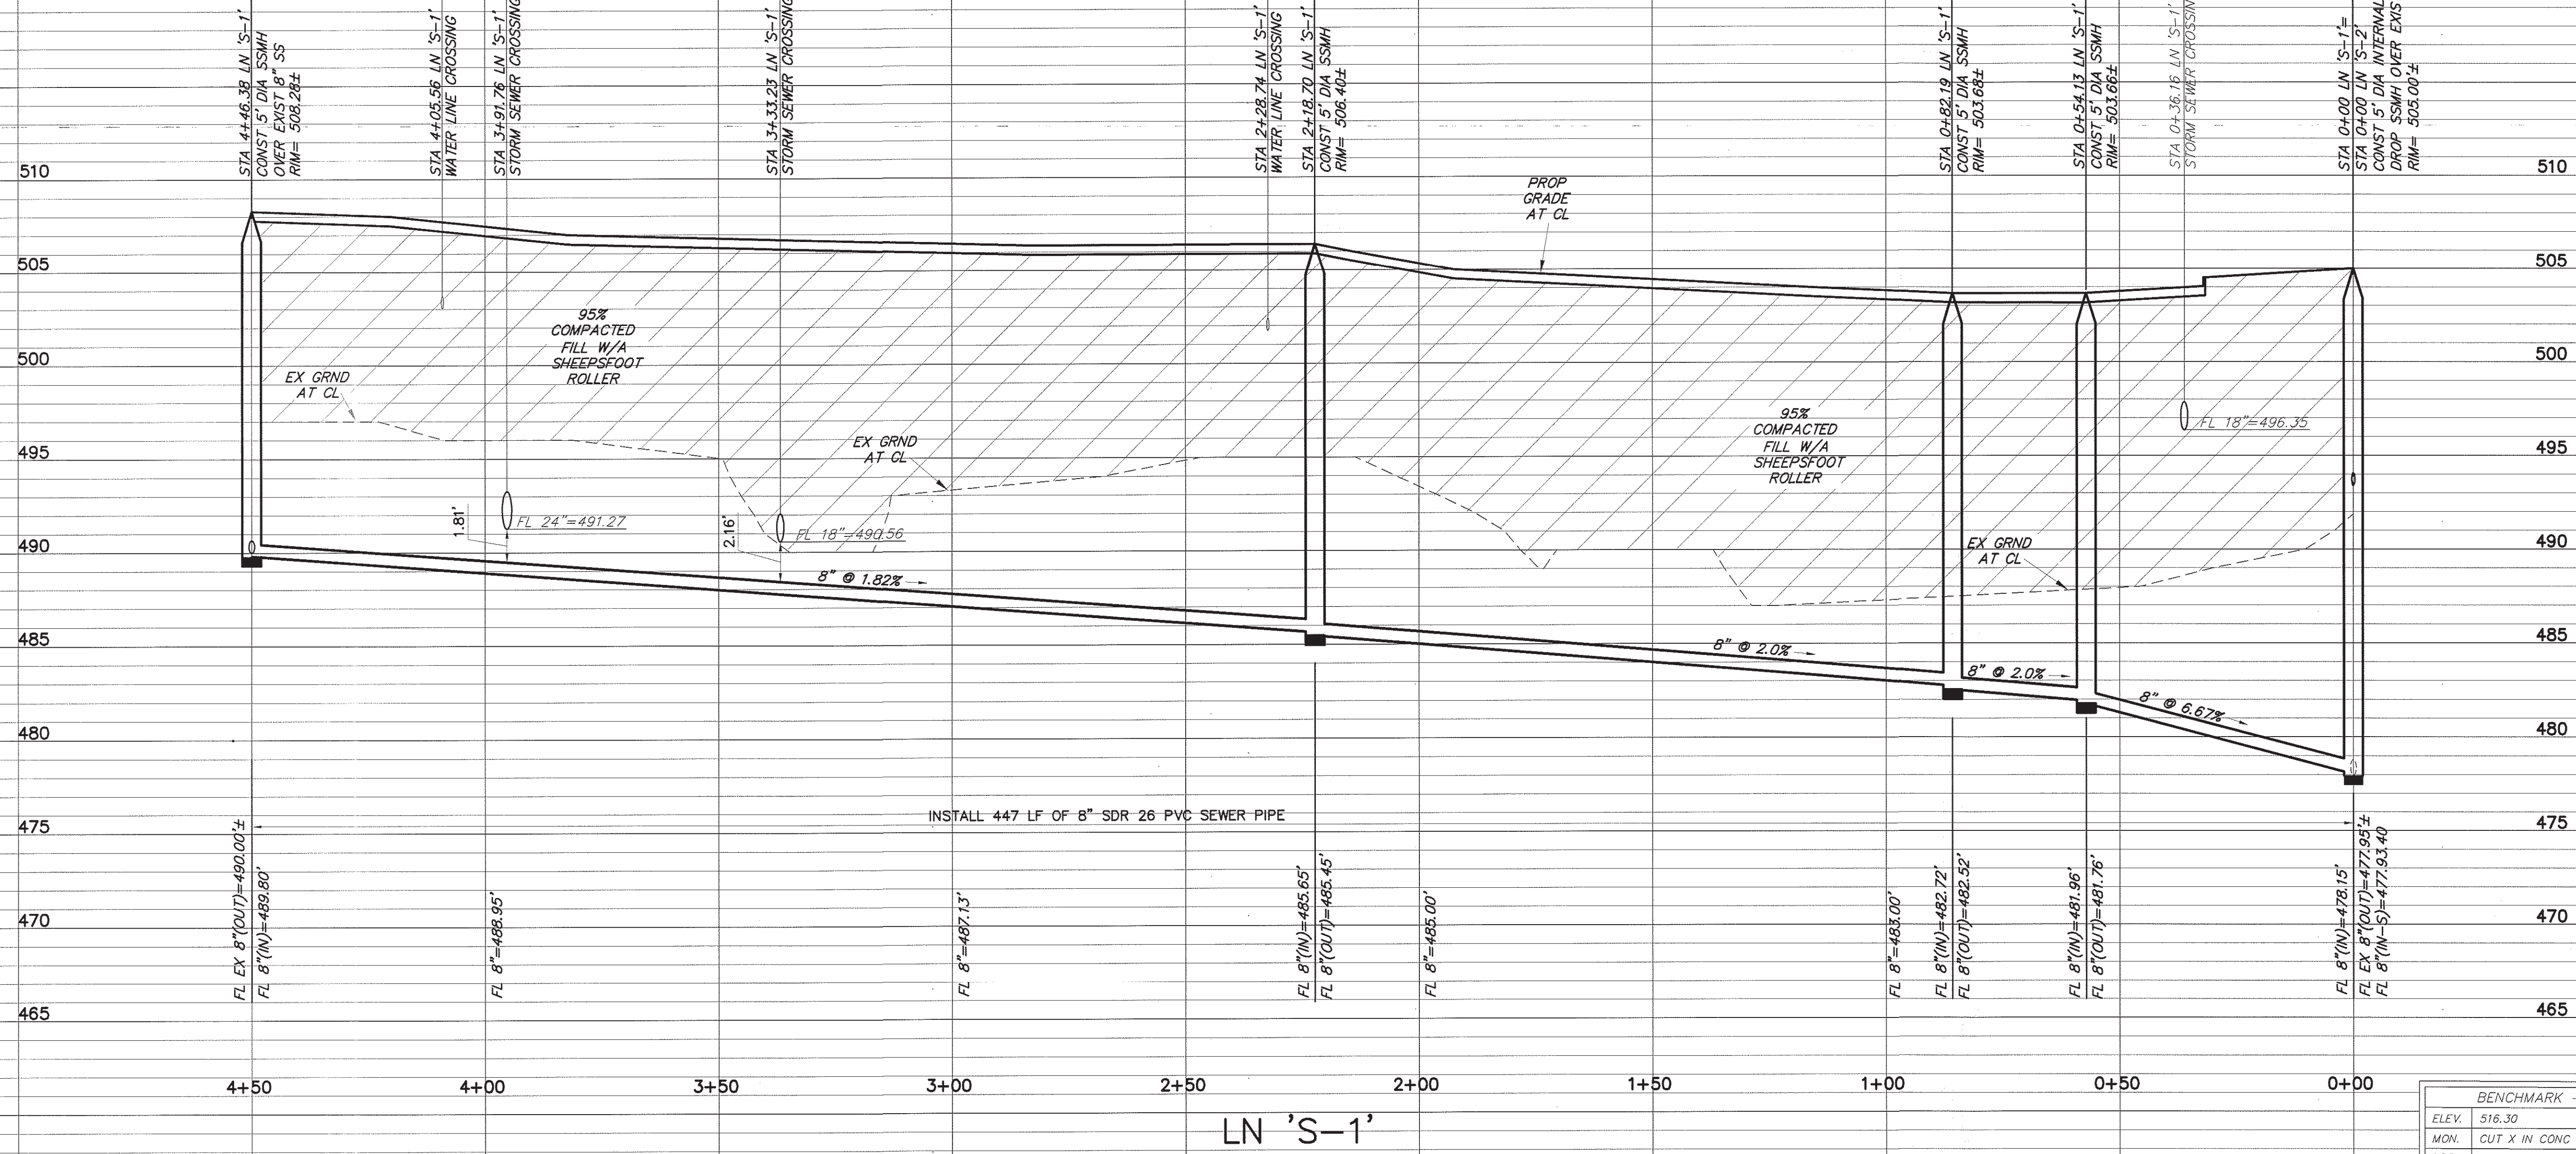

LN 'S-1'

NOTE: NO SERVICES ALLOWED ON SEWER MAIN 10' OR DEEPER

BENCHMARK - TBM 1  
 ELEV. 516.30  
 MON. CUT X IN CONC  
 LOC. CUT X IN TOP OF INLET NEAR S.W. PROP CORNER OF LOT 18, BLOCK A OF LA JOLLA POINTE ADDITION

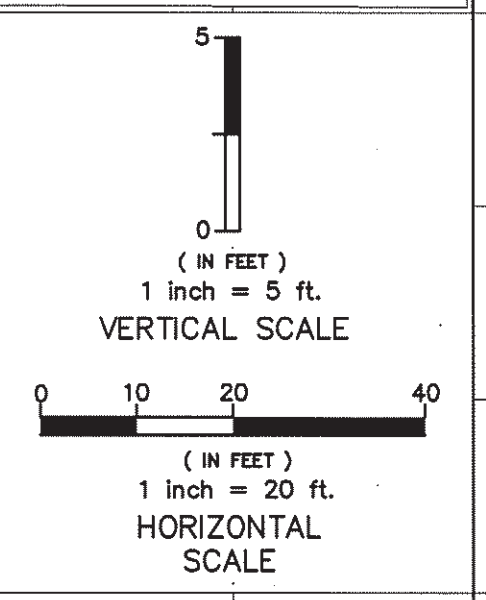


**RECORD DRAWING**  
 TO THE BEST OF OUR KNOWLEDGE THE IMPROVEMENTS SHOWN ON THIS PLAN WERE COMPLETED IN GENERAL CONFORMANCE WITH THE DESIGN PLANS. THIS DETERMINATION WAS MADE BASED ON POST-CONSTRUCTION SURVEY DATA AND INFORMATION PROVIDED BY THE CONTRACTOR  
 Juan J. Vasquez, P.E. 09/04/2020  
 SIGNED \_\_\_\_\_ DATE \_\_\_\_\_  
 VASQUEZ ENGINEERING, LLC  
 TEXAS REG. F-12266

THE SEAL APPEARING ON THIS DOCUMENT WAS AUTHORIZED BY JUAN J. VASQUEZ, P.E. 88852, ON 10/11/2018

APP. NO. DATE

VASQUEZ ENGINEERING, L.L.C.  
 1919 S. Shiloh Road  
 Suite 440, LB 44  
 Garland, Texas 75042  
 Ph: 972-278-2948  
 TX Registration # F-12266

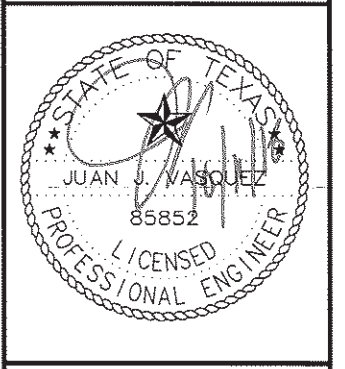


DEVELOPER:  
 ROCKWALL INN KEEPERS I, LTD.  
 6176 FM 2011  
 LONGVIEW, TX 75603

SANITARY SEWER PROFILES  
 LOT 18, BLOCK A  
 LA JOLLA POINTE ADDITION  
 ROCKWALL, TEXAS


Scale: AS NOTED  
 Designed by: JJV  
 Drawn by: JJV  
 Checked by: JJV  
 638-010wq/C7.2 SANITARY SEWER PROFILES.rwp  
 Date: 10/11/2018

SHEET  
**C7.2**



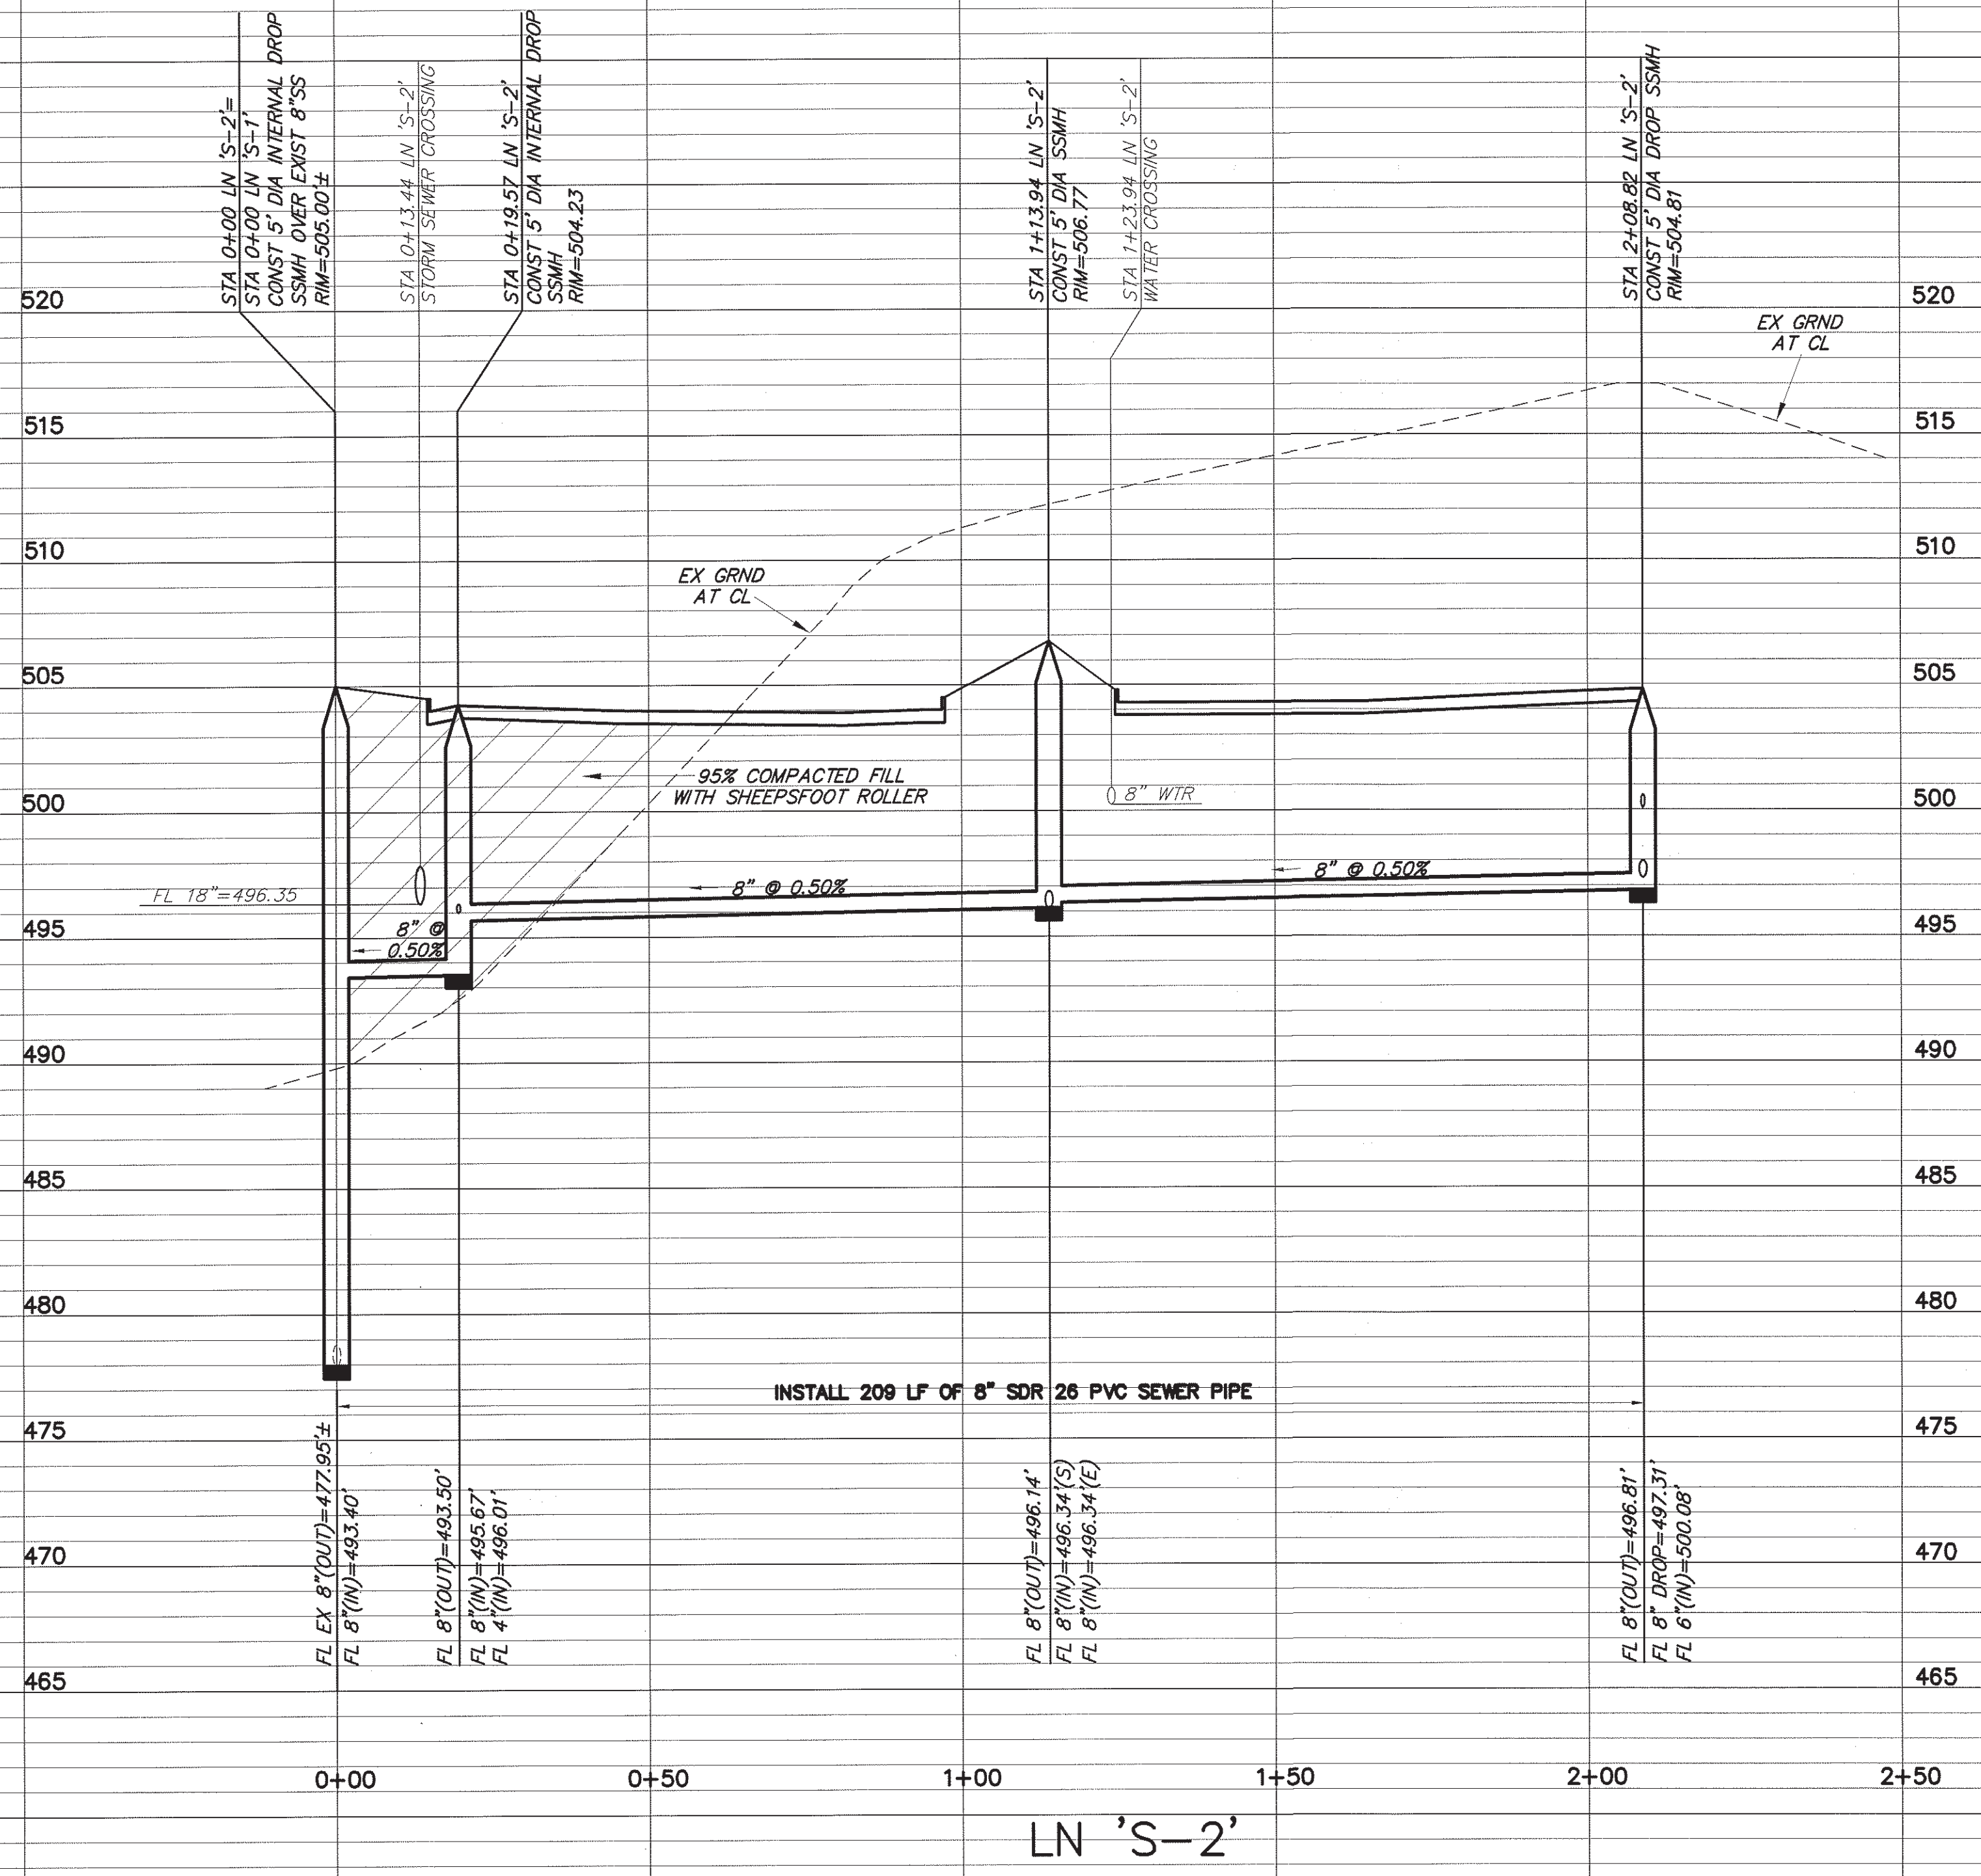


BENCHMARK - TBM1  
 ELEV. 516.30  
 MON. CUT X IN CONC  
 LOC. CUT X IN TOP OF INLET NEAR S.W. PROP CORNER OF LOT 18, BLOCK A OF LA JOLLA POINTE ADDITION

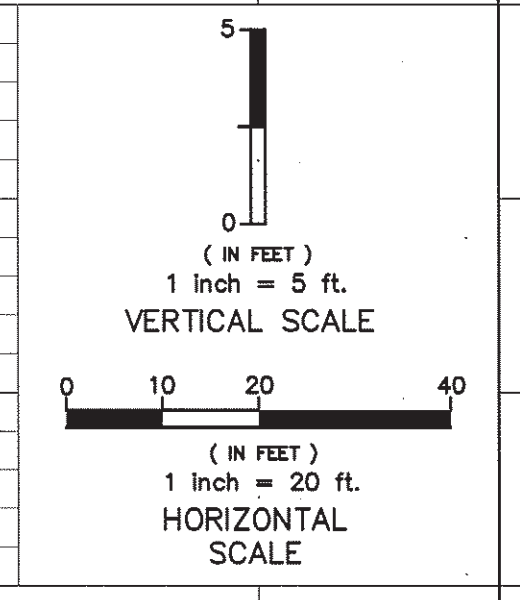

**RECORD DRAWING**  
 TO THE BEST OF OUR KNOWLEDGE THE IMPROVEMENTS SHOWN ON THIS PLAN WERE COMPLETED IN GENERAL CONFORMANCE WITH THE DESIGN PLANS. THIS DETERMINATION WAS MADE BASED ON POST-CONSTRUCTION SURVEY DATA AND INFORMATION PROVIDED BY THE CONTRACTOR  
 Juan J. Vasquez, P.E. 09/04/2020  
 SIGNED DATE  
 VASQUEZ ENGINEERING, LLC  
 TEXAS REG. F-12266

THE SEAL APPEARING ON THIS DOCUMENT WAS AUTHORIZED BY JUAN J. VASQUEZ, P.E. 09/04/2020

**VASQUEZ ENGINEERING, L.L.C.**  
 1919 S. Shiloh Road  
 Suite 440, LB 44  
 Garland, Texas 75042  
 Ph: 972-276-2948  
 TX Registration # F-12266

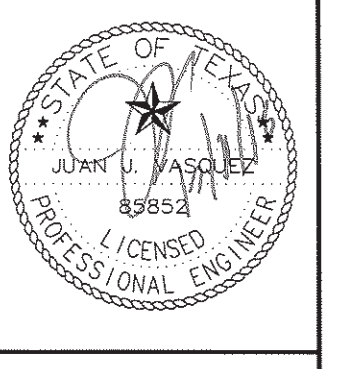


**DEVELOPER:**  
 ROCKWALL INN KEEPERS I, LTD.  
 6176 FM 2011  
 LONGVIEW, TX 75603

**SANITARY SEWER PROFILES**  
 LOT 18, BLOCK A  
 LA JOLLA POINTE ADDITION  
 ROCKWALL, TEXAS

Scale: AS NOTED  
 Designed by: JJV  
 Drawn by: JJV  
 Checked by: JJV  
 Date: 10/11/2018


SHEET  
**C7.3**



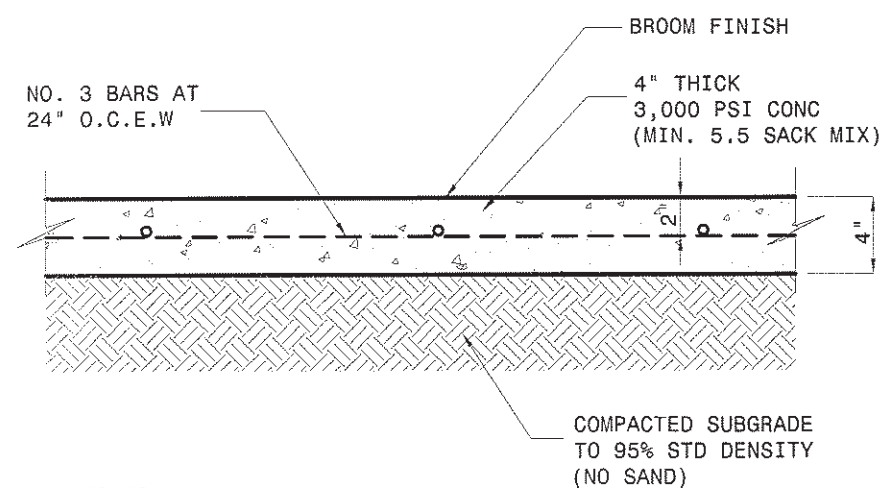


- NOTES:
1. TOOLED JOINTS AT 5' MAXIMUM SPACING.
  2. EXPANSION JOINTS AT 30' MAXIMUM SPACING.
  3. 2% MAXIMUM CROSS SLOPE.

**ON-SITE SIDEWALK DETAIL**  
NTS

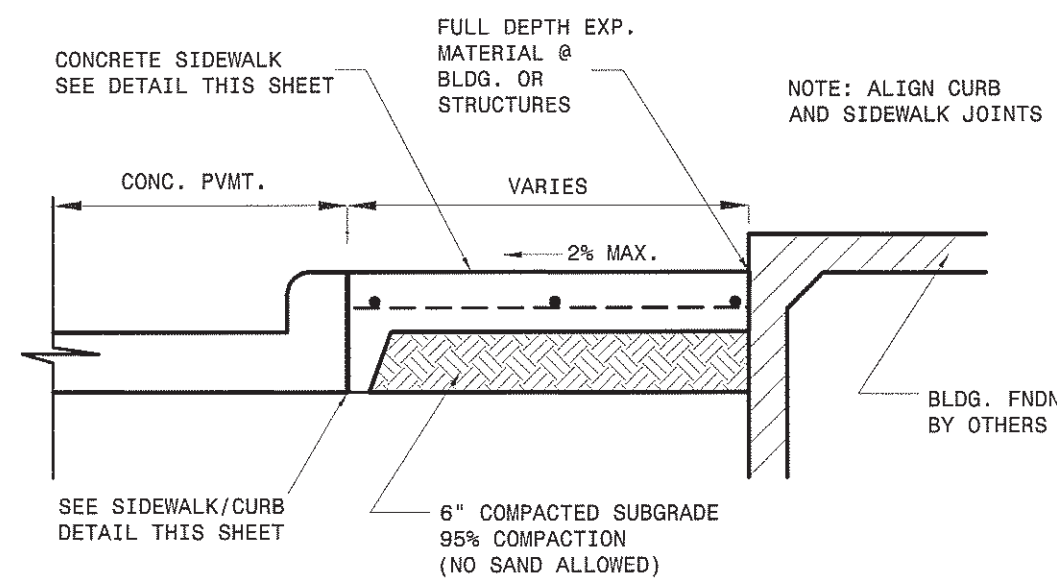


**SIDEWALK ADJACENT TO CURB DETAIL**  
NTS

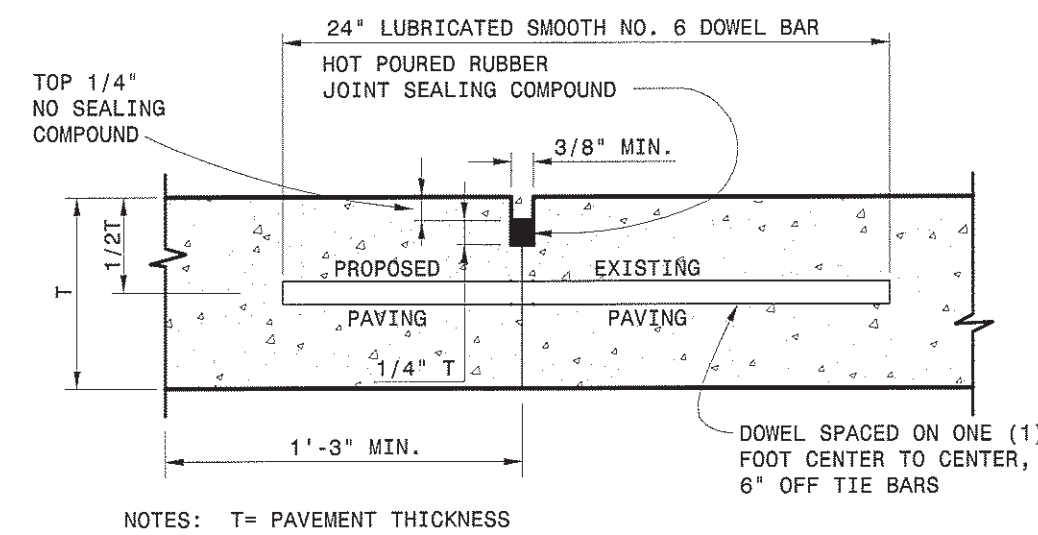

- NOTES: T = PAVEMENT THICKNESS
1. LONGITUDINAL BUTT CONSTRUCTION MAY BE UTILIZED IN PLACE OF LONGITUDINAL HINGED (KEYWAY) JOINT AT CONTRACTOR'S OPTION.
  2. DOWEL BARS SHALL BE DRILLED INTO PAVEMENT HORIZONTALLY BY USE OF A MECHANICAL RIG.
- DRILLING BY HAND IS NOT ACCEPTABLE, PUSHING DOWEL BARS INTO GREEN CONCRETE NOT ACCEPTABLE



**LONGITUDINAL BUTT JOINT**  
NTS

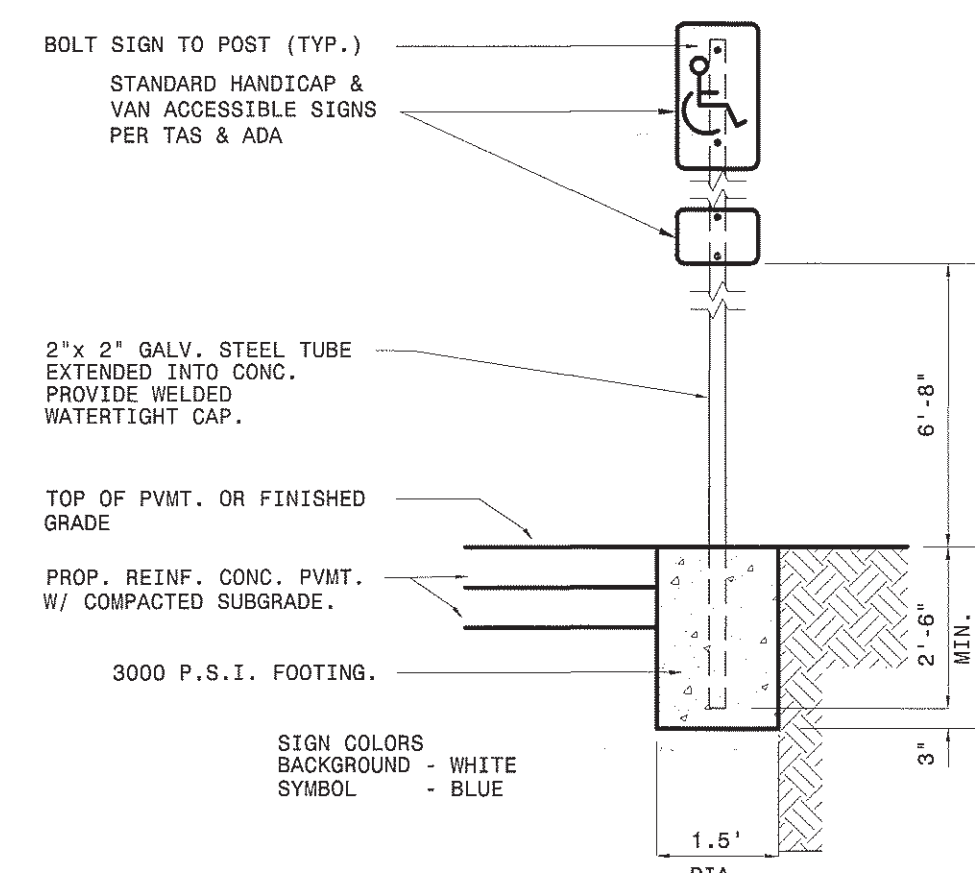


**ACCESSIBLE SIGN DETAIL**  
NTS

**GENERAL NOTES**


1. THE CONTRACTOR SHALL BE RESPONSIBLE FOR BEING FAMILIAR WITH THE PLANS AND SPECIFICATIONS FOR THIS PROJECT, THE PROJECT AREA, AND ALL CODES, REGULATIONS OR LAWS APPLICABLE TO THE PROJECT.
2. ALL CONSTRUCTION SHALL BE PER CITY STANDARDS/TXDOT STANDARDS.
3. OWNER SHALL DESIGNATE A STAGING AREA FOR THE CONTRACTOR. NO STORAGE OF EQUIPMENT OR MATERIALS SHALL BE PERMITTED WITHOUT PERMISSION OF THE OWNER.
4. CONTRACTOR SHALL MAINTAIN THE SITE IN A NEAT AND ORDERLY FASHION AND DISPOSE OF EXCESS MATERIALS AND DEBRIS BY LEGAL MEANS OFF SITE. NO DEBRIS SHALL BE BURIED ON SITE.
5. UTILITIES SHOWN ARE AT APPROXIMATE LOCATIONS BASED ON AVAILABLE PLANS AND NOT ALL UTILITIES MAY BE SHOWN. CONTRACTOR IS RESPONSIBLE FOR LOCATING ALL UTILITIES PRIOR TO CONSTRUCTION AND SHALL NOTIFY THE TOWN AND ENGINEER OF POTENTIAL CONFLICTS WITH THE PLANS PRIOR TO CONSTRUCTION.
6. ALL DIMENSION SHOWN ARE TO THE FACE OF CURB, EDGE OF PAVEMENT, OR CENTERLINE OF PIPE/CHANNEL UNLESS OTHERWISE NOTED.
7. CONTRACTOR IS RESPONSIBLE FOR PROTECTION OF EXISTING UTILITIES AND SITE FEATURES DURING CONSTRUCTION. CONTRACTOR SHALL REPAIR ANY DAMAGED UTILITIES OR SITE FEATURES TO A LIKE NEW CONDITION AT CONTRACTOR'S EXPENSE PRIOR TO FINAL APPROVAL OF THE CONSTRUCTION BY OWNER.
8. CONTRACTOR TO ADJUST ALL EXISTING AND PROPOSED UTILITIES TO FINAL GRADE.

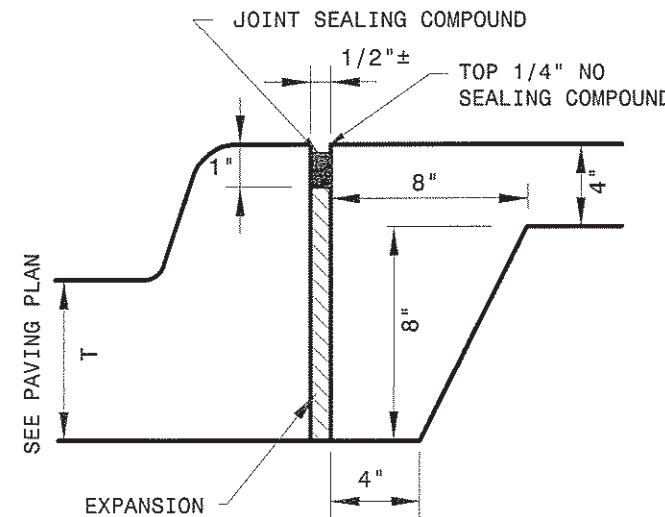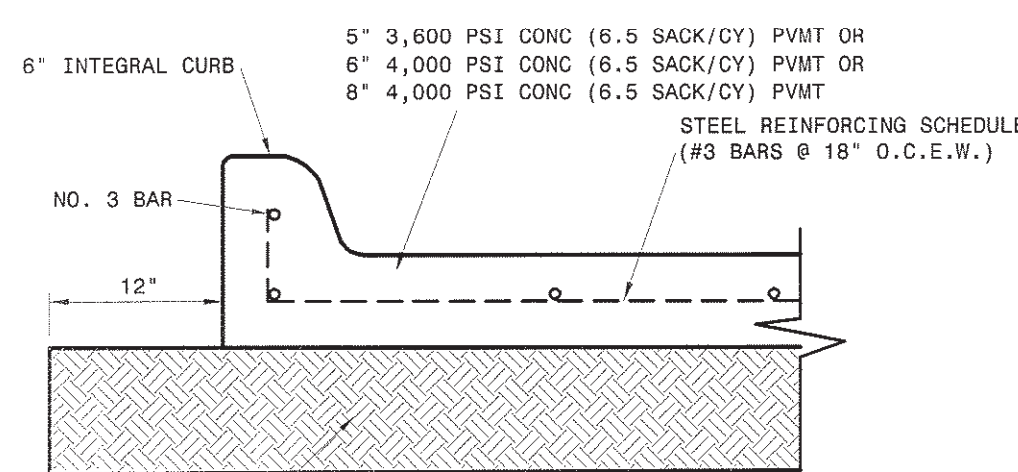


**SIDEWALK/CURB DETAIL**  
NTS

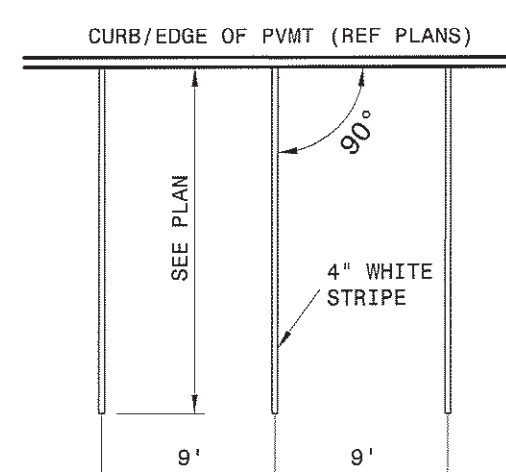

**STANDARD PARKING STALL DETAIL**  
NTS

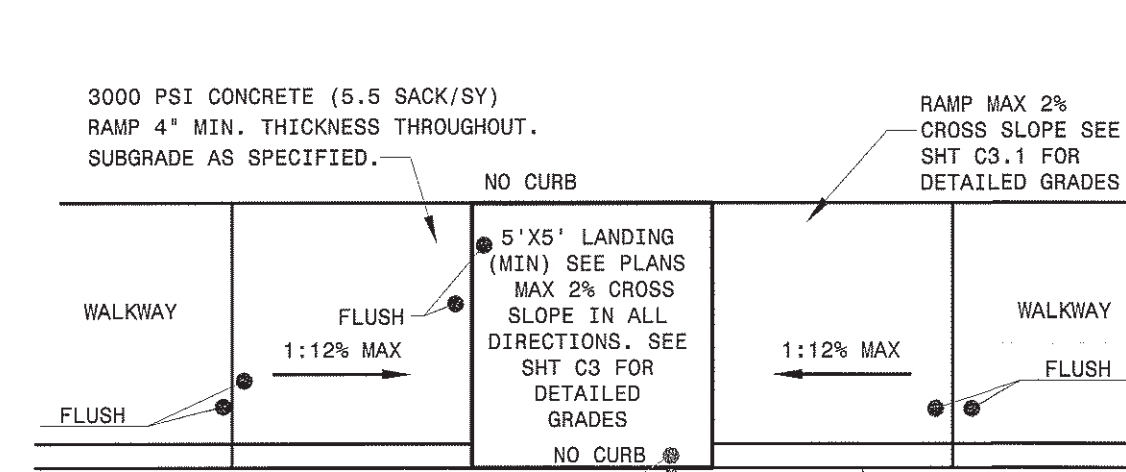


**PRIVATE BARRIER FREE RAMP TYPE I**  
NTS

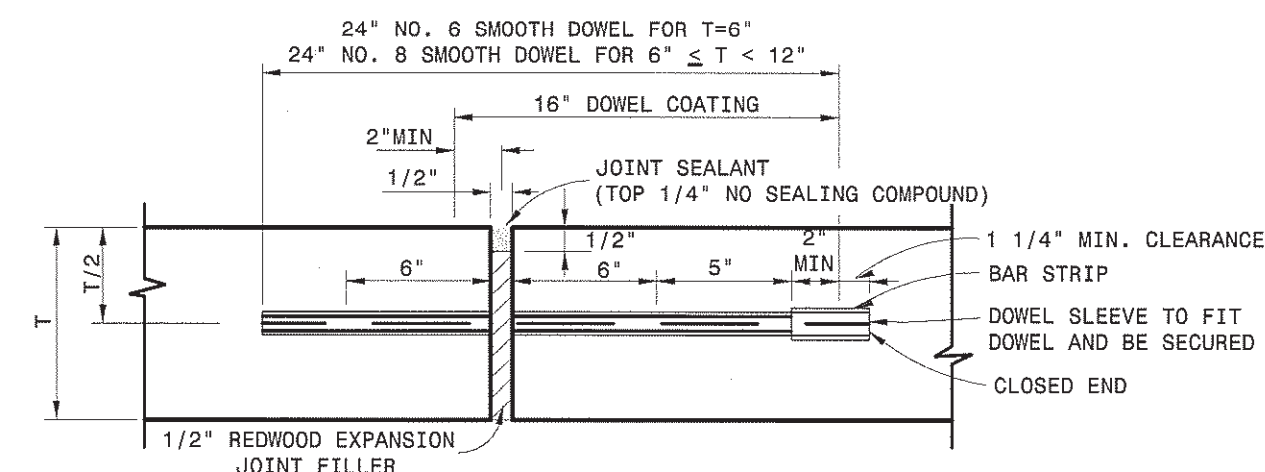


**EXPANSION JOINT**  
NTS

- NOTES:
1. PAVEMENT AND SUBGRADE RECOMMENDATIONS PER GEOTECHNICAL REPORT PREPARED BY GEOSCIENCE ENGINEERING & TESTING, INC., PROJECT NO. 17-068077, DATED JANUARY 2018.
  2. CONCRETE TO BE AIR ENTRAINED (4-6%).
  3. IN LIEU OF LIME STABILIZED GRADE INCREASE CONC PVMT THICKNESS BY 1-INCH.
  4. EXPANSION JOINTS TO BE AS NOTED ON THE PLAN.
  5. REFER TO GEOTECHNICAL REPORT FOR ADDITIONAL INFORMATION.


**ON-SITE CONCRETE PVMT SECTION**  
NTS

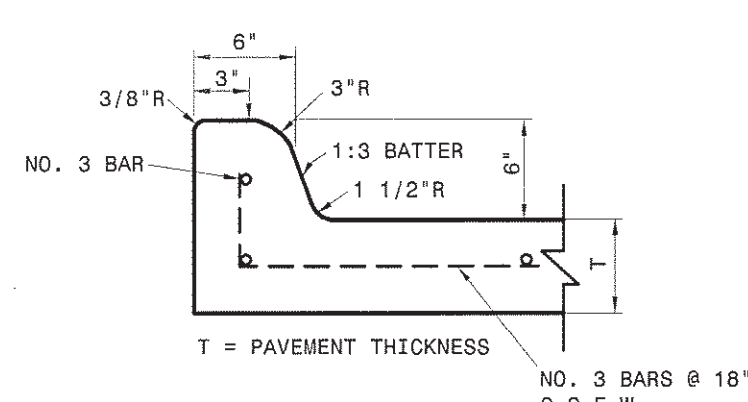


**INTEGRAL CURB**  
NTS

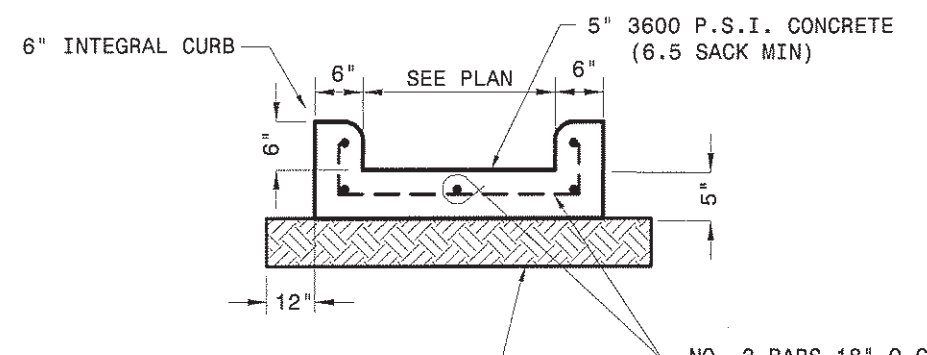


**FLUME DETAIL**  
NTS

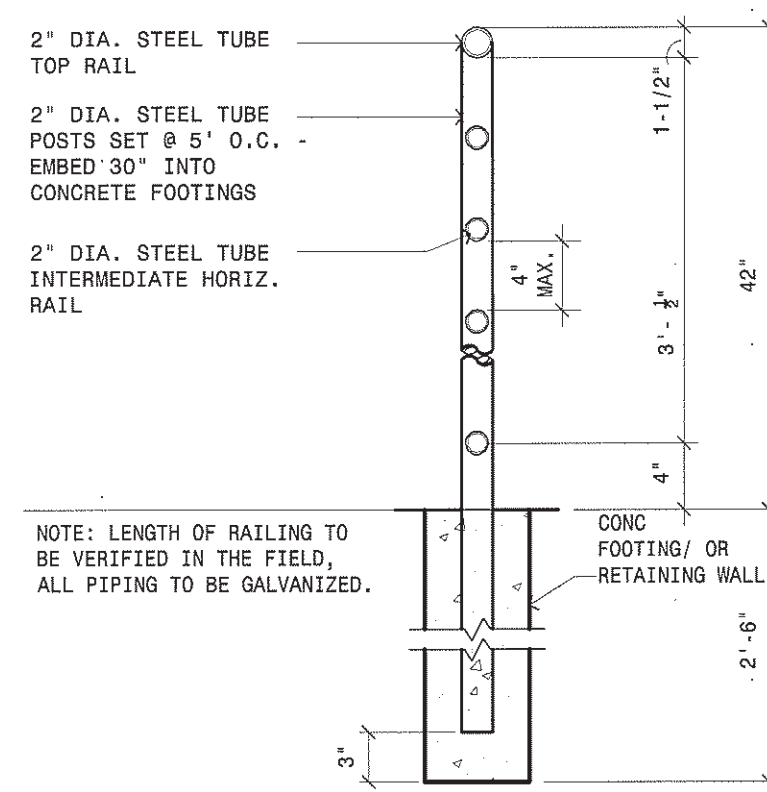


**TUBULAR STEEL FENCE**  
NTS

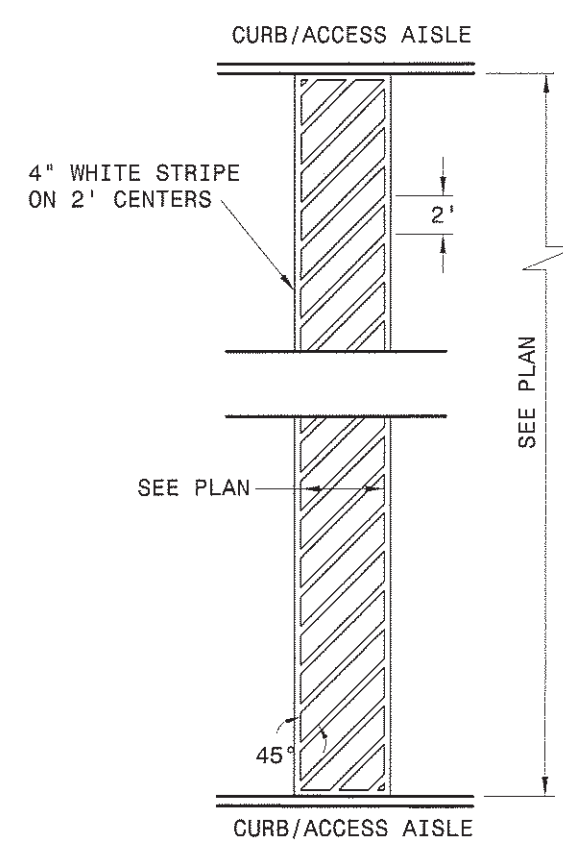

**CROSSWALK STRIPING DETAIL**  
NTS

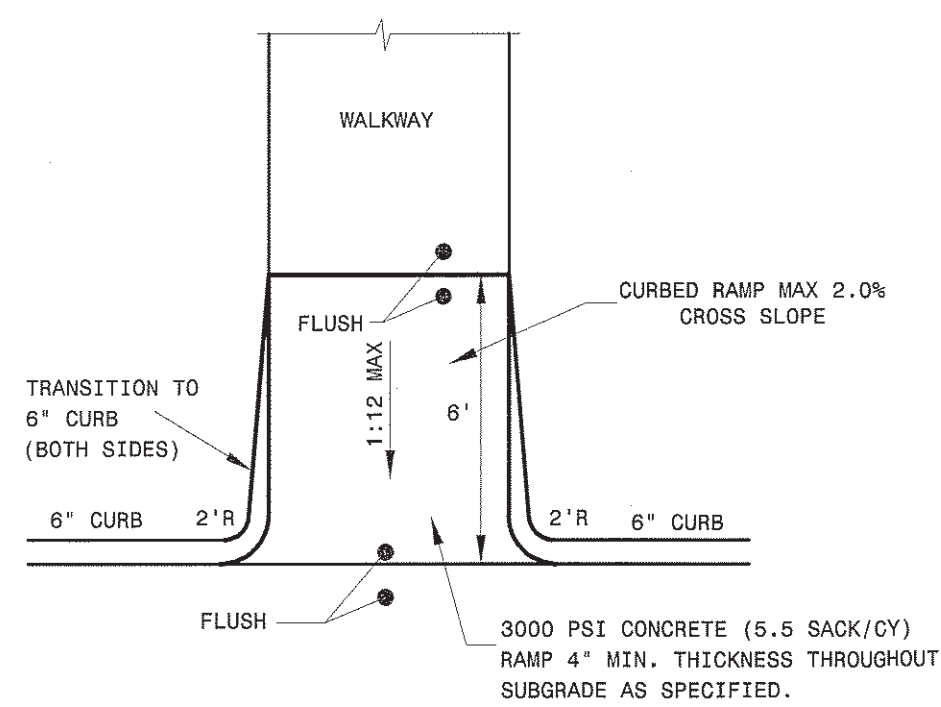

**PRIVATE BARRIER FREE RAMP TYPE II**  
NTS

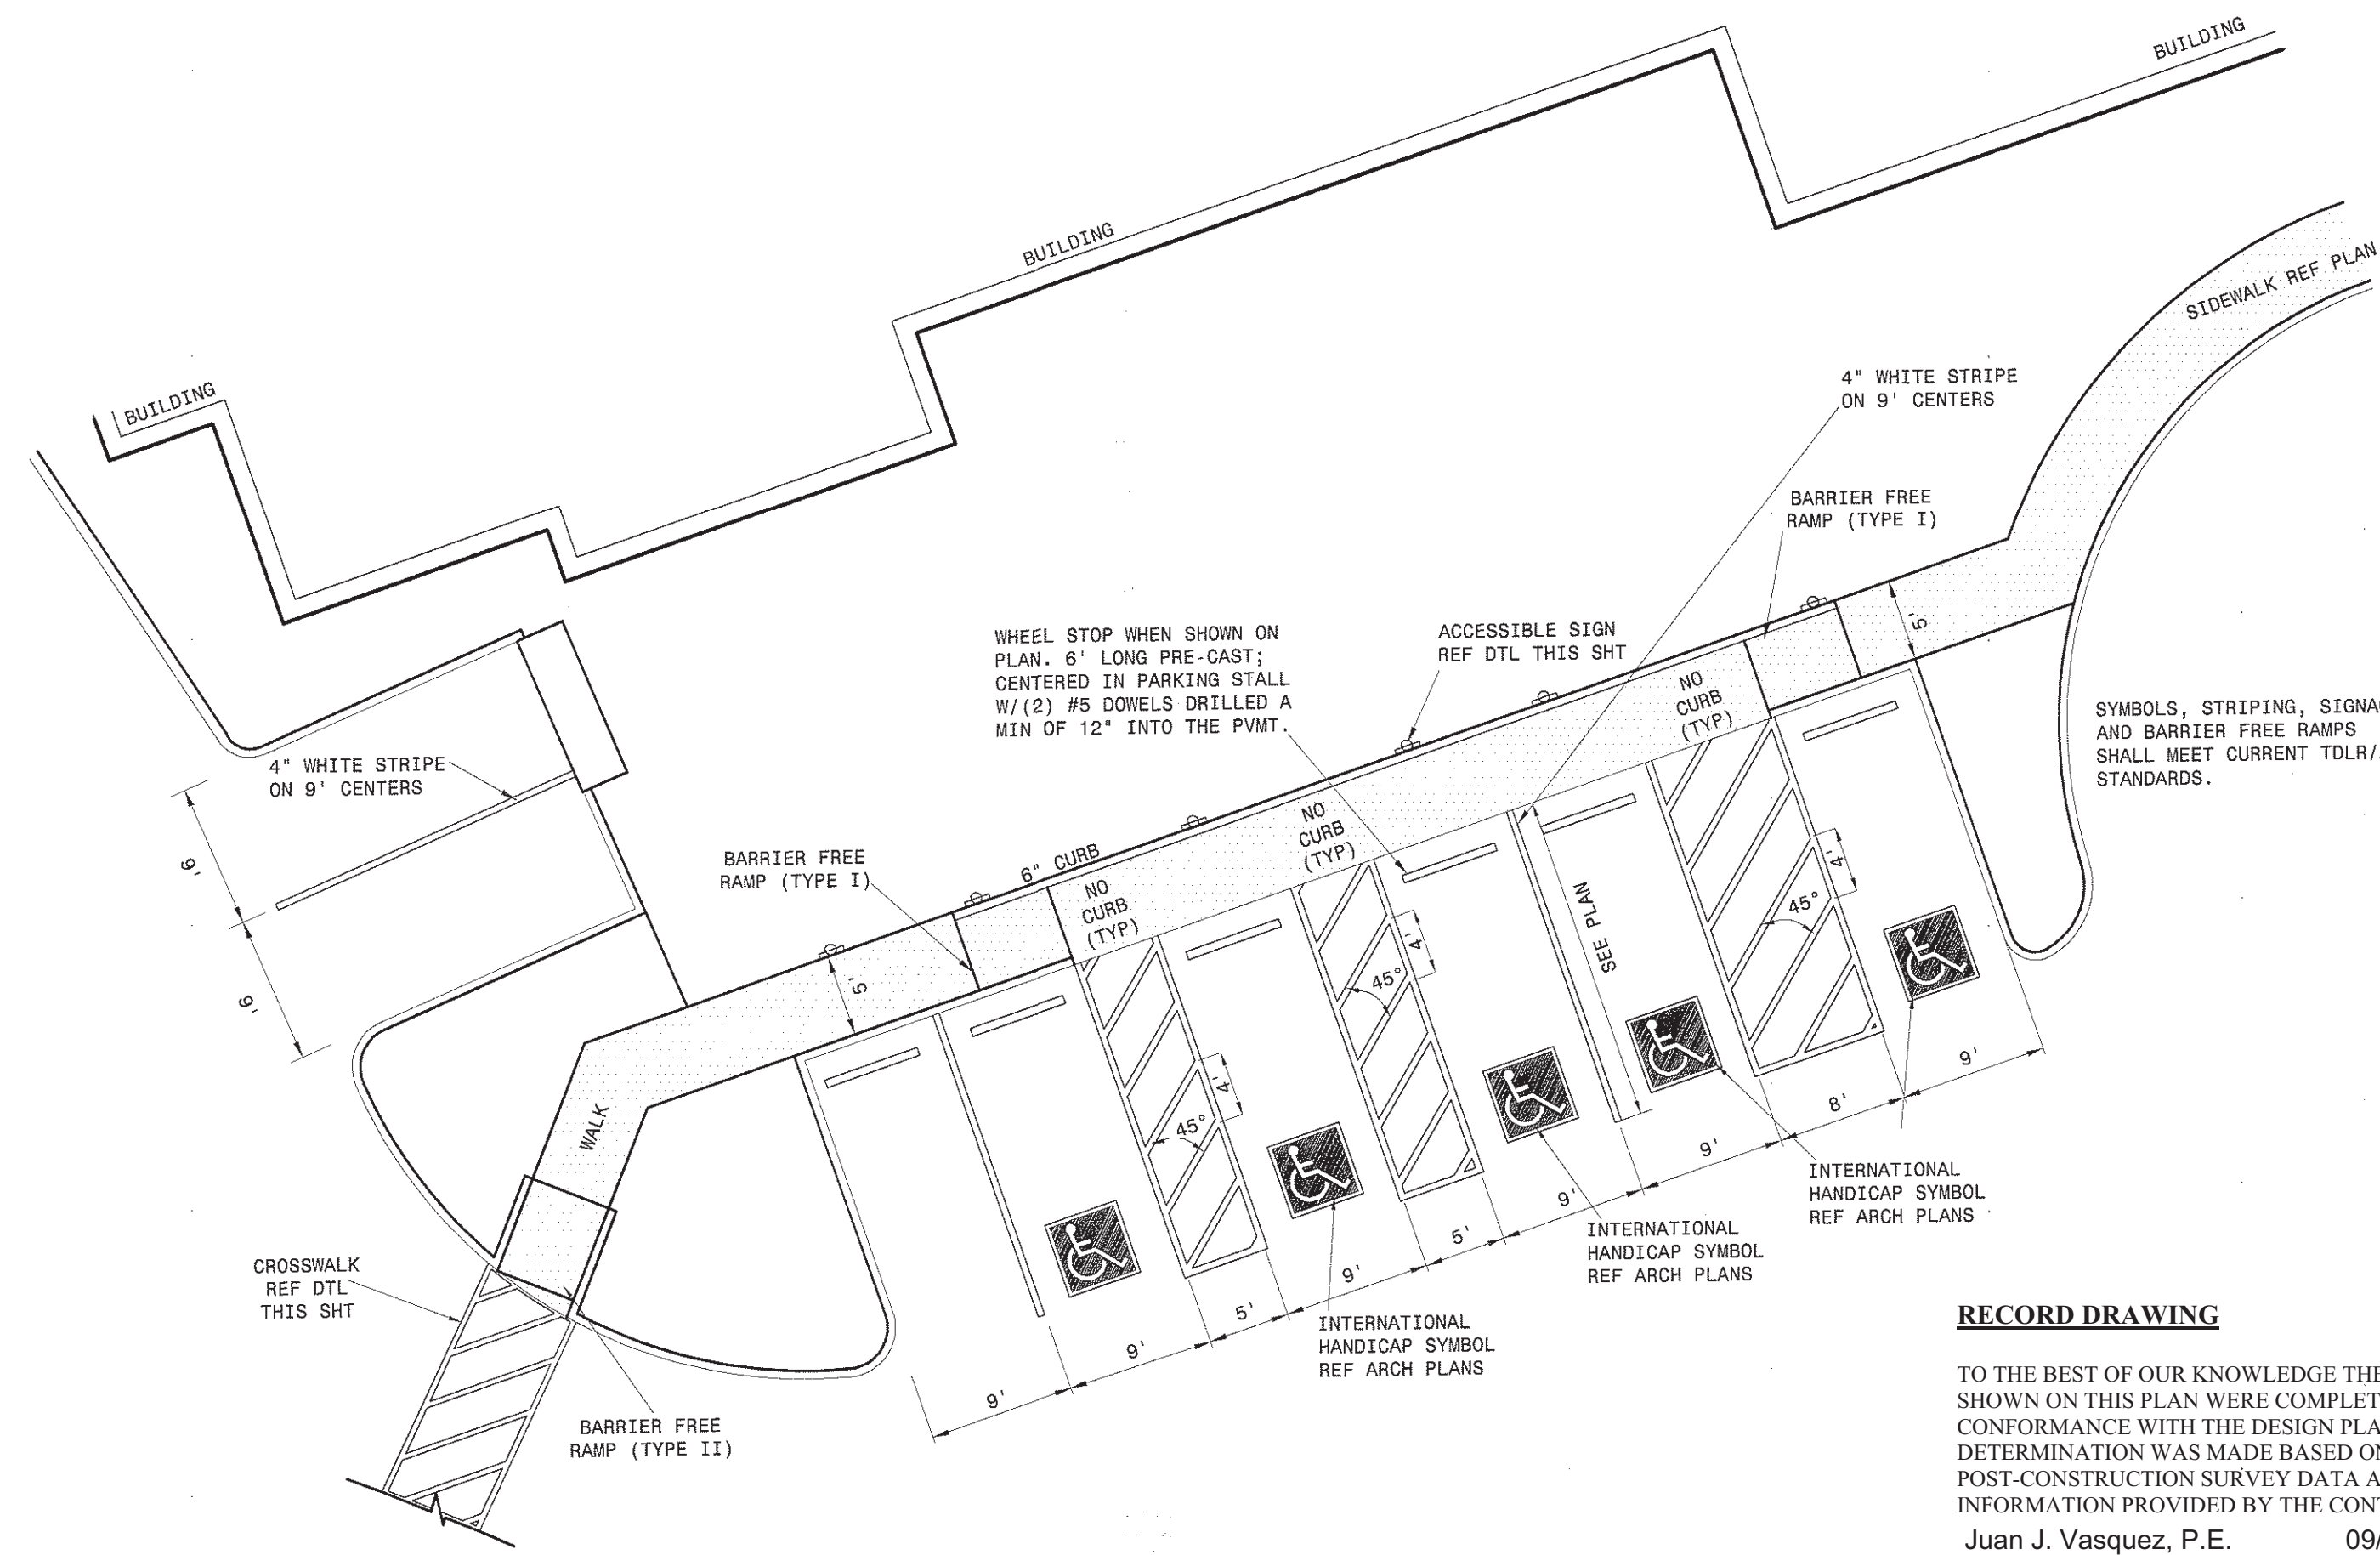


**ACCESSIBLE PARKING DETAIL (TYPICAL)**  
NTS

**RECORD DRAWING**

TO THE BEST OF OUR KNOWLEDGE THE IMPROVEMENTS SHOWN ON THIS PLAN WERE COMPLETED IN GENERAL CONFORMANCE WITH THE DESIGN PLANS. THIS DETERMINATION WAS MADE BASED ON POST-CONSTRUCTION SURVEY DATA AND INFORMATION PROVIDED BY THE CONTRACTOR  
 Juan J. Vasquez, P.E. 09/04/2020  
 SIGNED DATE

VASQUEZ ENGINEERING, LLC  
 TEXAS REG. F-12266

**VASQUEZ ENGINEERING, L.L.C.**  
 1919 S. Shiloh Road  
 Suite 440, LB 44  
 Garland, Texas 75042  
 Ph: 972-278-2948  
 TX Registration # F-12266

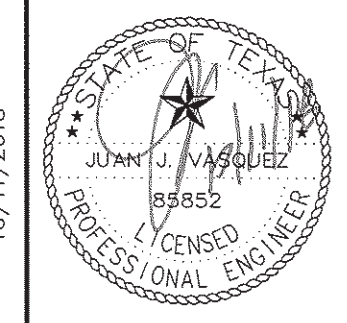

THE SEAL APPEARING ON THIS DOCUMENT WAS AUTHORIZED BY JUAN J. VASQUEZ, P.E. ON 10/11/2018

**DEVELOPER:**  
 ROCKWALL INN KEEPERS I, LTD.  
 6176 FM 2011  
 LONGVIEW, TX 75603



**DETAILS & GENERAL NOTES**  
 LOT 18, BLOCK A  
 LA JOLLA POINTE ADDITION  
 ROCKWALL, TEXAS

Scale:	AS NOTED
Designed by:	JJV
Drawn by:	JJV
Checked by:	JJV
Date:	10/11/2018

SHEET  
**C8**



DISCLAIMER: The use of this standard is governed by the "Texas Engineering Practice Act". No warranty of any kind is made by TxDOT for any purpose whatsoever. TxDOT assumes no responsibility for the consequences of the use of this standard to other formats or for incorrect results or damages resulting from its use.

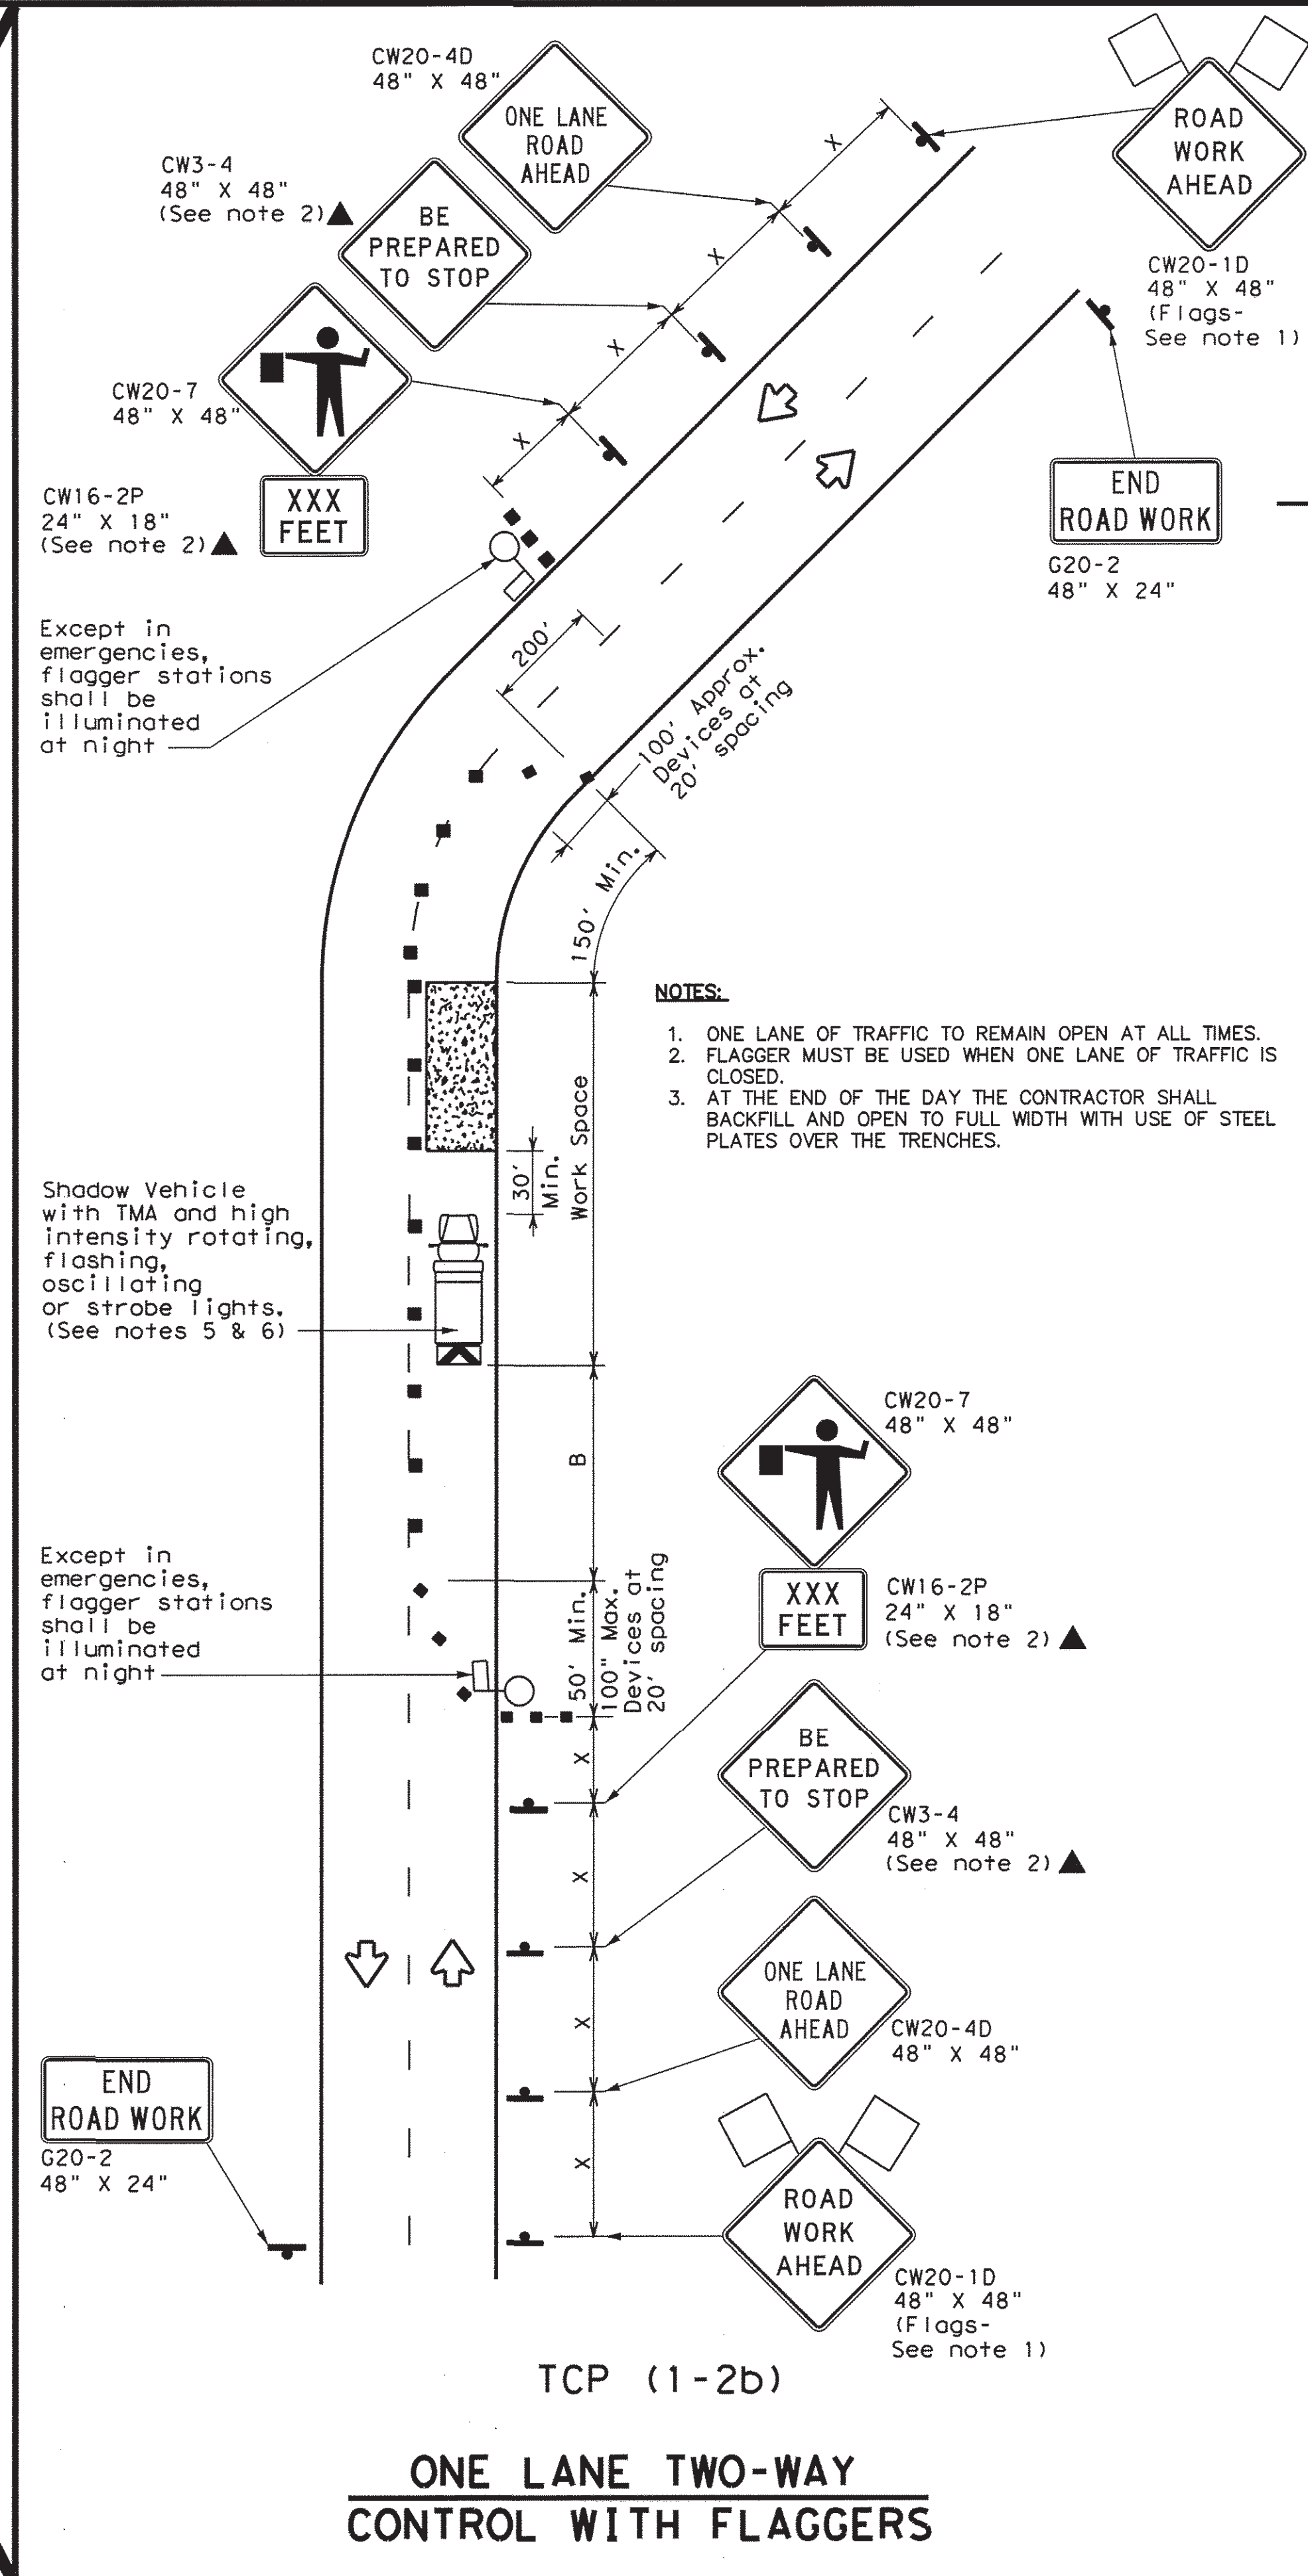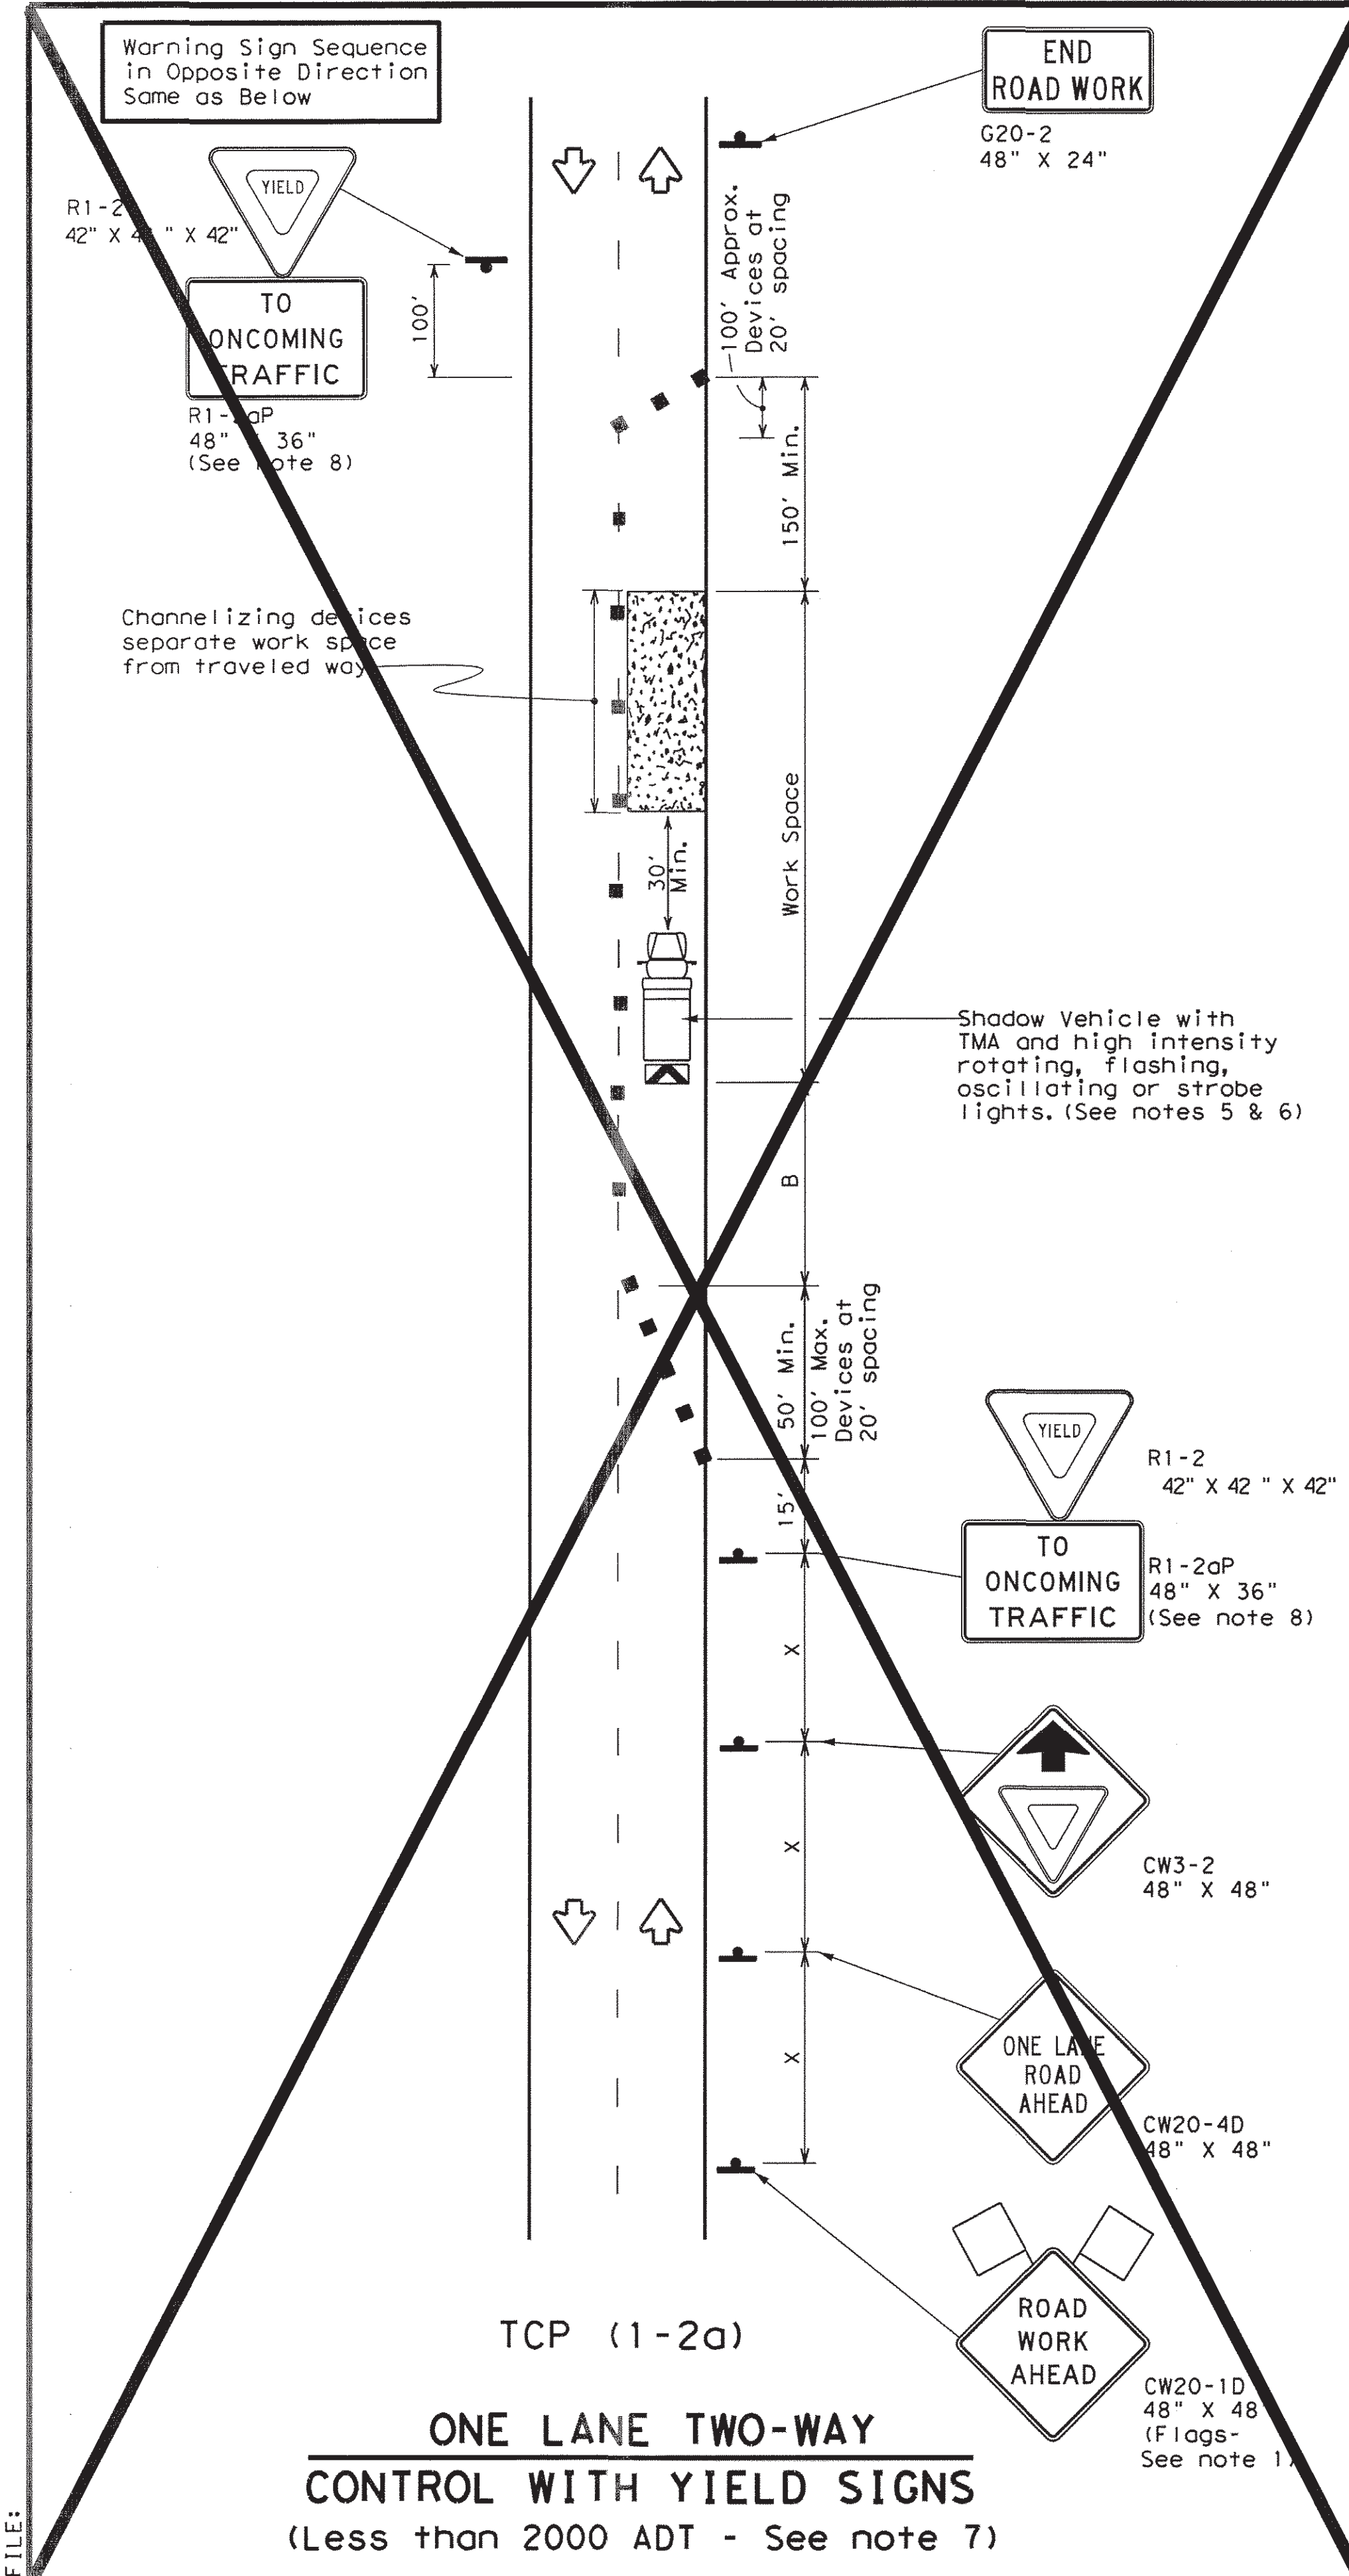

**LEGEND**

	Type 3 Barricade		Channelizing Devices
	Heavy Work Vehicle		Truck Mounted Attenuator (TMA)
	Trailer Mounted Flashing Arrow Board		Portable Changeable Message Sign (PCMS)
	Sign		Traffic Flow
	Flag		Flagger

Posted Speed * *	Formula L = WS <sup>2</sup> / 60	Minimum Desirable Taper Lengths **			Suggested Maximum Spacing of Channelizing Devices		Minimum Sign Spacing "x" Distance	Suggested Longitudinal Buffer Space "B"	Stopping Sight Distance
		10' Offset	11' Offset	12' Offset	On a Taper	On a Tangent			
30	L = WS <sup>2</sup> / 60	150'	165'	180'	30'	60'	120'	90'	200'
35		205'	225'	245'	35'	70'	160'	120'	250'
40		265'	295'	320'	40'	80'	240'	155'	305'
45	L = WS	450'	495'	540'	45'	90'	320'	195'	360'
50		500'	550'	600'	50'	100'	400'	240'	425'
55		550'	605'	660'	55'	110'	500'	295'	495'
60		600'	660'	720'	60'	120'	600'	350'	570'
65		650'	715'	780'	65'	130'	700'	410'	645'
70		700'	770'	840'	70'	140'	800'	475'	730'
75		750'	825'	900'	75'	150'	900'	540'	820'

\* Conventional Roads Only  
 \*\* Taper lengths have been rounded off.  
 L=Length of Taper (FT) W=Width of Offset (FT) S=Posted Speed (MPH)

**TYPICAL USAGE**

MOBILE	SHORT DURATION	SHORT TERM STATIONARY	INTERMEDIATE TERM STATIONARY	LONG TERM STATIONARY
	✓	✓		

- GENERAL NOTES**
- Flags attached to signs where shown are REQUIRED.
  - All traffic control devices illustrated are REQUIRED, except those denoted with the triangle symbol may be omitted when stated elsewhere in the plans, or for routine maintenance work, when approved by the Engineer.
  - The CW3-4 "BE PREPARED TO STOP" sign may be installed after the CW20-4D "ONE LANE ROAD AHEAD" sign, but proper sign spacing shall be maintained.
  - Sign spacing may be increased or an additional CW20-1D "ROAD WORK AHEAD" sign may be used if advance warning ahead of the flagger or R1-2 "YIELD" sign is less than 1500 feet.
  - A Shadow Vehicle with a TMA should be used anytime it can be positioned 30 to 100 feet in advance of the area of crew exposure without adversely affecting the performance or quality of the work. If workers are no longer present but road or work conditions require the traffic control to remain in place, Type 3 Barricades or other channelizing devices may be substituted for the Shadow Vehicle and TMA.
  - Additional Shadow Vehicles with TMAs may be positioned off the paved surface, next to those shown in order to protect wider work spaces.
- TCP (1-2a)**
- R1-2 "YIELD" sign traffic control may be used on projects with approaches that have adequate sight triangles. For projects in urban areas, work space should be no longer than one half city block. In rural areas on roads with less than 2000 ADT, work spaces should be no longer than 1/4 mile.
  - R1-2 "YIELD" sign and R1-2aP "TO ONCOMING TRAFFIC" plaque shall be placed on a support at a 10-foot minimum mounting height.
- TCP (1-2b)**
- Flaggers should use two-way radios or other methods of communication to control traffic.
  - Length of work space should be based on the ability of flaggers to communicate.
  - If the work space is located near a horizontal or vertical curve, the buffer distances should be increased in order to maintain adequate stopping sight distance to the flagger and a queue of stopped vehicles (see table above).
  - Channelizing devices on the center-line may be omitted when a pilot car is leading traffic and approved by the Engineer.
  - Flaggers should use 24" STOP/SLOW paddles to control traffic. Flags should be limited to emergency situations.

For construction or maintenance contract work, specific project requirements for shadow vehicles can be found in the project GENERAL NOTES for Item 502, Barricades, Signs and Traffic Handling.

Texas Department of Transportation  
Traffic Operations Division

**TRAFFIC CONTROL PLAN**  
**ONE-LANE TWO-WAY**  
**TRAFFIC CONTROL**

TCP (1-2)-12



© TxDOT December 1985

DESIGNED BY: JVV	DATE: 4-90	REVISED: 2-12
DRAWN BY: JVV	2-94	
CHECKED BY: JVV	1-97	
DATE: 4-98		

CONTRACT NO.	SHEET NO.
JOB	HIGHWAY
DIST	COUNTY
	SHEET NO.

THE SEAL APPEARING ON THIS DOCUMENT WAS AUTHORIZED BY JUN 3 10/17/2018

VASQUEZ ENGINEERING, L.L.C.  
1919 S. Shiloh Road  
Suite 440, LB 44  
Garland, Texas 75042  
Ph: 972-728-2948  
TX Registration # F-12266

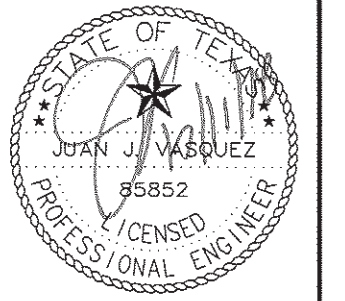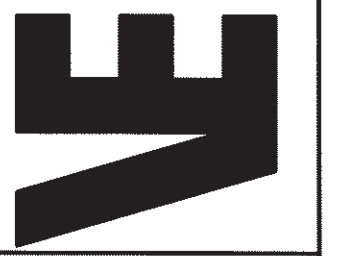

DEVELOPER:  
ROCKWALL INN KEEPERS I, LTD.  
6176 FM 2011  
LONGVIEW, TX 75603

TRAFFIC CONTROL PLAN  
LOT 1, BLOCK A  
HYATT ROCKWALL ADDITION  
ROCKWALL, TEXAS


Scale: NONE  
Designed by: JVV  
Drawn by: JVV  
Checked by: JVV  
Date: 10/11/2018

SHEET  
TP1







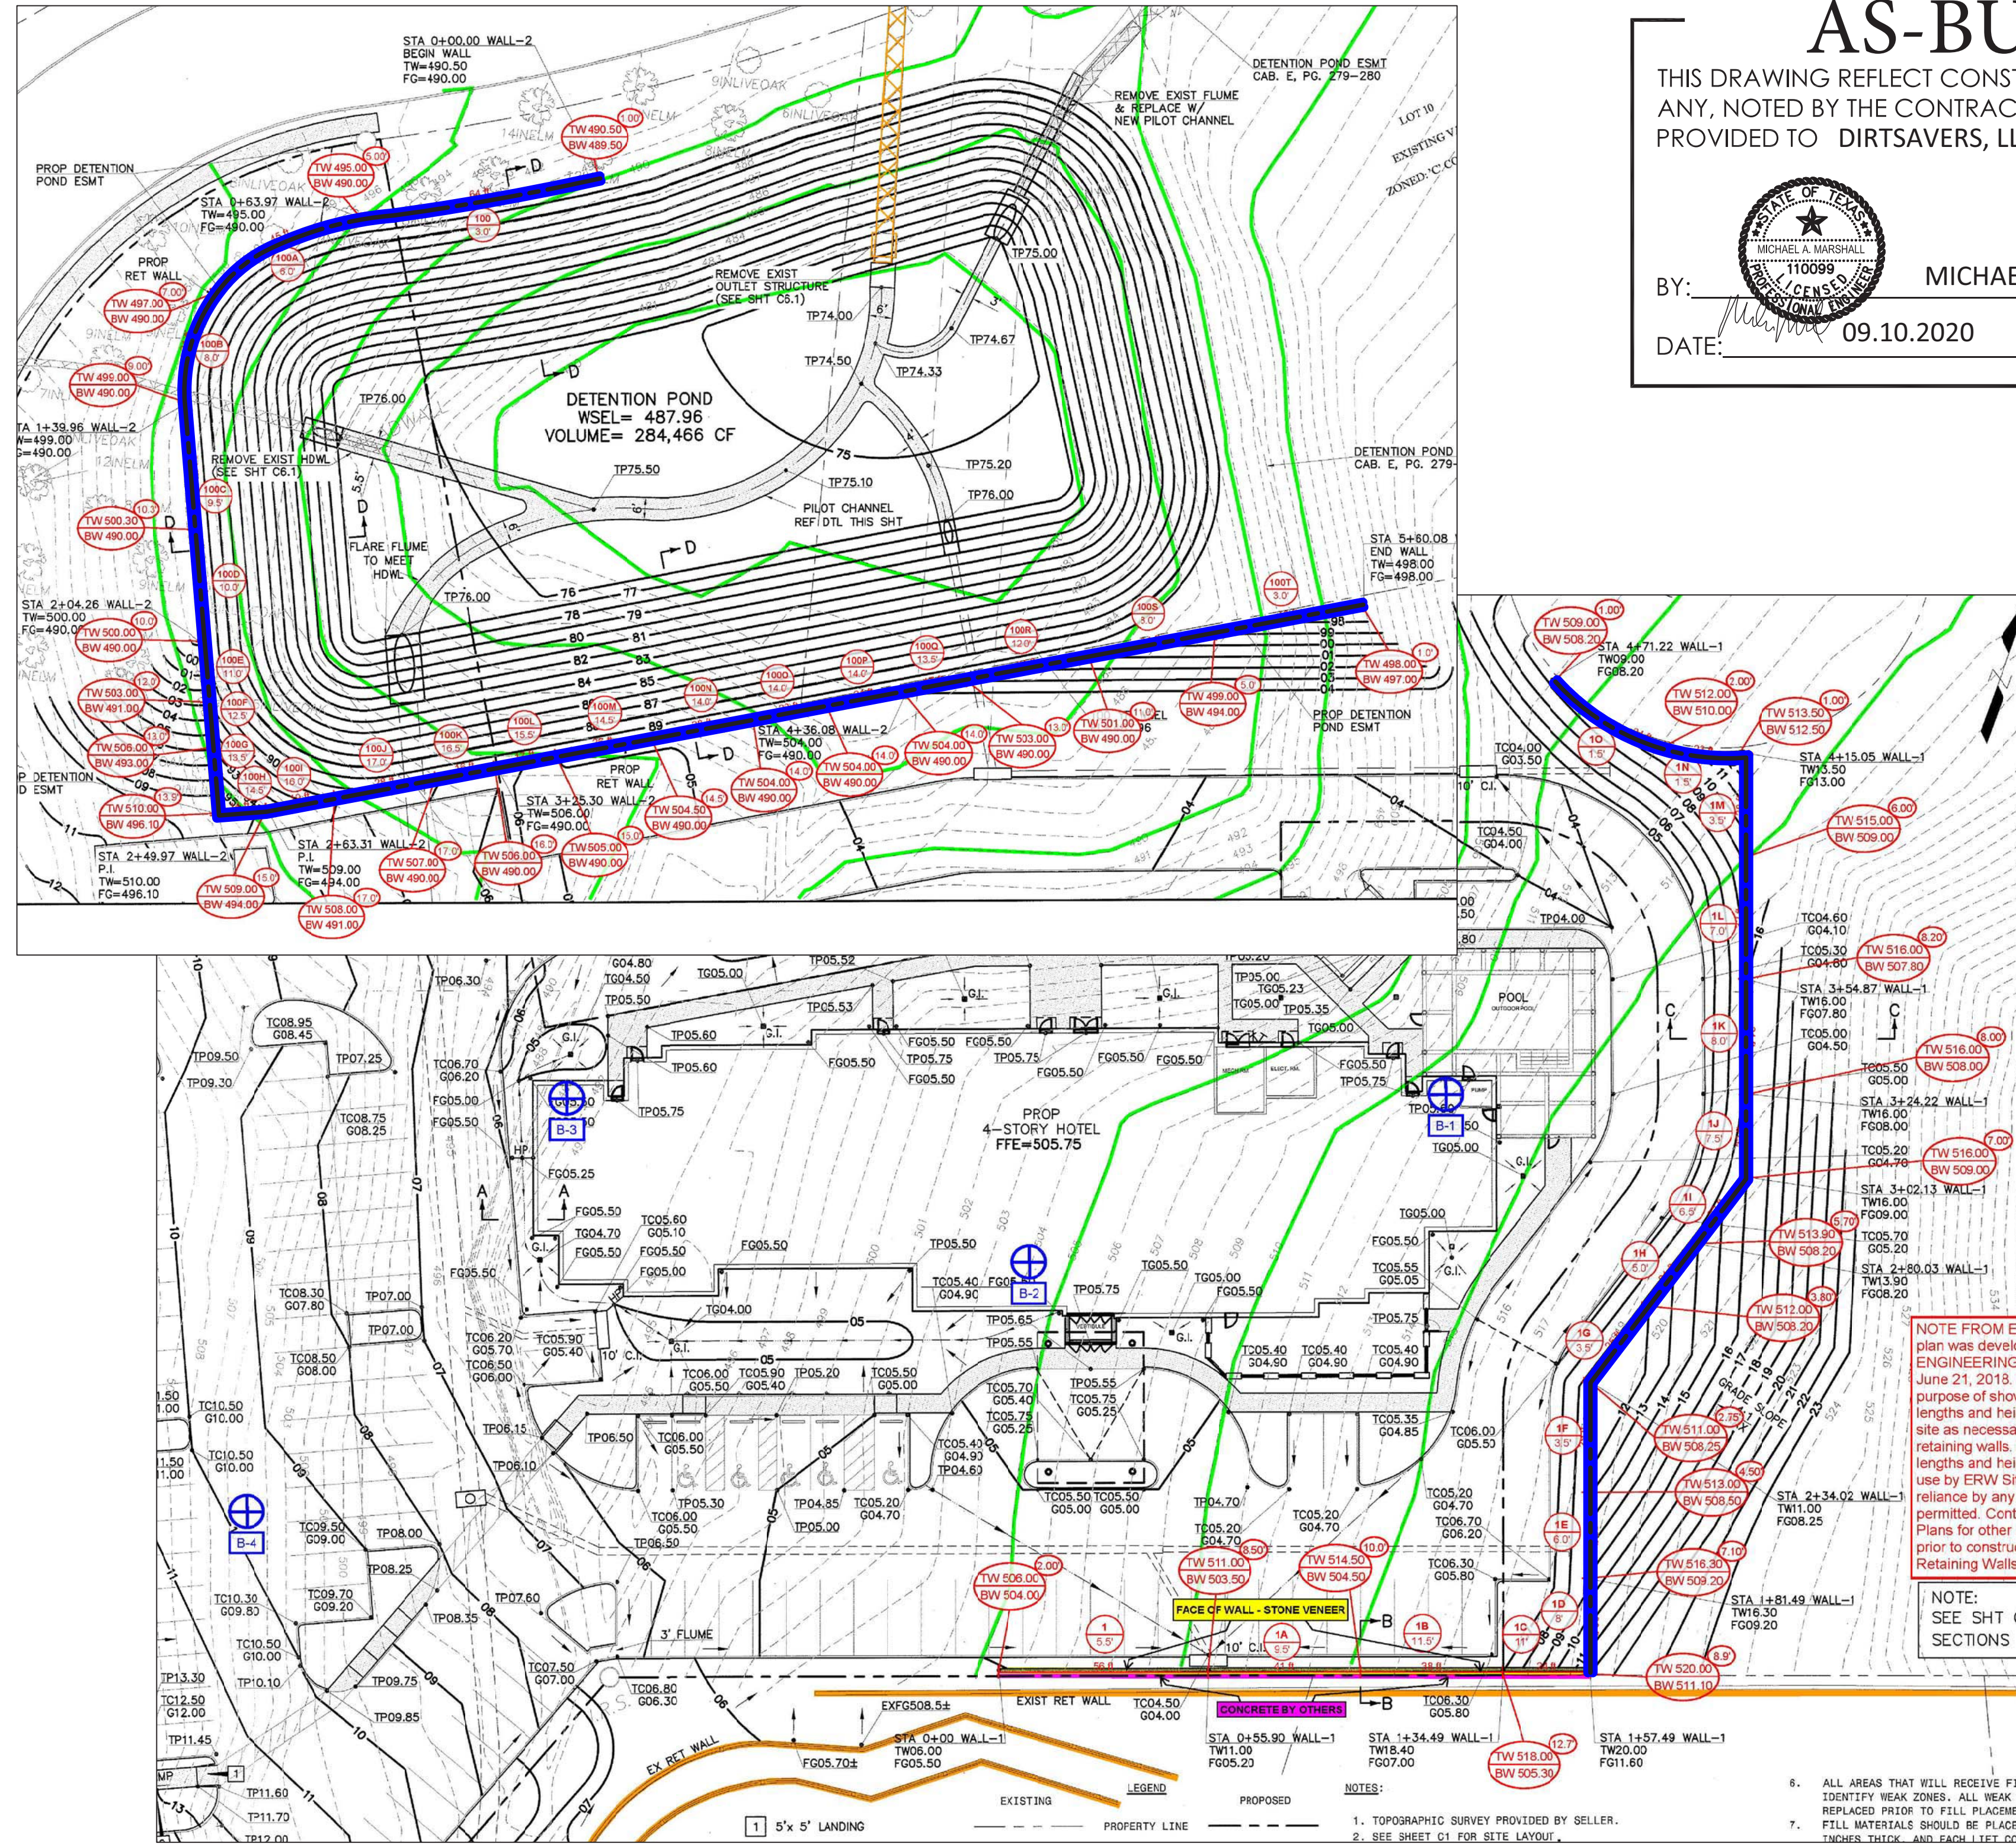


**AS-BUILT**

THIS DRAWING REFLECT CONSTRUCTION CHANGES IF ANY, NOTED BY THE CONTRACTOR OR OWNER AND PROVIDED TO DIRTSAVERS, LLC.

BY:  MICHAEL MARSHALL, P.E.


DATE: 09.10.2020

**DIRTSAVERS**  
 PO BOX 586  
 ALLEDO, TX 76008  
 PH: 469.834.7446  
 F-14138

**HYATT PLACE ROCKWALL**  
 MASONRY RETAINING WALLS  
 ROCKWALL, TX

**ERW SITE SOLUTION**  
 FORT WORTH, TEXAS  
 ERW JOB NO. 18-0642

No.	Date	Item

  
 MICHAEL A. MARSHALL  
 110089  
 LICENSED PROFESSIONAL ENGINEER  
 09.13.2018


RETAINING WALL  
 DETAILS AND NOTES

Project No. RW091318-1  
 Date 09.13.2018  
 Last Revision 09.13.2018

**RW2**

**RW2/1 MASONRY WALL SITE PLAN**  
 SCALE: N.T.S.



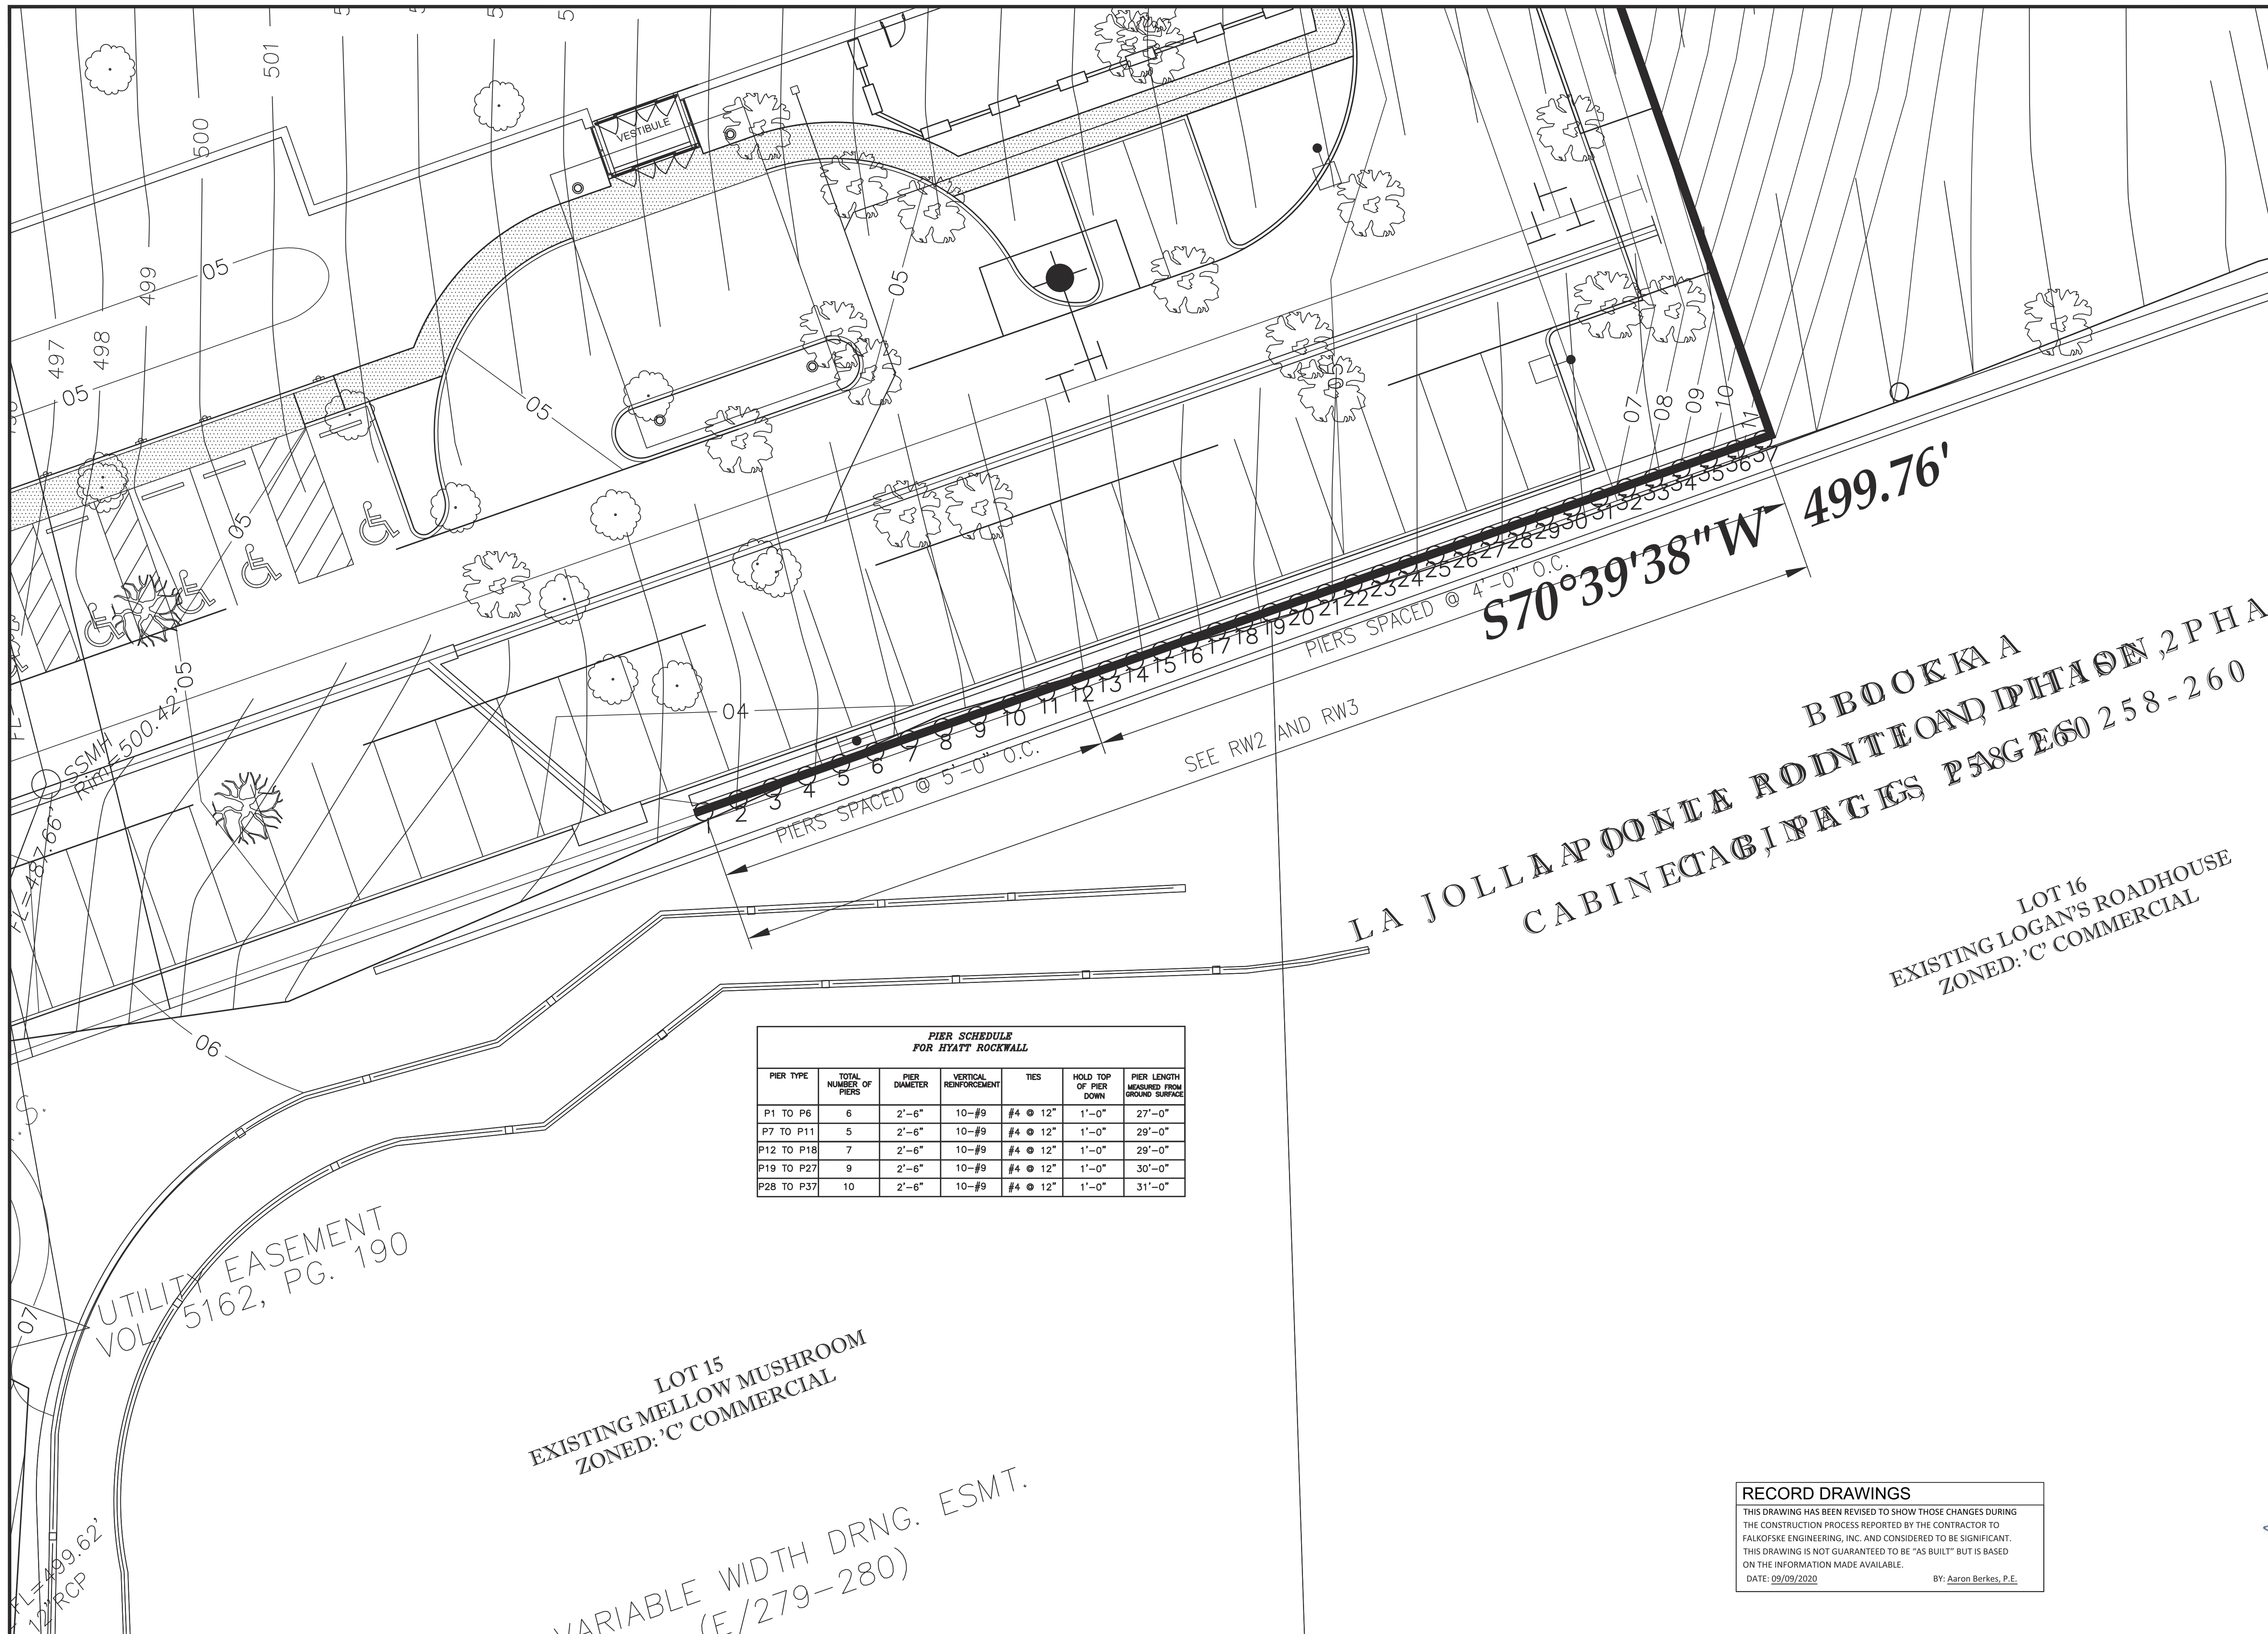

**PIER SCHEDULE  
FOR HYATT ROCKWALL**

PIER TYPE	TOTAL NUMBER OF PIERS	PIER DIAMETER	VERTICAL REINFORCEMENT	TIES	HOLD TOP OF PIER DOWN	PIER LENGTH MEASURED FROM GROUND SURFACE
P1 TO P6	6	2'-6"	10-#9	#4 @ 12"	1'-0"	27'-0"
P7 TO P11	5	2'-6"	10-#9	#4 @ 12"	1'-0"	29'-0"
P12 TO P18	7	2'-6"	10-#9	#4 @ 12"	1'-0"	29'-0"
P19 TO P27	9	2'-6"	10-#9	#4 @ 12"	1'-0"	30'-0"
P28 TO P37	10	2'-6"	10-#9	#4 @ 12"	1'-0"	31'-0"


**RECORD DRAWINGS**  
 THIS DRAWING HAS BEEN REVISED TO SHOW THOSE CHANGES DURING THE CONSTRUCTION PROCESS REPORTED BY THE CONTRACTOR TO FALKOFSKE ENGINEERING, INC. AND CONSIDERED TO BE SIGNIFICANT. THIS DRAWING IS NOT GUARANTEED TO BE "AS BUILT" BUT IS BASED ON THE INFORMATION MADE AVAILABLE.  
 DATE: 09/09/2020 BY: Aaron Berkes, P.E.

DATE	BY	NO.	DATE	REVISION	BY
03-05-20	AMB				
03-08-20	EG				
03-08-20	AMB				

Falkofske Engineering, Inc.  
 Structural Engineering Consultants  
 TX Reg. Engineering Firm F-4038  
 722 North Fieldier Road  
 Arlington, Texas 76012  
 (817) 261-8300

The use of these plans and specifications shall be restricted to the project for which they were prepared. Any use for other projects, in whole or in part, is prohibited. The user of these plans and specifications shall be responsible for obtaining all necessary permits and approvals. Falkofske Engineering, Inc. is not responsible for any errors or omissions on these plans and specifications.

SITE PLAN - PIER LOCATIONS  
 HYATT ROCKWALL  
 LA JOLLA POINTE DRIVE AND LAGUNA DRIVE  
 ROCKWALL, TEXAS  
 ROCKWALL INNKEEPERS I, LTD  
 6176 FM 2011  
 LONGVIEW, TEXAS 75603

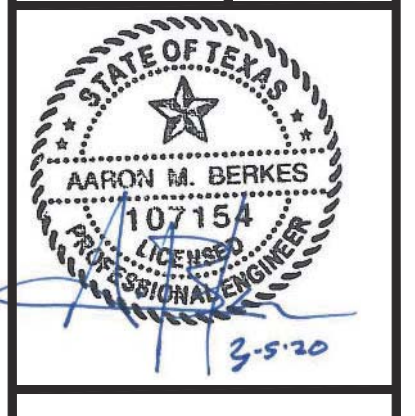


JOB NO. 122.19  
 SP1



1  
RW1


WALL SECTION W/HANDRAIL POST  
CONTRACTOR OPTION

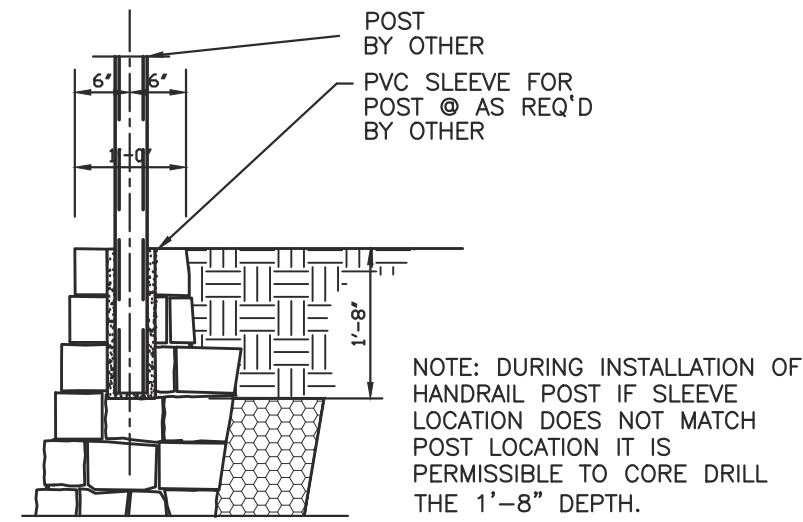

N.T.S.

2  
RW1


TYPICAL PLAN VIEW AT BASE

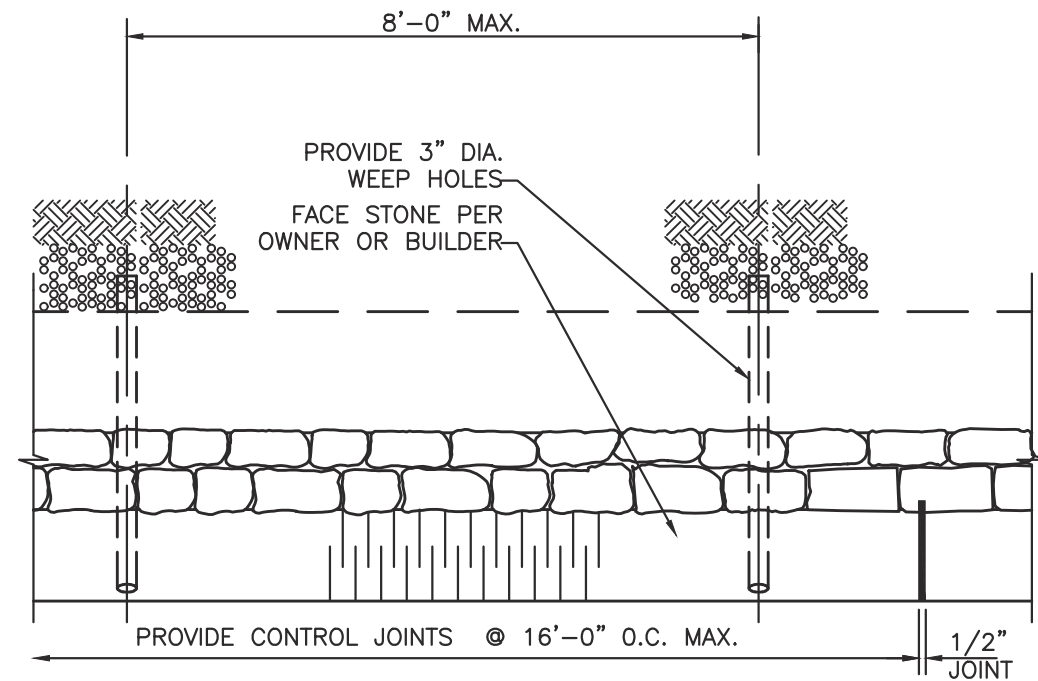

N.T.S.

3  
RW1

TYPICAL PLAN VIEW AT CORNERS

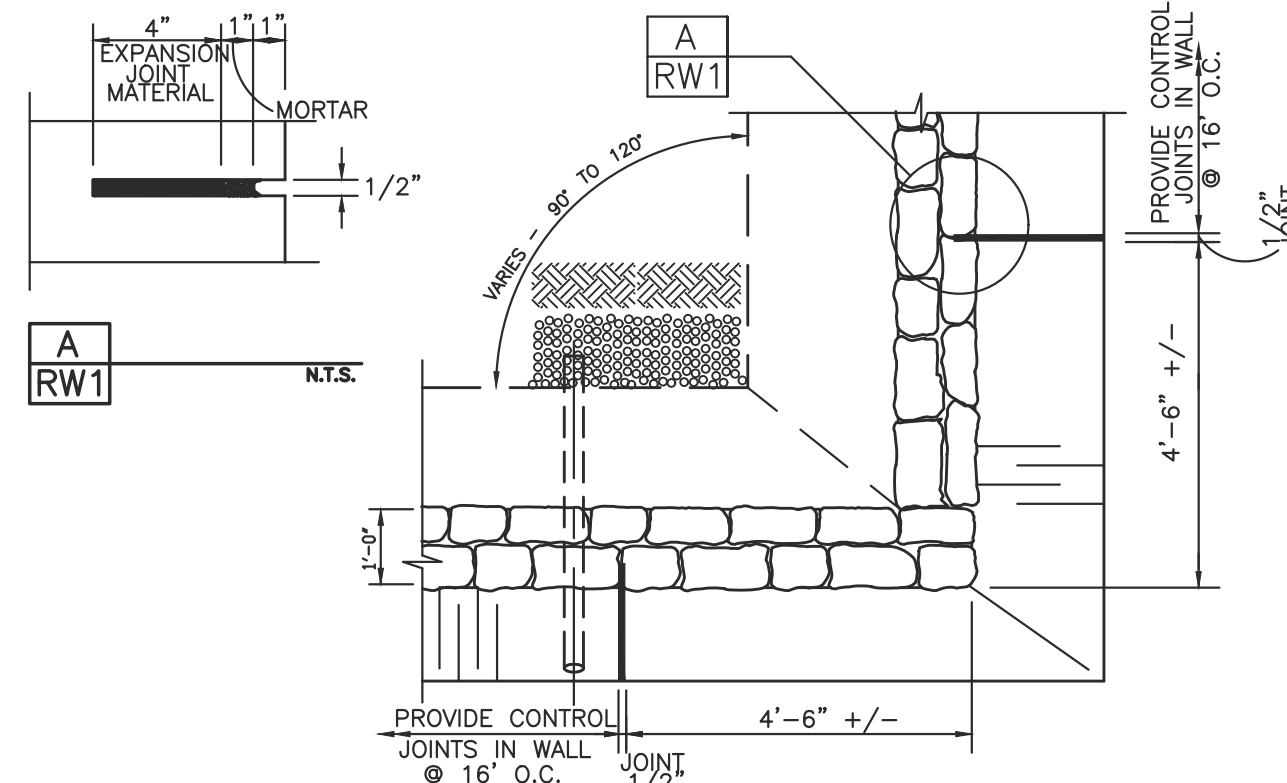

N.T.S.

**RECORD DRAWINGS**

THIS DRAWING HAS BEEN REVISED TO SHOW THOSE CHANGES DURING THE CONSTRUCTION PROCESS REPORTED BY THE CONTRACTOR TO FALCOFSKE ENGINEERING, INC. AND CONSIDERED TO BE SIGNIFICANT. THIS DRAWING IS NOT GUARANTEED TO BE "AS BUILT" BUT IS BASED ON THE INFORMATION MADE AVAILABLE.

DATE: 09/09/2020

BY: Aaron Berkes, P.E.

**GENERAL NOTES**

**1. Design**

**1.1. Design Codes**

International Building Code, 2015 Edition

**1.2. Geotechnical Report**

Firm: Geoscience Engineering & Testing, Inc.  
Report No. 20-DG5014 Dated: February 20, 2020  
Allowable Bearing Capacity 1500 psf

**1.3. Design Parameters**

**Soil Parameters:**

Soil Type*	Friction Angle	Cohesion (psf)	Unit Weight (pcf)
Retained Backfill (On site clay)	26 deg	0 psf	120 pcf
Foundation Soils (1500 psf)	26 deg	0 psf	120 pcf

\*See materials below for a description of each Soil Type.

**Factors of Safety:**

- a. Minimum Factor of Safety Against Base Sliding (Static Condition) 1.5
- b. Minimum Factor of Safety Against Overturning 2.0
- c. Minimum Factor of Safety Against Global Stability 1.5
- d. Minimum Factor of Safety for Bearing Capacity 3.0

**Design Loading:**

Lateral earth pressures are calculated using Coulombs Lateral Earth Pressure Theory. Designs have been performed to accept loading per the proposed loading conditions based on the Civil Grading Plans. A live loading of 250 psf has been used for all walls supporting areas subject to firelane loading.

Retaining walls should not have solid fence (such as wood fence) placed on top of wall other than that shown on these plans. Retaining walls shall not have slope at base or top of wall that exceed that which is shown on these plans. The retaining walls noted above require special design.

**2. Materials**

**2.1. Soil Types**

- a. Retained Backfill
  - a.a. On site clayey soils
  - a.b. Properly compacted on-site fill soils, verification by others.
  - a.c. Free draining granular backfill, clean, non-plastic, relatively well-graded.
- b. Foundation Soils ( Allowable Bearing = 1500 psf min)
  - b.a. Bearing on Stiff Natural Undisturbed Clayey or Sandy Soils or Compacted and Tested Fill Soils
  - b.b. Friction Angle between Base of Wall and Soil - 17 deg
  - b.c. Bearing in fill soils. Fill soils supporting the retaining walls shall be placed in accordance with the recommendations for the fill placement per the geotechnical report.
- c. Drainage Material
  - c.a. Free draining granular backfill, clean, non-plastic, relatively well-graded.

**2.2. Dimension Stone**

- a. Average Density of masonry wall varies from 135pcf to 145pcf.
- b. Stone size varies from 4" to 18"
- c. Face stone shall be coordinated between contractor and owner/developer.
- d. Recycled concrete 4" to 18" may be used in place of dimension stone, contractors option.

**2.3. Rebar/Welded Wire Fabric (If Required)**

- a. All steel reinforcement shall be new billet steel conforming to ASTM A-615, Grade 60 with fy=60ksi.
- b. All reinforcement shall not have deleterious material on it.
- c. All welded wire fabric shall have minimum fy=65ksi and be hot dip galvanized.

**2.4. Drainage Materials**

- a. Weep pipes shall be PVC or corrugated HDPE pipe.
- b. Drainage zone shall be separated from retained backfill by mirafil 140N filter fabric or approved equal.

**2.5 Portland Cement Mortar for Retaining Wall Construction.**

The portland cement mortar used for construction of the masonry stone retaining walls shall be provided with the following proportions per cubic yard of concrete. The portland cement mortar supplier shall provide "batch tickets" clearly indicating that the appropriate amount of materials are provided in each truck load. The batch tickets shall clearly indicate the amount batched, the date, the project name and shall be provided to Falkofske Engineering, Inc. for review, documentation, and file.

Contents	Amount per cubic yard	Specific Gravity	Volume ft <sup>3</sup>
Type 1 Portland cement:	414 lbs	3.15	2.11
Type F Fly Ash	103 lbs	2.93	0.56
Fine Aggregate (sand):	2753 lbs	2.59	17.03
Potable Water	430.01 lbs	51.56 Gallons	6.89
Sika Air (or equivalent)	As Required (oz)	1.5%	0.41
			27.0 Total

Note: the portland cement mortar supplier material weights may vary slightly based on the specific gravity of the materials used.

Concrete retarders may be used at the discretion of the masonry wall contractor. A greater amount of retarder is typically used during hot periods and a less amount of retarder is typically used during cool weather.

Please note that the above proportions will provide a portland cement mortar with a compressive strength of about fc = 2500 psi. Falkofske Engineering, Inc. does not require any concrete testing provided the above proportions are verified by way of the "batch tickets".

**3. Construction**

**3.1 Preparation Work**

- a. Prior to grading or excavation of the site, confirm the location of the retaining walls and all underground features, including utility location within the area of construction. Ensure surrounding structures are protected from effects of wall excavation, and construction.
- b. Coordinate installation of underground utilities and other improvements with wall installation.

**3.2 Excavation**

- a. If a mortared footing is over-excavated, then the dimension stone shall be placed mortared. If a dry stone footing is over excavated, then the dimension stone does not need to be mortared.
- b. Fill over-excavated area in front of the wall footing with compacted on site soils before the wall construction exceeds 4 feet in height.
- c. In areas where the walls are installed in a cut, the required excavation shall extend horizontally to the extent of the width of the retaining wall. The wall may be built to the cut. If the wall is over cut, then soil shall either be compacted or the drainage zone may be widened.

**3.3 Wall Construction**

- a. The wall shall be constructed to the dimensions as shown on these plans. Front leads, back leads, and string lines shall be set for each wall. Care shall be taken to install the mortar zones the correct thickness, and to place drainage behind the wall as required.
- b. Control joints shall be installed at a maximum of 16'-0" o.c. per these plans.
- c. Weep pipes shall be placed at 8'-0" o.c. max.
- d. Face rock type shall be coordinated between the architect, owner, and retaining wall contractor.

**3.4 Retained Backfill Placement**

- a. Retained backfill shall be placed per the recommendations of the geotechnical engineer, but should not be less than 93% Standard Proctor Maximum Dry Density (ASTM D698).
- b. Fill should be placed in maximum 8" thick compacted lifts.
- c. Large compaction equipment (equipment heavier than 7,500 lb) shall remain a minimum of 1.5x the height of the wall away from the back of the wall for a period of 2 weeks from the time of construction.
- d. After a period of 2 weeks from the time of construction large compaction equipment may be used behind the wall but shall stay a minimum of 5'-0" away from the back of the wall.
- e. Soil placed with in 5'-0" of the back of the wall shall be placed using handheld compaction equipment.
- f. If the wall is in a cut situation the wall may be built up to the cut. If the wall is overcut the drainage zone may be widened to the cut or compacted fill may be placed between the drainage zone and the cut.

**3.6 Retaining Wall Performance, Maintenance, and Other Comments**

- a. Control joints are provided in the retaining wall to allow for minor movements due to settlement and shrink swell of the soils. Some cracking may occur in the face of the retaining wall. This cracking, if minor (less than 3/8"), may be cosmetically repaired as desired.
- b. The retaining walls are designed to allow surface water to flow over the tops of the retaining walls. Care should be taken during and after construction to not allow water to pond behind the retaining walls, as this can have a negative impact on the stability of the retaining walls.
- c. If downspouts are located near the back of the retaining wall they should either be plumbed through the retaining wall to drain below the wall or collected and tied into the storm sewer system. Perforated subsurface pipes shall not be used behind the retaining walls.
- d. Positive drainage over the top of the walls shall be maintained throughout the life of the structure. If swales are placed behind the wall they shall remain clean and free draining. If water is found to be ponding in the swale it shall be fixed to allow water to freely drain as soon as possible.
- e. Any broken sprinklers behind the retaining wall shall be turned off and repaired as soon as possible.

**3.7 Cold Weather Construction of Retaining Walls**

**Construction Requirements for temperatures between 40°F and 32°F:**

- a. Water and aggregates used in mortar shall not be heated above 140°F.
- b. Mortar sand or mixing water shall be heated to produce mortar temperatures between 40°F and 120°F at the time of mixing.

**Construction Requirements for temperatures between 32°F and 25°F:**

- a. The guidelines above for construction requirements for temperatures between 40°F and 32°F and the following shall be met.
- b. The mortar temperature shall be maintained above freezing until used in masonry stone retaining wall.
- c. Visible ice and snow shall be removed from the top surface of existing foundations and masonry to receive new construction. These surfaces shall be heated to above freezing, using methods that do not result in damage.
- d. Newly constructed masonry shall be completely covered with weather-resistive membrane for 48 hours after being completed.

**Construction Requirements for temperatures between 25°F and 20°F:**

- a. The guidelines above for construction requirements for temperatures between 40°F and 32°F, the construction guidelines for temperatures between 32°F and 25°F, and the following shall be met.
- b. Masonry (raw stone) surfaces under construction shall be heated to 40°F.
- c. Wind breaks or enclosures shall be provided when the wind velocity exceeds 15 miles per hour.
- d. Newly constructed masonry shall be completely covered with weather-resistive insulating blankets, or equal protection, for 48 hours after being completed.

The above procedures comes from sections 2104.3.2.1, 2104.3.2.2, 2104.3.2.3, 2104.3.3.3, and 2104.3.3.4 of the International Building Code, and is in compliance with Masonry Standards Joint Committee recommendations for cold weather construction of masonry structures.

**4. Concrete Mix Design for Piers:**

1. All concrete for piers shall have a minimum compressive strength of fc = 4000 psi at 28 days.
2. Provide a design slump of 7" to 9" for concrete placed in piers.
3. The use of workability admixtures and air entrainment in the concrete mix designs is permitted.
4. The use of calcium chloride admixtures in the concrete is not permitted.
5. Adding water to the concrete at the site is not permitted.
6. Hard rock aggregate maximum of 3/4" may be used in concrete placed in standard drilled piers. No hard rock aggregate is to be used in auger drilled cast in place piers.
7. Provide the concrete mix designs for the piers to Falkofske Engineering, Inc. for review prior to construction. Also provide recent (within the last 6 months) compressive test results of the mix designs for review by Falkofske Engineering, Inc.
8. Provide concrete test cylinders for every 50 yards of concrete placed, or for any concrete placed on any given day. Make 5 test cylinders, test one at 7 days, one at 14 days, two at 28 days, and hold the 5th cylinder in reserve for 56 days if necessary. Provide all concrete compressive test results to Falkofske Engineering, Inc. for final review.
9. Provide steel centerlines to center the steel in the pier hole, and use chairs to hold steel off the ground in the bottom of the pier hole.
10. Concrete may free fall during placement, as long as the concrete is centered in the pier and does not damage the steel cage.
11. Piers may be "Standard Drilled" or "Auger Cast In Place". See bulletpoint 6.

**Concrete Reinforcement:**

- 1. All concrete steel reinforcement shall be new billet steel conforming to ASTM A-615, Grade 60 with fy = 60 ksi. All reinforcement shall be free of rust and deleterious materials.

**5. Construction Reviews**

**Construction Reviews By Materials Testing Lab:**

1. The geotechnical engineer, shall be retained to perform pier drilling review. A pier drilling log shall be made for each pier indicating the depth through clay soils.
2. The pier drilling logs shall note that the piers holes are clean prior to placing the steel reinforcement cage.
3. The size, number, and grade of the reinforcement placed in the pier hole shall be verified by the testing lab and so noted on the pier drilling logs.

**6. Construction Observations**

**4.1 Construction Observations by Falkofske Engineering, Inc.**

- a. Falkofske Engineering, Inc. will perform construction observation, but only as a means of verification of the contractors quality control performance.
- b. Falkofske Engineering, Inc. will act as the Special Inspector for this project. Contractor shall contact Falkofske Engineering to set up inspections, at least 1 day before construction starts.
- c. All required materials testing shall be performed by an approved materials testing laboratory.
- d. Falkofske Engineering, inc. is not responsible for means, methods, and material furnished by the retaining wall contractor.

**4.2 Construction Observations by Others**


- a. Construction observations as required by the city shall be coordinated by the contractor.

DATE	BY	NO.	DATE	REVISION	BY
03-05-20	AMB				
03-05-20	EG				
03-05-20	AMB				

Falkofske Engineering, Inc.  
Structural Engineering Consultants  
TX Reg. Engineering Firm F-4038  
722 North Fielder Road  
Arlington, Texas 76012  
(817) 261-8300

The use of these plans and specifications shall be restricted to the project for which they were prepared. Any other use, without the express written consent of Falkofske Engineering, Inc. is prohibited. This prohibition shall extend to all reproductions, in whole or in part, of these plans and specifications. Falkofske Engineering, Inc. does not warrant the accuracy of the information contained herein.


MASONRY RETAINING WALLS - NOTES & STANDARD DETAILS  
HYATT ROCKWALL  
LA JOLLA POINTE DRIVE AND LAGUNA DRIVE  
ROCKWALL, TEXAS  
ROCKWALL INKKEEPERS I, LTD  
6176 FM 2011  
LONGVIEW, TEXAS 75603

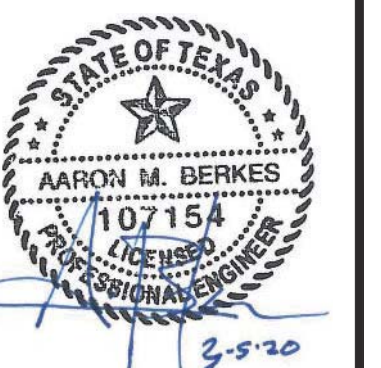


JOB NO. 122.19

RW1




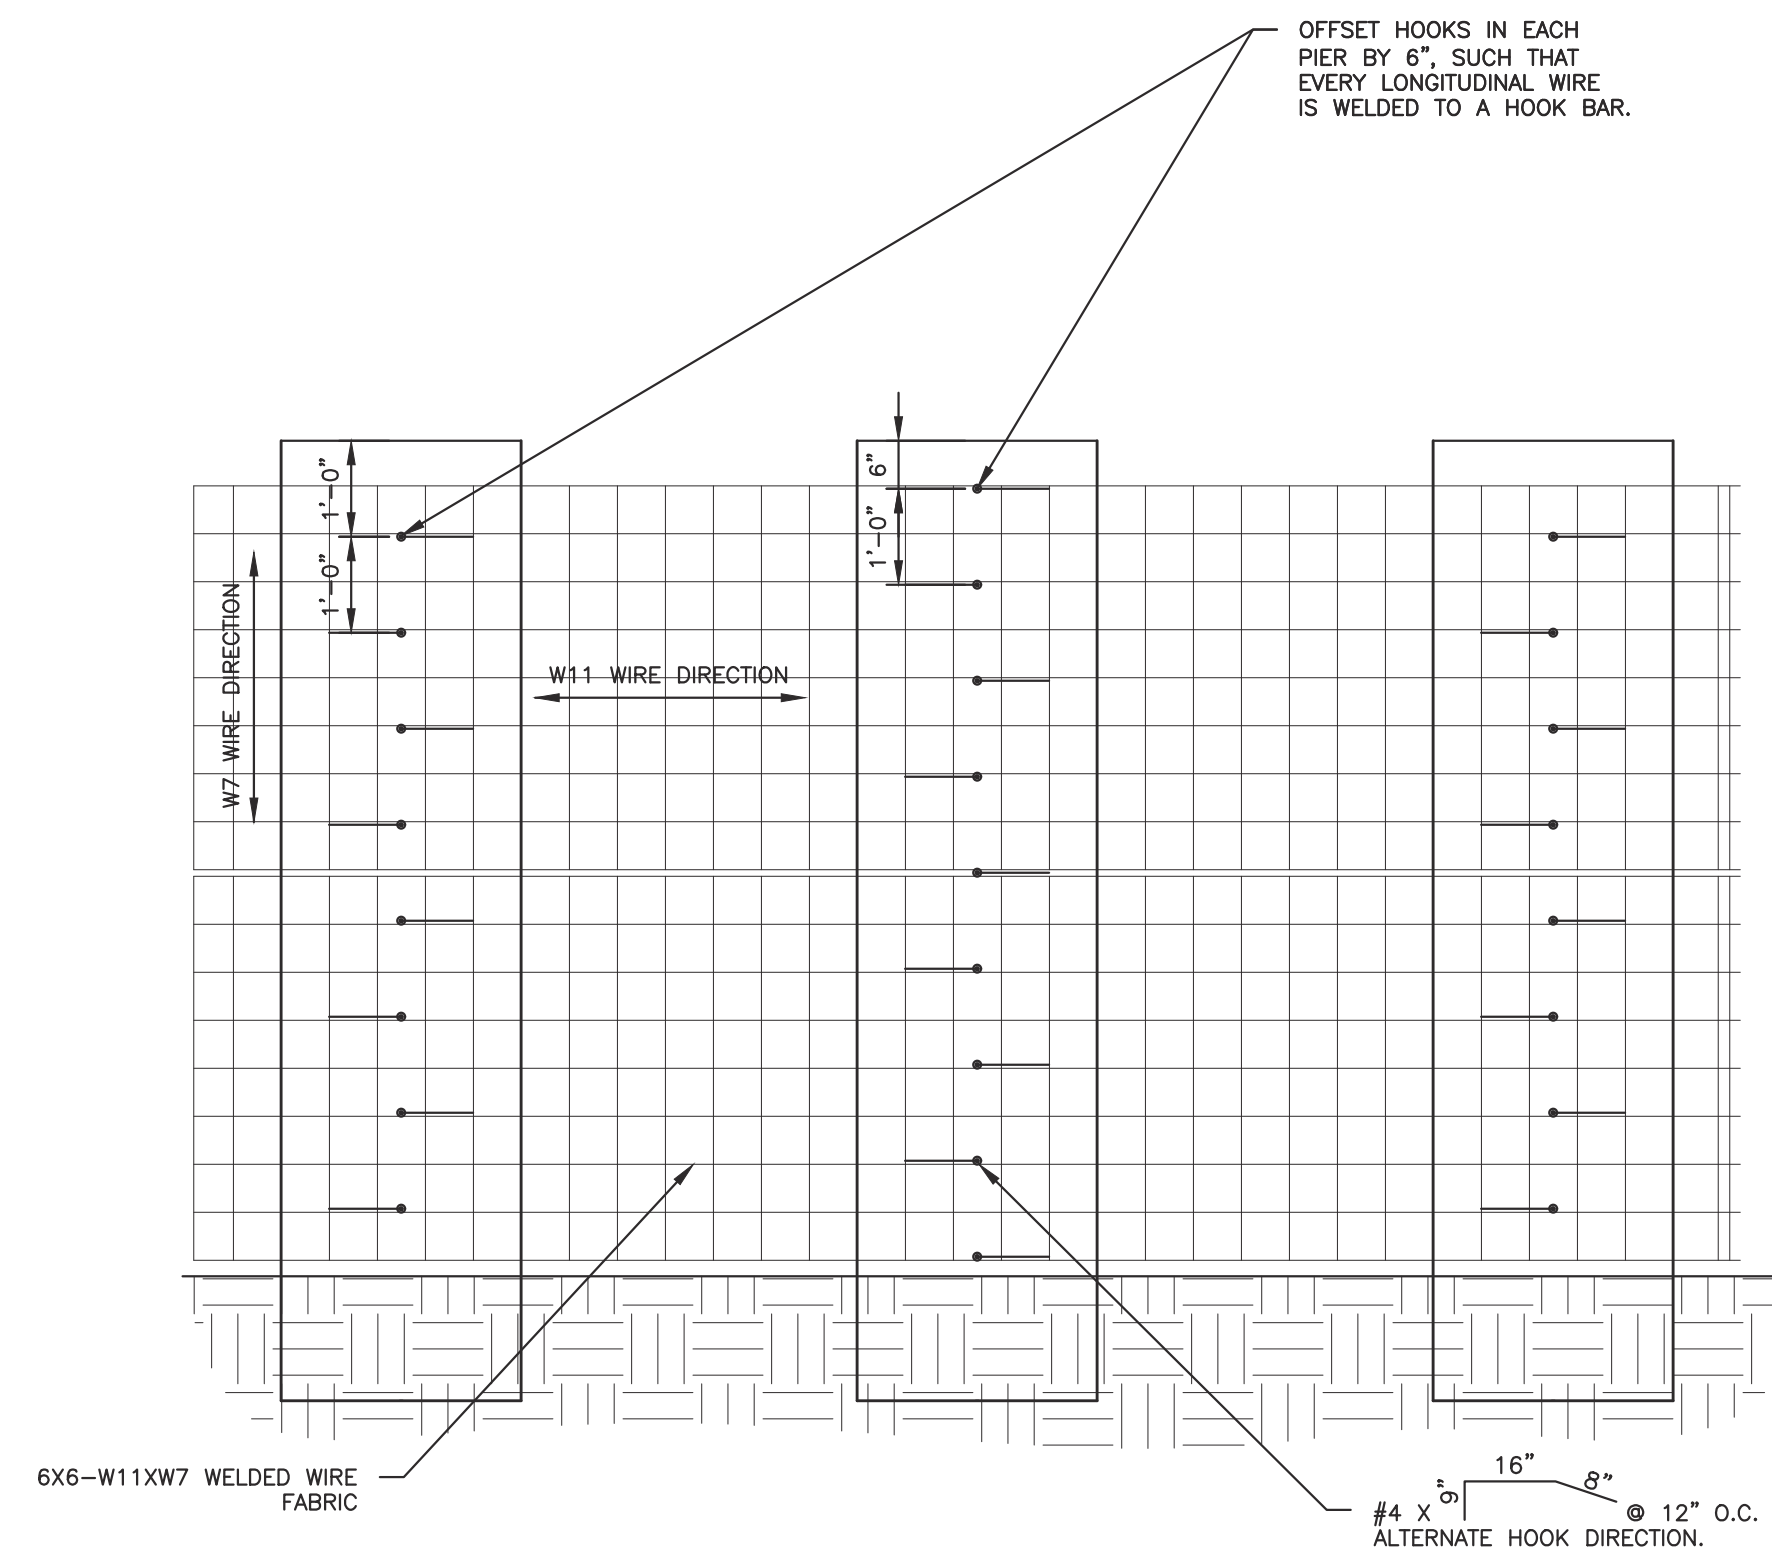


2  
RW2 ELEVATION OF SOLDIER PIER WALL BEFORE STONE FACING IS PLACED 1/2" = 1'-0"

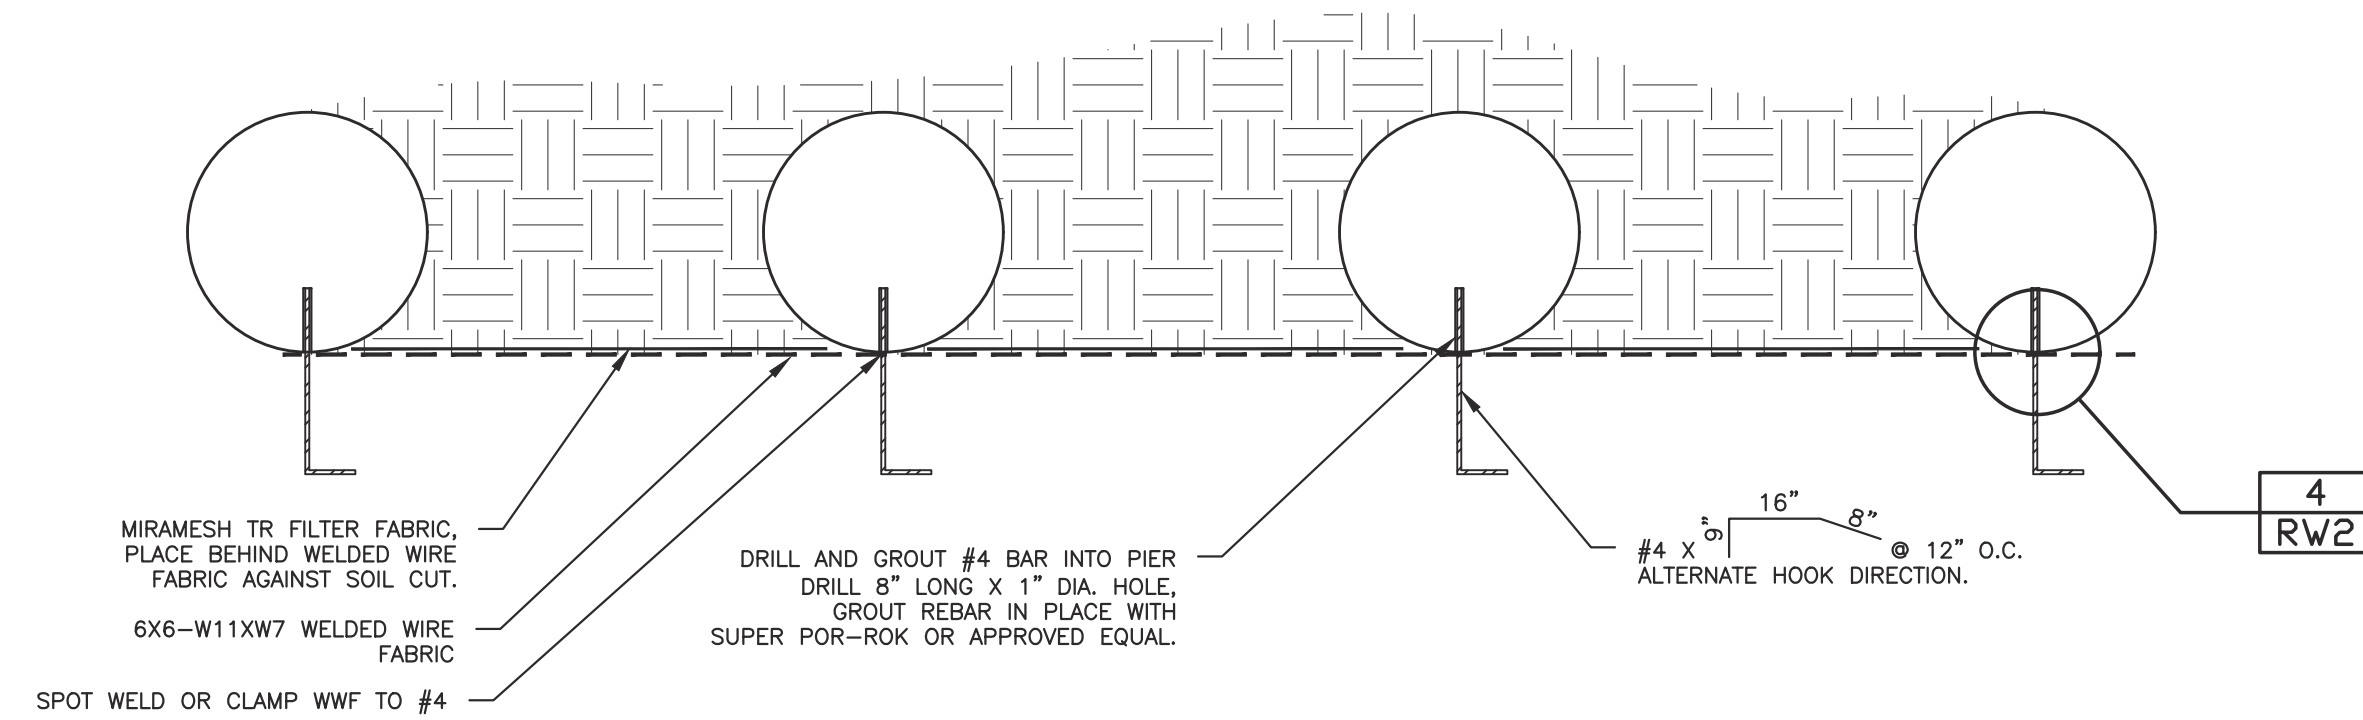

3  
RW2 PLAN VIEW OF SOLDIER PIER WALL 1/2" = 1'-0"

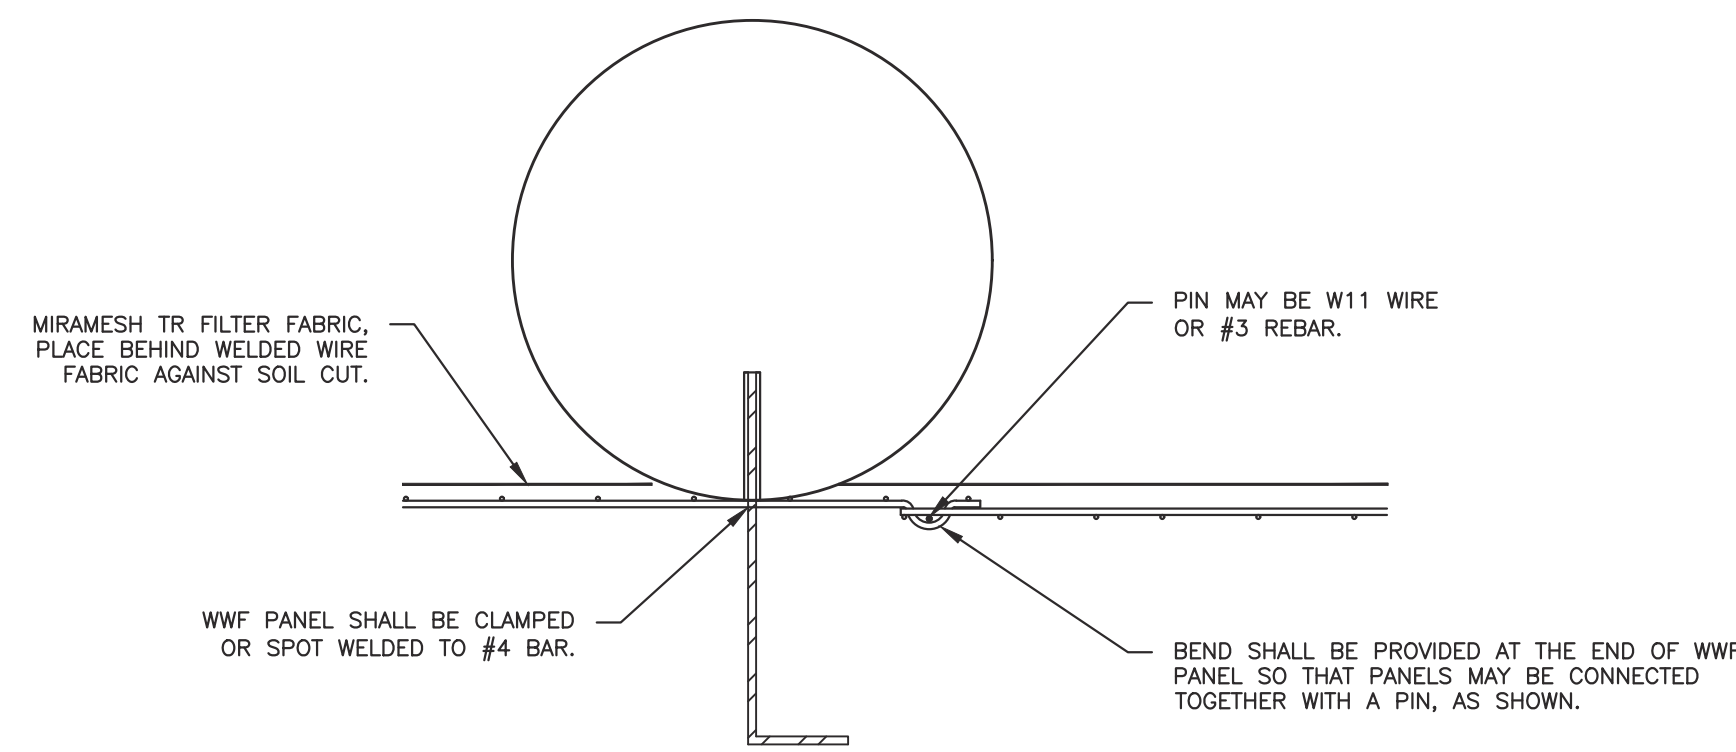

4  
RW2 WIRE LAGGING ATTACHMENT DETAIL 1" = 1'-0"

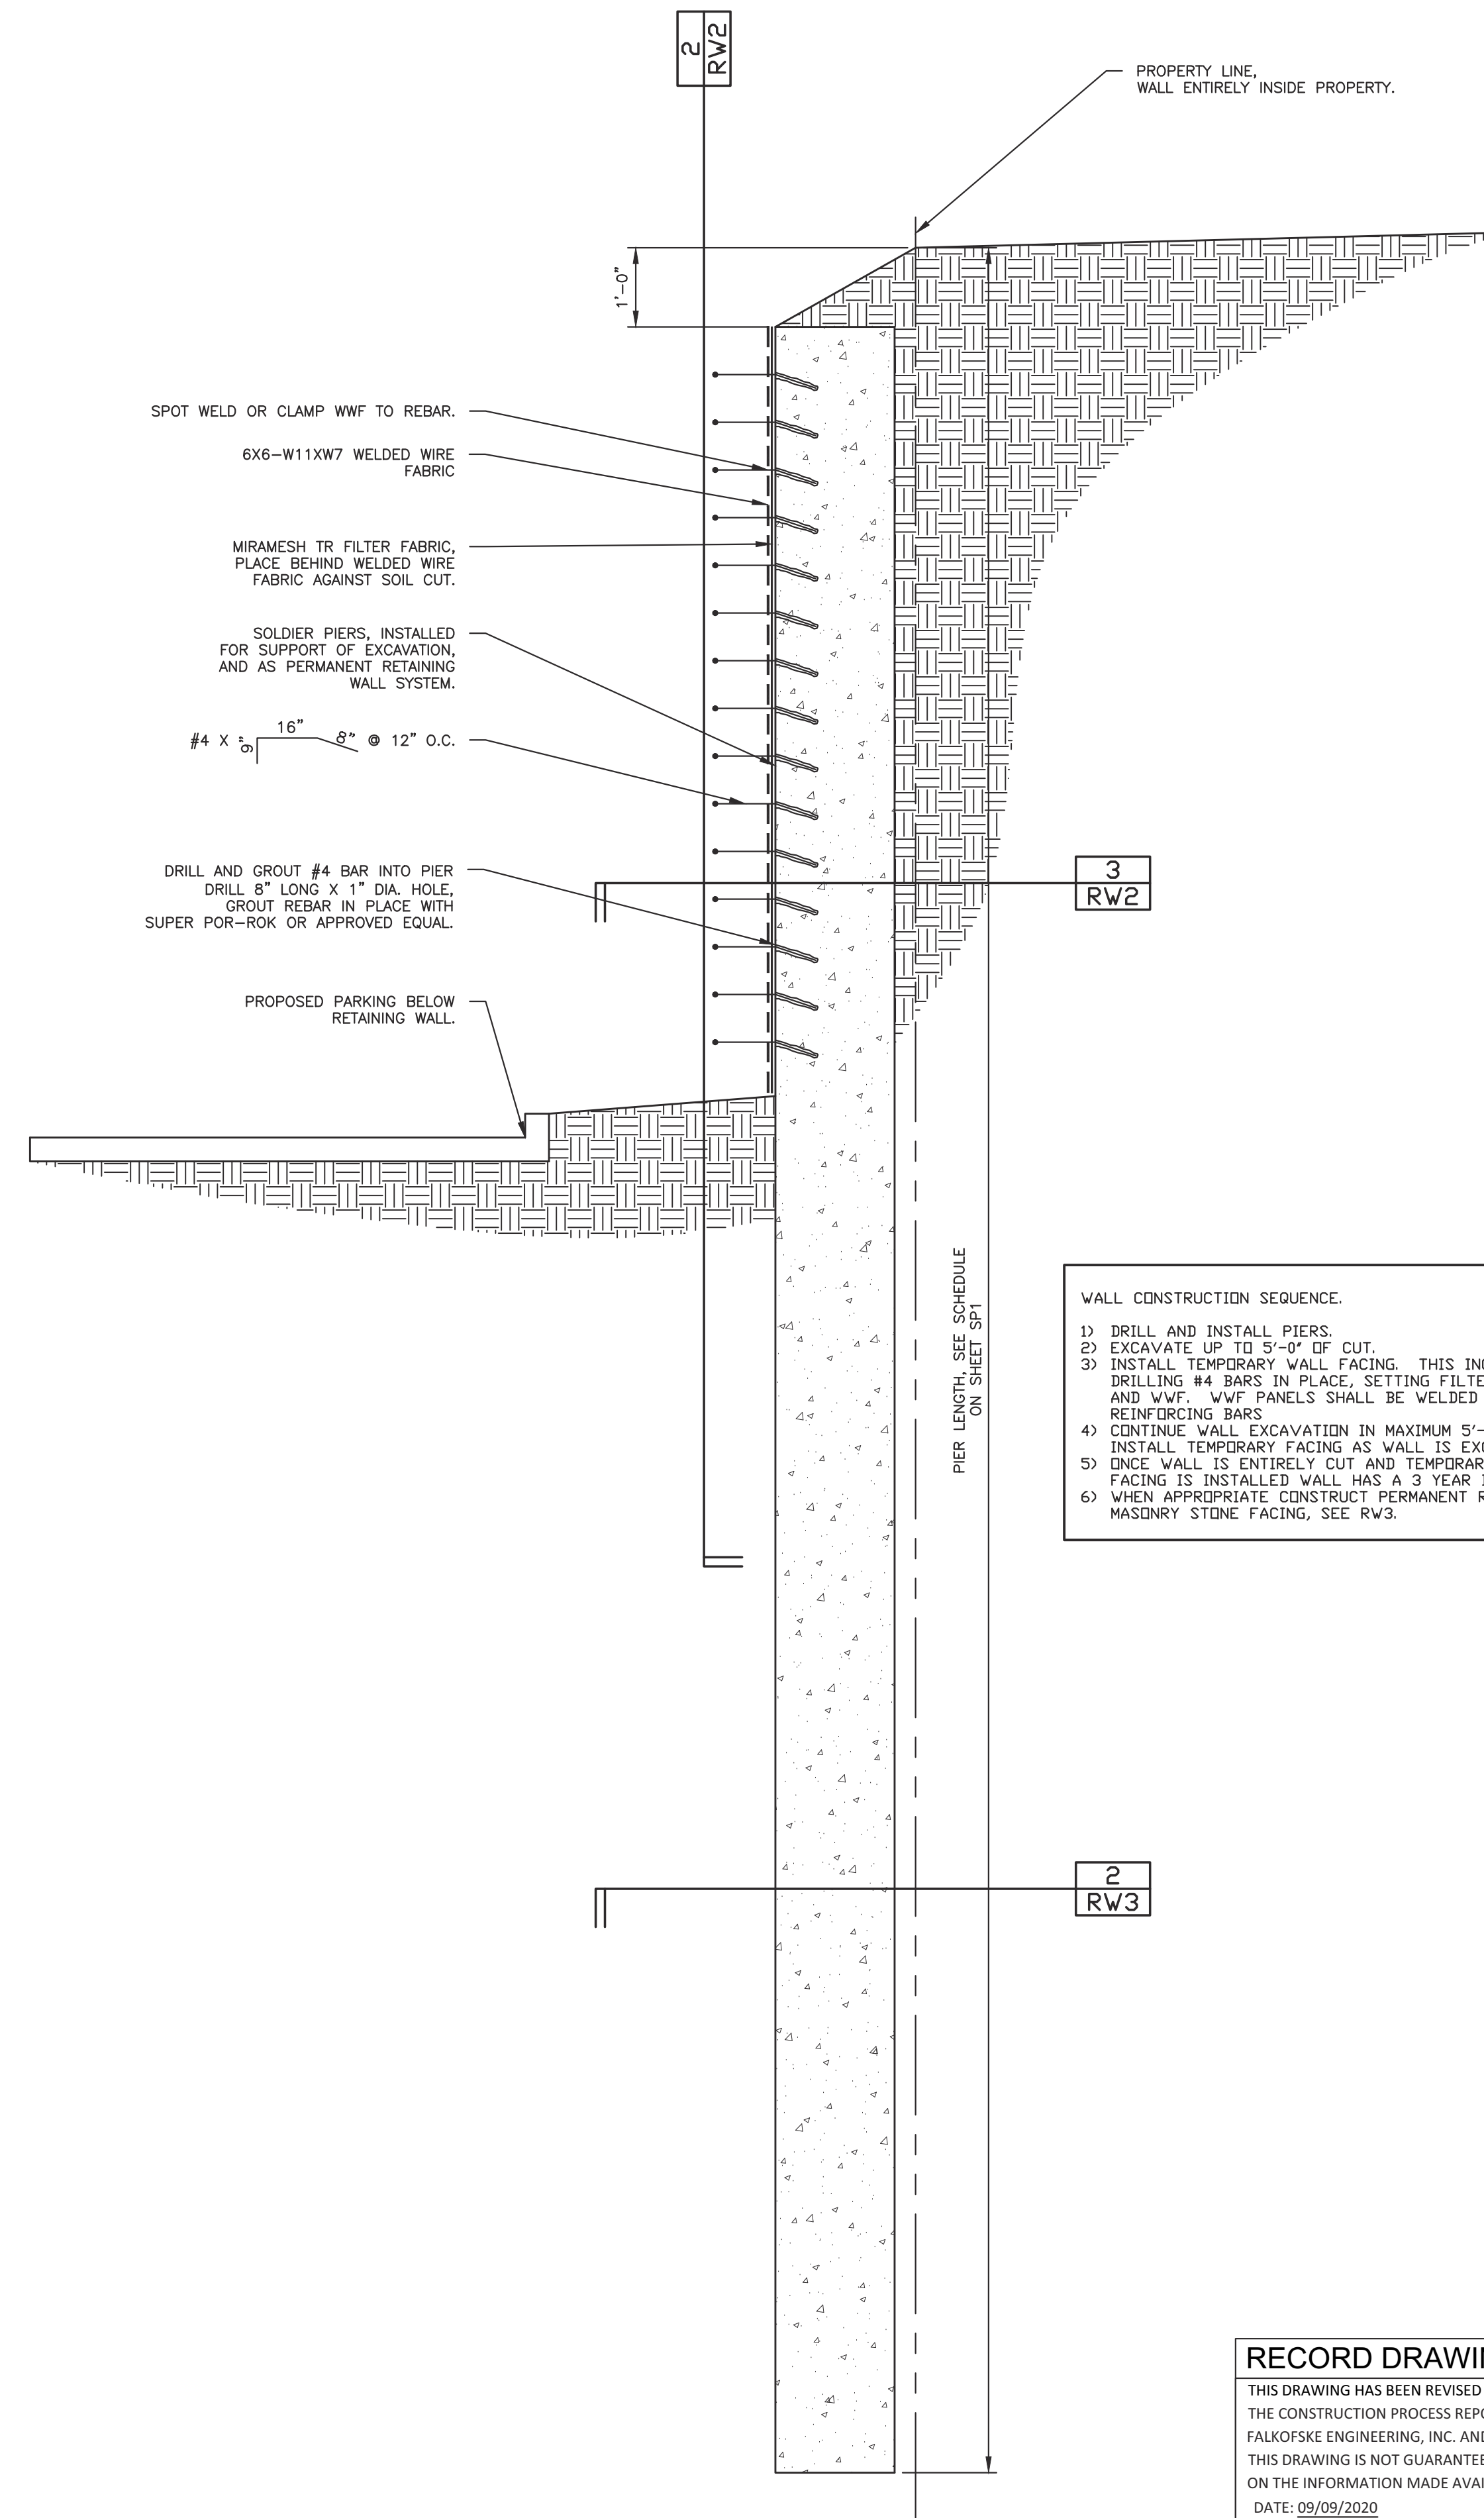

1  
RW2 TYPICAL SECTION AT SOLDIER PILE WALL - TEMPORARY FACING

- WALL CONSTRUCTION SEQUENCE.
- 1) DRILL AND INSTALL PIERS.
  - 2) EXCAVATE UP TO 5'-0" OF CUT.
  - 3) INSTALL TEMPORARY WALL FACING. THIS INCLUDES DRILLING #4 BARS IN PLACE, SETTING FILTER FABRIC AND WWF. WWF PANELS SHALL BE WELDED TO REINFORCING BARS.
  - 4) CONTINUE WALL EXCAVATION IN MAXIMUM 5'-0" CUTS. INSTALL TEMPORARY FACING AS WALL IS EXCAVATED.
  - 5) ONCE WALL IS ENTIRELY CUT AND TEMPORARY WALL FACING IS INSTALLED WALL HAS A 3 YEAR DESIGN LIFE.
  - 6) WHEN APPROPRIATE CONSTRUCT PERMANENT REINFORCED MASONRY STONE FACING, SEE RW3.


**RECORD DRAWINGS**  
 THIS DRAWING HAS BEEN REVISED TO SHOW THOSE CHANGES DURING THE CONSTRUCTION PROCESS REPORTED BY THE CONTRACTOR TO FALKOFSKE ENGINEERING, INC. AND CONSIDERED TO BE SIGNIFICANT. THIS DRAWING IS NOT GUARANTEED TO BE "AS BUILT" BUT IS BASED ON THE INFORMATION MADE AVAILABLE.  
 DATE: 09/09/2020 BY: Aaron Berkes, P.E.

DATE	BY	NO.	DATE	REVISION	BY
03-05-20	AMB				
03-05-20	EG				
03-05-20	AMB				

Falkofske Engineering, Inc.  
 Structural Engineering Consultants  
 TX Reg. Engineering Firm F-4038  
 722 North Fielder Road  
 Arlington, Texas 76012  
 (817) 261-8300

The use of these plans and specifications shall be restricted to the project for which they were prepared. Any other use, reproduction, or distribution, in whole or in part, is prohibited without the prior written consent of Falkofske Engineering, Inc.


SOLDIER PIER WALL AND TEMPORARY FACING DETAILS  
 HYATT ROCKWALL  
 LA JOLLA POINTE DRIVE AND LAGUNA DRIVE  
 ROCKWALL, TEXAS  
 ROCKWALL INKKEEPERS I, LTD  
 6176 FM 2011  
 LONGVIEW, TEXAS 75603

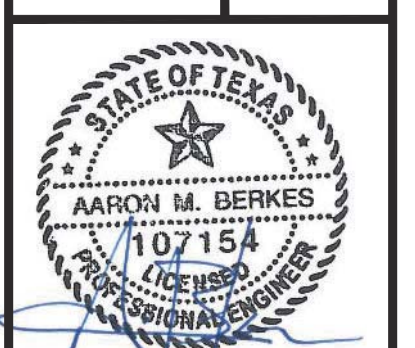

JOB NO. 122.19


RW2



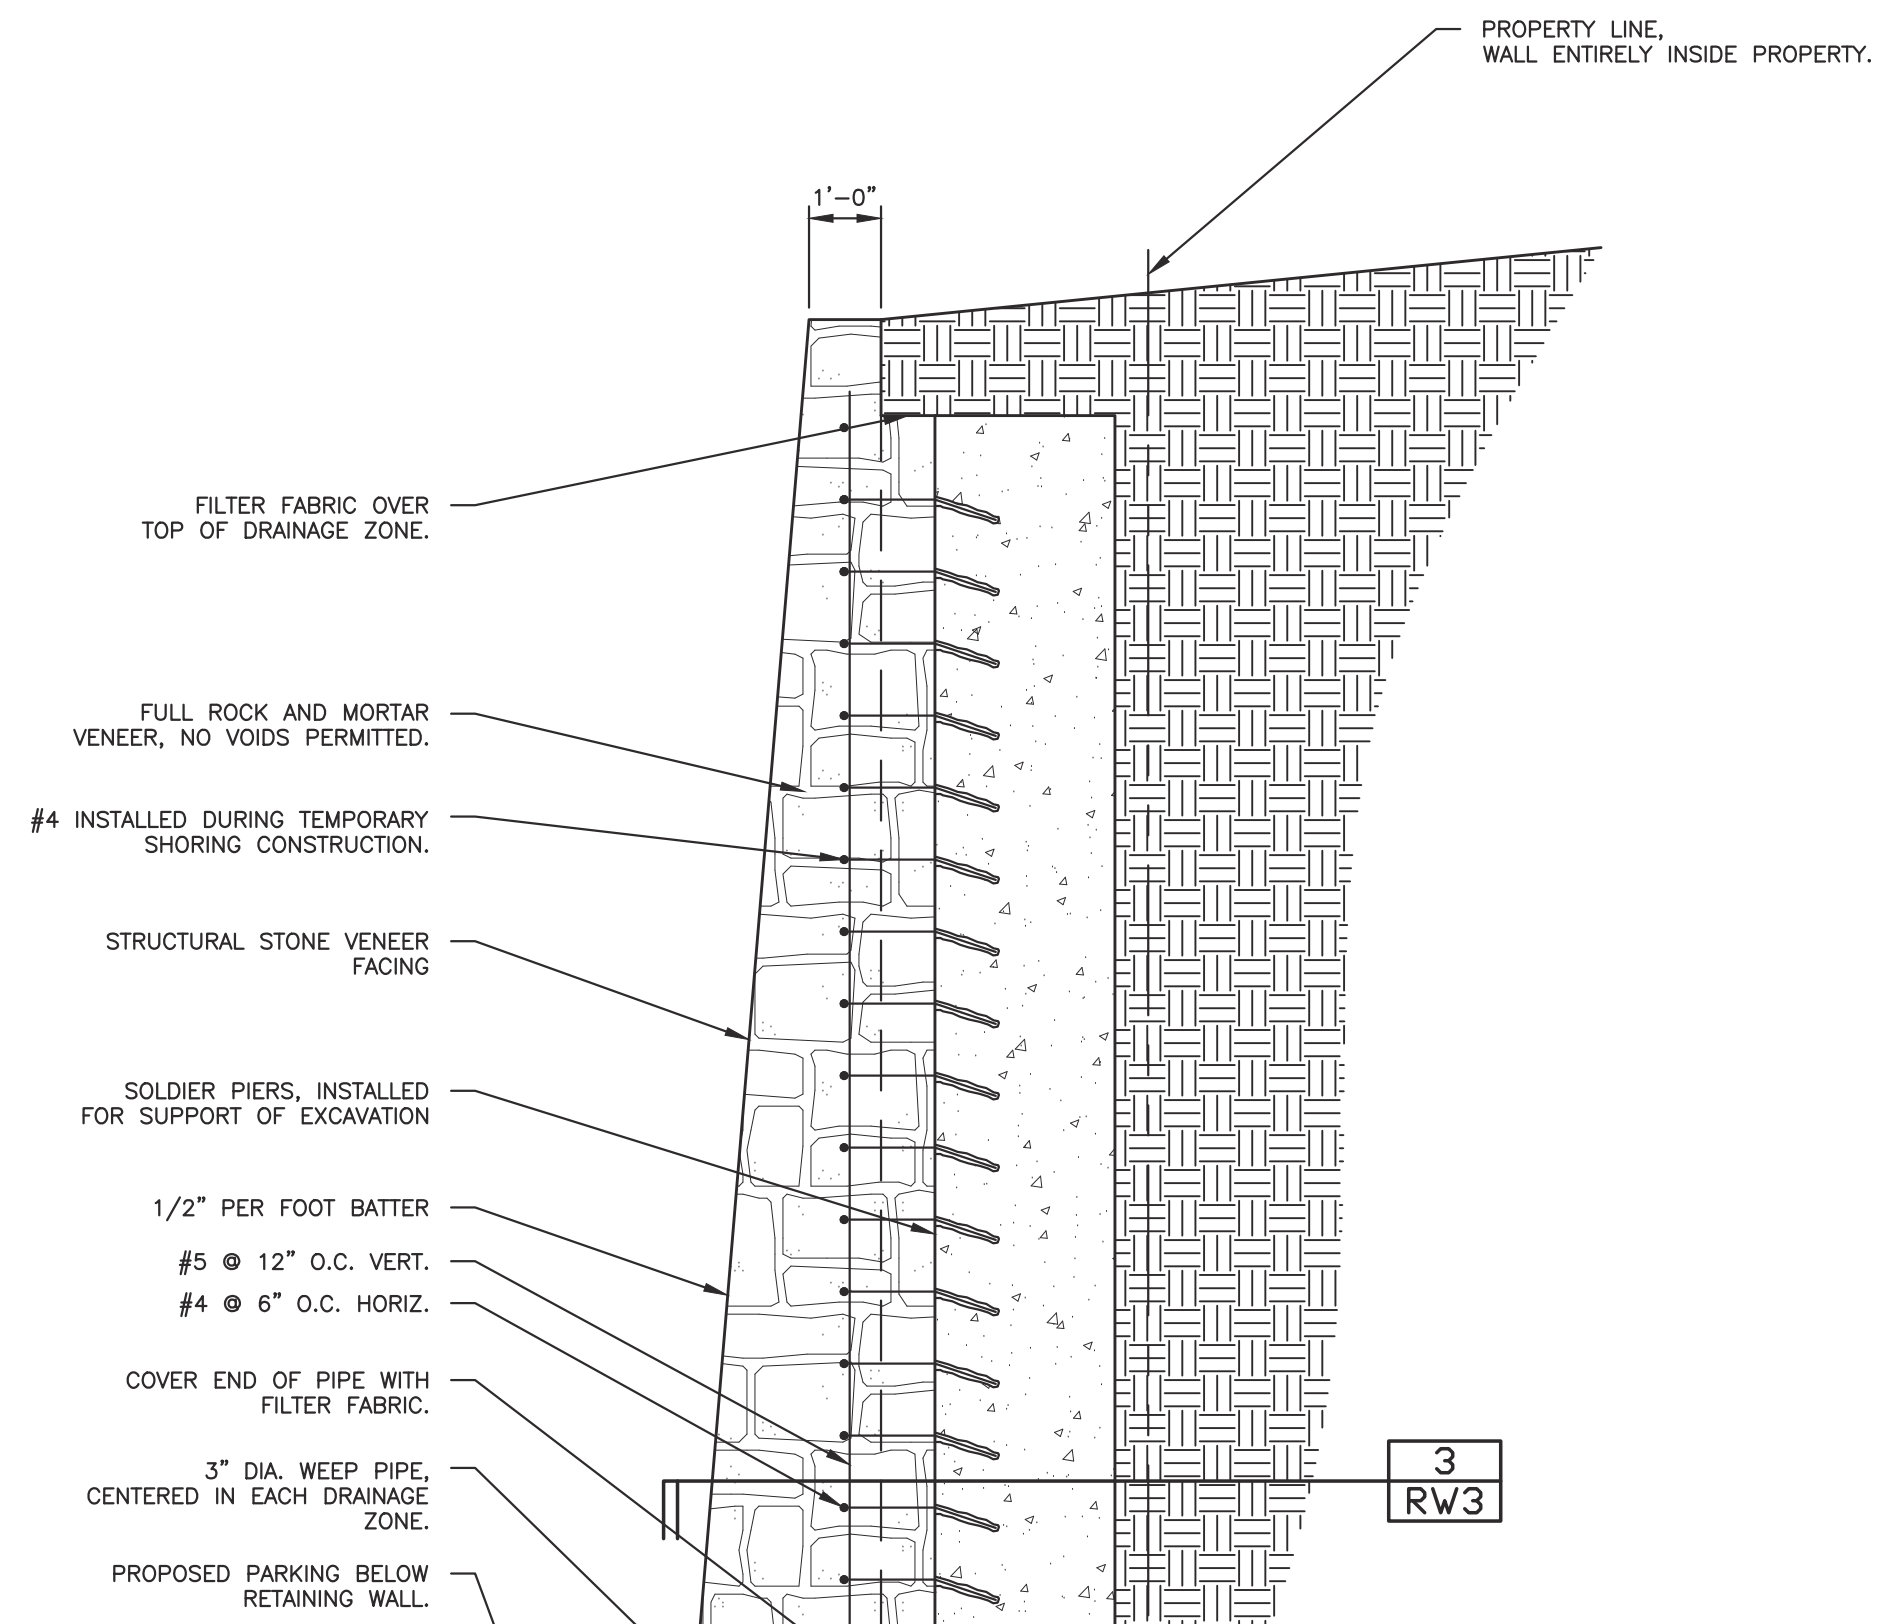


**BASE SCHEDULE**

VENEER HEIGHT	BASE WIDTH
1'-0"	1'-6 1/2"
2'-0"	1'-7"
3'-0"	1'-7 1/2"
4'-0"	1'-8"
5'-0"	1'-8 1/2"
6'-0"	1'-9"
7'-0"	1'-9 1/2"
8'-0"	1'-10"
9'-0"	1'-10 1/2"
10'-0"	1'-11"
11'-0"	1'-11 1/2"

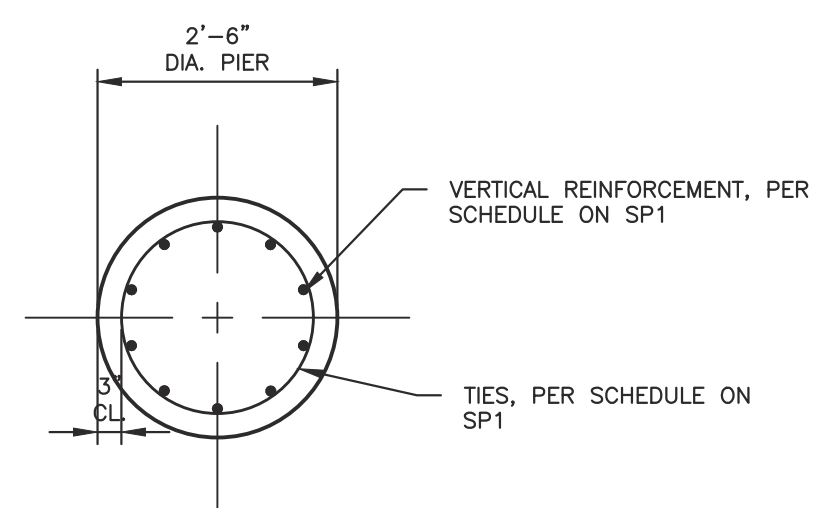

2 RW3 PIER SECTION 1/2" = 1'-0"

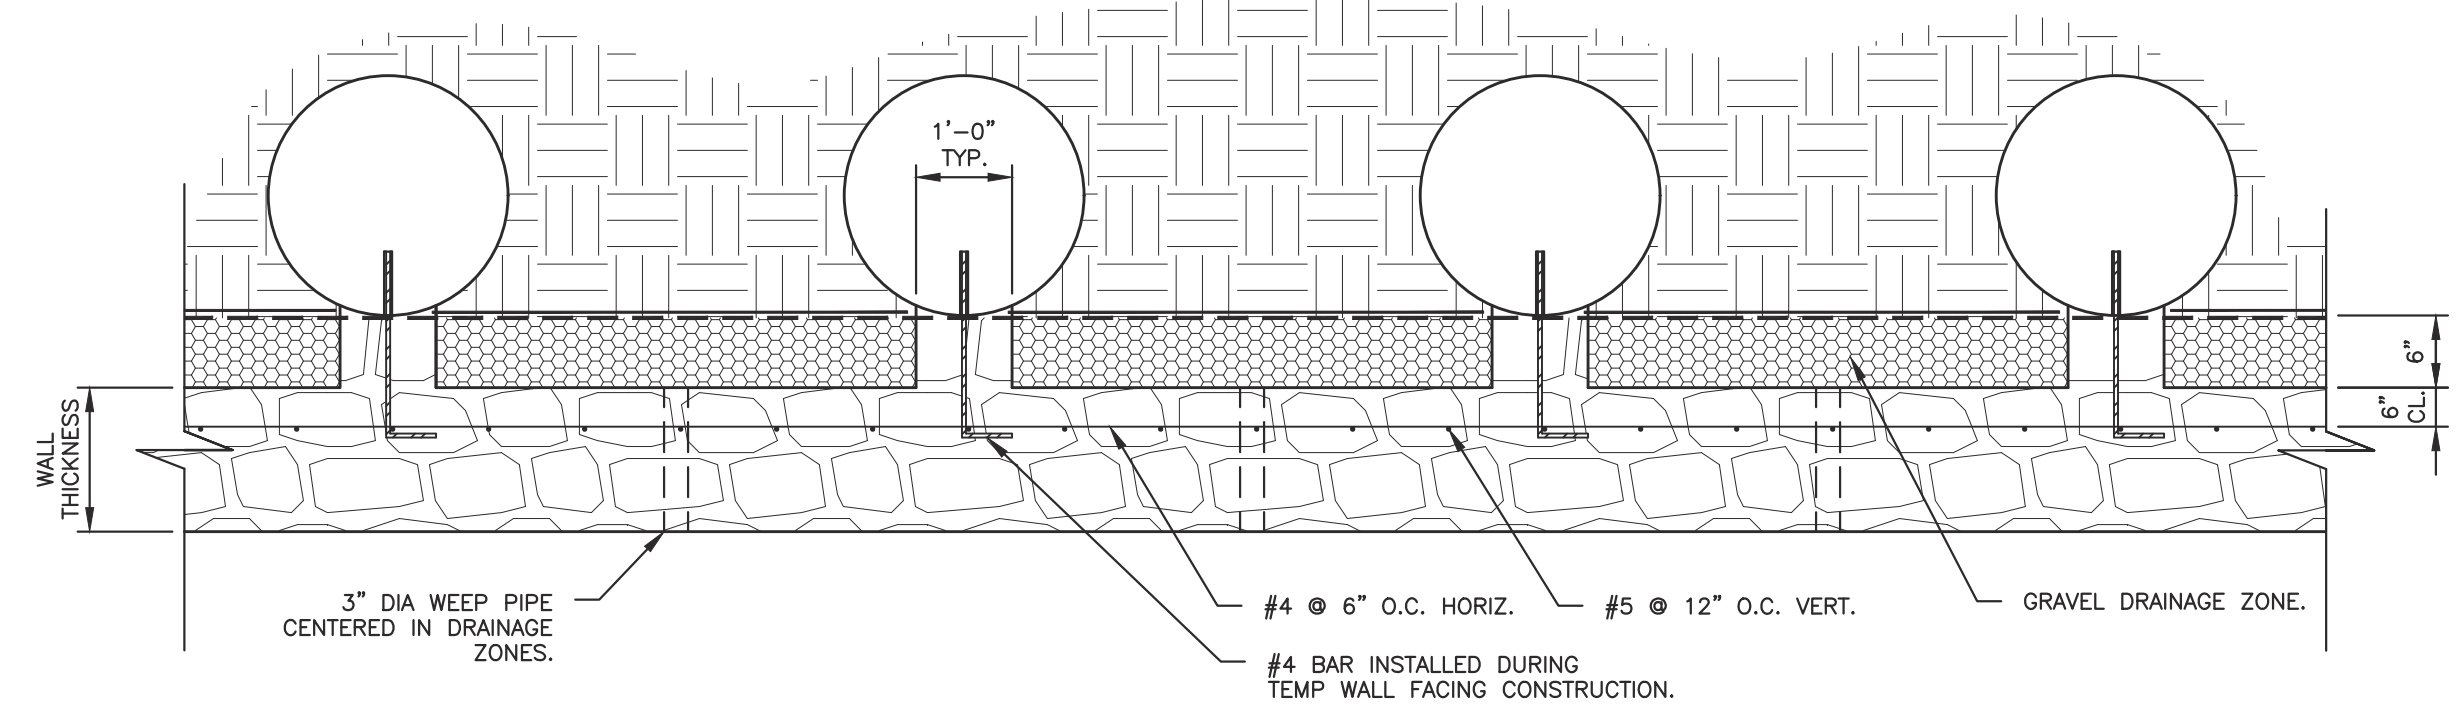

3 RW3 WALL SECTION 1/2" = 1'-0"

1 RW3 TYPICAL SECTION AT SOLDIER PILE WALL WITH PERMANENT STONE FACING.


**RECORD DRAWINGS**  
 THIS DRAWING HAS BEEN REVISED TO SHOW THOSE CHANGES DURING THE CONSTRUCTION PROCESS REPORTED BY THE CONTRACTOR TO FALKOFSKE ENGINEERING, INC. AND CONSIDERED TO BE SIGNIFICANT. THIS DRAWING IS NOT GUARANTEED TO BE "AS BUILT" BUT IS BASED ON THE INFORMATION MADE AVAILABLE.  
 DATE: 09/09/2020 BY: Aaron Berkes, P.E.

DATE	BY	NO.	DATE	REVISION	BY
03-05-20	AMB				
03-05-20	EG				
03-05-20	AMB				

Falkofske Engineering, Inc.  
 Structural Engineering Consultants  
 TX Reg. Engineering Firm F-4038  
 722 North Fielder Road  
 Arlington, Texas 76012  
 (817) 261-8300

The use of these plans and specifications shall be restricted to the project for which they were prepared. Any use for any other project is expressly limited to such use, and any such use shall be at the discretion of the contractor. The use of these plans and specifications for any other project, in whole or in part, is prohibited. The user shall be responsible for obtaining all necessary permits and for obtaining all necessary information concerning applicable laws and regulations. FALKOFSKE ENGINEERING, INC. is not responsible for any such use.

SOLDIER PIER WALL AND PERMANENT STONE FACING  
 HYATT ROCKWALL  
 LA JOLLA POINTE DRIVE AND LAGUNA DRIVE  
 ROCKWALL, TEXAS  
 ROCKWALL INKKEEPERS 1, LTD  
 6176 FM 2011  
 LONGVIEW, TEXAS 75603

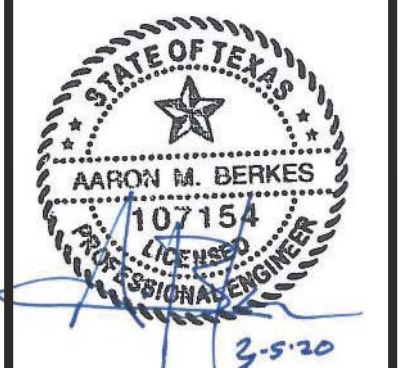


JOB NO. 122.19

RW3



NOTE:  
 TOP OF WALL SHALL BE A MAXIMUM OF 18"  
 TO 4'-0" ABOVE THE TOP OF PIER. WALL  
 THICKNESS ABOVE TOP OF PIER SHALL BE  
 2'-0" THICK AS SHOWN ON DETAIL 1/RW4.  
 ALSO, FOR WALLS THAT ARE BETWEEN THE  
 PIERS SHALL ALSO HAVE A THICKNESS OF  
 2'-0" AT TOP OF WALL.

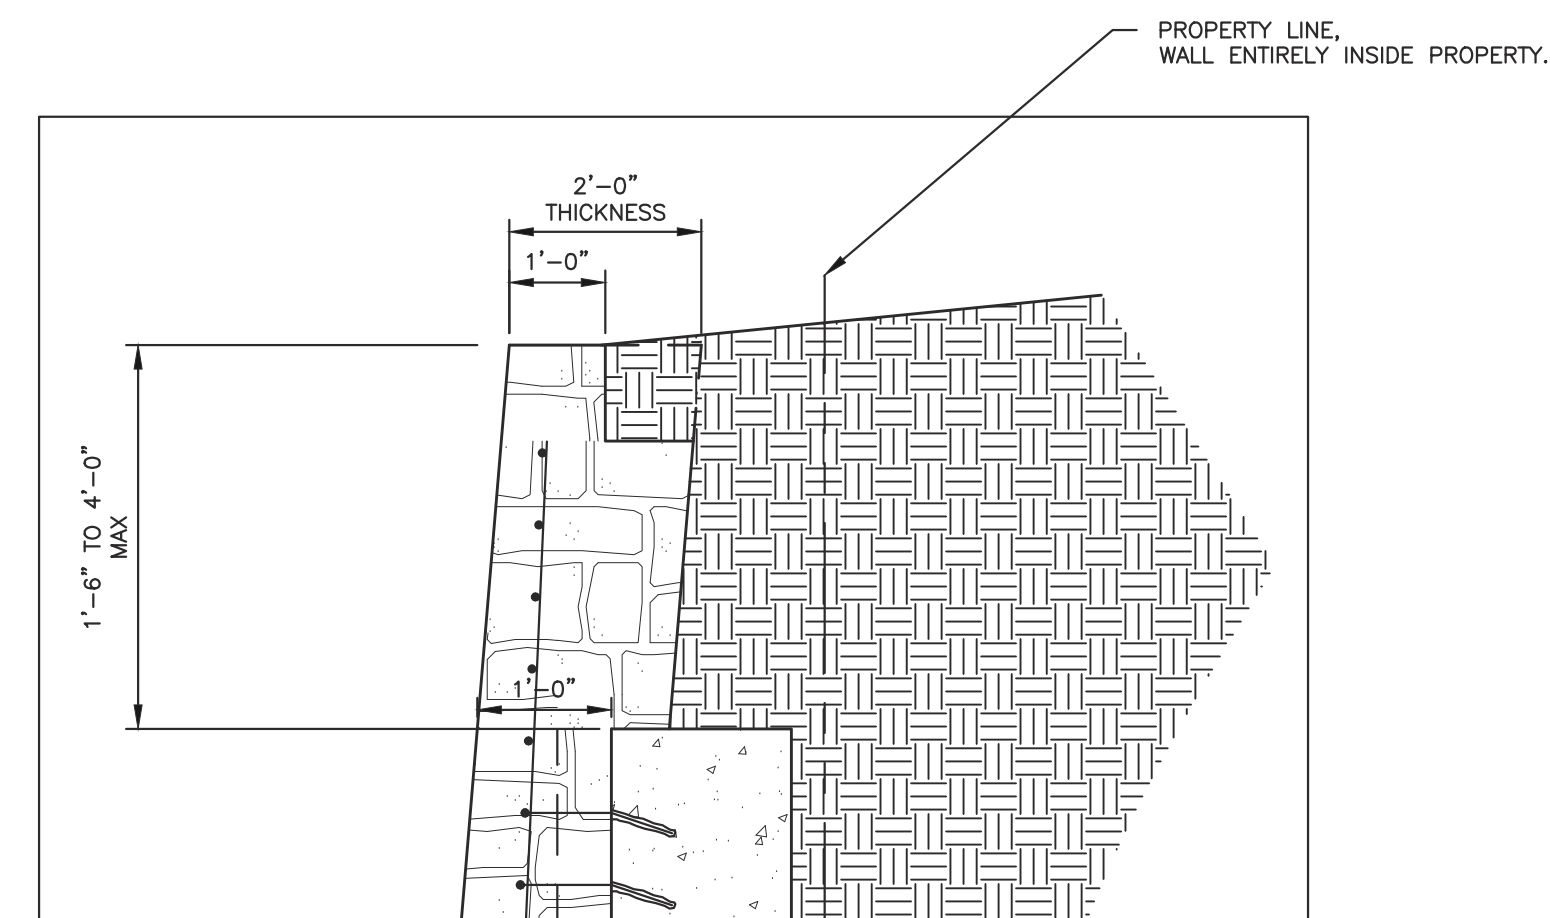

1  
 RW4


WALL SECTION MODIFIED TOP OF WALL

1/2" = 1'-0"

**RECORD DRAWINGS**  
 THIS DRAWING HAS BEEN REVISED TO SHOW THOSE CHANGES DURING  
 THE CONSTRUCTION PROCESS REPORTED BY THE CONTRACTOR TO  
 FALKOFSKE ENGINEERING, INC. AND CONSIDERED TO BE SIGNIFICANT.  
 THIS DRAWING IS NOT GUARANTEED TO BE "AS BUILT" BUT IS BASED  
 ON THE INFORMATION MADE AVAILABLE.  
 DATE: 09/09/2020 BY: Aaron Berkes, P.E.

MODIFIED SOLDIER PIER WALL AND PERMANENT STONE FACING  
 HYATT ROCKWALL  
 LA JOLLA POINTE DRIVE AND LAGUNA DRIVE  
 ROCKWALL, TEXAS


ROCKWALL INKKEEPERS I, LTD  
 6176 FM 2011  
 LONGVIEW, TEXAS 75603

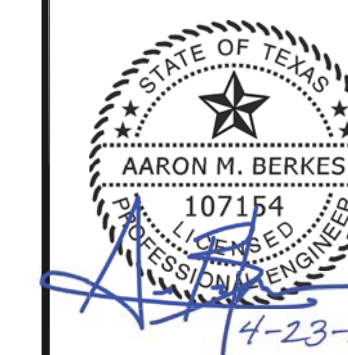

JOB NO. 122.19

RW4

Falkofske Engineering, Inc.  
 Structural Engineering Consultants  
 TX Reg. Engineering Firm F-4038  
 722 North Fielder Road  
 Arlington, Texas 76012  
 (817) 261-8300

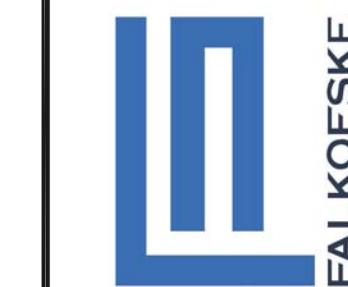


The use of these plans and specifications shall be restricted to the project for which they were prepared. Any other use, reproduction, or distribution, in whole or in part, is prohibited without the prior written consent of Falkofske Engineering, Inc.

DATE	BY	NO.	DATE	REVISION	BY
DES. 04-23-20	AMB				
DRN. 04-23-20	EG				
CHK. 04-23-20	AMB				



M. K. & T. RAILROAD

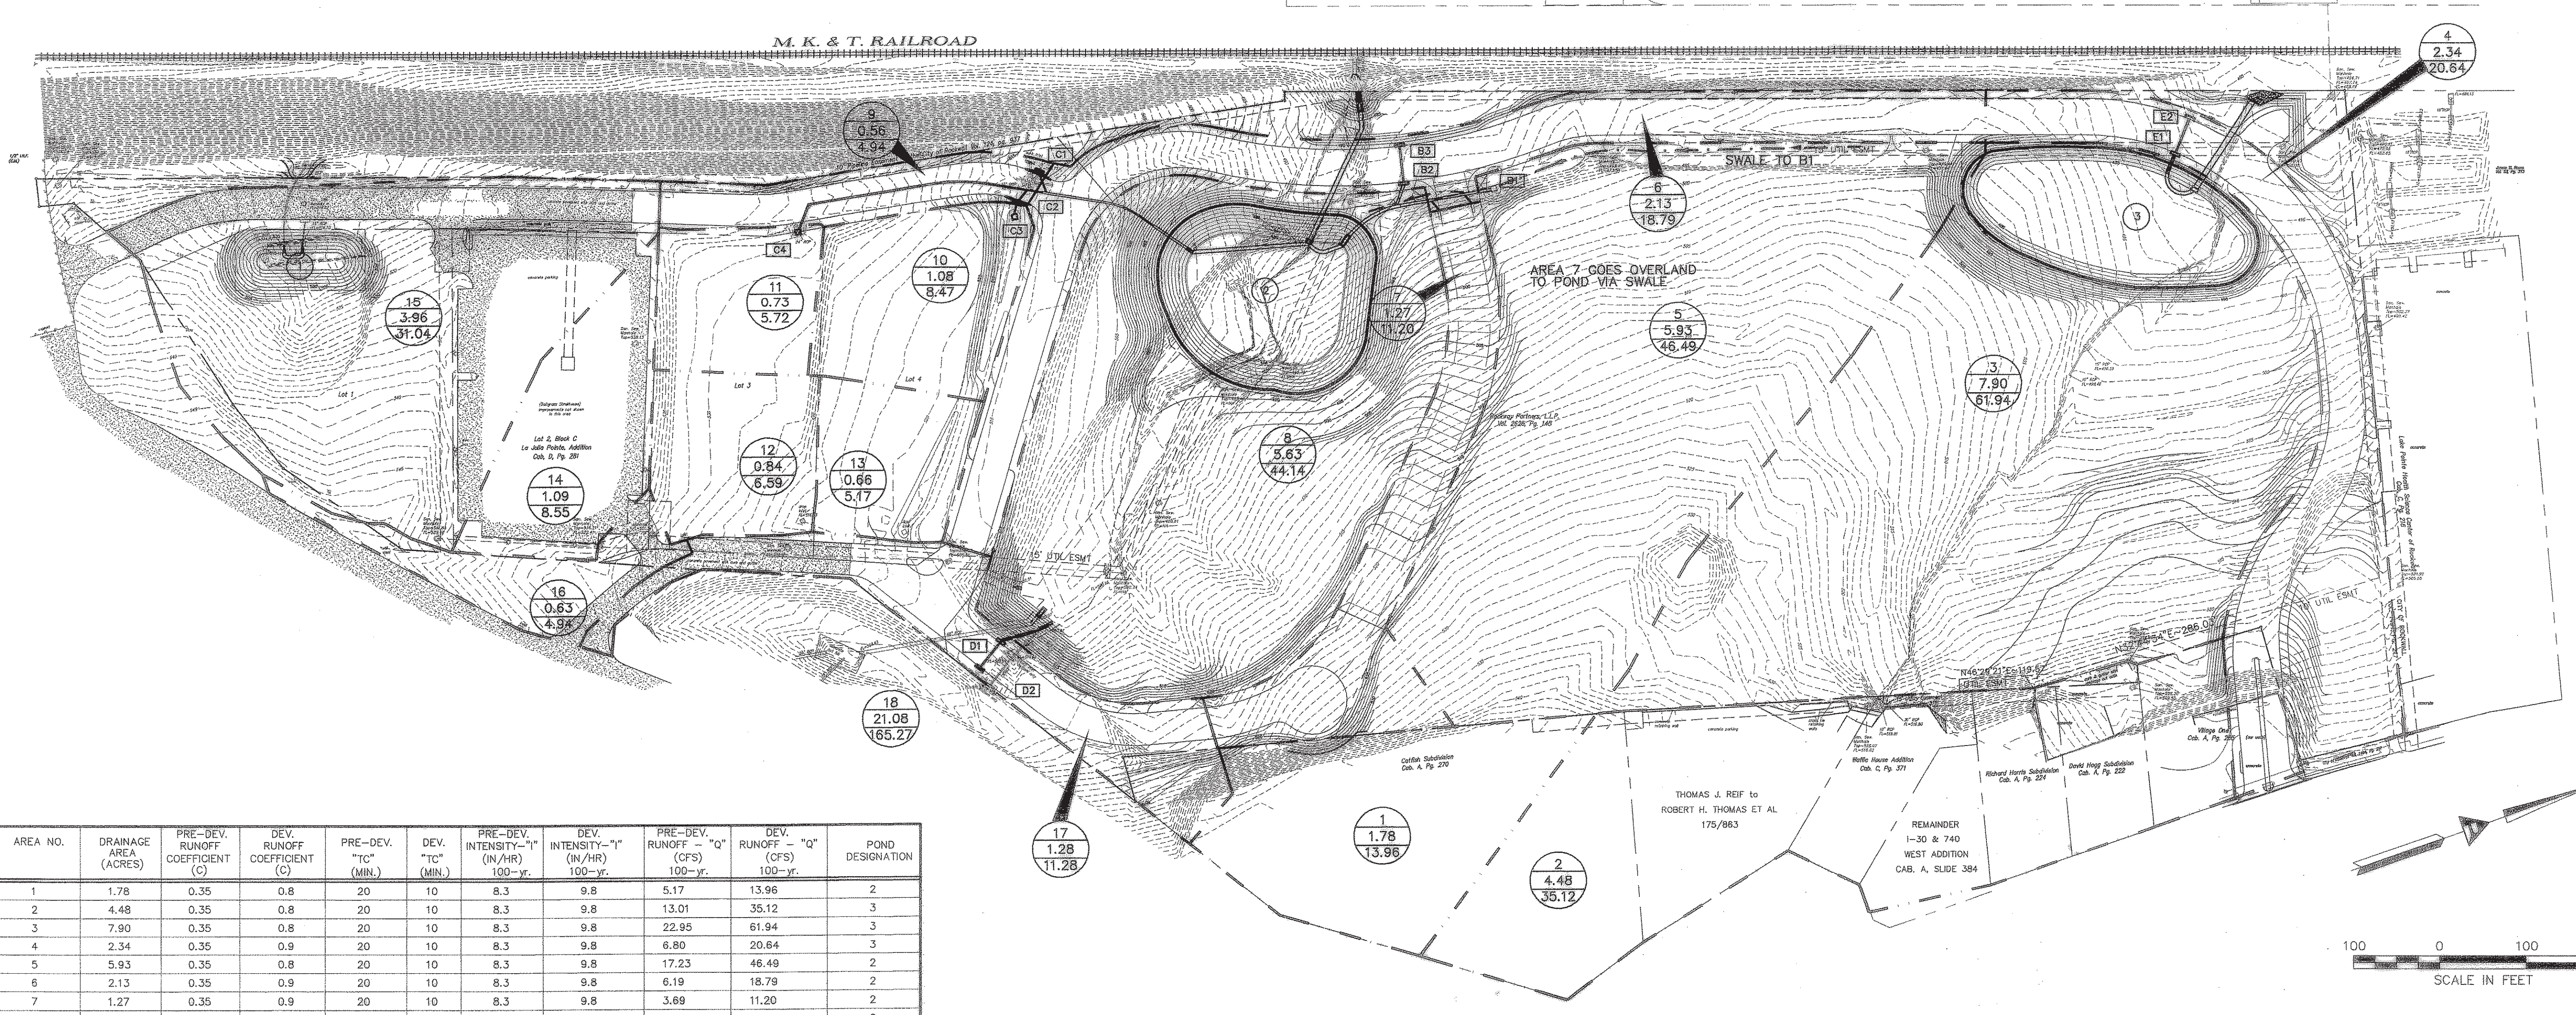

AREA NO.	DRAINAGE AREA (ACRES)	PRE-DEV. RUNOFF COEFFICIENT (C)	DEV. RUNOFF COEFFICIENT (C)	PRE-DEV. "Tc" (MIN.)	DEV. "Tc" (MIN.)	PRE-DEV. INTENSITY - "I" (IN/HR) 100-yr.	DEV. INTENSITY - "I" (IN/HR) 100-yr.	PRE-DEV. RUNOFF - "Q" (CFS) 100-yr.	DEV. RUNOFF - "Q" (CFS) 100-yr.	POND DESIGNATION
1	1.78	0.35	0.8	20	10	8.3	9.8	5.17	13.96	2
2	4.48	0.35	0.8	20	10	8.3	9.8	13.01	35.12	3
3	7.90	0.35	0.8	20	10	8.3	9.8	22.95	61.94	3
4	2.34	0.35	0.9	20	10	8.3	9.8	6.80	20.64	3
5	5.93	0.35	0.8	20	10	8.3	9.8	17.23	46.49	2
6	2.13	0.35	0.9	20	10	8.3	9.8	6.19	18.79	2
7	1.27	0.35	0.9	20	10	8.3	9.8	3.69	11.20	2
8	5.63	0.35	0.8	20	10	8.3	9.8	16.36	44.14	2
9	0.56	0.35	0.8	20	10	8.3	9.8	1.63	4.94	2
10	1.08	0.35	0.8	20	10	8.3	9.8	3.14	8.47	2
11	0.73	0.35	0.8	20	10	8.3	9.8	2.12	5.72	2
12	0.84	0.35	0.8	20	10	8.3	9.8	2.44	6.59	2
13	0.66	0.35	0.8	20	10	8.3	9.8	1.92	5.17	2
14	1.09	0.35	0.8	20	10	8.3	9.8	3.16	8.55	2
15	3.96	0.35	0.8	20	10	8.3	9.8	13.58	31.05	1
16	0.63	0.35	0.8	20	10	8.3	9.8	1.83	4.94	2
17	1.28	0.35	0.9	20	10	8.3	9.8	3.72	11.28	2
18	21.08	0.35	0.8	20	10	8.3	9.8	61.24	165.27	2

DETENTION POND	CONTRIBUTING DRAINAGE AREA TO POND	AGGREGATE RUNOFF COEFFICIENT	TOTAL PRE-DEV. RUNOFF TO POND 100-YR	TOTAL DEV. RUNOFF TO POND 100-YR	TOTAL PRE-DEV. RUNOFF TO POND 2-YR	TOTAL DEV. RUNOFF TO POND 2-YR	TOTAL PRE-DEV. RUNOFF TO POND 5-YR	TOTAL DEV. RUNOFF TO POND 5-YR	TOTAL PRE-DEV. RUNOFF TO POND 10-YR	TOTAL DEV. RUNOFF TO POND 10-YR	TOTAL PRE-DEV. RUNOFF TO POND 25-YR	TOTAL DEV. RUNOFF TO POND 25-YR	TOTAL PRE-DEV. RUNOFF TO POND 50-YR	TOTAL DEV. RUNOFF TO POND 50-YR
1	3.96	0.80	11.50	31.05	5.13	14.57	6.65	17.74	7.97	20.59	9.01	24.08	10.40	28.20
2	44.69	0.81	129.82	354.75	57.87	166.51	75.08	202.71	89.94	235.29	101.67	275.11	117.31	322.17
3	14.72	0.82	42.76	118.29	19.06	55.52	24.73	67.59	29.62	78.46	33.49	91.74	38.64	107.43

SEE SHT C-22 FOR DETENTION CALCULATIONS.

INLET CALCULATIONS															
INLET No.	Location	Design Storm Frequency (yrs.)	AREA RUNOFF Q = CIA					Carry-Over From Upstream Inlet (cfs.)	Gutter Slope (ft./ft.)	Crown Type	SELECTED INLET			Carry-Over To Downstream Inlet (cfs.)	
			Time of Conc. (min.)	Intensity (in./hr.)	Runoff Coeff. "C"	Area (Ac.)	"Q" (cfs.)				Length "L" (feet)	Type	Capacity (cfs)		
B1	LINE "B"	100	10	9.8	0.8	5.93	46.49	0	N/A	N/A	4'x4'	DROP	48	0	
B2	LAT. "B-1"	100	10	9.8	0.9	1.065	9.4	0	SUMP	2%	10	C.I.	15.6	0	
B3	LAT. "B-1"	100	10	9.8	0.9	1.065	9.4	0	SUMP	2%	10	C.I.	15.6	0	
C1	LAT. "C-1"	100	10	9.8	0.9	0.28	2.47	0	0.080	2%	10	C.I.	6.6	0	
C2	LAT. "C-2"	100	10	9.8	0.9	0.28	2.47	0	0.080	2%	10	C.I.	6.6	0	
C3	LAT. "C-2"	100	10	9.8	0.8	1.08	8.47	0	N/A	N/A	4'x4'	DROP	48	0	
C4	LINE "C"	100	10	9.8	0.8	0.73	5.72	0	N/A	N/A	4'x4'	DROP	48	0	
D1	LINE "D"	100	10	9.8	0.9	0.64	5.64	0	SUMP	2%	10	C.I.	15.6	0	
D2	LINE "D"	100	10	9.8	0.9	0.64	5.64	0	SUMP	2%	10	C.I.	15.6	0	
E1	LINE "E"	100	10	9.8	0.9	1.17	10.32	0	SUMP	2%	10	C.I.	15.6	0	
E2	LINE "E"	100	10	9.8	0.9	1.17	10.32	0	SUMP	2%	10	C.I.	15.6	0	

FOR INFORMATION ONLY

RECORD DRAWINGS AS PROVIDED BY: I.C.S. COMMERCIAL  
 DATE: 9/25/03

App. Revisions No. Date

**Allen & Ridinger Consulting, Inc.**  
 109 W. Main Street  
 Lewisville, Texas 75057  
 Tel. No. (972) 353-8000  
 Fax No. (972) 353-8011

STATE OF TEXAS  
 MICHAEL S. ALLEN  
 86188  
 LICENSED PROFESSIONAL ENGINEER  
 3/14/03

La Jolla Pointe Addition  
 ROCKWALL, TEXAS


DRAINAGE AREA MAP

Scale: 1"=100'  
 Designed by: MSA  
 Drawn by: MSA  
 Checked by: MSA  
 Date: March 14, 2003  
 Project No. 018-001


SHEET C-7 OF 25




FOR INFORMATION ONLY

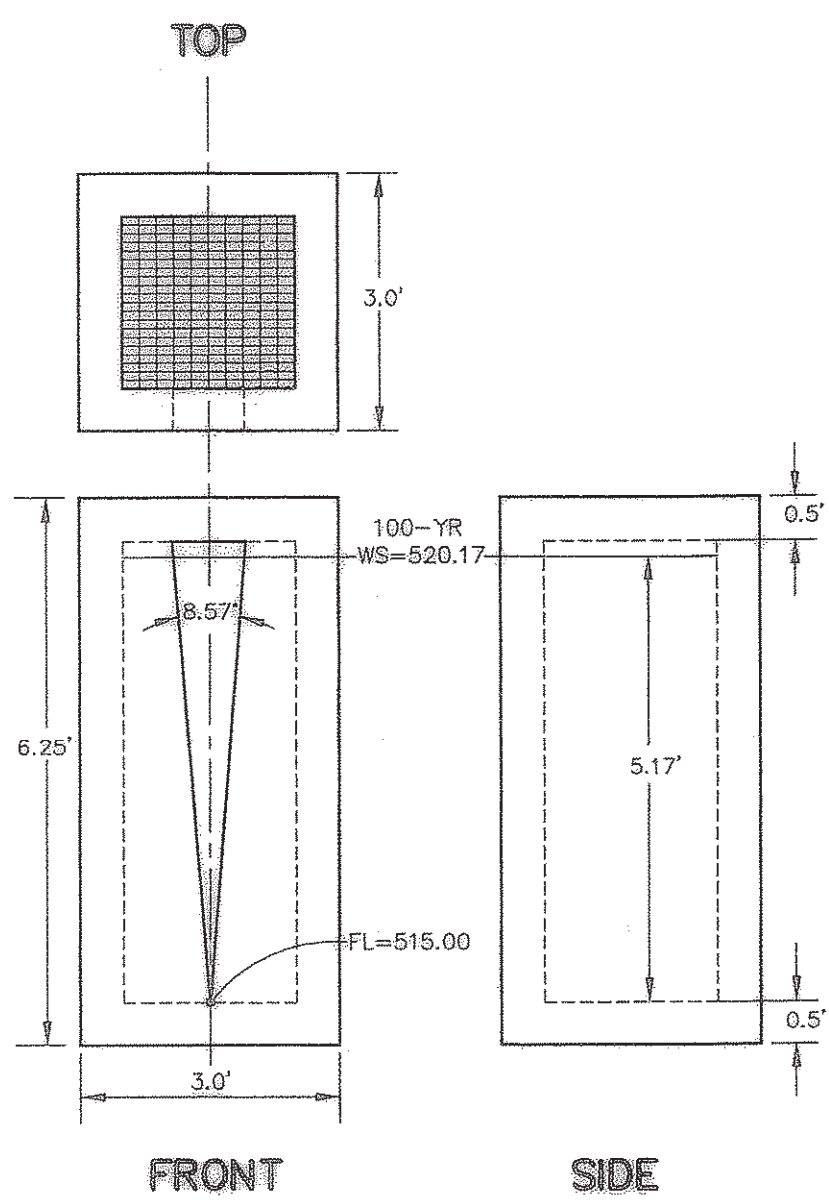

**POND 1  
METERING STRUCTURE**  
N.T.S.

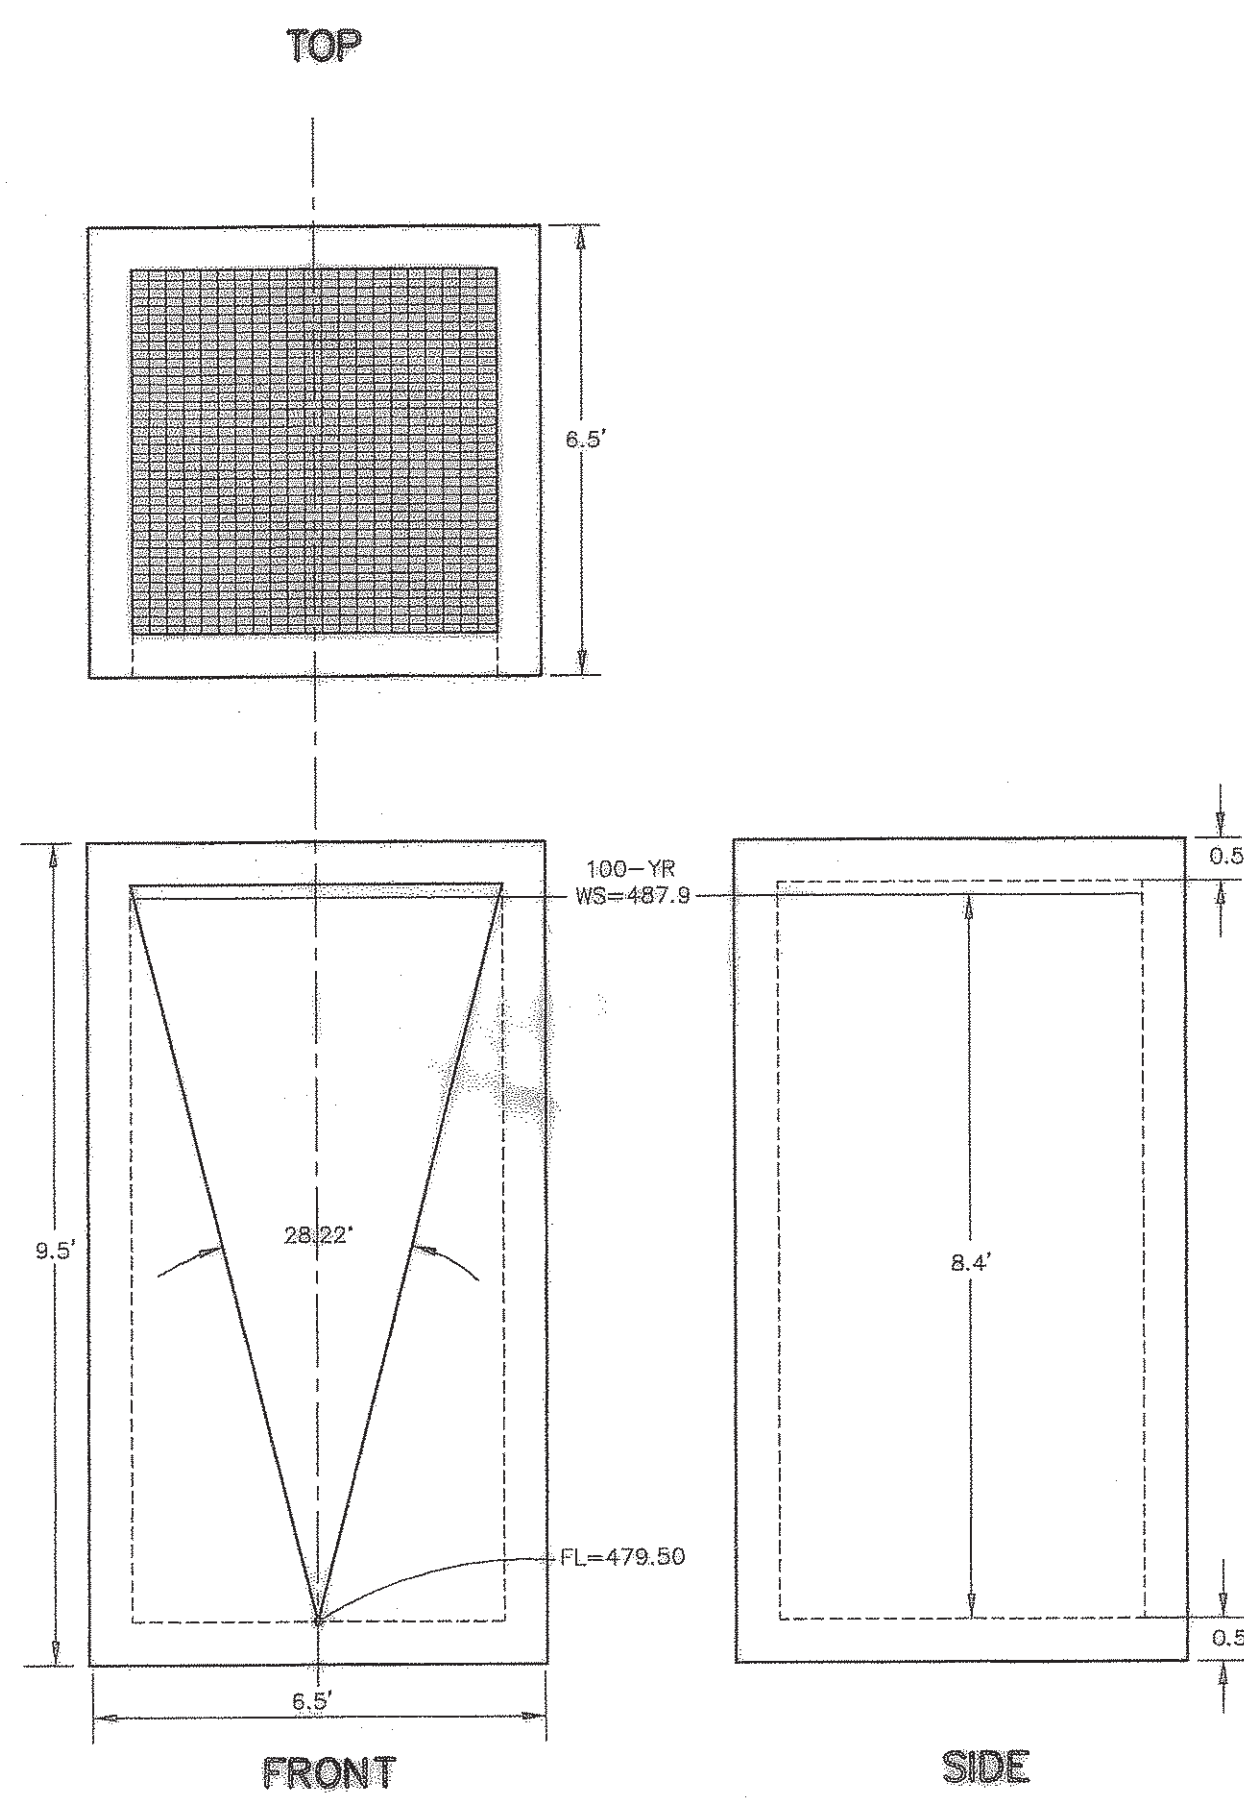

**POND 2  
METERING STRUCTURE**  
N.T.S.

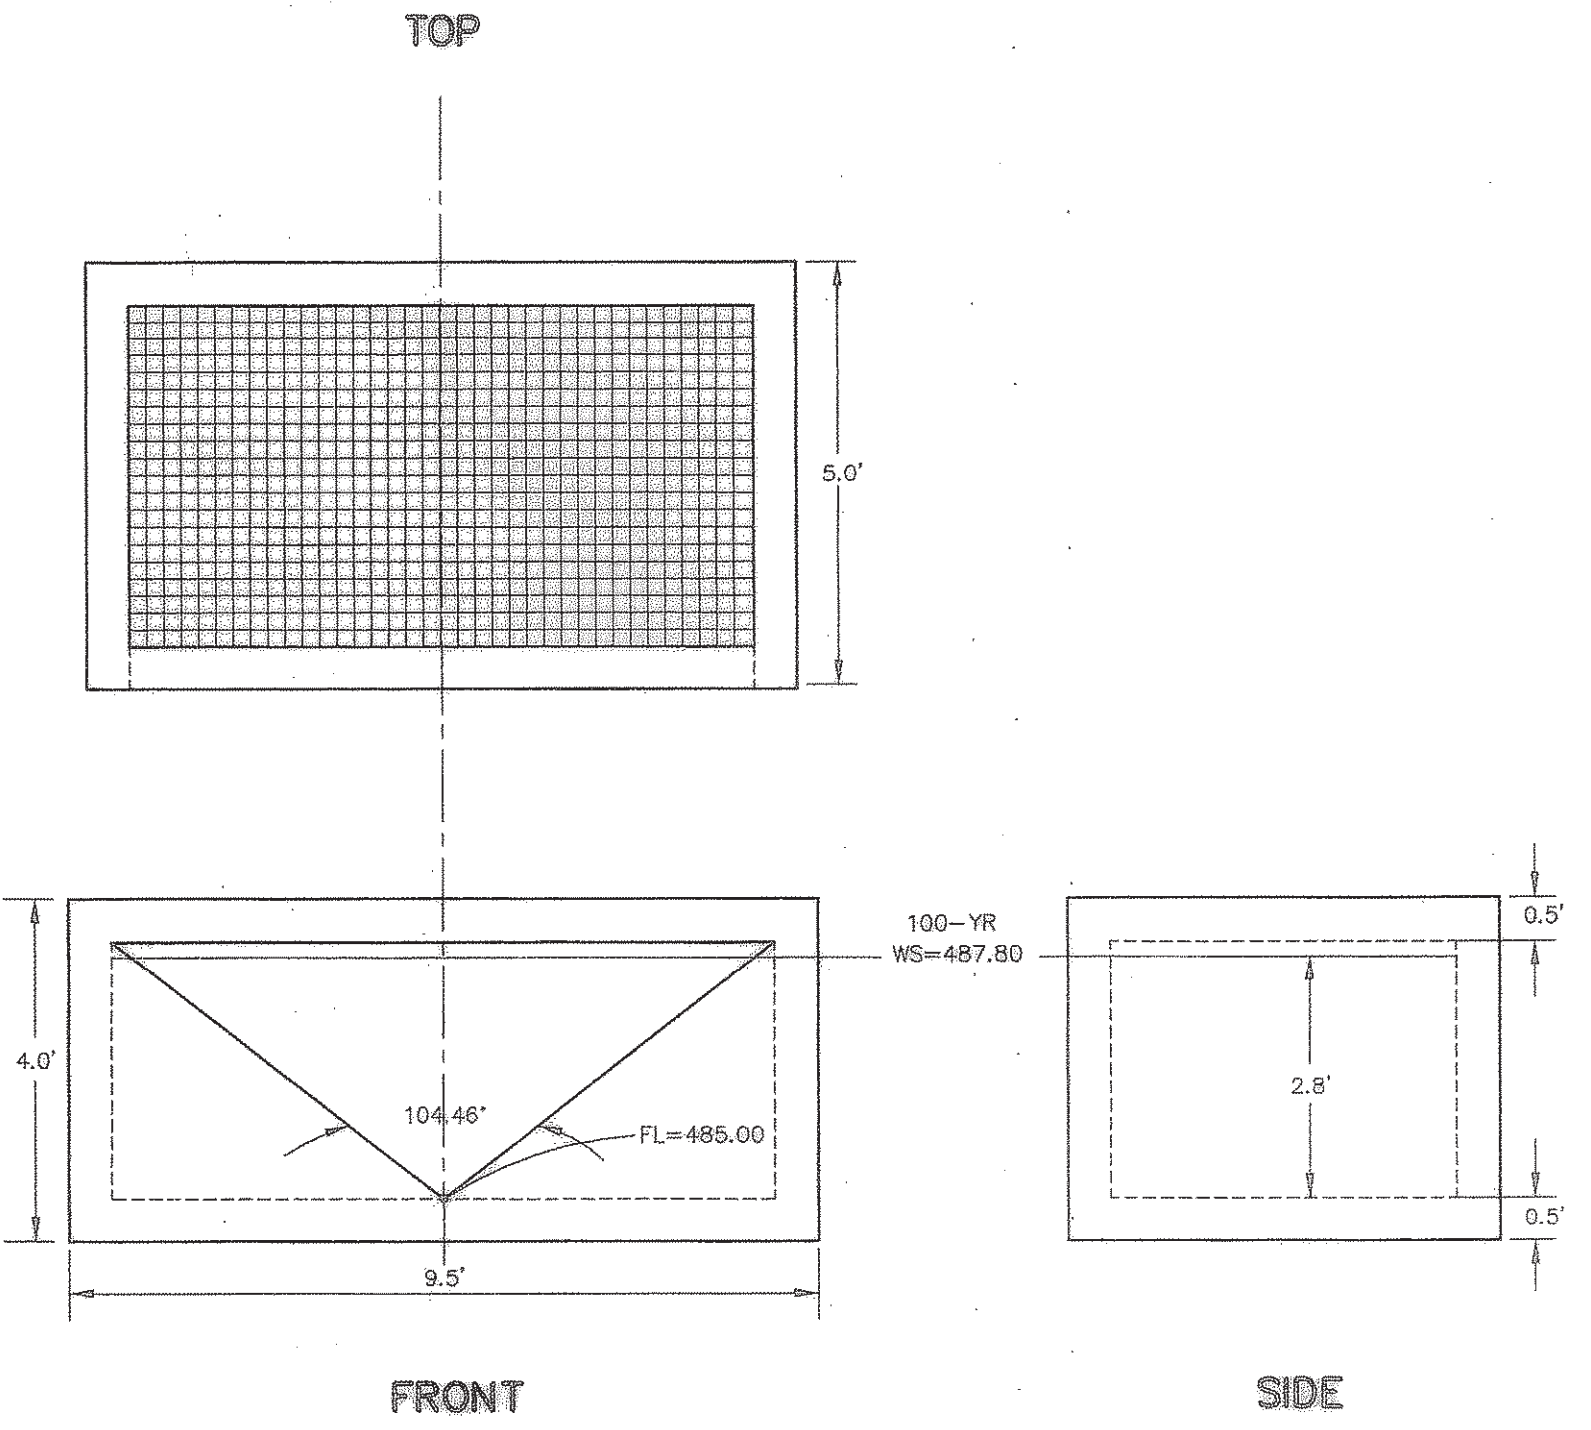

**POND 3  
METERING STRUCTURE**  
N.T.S.

POND DESIGNATION	Tc (min.)	i (in/hr)	A (acres)	C	Q <sub>in</sub> (CFS)	Q <sub>out</sub> (CFS)	VOLUME INFLOW (FT <sup>3</sup> )	VOLUME OUTFLOW (FT <sup>3</sup> )	VOLUME DETAINED (FT <sup>3</sup> )
PRE-DEV.	20	8.3	3.96	0.35	—	11.50	—	—	—
POST-DEV.	10	9.8	3.96	0.8	31.05	11.50	18,627.84	8,627.85	10,000
	20	8.3	3.96	0.8	26.29	11.50	31,553.28	12,078.99	19,474.29
	30	6.86	3.96	0.8	21.73	11.50	39,118.46	15,530.13	23,588.33
	40	5.74	3.96	0.8	18.18	11.50	43,642.37	18,981.27	<b>24,661.1</b>
	50	4.95	3.96	0.8	15.68	11.50	47,044.8	22,432.41	24,612.39
	60	4.37	3.96	0.8	13.84	11.50	49,838.98	25,883.55	23,955.43
	70	3.91	3.96	0.8	12.39	11.50	52,024.9	29,334.69	22,690.21

POND DESIGNATION	Tc (min.)	i (in/hr)	A (acres)	C	Q <sub>in</sub> (CFS)	Q <sub>out</sub> (CFS)	VOLUME INFLOW (FT <sup>3</sup> )	VOLUME OUTFLOW (FT <sup>3</sup> )	VOLUME DETAINED (FT <sup>3</sup> )
PRE-DEV.	20	8.3	44.69	0.35	—	129.80	—	—	—
POST-DEV.	10	9.8	44.69	0.81	354.7	129.80	212,849.50	97,368.34	115,481.20
	20	8.3	44.69	0.81	300.5	129.80	360,541	136,315.7	224,225.4
	30	6.86	44.69	0.81	248.3	129.80	446,984	175,263	271,721
	40	5.74	44.69	0.81	207.8	129.80	498,676	214,210.3	<b>284,465.7</b>
	50	4.95	44.69	0.81	179.2	129.80	537,553.7	253,157.7	284,396
	60	4.37	44.69	0.81	158.2	129.80	569,481.1	292,105	277,376.1
	70	3.91	44.69	0.81	141.5	129.80	594,458.3	331,052.3	263,406

POND DESIGNATION	Tc (min.)	i (in/hr)	A (acres)	C	Q <sub>in</sub> (CFS)	Q <sub>out</sub> (CFS)	VOLUME INFLOW (FT <sup>3</sup> )	VOLUME OUTFLOW (FT <sup>3</sup> )	VOLUME DETAINED (FT <sup>3</sup> )
PRE-DEV.	20	8.3	14.72	0.35	—	42.76	—	—	—
POST-DEV.	10	9.8	14.72	0.82	118.3	42.76	70,973.95	32,071.20	38,902.75
	20	8.3	14.72	0.82	100.2	42.76	120,221.2	44,899.68	75,321.5
	30	6.86	14.72	0.82	82.8	42.76	149,045.3	57,728.16	91,317.14
	40	5.74	14.72	0.82	69.28	42.76	166,281.8	70,556.64	95,725.19
	50	4.95	14.72	0.82	59.75	42.76	179,245.4	83,385.12	<b>95,860.32</b>
	60	4.37	14.72	0.82	52.75	42.76	189,891.5	96,213.6	93,677.93
	70	3.91	14.72	0.82	52.75	42.76	198,220.1	109,042.1	89,178.03

POND DESIGNATION	FREQ. (YR.)	Q EXISTING	Q PROPOSED	Q RELEASED ALLOWABLE	BASED ON STAGE VS. STORAGE CURVE FOR POND		BASED ON RELEASE STRUCTURE	
					CALCULATED STORAGE ELEV. (FT)	CAL. MIN. STORAGE VALUE (FT <sup>3</sup> )	CALCULATED STORAGE ELEV. (FT)	CAL. STORAGE VALUE (FT <sup>3</sup> )
1	100	11.5	31.05	11.5	520.17	24,661	520.17	24,661
	50	10.4	28.2	10.4	519.67	20,864	519.96	23,048
	25	9.01	24.08	9.01	519.41	19,023	519.68	20,938
	10	7.97	20.59	7.97	518.86	15,362	519.46	19,356
	5	6.65	17.74	6.65	518.46	12,973	519.15	17,238
	2	5.13	14.57	5.13	517.94	10,166	518.74	14,633

DETENTION POND VOLUME REQUIRED = 24,661 FT<sup>3</sup>  
DETENTION POND VOLUME PROVIDED = 27,431 FT<sup>3</sup>

POND DESIGNATION	FREQ. (YR.)	Q EXISTING	Q PROPOSED	Q RELEASED ALLOWABLE	BASED ON STAGE VS. STORAGE CURVE FOR POND		BASED ON RELEASE STRUCTURE	
					CALCULATED STORAGE ELEV. (FT)	CAL. MIN. STORAGE VALUE (FT <sup>3</sup> )	CALCULATED STORAGE ELEV. (FT)	CAL. STORAGE VALUE (FT <sup>3</sup> )
2	100	129.8	354.7	129.8	487.9	284,466	487.9	284,466
	50	117.3	322.2	117.3	486.91	240,823	487.56	268,849
	25	101.7	275.1	101.7	486.41	219,841	487.11	249,139
	10	89.94	235.3	89.94	485.35	177,559	486.75	233,806
	5	75.08	202.7	75.08	484.58	149,783	486.24	212,736
	2	57.87	166.5	57.87	483.65	117,398	485.58	186,583

DETENTION POND VOLUME REQUIRED = 284,466 FT<sup>3</sup>  
DETENTION POND VOLUME PROVIDED = 288,711 FT<sup>3</sup>

POND DESIGNATION	FREQ. (YR.)	Q EXISTING	Q PROPOSED	Q RELEASED ALLOWABLE	BASED ON STAGE VS. STORAGE CURVE FOR POND		BASED ON RELEASE STRUCTURE	
					CALCULATED STORAGE ELEV. (FT)	CAL. MIN. STORAGE VALUE (FT <sup>3</sup> )	CALCULATED STORAGE ELEV. (FT)	CAL. STORAGE VALUE (FT <sup>3</sup> )
3	100	42.76	118.3	42.76	487.80	95,860	487.80	95,860
	50	38.64	107.4	38.64	487.41	81,089	487.66	91,598
	25	33.49	91.74	33.49	487.22	74,112	487.53	85,885
	10	29.62	78.46	29.62	486.82	59,920	487.41	81,366
	5	24.73	67.59	24.73	486.56	50,448	487.25	75,411
	2	19.06	55.52	19.06	486.24	39,521	487.02	66,990

DETENTION POND VOLUME REQUIRED = 95,860 FT<sup>3</sup>  
DETENTION POND VOLUME PROVIDED = 144,997 FT<sup>3</sup>

METERING DEVICE

"V" Notched Weir in Detention Wall

$$Q = 0.58 \frac{8}{15} \tan \frac{\Delta}{2} \sqrt{2g} H^{\frac{5}{2}}$$

$$Q = 11.5 \text{ cfs}$$

$$\Delta = 8.57'$$

- Q = 5.12 cfs 2 RELEASE
- Q = 6.52 cfs 3 RELEASE
- Q = 7.81 cfs 10 RELEASE
- Q = 8.81 cfs 25 RELEASE
- Q = 10.19 cfs 50 RELEASE

METERING DEVICE

"V" Notched Weir in Detention Wall

$$Q = 0.58 \frac{8}{15} \tan \frac{\Delta}{2} \sqrt{2g} H^{\frac{5}{2}}$$

$$Q = 129.8 \text{ cfs}$$

$$\Delta = 28.22'$$

- Q = 56.87 cfs 2 RELEASE
- Q = 73.59 cfs 5 RELEASE
- Q = 88.31 cfs 10 RELEASE
- Q = 99.69 cfs 25 RELEASE
- Q = 115.3 cfs 50 RELEASE

METERING DEVICE

"V" Notched Weir in Detention Wall

$$Q = 0.58 \frac{8}{15} \tan \frac{\Delta}{2} \sqrt{2g} H^{\frac{5}{2}}$$


$$Q = 42.76 \text{ cfs}$$

$$\Delta = 104.46'$$

- Q = 18.58 cfs 2 RELEASE
- Q = 24.32 cfs 5 RELEASE
- Q = 28.88 cfs 10 RELEASE
- Q = 32.61 cfs 25 RELEASE
- Q = 37.67 cfs 50 RELEASE

RECORD DRAWINGS AS PROVIDED BY: I.C.S. COMMERCIAL  
MICHAEL S. ALLEN, P.E.  
DATE: 9/25/03

Allen & Ridinger Consulting, Inc.  
109 W. Main Street  
Lansville, Texas 75057  
Tel. No. (972) 353-8000  
Fax No. (972) 353-8011

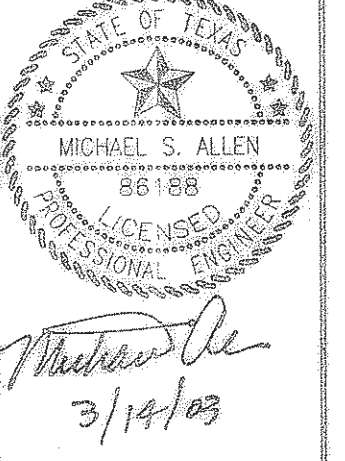

La Jolla Pointe Addition  
ROCKWALL, TEXAS

DRAINAGE DETAILS & DETENTION CALCULATIONS

Scale: NTS  
Designed by: MSA  
Drawn by: MSA  
Checked by: MSA  
Date: March 14, 2003  
Project No. 018-001