

ERIC L. DAVIS ENGINEERING, INC.
120 East Main Street
Forney, Texas 75126
972/564-0592 Fax 972/564-6523
E-Mail ericdavis@eldengineering.com

EROSION CONTROL
ENGINEERED FOR:
HYUNDAI DEALERSHIP

CC: MORGAN GROUP	PLAN: GRADING
ADDITION: ROCKWALL COUNTY	ELD JOB No.:
ADDRESS: 1540 INTERSTATE 30	DRAWN BY: BW
LOT: BLOCK:	FIRM REGISTRATION #: 3987
CITY: ROCKWALL, TEXAS	

SCALE: 1"=20'


SHEET: 3 OF 3

COMMERCE STREET

60' R.O.W. PER CAB. B, SLIDE 323

PERMANENT FILL LOCATION

AS-BUILT

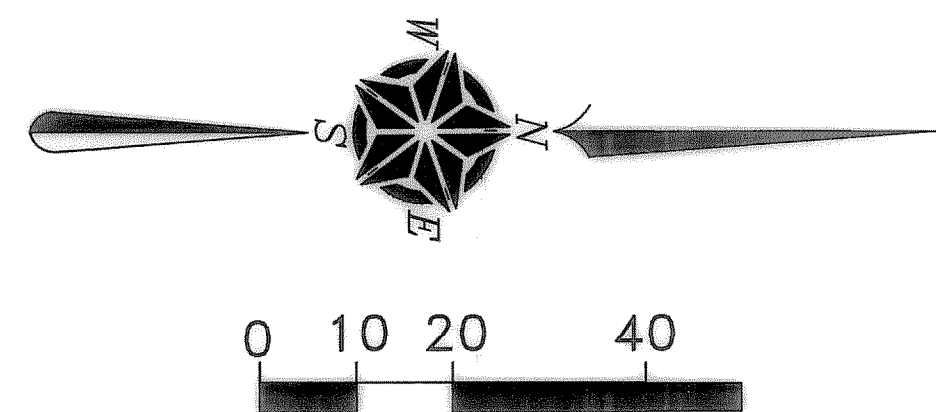

LEGEND	
	SWALE LINE
	PROPOSED GRADE ELEVATIONS
	PROPOSED FLOW DIRECTION
	REMOVE EXISTING ASPHALT
	REINFORCED SILT FENCE

ERIC L. DAVIS
86895
4-25-13

