


Inlet or Station	Pipe Invert Elevation	Length (ft)	Slope of Sewer (ft/ft)	Diam.	Capacity Full (cfs)	Velocity Full (fps)	QD (cfs)	Q/A Velocity (fps)	Hydraulic Gradient (ft/ft)	Kj	Transition Head	Downstrm Hydraulic Grade Elevation	Upstream Hydraulic Grade Elevation	Velocity Head (ft)	Total Energy Elevation (ft)	Top of Pipe Elevation	Pipe Surcharge
OUT	519.80	10	26.00%	2	115.34	36.7	13.2	10.0	1.93%	0.60		520.24	520.24	1.55	521.79	521.80	-1.56
CI-1	522.40	28	2.14%	2	33.11	10.5	11.9	10.4	2.09%	0.60	0.55	522.84	522.84	1.68	524.52	524.40	-1.56
CI-2	523.00									0.60		523.42			525.00		-1.58

0 15 30 60

SCALE IN FEET

— 4.43 — PROPOSED CONTOUR  
 - - 4.43 - - EXISTING CONTOUR  
 ← DRAINAGE DIRECTION

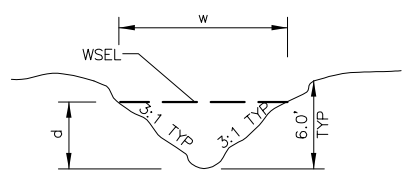

SECTION "A"  
EXISTING DITCH N.T.S.

DITCH FLOW CAPACITIES

$p=6.45$   
 $a=3.12$   
 $r=0.48$   
 $s=0.056$   
 $Q_d = 1.486 / .032(a)(r)^{2/3} (s)$   
 $Q_d = 20.9$  cfs  
 $V_d = 6.8$  fps  
 $d = 1.02$  ft  
 $w = 6.2$  ft  
 des=Existing 100 YR PEAK FLOW

Existing Drainage Area Calculations

Drainage Area	Area (Ac.)	Tc (Min.)	$I_{100}$ (in/hr)	C	$Q_{100}$ (cfs)
1	0.55	20	8.3	0.35	1.6
2	1.13	20	8.3	0.35	3.3
3	0.71	10	9.8	0.50	3.5
4	0.15	10	9.8	0.90	1.3
5	0.96	10	9.8	0.55	5.2
6	0.29	10	9.8	0.55	1.6
7	0.89	10	9.8	0.50	4.4
8	0.88	10	9.8	0.50	4.3

Sag Inlets Computation Data for Existing Condition

Inlet ID	Inlet Type	Length (ft)	Grate Perim (ft)	Area (sf)	Total Q (cfs)	Inlet Capacity (cfs)	Total Head (ft)	Ponded Head (ft)	Width Left (ft)	Width Right (ft)
CI-1	Curb-Sag	5.0	n/a	n/a	1.30	6.26	0.17	4.20	4.25	
CI-2	Curb-Sag	10.0	n/a	n/a	5.10	10.33	0.32	7.25	7.30	


ID	SHAPE	MATERIAL	RISE	BARRELS	LENGTH	SLOPE	US FL	DS FL	HW ELEV	TW ELEV	VELOCITY	DISCHARGE
CULVERT 1	CIRC	CONCRETE	36"	1	100'	7.9%	503.0	495.1	505.3	496.1	18.6 fps	25.9cfs



NOTE: TO THE BEST OF OUR KNOWLEDGE ERIC L. DAVIS ENGINEERING, INC., HEREBY STATES THAT THIS PLAN IS AS-BUILT. THE INFORMATION PROVIDED IS BASED ON SURVEYING CONDUCTED AT THE SITE AND INFORMATION PROVIDED BY THE CONTRACTOR.

TBM: TOP OF 10' CURB INLET ON INDEPENDENCE PLACE ELEV=528.12

REVISION	DATE	BY

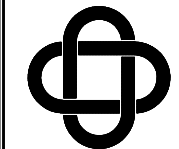

ERIC L. DAVIS ENGINEERING, INC.  
 425 Pinson Road Ste. C  
 Forney, Texas 75126  
 972/564-0592 Fax 972/564-6523  
 ericdavis@eldengineering.com

EXISTING DRAINAGE AREA MAP  
 INDEPENDENCE PASS  
 OF ROCKWALL, ROCKWALL CO, TEXAS

DEVELOPER: HANSON PROPERTIES, INC.  
 1400 WINDYBROOK DRIVE  
 ROCKWALL, TX 75087  
 (214) 977-3177

JOB NO.: 084-01  
 DRAWN BY: GT  
 CHECKED BY: ML  
 DATE: 04-06-07

AS-BUILT



SCALE: 1"=30'  
 SHEET 1 OF 1  
 SHEET 6