


Install: 250 L.F. of 12" PVC Drain Pipe

DRAINAGE PROFILES
REPLAT OF LOT 2 INDUSTRIAL ADDITION
ROCKWALL, TEXAS

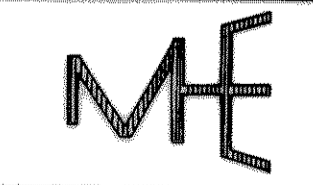

MORRISON HYDROLOGY/ENGINEERING, INC.
 520 AVENUE H EAST, SUITE 102
 ARLINGTON, TEXAS 76011 METRO 817-640-4554

REVISION NO.	REMARKS	DATE

DESIGNED:	R. W. M.	SCALE:	1" = 20' HOR. & 1" = 5' V.
DRAWN:	R. W. M.	APPROVED:	
JOB NO:		DATE:	4/93
		SHEET NO.:	4 OF 5

