

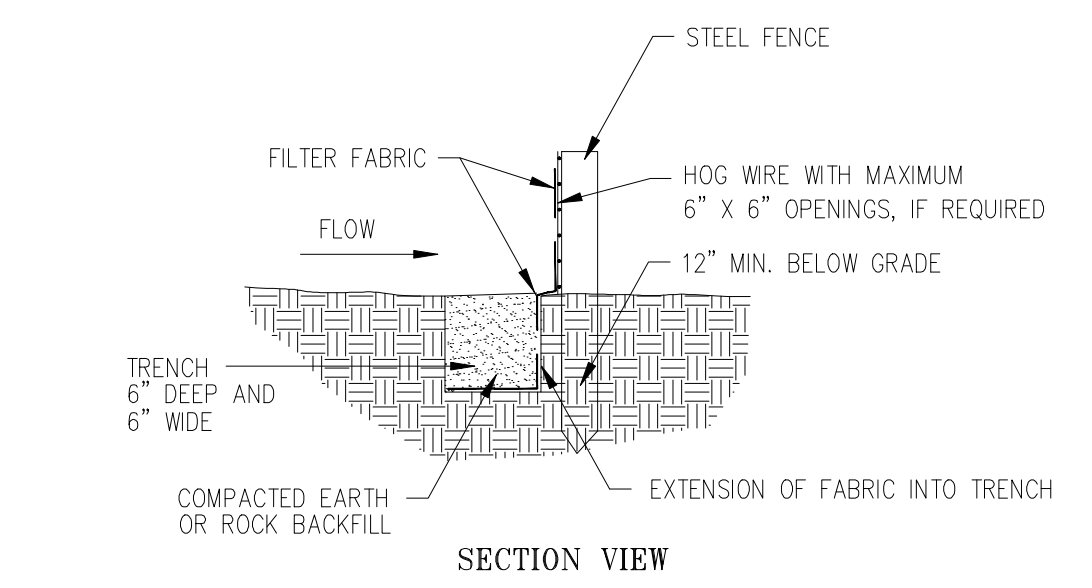
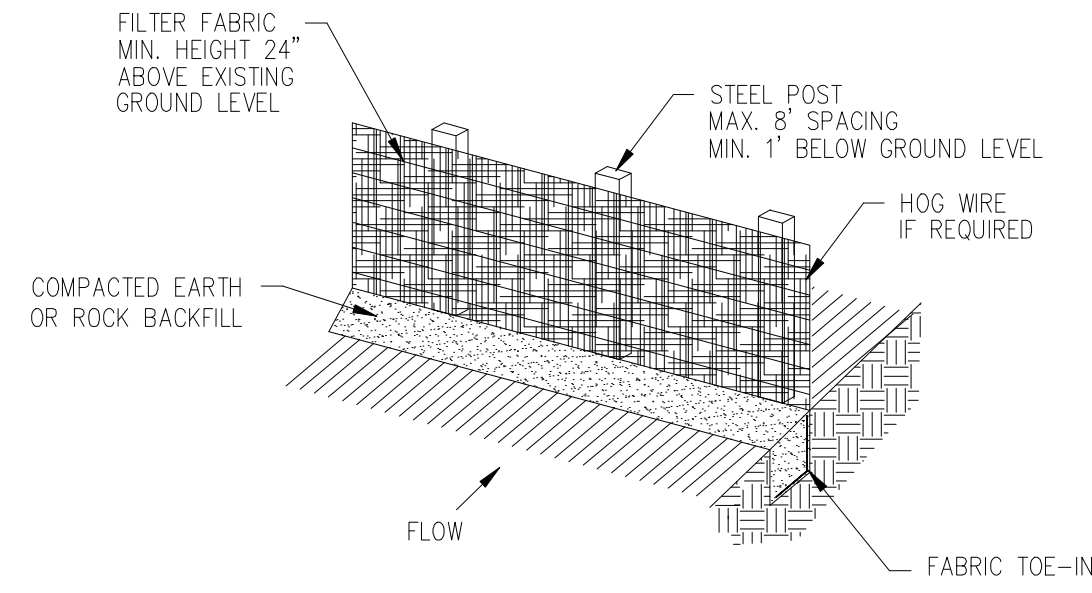


Inlet Protection – Curb

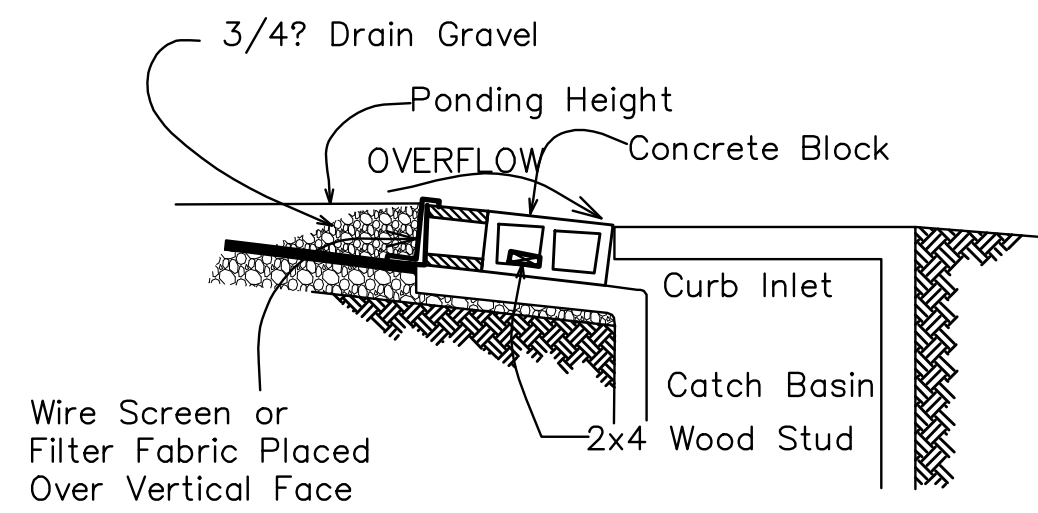

SILT FENCE
N.T.S.

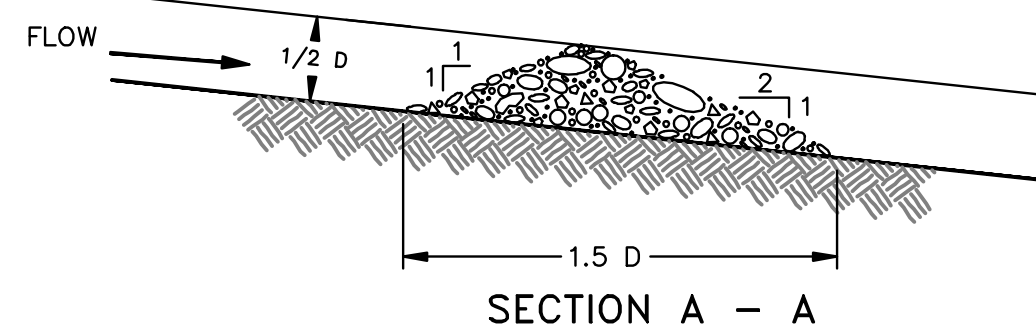



ROCK CHECK DAM
N.T.S.

CONSTRUCTION NOTES

1. CONTRACTOR WILL INSTALL ADDITIONAL EROSION CONTROL WHERE EROSION PROTECTION IS NEEDED AS PER THE OWNERS ENGINEERS, OR THE CITY'S INSPECTORS.
2. THE EXISTING VEGETATION ALONG EXISTING ROADWAYS SHALL BE REPLACED TO ITS ORIGINAL CONDITIONS OR BETTER.

EROSION CONTROL PLAN STANDARD GENERAL NOTES

1. EROSION CONTROL DEVICES AS SHOWN ON THE EROSION CONTROL PLAN FOR THE PROJECT SHALL BE INSTALLED PRIOR TO THE START OF LAND DISTURBING ACTIVITIES ON THE PROJECT.
2. ALL EROSION CONTROL DEVICES ARE TO BE INSTALLED IN ACCORDANCE WITH THE APPROVED PLANS AND SPECIFICATIONS FOR THE PROJECT. CHANGES ARE TO BE APPROVED BEFORE CONSTRUCTION BY THE DESIGN ENGINEER AND THE CITY'S ENGINEERING DIVISION.
3. IF THE EROSION CONTROL PLAN AS APPROVED CANNOT CONTROL EROSION AND OFF-SITE SEDIMENTATION FROM THE PROJECT, THE EROSION CONTROL PLAN WILL BE REQUIRED TO BE REVISED AND/OR ADDITIONAL EROSION CONTROL DEVICES WILL BE REQUIRED ON SITE.
4. IF OFF-SITE SOIL BORROW OR SPOIL SITES ARE USED IN CONJUNCTION WITH THIS PROJECT, THIS INFORMATION SHALL BE DISCLOSED AND SHOWN ON THE EROSION CONTROL PLAN. OFF-SITE BORROW AND SPOIL AREAS ARE CONSIDERED A PART OF THE PROJECT SITE AND THEREFORE SHALL COMPLY WITH THE CITY'S EROSION CONTROL REQUIREMENTS. THESE AREAS SHALL BE STABILIZED WITH PERMANENT GROUND COVER PRIOR TO FINAL APPROVAL OF THE PROJECT.
5. CONTRACTOR TO RE-VEGETATE ALL DISTURBED AREAS IMMEDIATELY UPON THE COMPLETION OF GRADING ACTIVITIES. 75% TO 80% OF ALL DISTURBED AREAS TO HAVE GRASS A MIN. OF 1 INCH TALL PRIOR TO ENGINEERING ACCEPTANCE.
6. NO PUBLIC ACCEPTANCE UNTIL VEGETATION IS ESTABLISHED ON ALL DISTURBED AREAS.

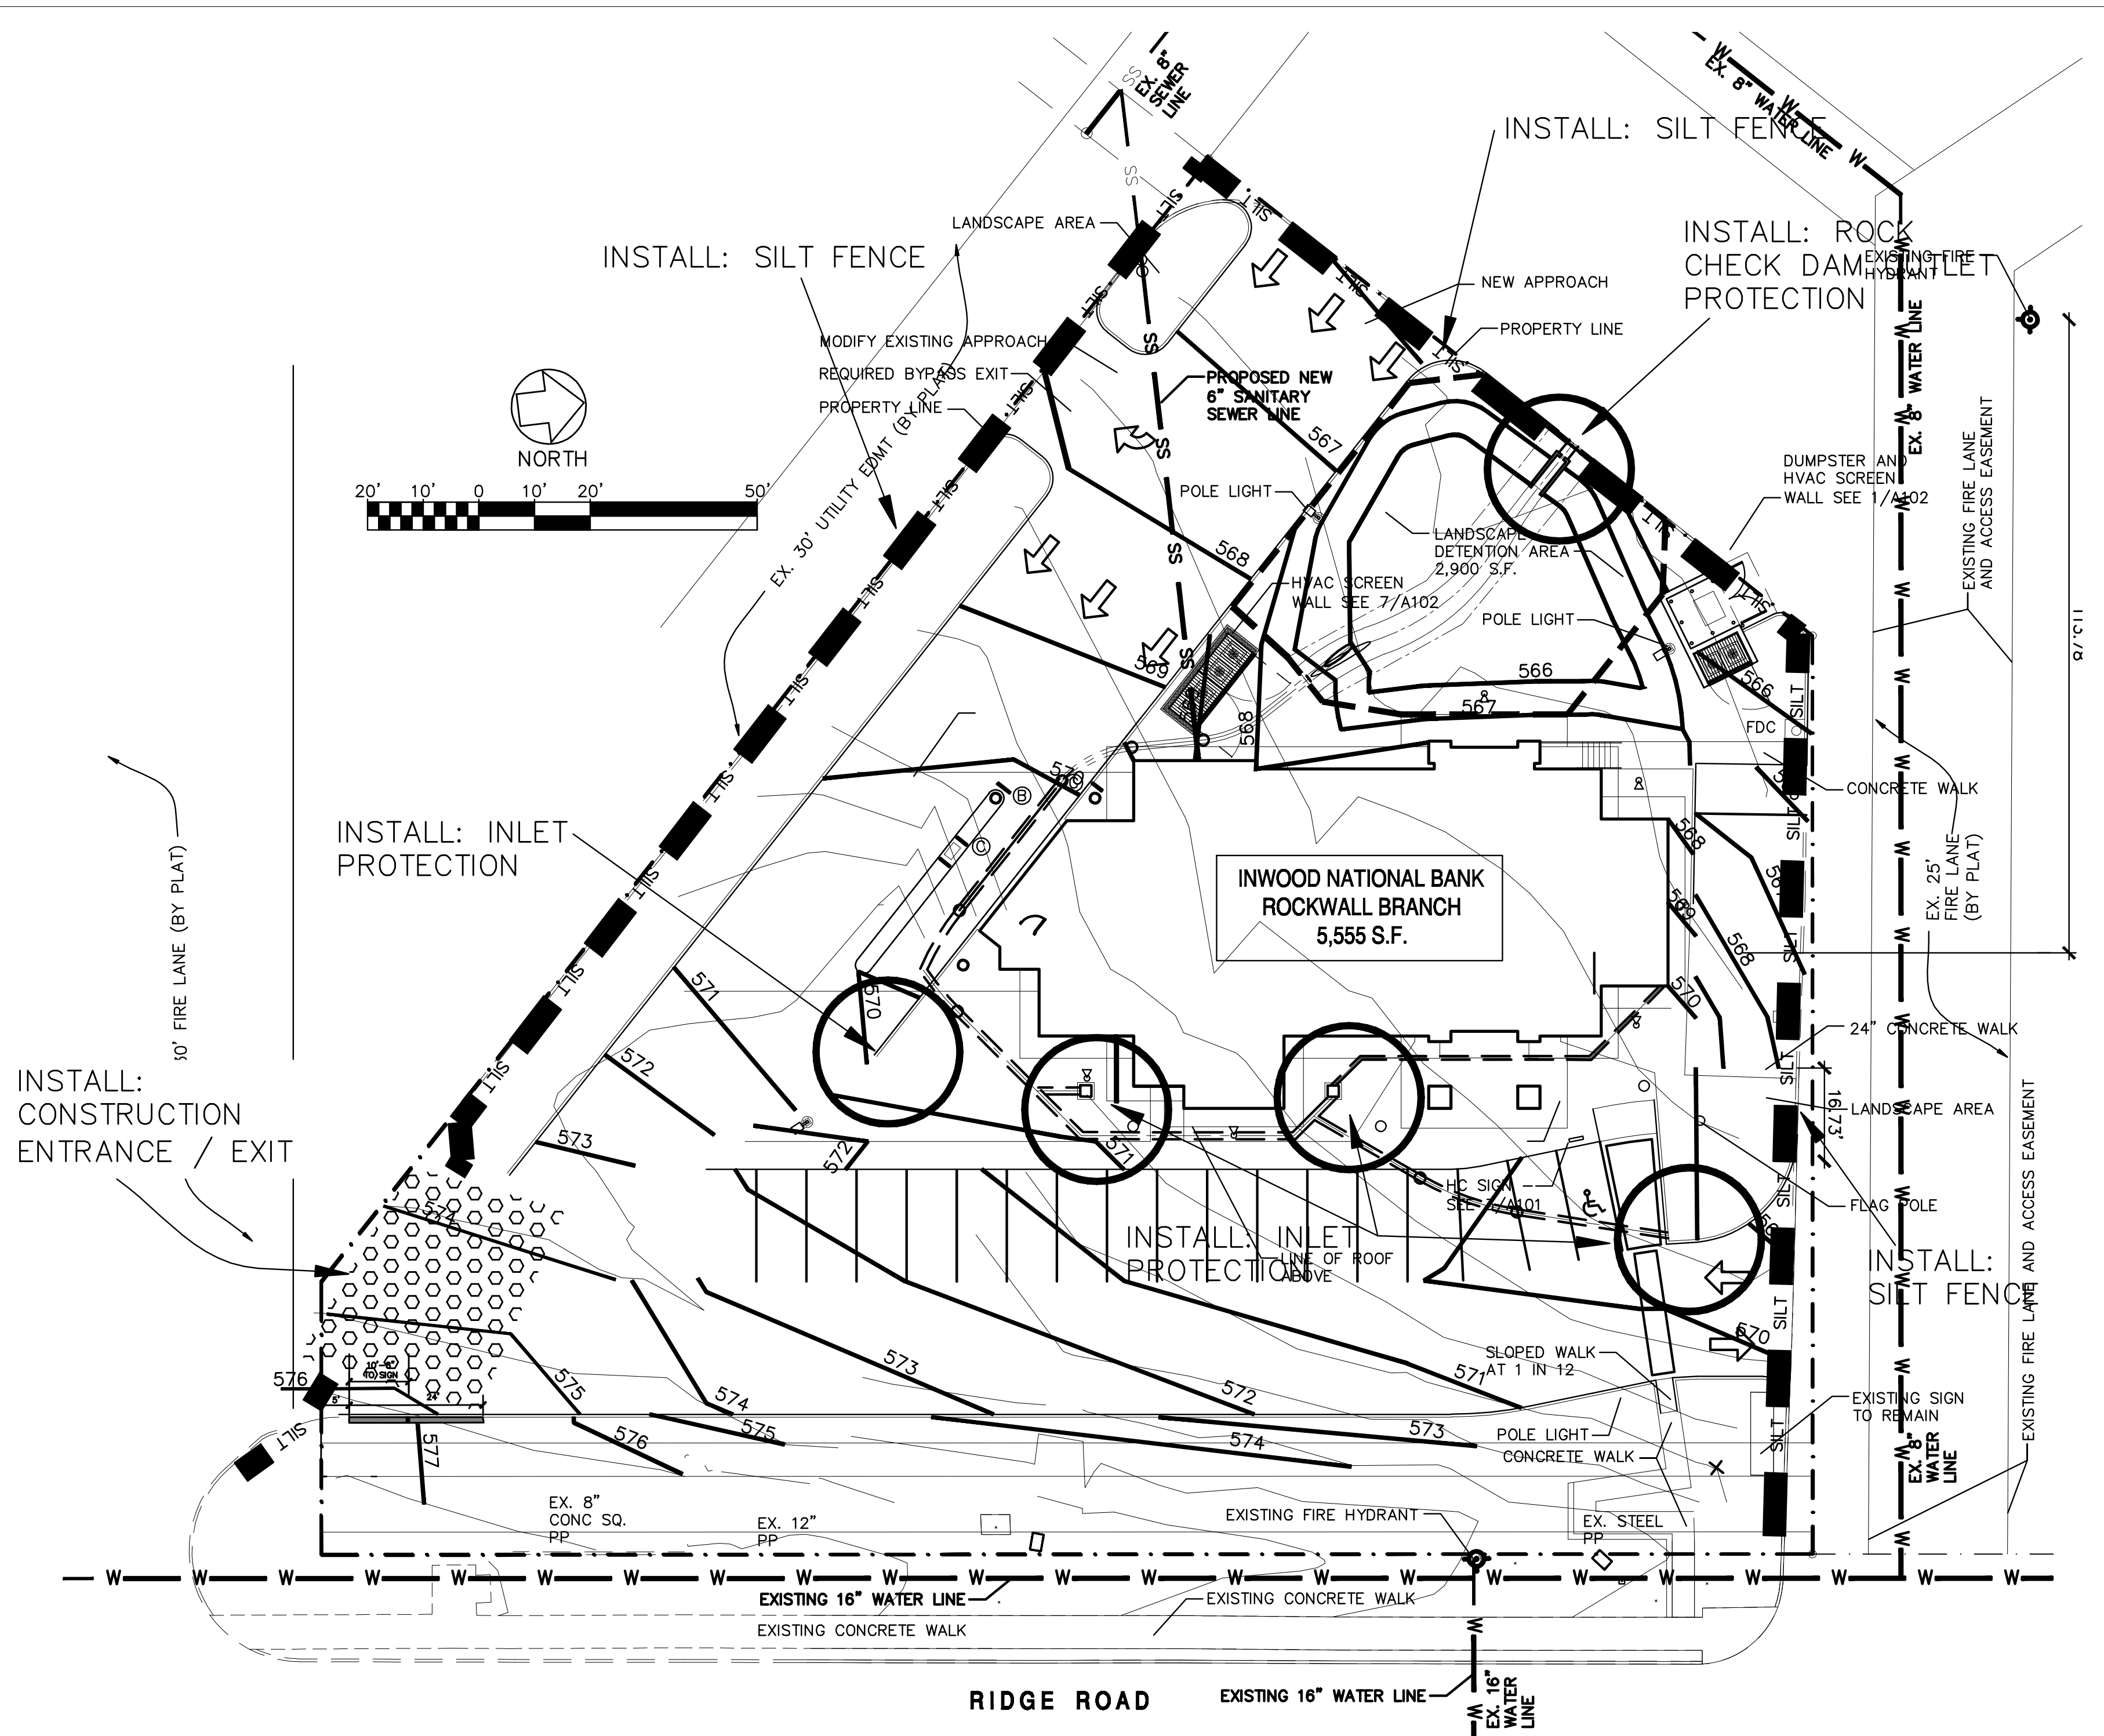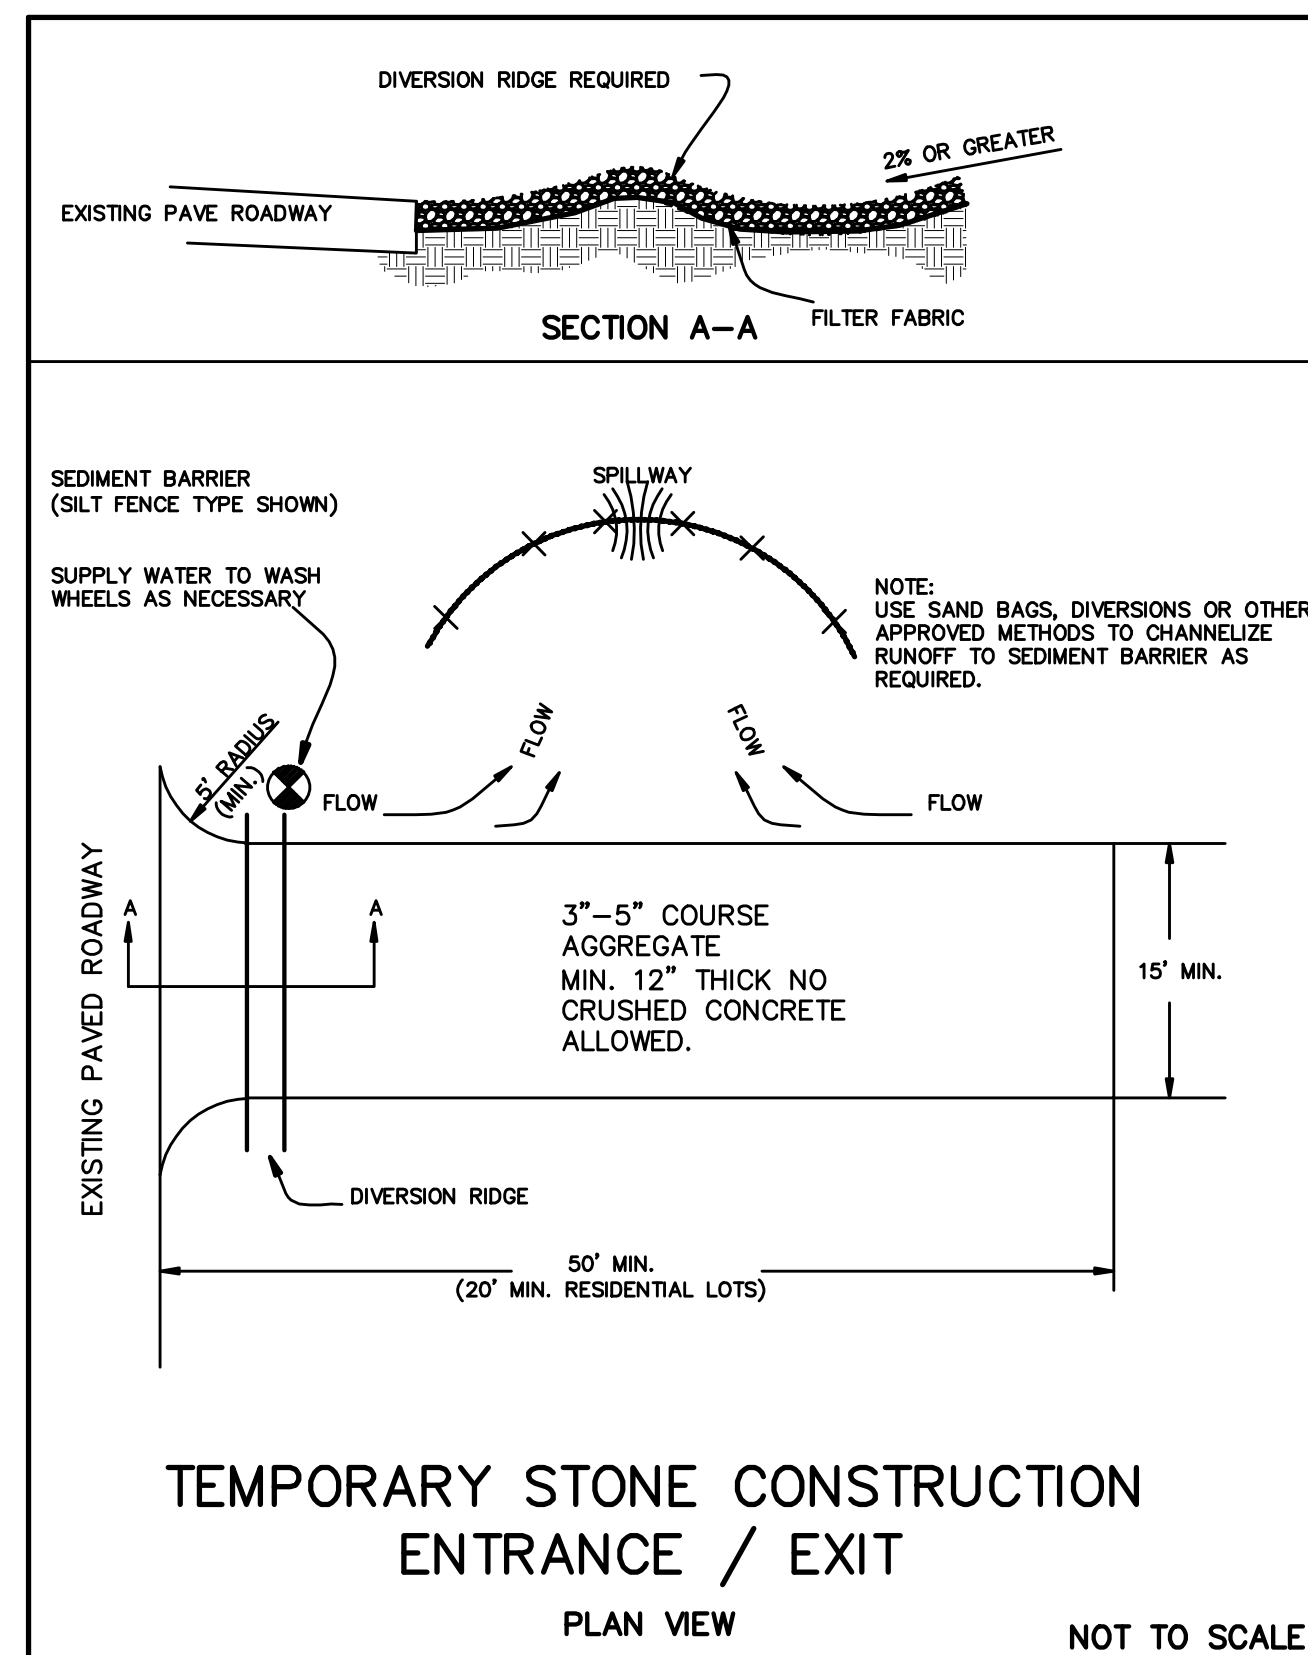

NO.	DATE	REVISION	BY
		REFLECTS CITY COMMENTS THROUGH 12-11-12	MNP

RECORD DRAWINGS 12-19-13

EROSION CONTROL PLAN
INWOOD NATIONAL BANK
CITY OF ROCKWALL, TEXAS

MP MICHAEL PEEPLES 1930 E. Rosemeade Suite 205
Engineers and Planners Carrollton, Texas 75007
Firm Number: F-3754 (214) 731-9948

DATE PLOTTED: 12/23/2013 DRAWN BY: MNP
DRAWING NO. SCALE: AS SHOWN

EC-1