

"THE NEW HORIZON"

ALLEY CONSTRUCTION PLANS

FOR

ALLEY/FIRELANE IMPROVEMENTS

JACK CANUP ADDITION


LOT 1 & 2, BLOCK A

IN THE


CITY OF ROCKWALL, TEXAS

SHEET INDEX

Sheet No.	Description
1	Cover Sheet
C1	Dimension/Grading Plan
C2	Drainage Area Map
C3	Erosion Control

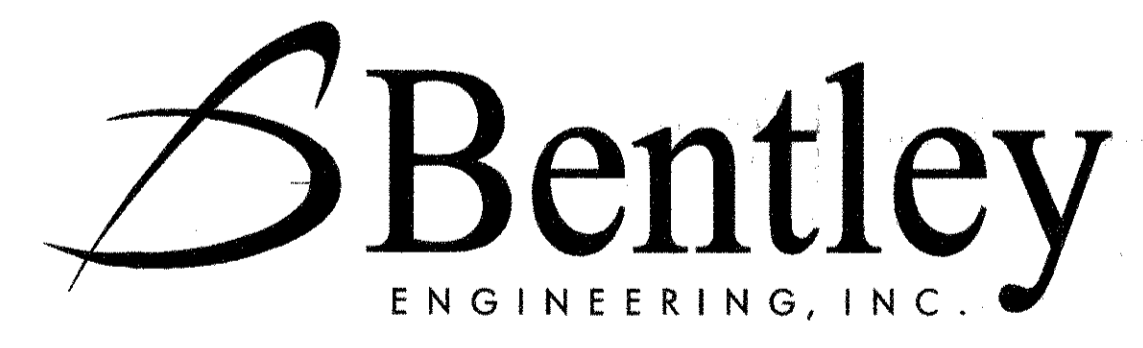

P. O. BOX 26
 ROCKWALL, TEXAS 75087
 PH: 972.771.2124
 FIRM REG. NO. F-674

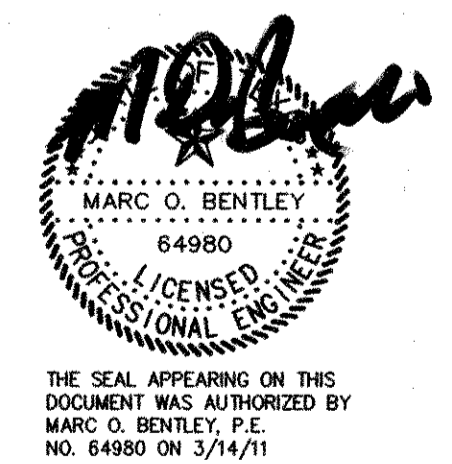

OWNER:
 DR. JOERG WHITTENBERG
 C/O ELMA PONDER
 REGAL REALTORS
 3125 RIDGE ROAD
 ROCKWALL, TX 75032
 OFFICE: 214.629.9756

SEPTEMBER 2011

RECORD DRAWING

TO THE BEST OF OUR KNOWLEDGE, BENTLEY ENGINEERING, INC. HEREBY STATES THAT THIS PLAN IS AS-BUILT. THIS INFORMATION IS BASED ON SURVEYING AT THE SITE AND INFORMATION PROVIDED BY THE CONTRACTOR.

DATE: DECEMBER 15, 2011