


TYPICAL PAVING SECTION

BENCH MARK
Top nut of F.H. in Joe White St. - 240'
south of intersection with Stimson St.
Elev. 527.07

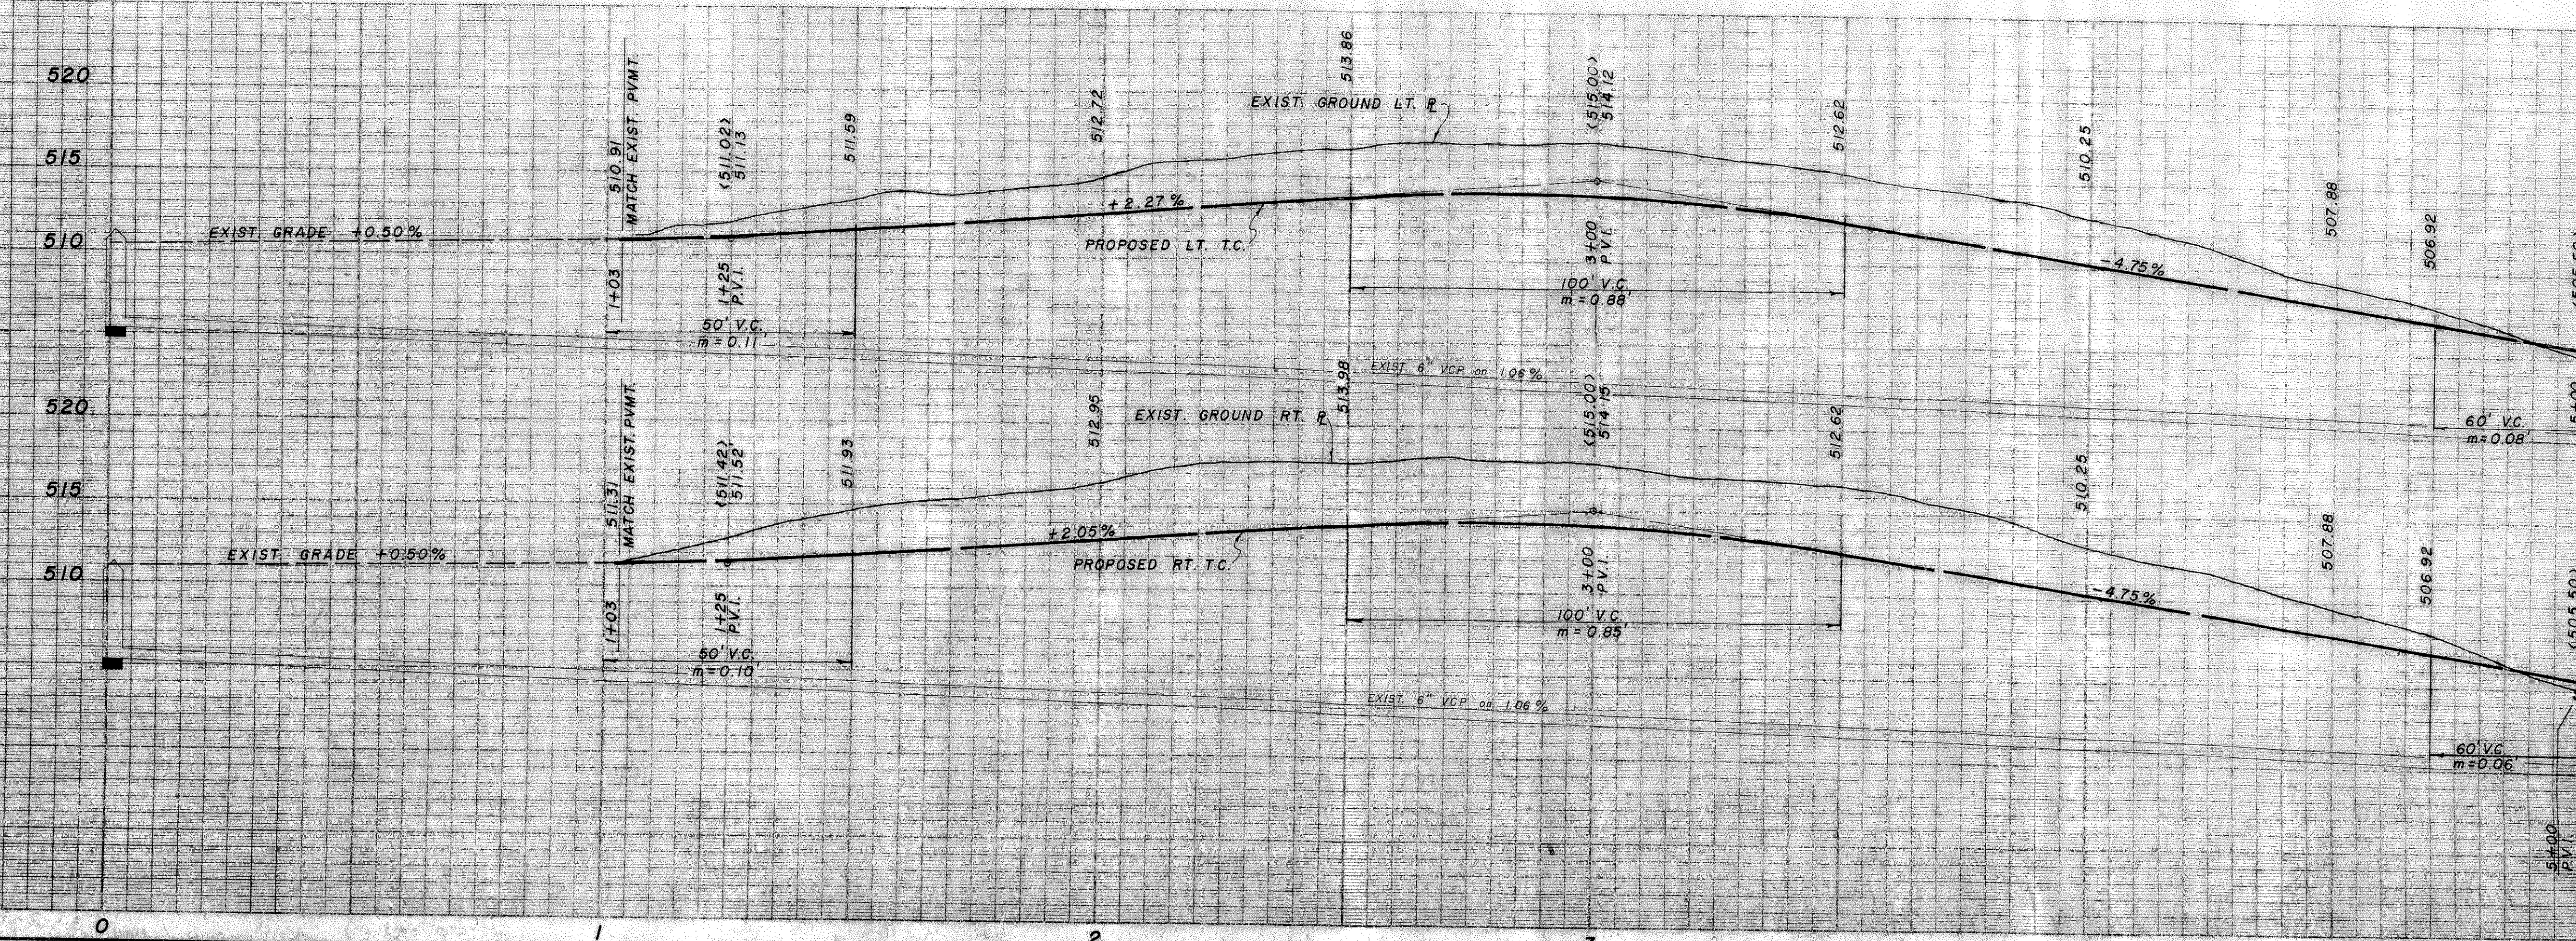

AS BUILT

WADE ADDITION						
PROPOSED PAVING & WATER						
STIMSON STREET						
COWAN & CAIN DEVELOPMENTS						
ROCKWALL, TEXAS						
DESIGN	DRAWN	DATE	SCALE	NOTES	FILE	NO.
HLE		5/73	1"=20'H. 1/2"=6'V.			7302