


THE SEAL APPEARING ON THIS DOCUMENT WAS AUTHORIZED BY W.L. DOUPHRETE II TEXAS P.E. NO. 60102 ON 1/8/84

DOUPHRETE & ASSOCIATES, INC.
 ENGINEERING - PROJECT MANAGEMENT - SURVEYING
 2235 RIDGE RD., # 200 ROCKWALL, TEXAS 76087
 PHONE: (972)771-9004 FAX: (972)771-9005

DRAINAGE AREA MAP
 JUSTIN DRIVE PROFESSIONAL PARK, LTD.
 5.31 AC.
 CITY OF ROCKWALL, ROCKWALL COUNTY, TEXAS

REVISION	W.L.D.
CHECKED	AC
DRAWN	3/5/01
DATE	0028DAM
PROJECT	4 OF 13

AREA	ACRES	C	I ₁₀₀	Q ₁₀₀
1	1.86	.80	9.8	14.58
2	1.42	.80	9.8	11.13
3	0.39	.80	9.8	3.06
4	0.63	.80	9.8	4.93
4A	0.25	.80	9.8	1.96
5	0.16	.80	9.8	1.25
6	1.01	.35	8.3	2.93
7A	3.56	.35	8.3	10.34
7B	0.47	.35	8.3	1.36
8A	0.17	.35	8.3	0.49
8B	1.74	.35	8.3	5.05
9	0.27	.80	9.8	2.11
10	0.30	.80	9.8	2.35
UNDEV ALLOWABLE	12.23	.35	8.3	35.53

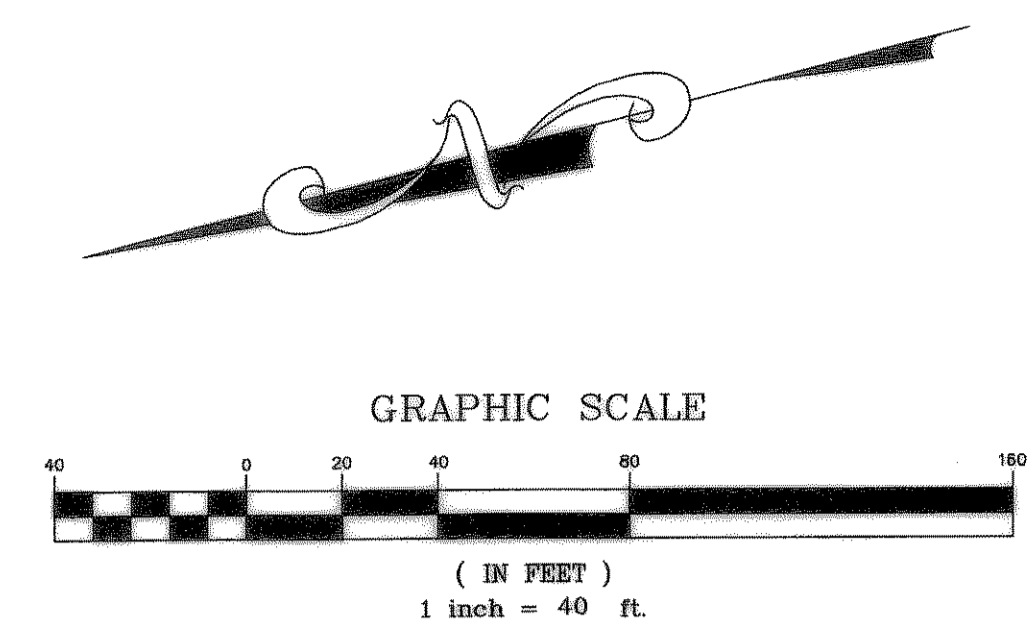

WHITEFORD
 VOL. 695, PG. 92

B.R. & R.B. CAMERON
 VOL. 108, PG. 837

LOT 2A
 BLOCK A
 AUTOZONE, INC.
 CAB. D, SLIDES 65 & 66

ROCKWALL COUNTY
 CENTRAL APPRAISAL DISTRICT
 LOT 1A
 BLOCK A

JUSTIN DRIVE
 (60' R.O.W.)

R=970.00'
 L=304.86'
 T=153.70'
 D=18°00'27"

RECORD DRAWING
 THIS DRAWING HAS BEEN REVISED TO REFLECT CONSTRUCTION RECORDS MAINTAINED AND PROVIDED BY THE CONTRACTOR FOR THIS PROJECT.