


ROCKWALL COUNTY  
 CENTRAL APPRAISAL DISTRICT  
 LOT 1A  
 BLOCK A

B.R. & R.B. CAMERON  
 VOL. 108, PG. 837

WHITEFORD  
 VOL. 695, PG. 92

LOT 2A  
 BLOCK A  
 AUTOZONE, INC.  
 CAB. D, SLIDES 65 & 66

PROPOSED BERM CROSS SECTION

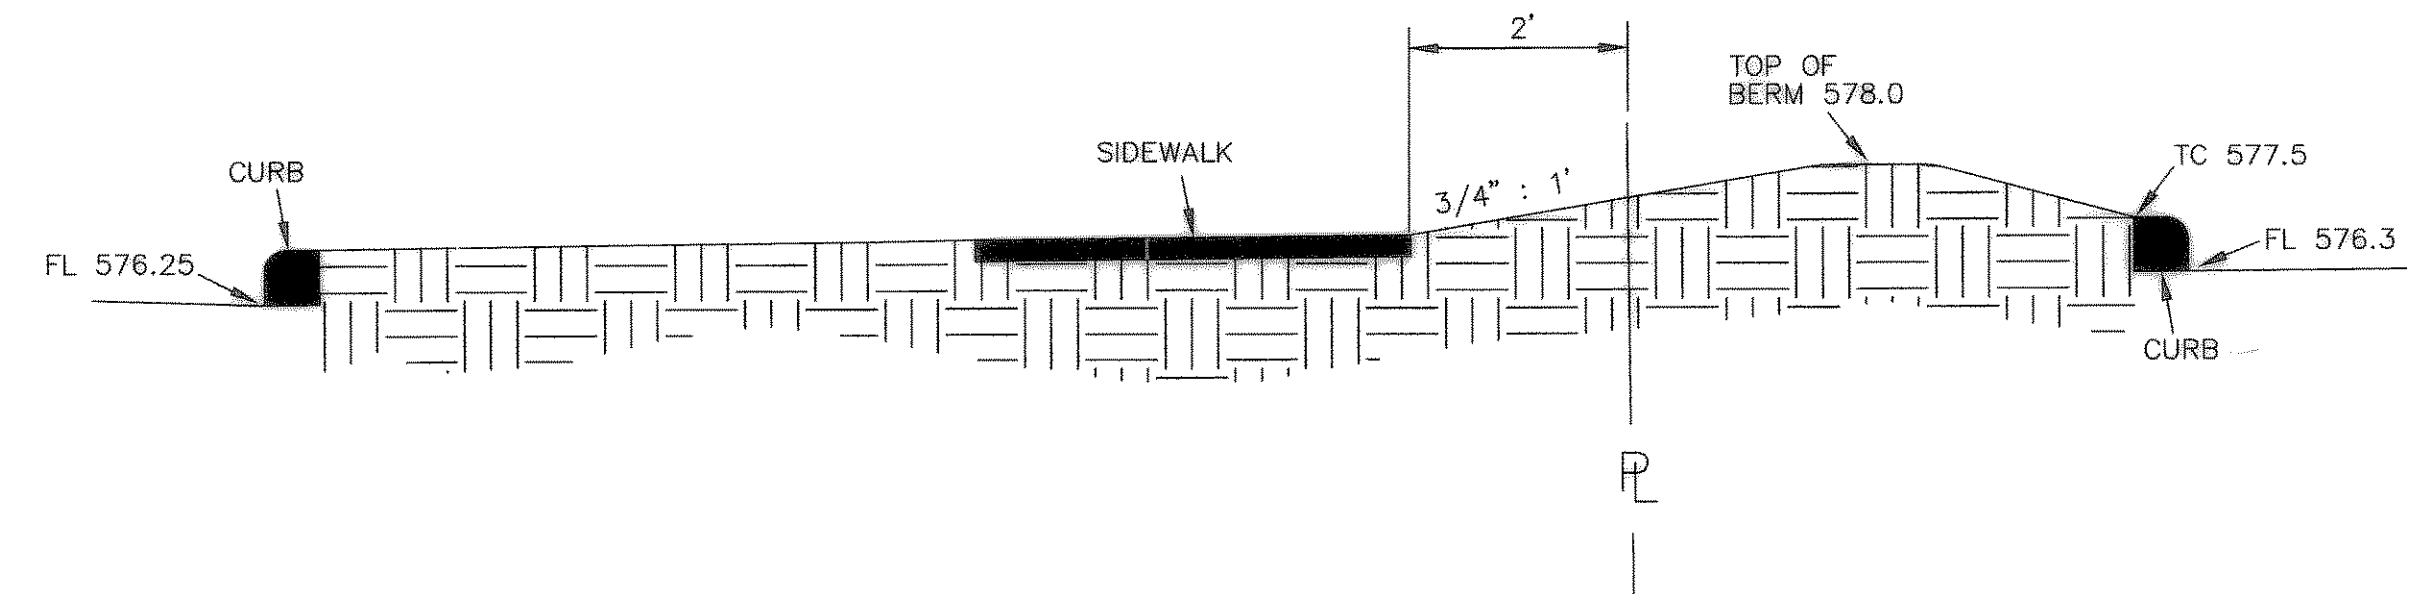

NOTE:  
 -ALL DETENTION PONDS SHALL HAVE SECURITY FENCE SURROUNDING EDGE OF PONDS.  
 -CURB STOPS SHALL BE INSTALLED IN NEEDED AREAS (NEAR PONDS OR WALLS)

NOTE: 555.55 = GUTTER ELEVATION  
 555.55 = TOP OF CURB ELEVATION  
 ① = DETENTION WALL ELEVATION NUMBER

DETENTION WALL GRADING CHART		
#	TOP OF WALL	BOTTOM OF WALL
1	575.20	572.07
2	575.20	572.11
3	575.55	572.15
4	575.75	572.19
5	575.55	572.25
6	576.50	572.19
7	576.35	572.14
8	576.21	572.09
9	576.06	572.04
10	575.92	571.99
11	575.69	571.90
12	574.60	571.28
13	575.08	570.78
14	575.08	570.78
15	574.60	571.20
16	575.10	571.90
17	572.02	568.50
18	572.02	568.70
19	572.02	568.50
20	572.02	568.50
21	572.02	568.50

RECORD DRAWING  
 THIS DRAWING HAS BEEN REVISED TO REFLECT CONSTRUCTION RECORDS MAINTAINED AND PROVIDED BY THE CONTRACTOR FOR THIS PROJECT.