


THE SEAL APPEARING ON THIS DOCUMENT WAS AUTHORIZED BY W.L. DOUPHRATE II, TEXAS, P.E. NO. 80102 ON 9/8/04


**DOUPHRATE & ASSOCIATES, INC.**  
ENGINEERING - PROJECT MANAGEMENT - SURVEYING  
2235 RIDGE RD., # 200 ROCKWALL, TEXAS 75087  
PHONE: (972) 771-9004 FAX: (972) 771-9005

**UTILITY PLAN**  
**JUSTIN DRIVE PROFESSIONAL PARK, LTD.**  
CITY OF ROCKWALL, ROCKWALL COUNTY, TEXAS  
5.31 AC.

4/11/01 REV. PER CITY MARKUPS
REVISION
W.L.D. CHECKED
AC DRAWN
3/5/01 DATE
0028 UTIL PROJECT
11 OF 13

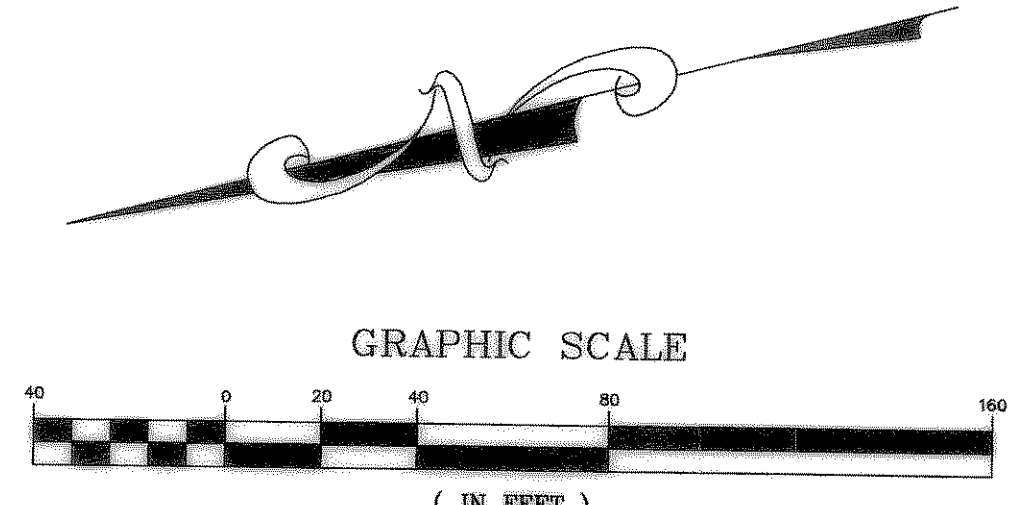

B.R. & B. CAMERON  
VOL. 108, PG. 837

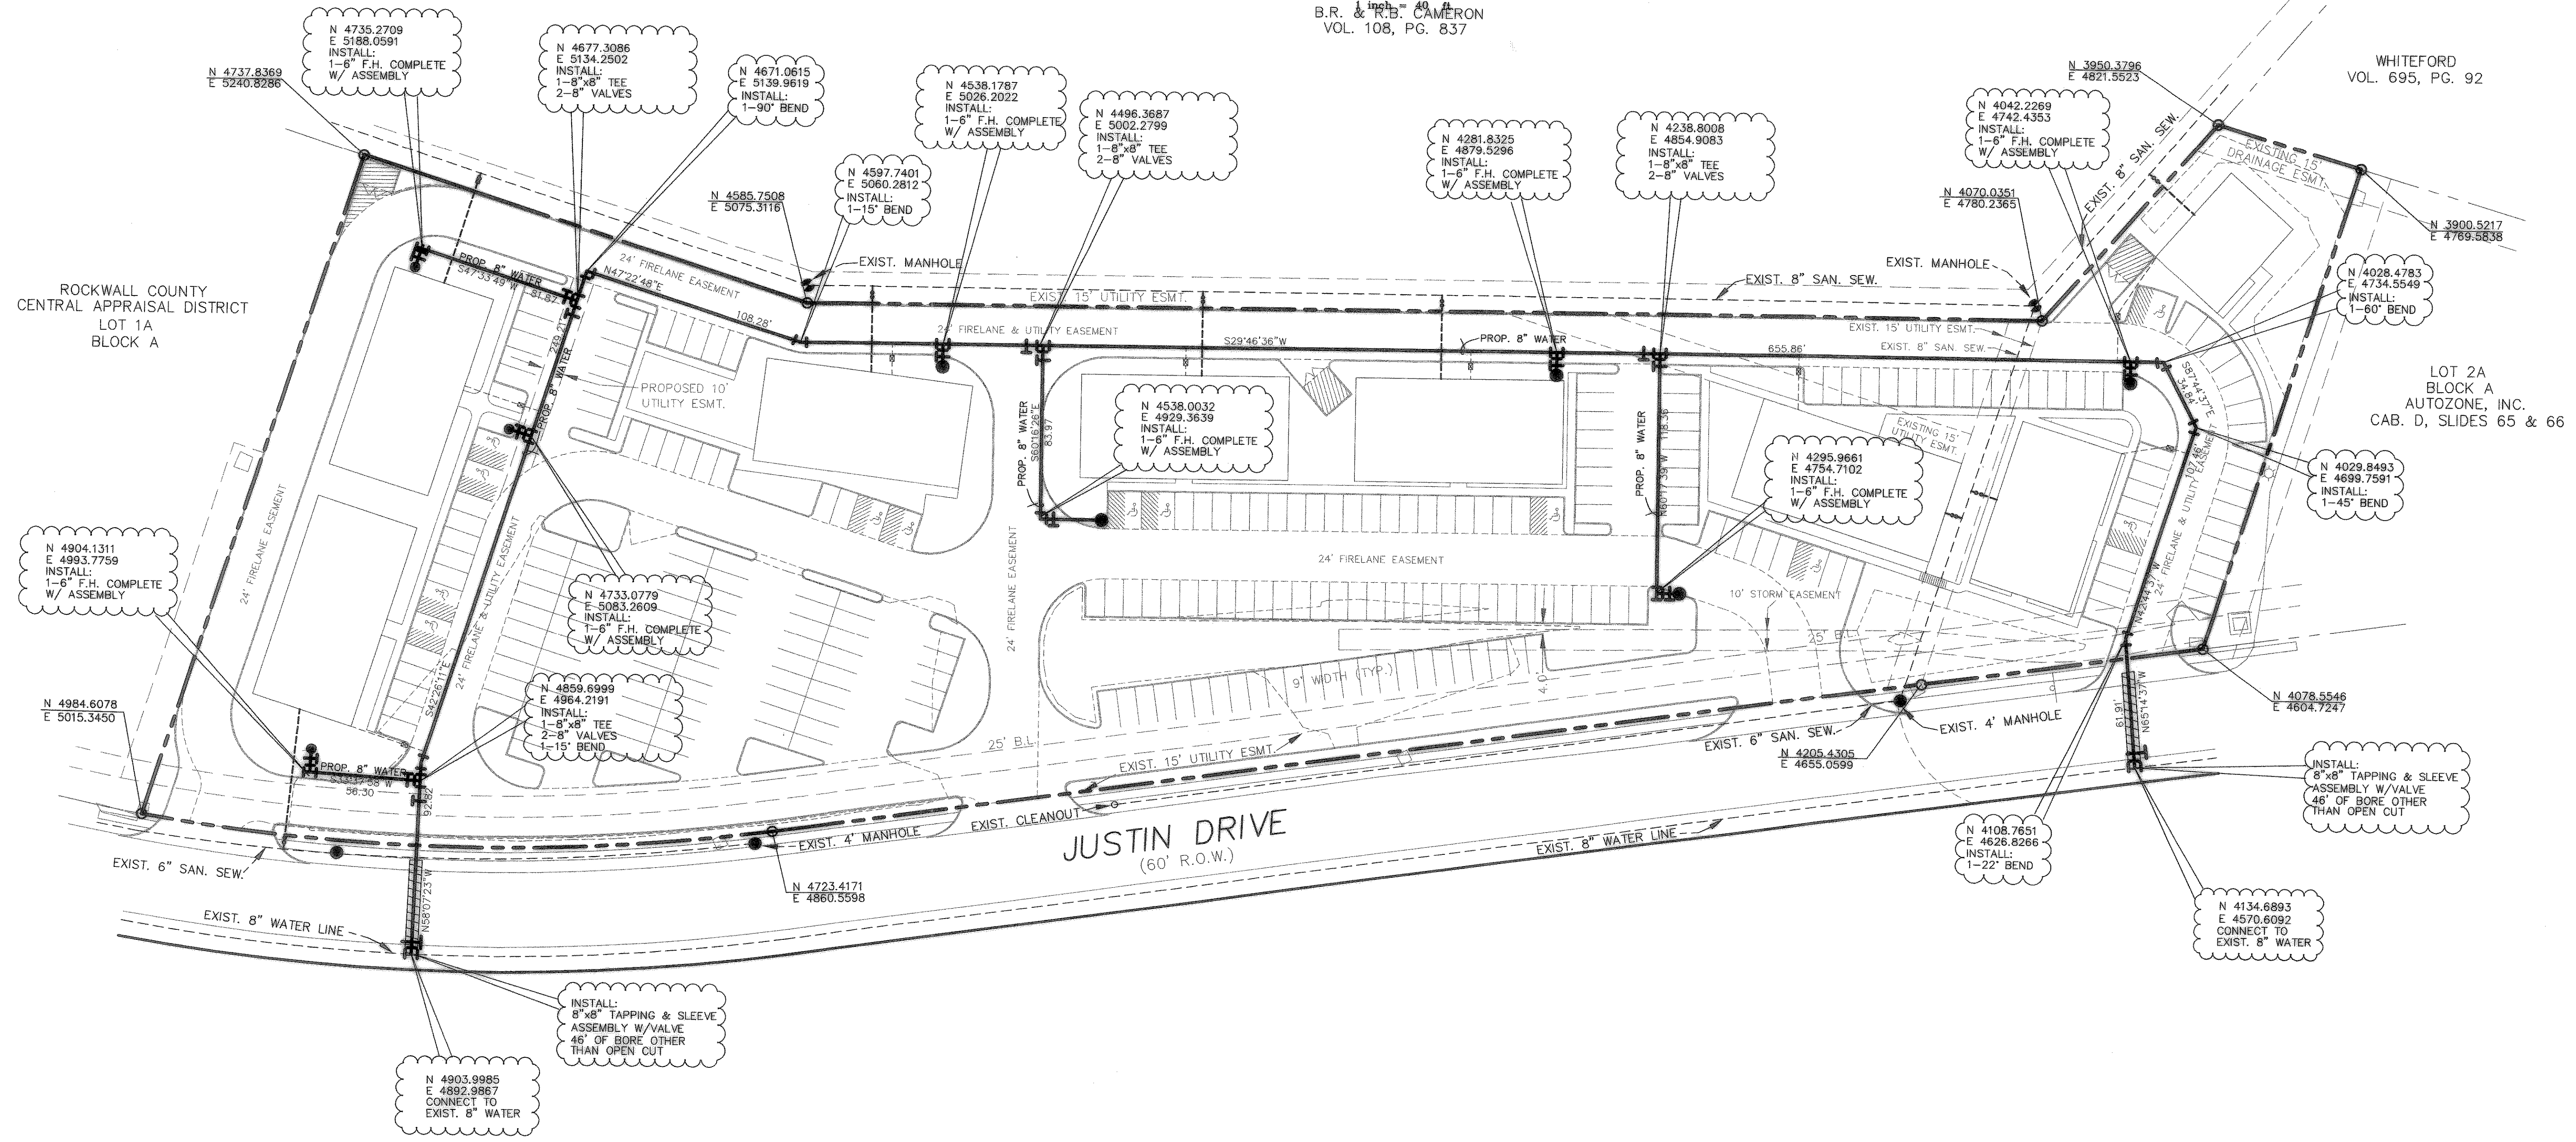

**RECORD DRAWING**  
THIS DRAWING HAS BEEN REVISED TO REFLECT CONSTRUCTION RECORDS MAINTAINED AND PROVIDED BY THE CONTRACTOR FOR THIS PROJECT.

- LEGEND**
- 6" PROPOSED WASTE WATER SERVICES (PRIVATE) (DBL. CLEANOUTS AT EASEMENT OR ROW LINES)
  - 2" PROPOSED WATER SERVICES W/METER BOX
  - METER BOX
  - DOUBLE CLEANOUT

**OWNER/DEVELOPER**  
JUSTIN DRIVE PROFESSIONAL PARK, LTD.  
500 TURTLE COVE BLVD. SUITE 210  
ROCKWALL, TEXAS 75087  
(972) 772-1027

**ENGINEER/SURVEYOR**  
DOUPHRATE & ASSOCIATES, INC.  
P.O. BOX 1336  
ROCKWALL, TEXAS 75087  
(972) 771-9004