

THE CITY OF ROCKWALL, TEXAS

CONSTRUCTION PLANS

FOR



OFFSITE WATER IMPROVEMENTS

TO SERVE

JOHN KING BOULEVARD

(AIRPORT ROAD TO JUSTIN ROAD)

ROCKWALL COUNTY, TEXAS

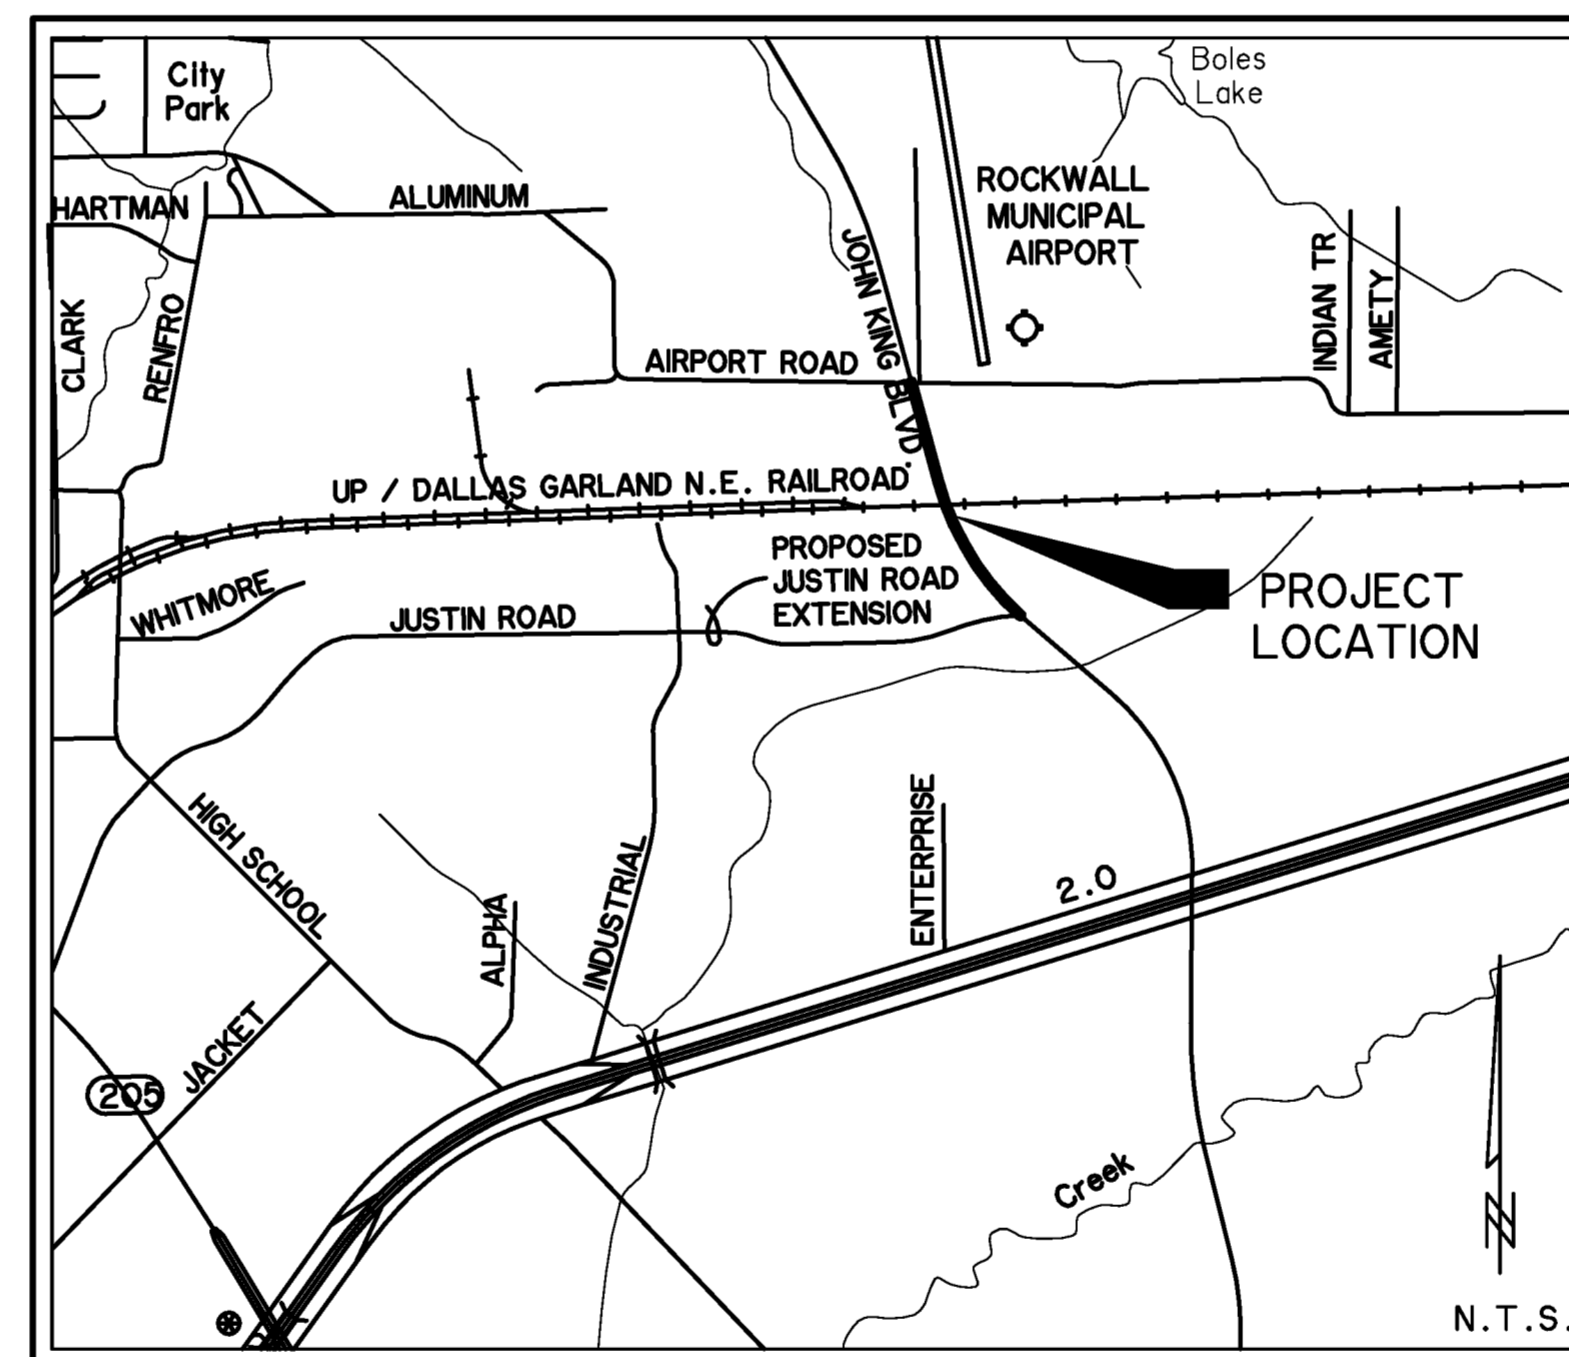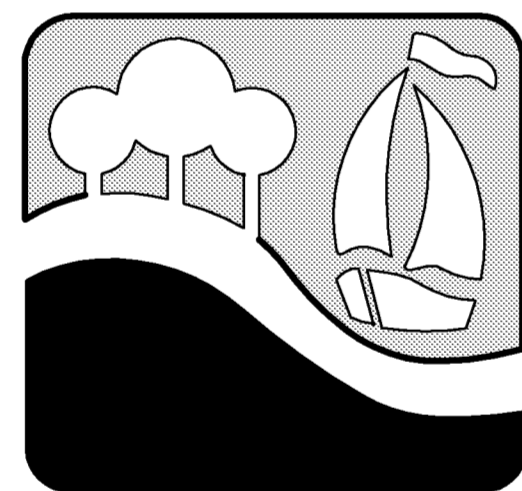

VICINITY MAP



PREPARED BY:
WIA WIER & ASSOCIATES, INC.
ENGINEERS SURVEYORS LAND PLANNERS
701 HIGHLANDER BLVD., SUITE 300 ARLINGTON, TEXAS 76015 METRO (817)467-7700
Texas Firm Registration No. F-2776 www.WierAssociates.com

SHEET INDEX

SO01	COVER SHEET TOPOGRAPHIC LEGEND AND SHEET QUANTITIES
U101-U104 U201	OFFSITE WATER LINE PLANS 16" WATER LINE W-4 PLAN & PROFILES WATER SYSTEM DETAILS
E101-E102 E201-E202	STORM WATER POLLUTION PREVENTION EROSION CONTROL PLANS EROSION CONTROL DETAILS

CITY OF ROCKWALL STANDARD DETAIL SHEETS INCORPORATED
HEREIN BY REFERENCE.

RECORD PLANS MAY 1, 2015

NOTE:

- 1.) ALL REFERENCES TO "CITY" SHALL MEAN "CITY OF ROCKWALL".
- 2.) ALL CONSTRUCTION SHALL BE IN ACCORDANCE WITH THE CITY OF ROCKWALL AND NORTH TEXAS COUNCIL OF GOVERNMENT STANDARD SPECIFICATIONS THIRD EDITION.

DAVID SWEET - MAYOR

COUNCIL MEMBERS

DAVID WHITE - Mayor Pro Tem

JIM PRUITT

BENNIE DANIELS

DENNIS LEWIS

SCOTT MILDER

MIKE TOWNSEND

RICK CROWLEY - City Manager

PRINTED: 5/1/2015 5TB FILE: WIER-PAVING.STB LAST SAVED: 4/21/2015 4:11 PM SAVED BY: CLAYTON FILE: OFFSITE-WATER-LEGEND-13096.DWG

EXISTING TOPOGRAPHIC LEGEND	
	ASPHALT PAVEMENT
	BOLLARD/GUARD POST
	DIMENSION TO BACK OF CURB
	CABLE TV
	CONTROL MONUMENT
	CONCRETE
	EDGE OF ASPHALT PAVEMENT
	ELEC BOX (GROUND)
	ELEC METER
	FIRE HYDRANT
	FIBER OPTIC CABLE
	GAS METER
	GAS MANHOLE
	GAS TEST STATION
	GUY WIRE
	CONCRETE HEADWALL
	IRRIGATION CONTROL VALVE
	IRON ROD FOUND
	IRON ROD SET
	LIGHT POLE
	POWER POLE
	POWER POLE W/LIGHT
	STORM DRAIN MANHOLE
	SPRINKLER HEAD
	SIGN
	SANITARY SEWER MANHOLE
	SANITARY SEWER CLEANOUT
	SOUTH WESTERN BELL TELEPHONE
	TELEPHONE PEDESTAL
	TELEPHONE SWITCH GEAR
	TRAFFIC SIGNAL BOX
	TRAFFIC SIGNAL POLE
	TRAFFIC SIGNAL CONTROLLER
	TRANSFORMER PAD
	WATER METER
	WATER VALVE
	OVERHEAD ELECTRIC LINE
	UNDERGROUND ELECTRIC LINE
	WATER LINE
	SANITARY SEWER LINE
	FIBER OPTIC LINE
	UNDERGROUND TELEPHONE
	OVERHEAD TELEPHONE
	UNDERGROUND GAS
	EXISTING CONCRETE STORM DRAIN LINE
	EXISTING CORRUGATED METAL STORM DRAIN LINE
	EXISTING FLOWLINE
	BARBED WIRE FENCE
	CHAIN LINK FENCE
	WOOD FENCE
	GUARD RAIL / BARRICADE
	EXISTING TREE LINE
	EXISTING TREE

WATER & SANITARY SEWER PLAN LEGEND	
	PROPOSED 18" OR LARGER WATER MAIN
	PROPOSED 16" OR SMALLER WATER MAIN
	FUTURE 18" OR LARGER WATER MAIN
	FUTURE 16" OR SMALLER WATER MAIN
	PROPOSED GATE VALVE
	PROPOSED REDUCER
	PROPOSED WATER METER
	PROPOSED FIRE HYDRANT
	PROPOSED AIR RELEASE VALVE OR BLOW-OFF VALVE
	PROPOSED 18" OR LARGER SANITARY SEWER
	PROPOSED 15" OR SMALLER SANITARY SEWER
	FUTURE 18" OR LARGER SANITARY SEWER
	FUTURE 15" OR SMALLER SANITARY SEWER
	PROPOSED SANITARY SEWER MANHOLE
	PROPOSED SANITARY SEWER CLEANOUT


EROSION CONTROL LEGEND	
	LIMITS OF OPERATOR DAY TO DAY OPERATIONAL CONTROL
	PROPOSED SWALE
	INDICATES STABILIZED CONSTRUCTION ENTRANCE
	INDICATES UN-REINFORCED SILT FENCE
	INDICATES REINFORCED SILT FENCE
	INDICATES ROCK BERM
	INDICATES DROP INLET PROTECTION
	INDICATES PROPOSED INLET TREATMENT
	CURLEX EROSION CONTROL BLANKET
	INDICATES SEDIMENT TRAP OUTLET CONTROL DEVICE
	EXISTING CONTOUR LINE
	PROPOSED CONTOUR LINE

WATER QUANTITIES							
ITEM No.	DESCRIPTION	SHEET UNITS	TOTAL QUANTITY	U101	U102	U103	U104
101	6" Water Main C-900 Class 200 PVC	LF	40	20	20		
102	16" Water Main C-905 Class 200 DR 18 PVC	LF	1,454	400	380	500	174
103	16" Water Main C-905 Class 200 DR 18 PVC by Bore	LF	120		120		
104	6" Gate Valve	EA	2	1	1		
105	16" Butterfly Valve	EA	4	1	1	2	
106	12"x12" Tapping Sleeve & Valve	EA	1	1			
107	Make Dry Connection to 16" Water Main by Separate Contract	EA	1				1
108	Fire Hydrant Assembly	EA	2	1	1		
109	6" Blow-off Assembly	EA	1	1			
110	2" Air Release Valve	EA	2	1		1	
111	2" Irrigation Water Service Tap & Corporation Stop	EA	1	1			
112	26" Steel Casing Pipe	LF	120		120		
113	Ductile Iron Fittings	TON	3.9	1.5	0.7	1.6	0.1
114	4" PVC Steel Casing Pipe Vents	EA	2		2		
115	Railroad Crossing R.O.W. Marker Sign	EA	2		2		
116	Trench Safety	LF	1,518	420	400	524	174
117	Erosion Control Measures	LS	1				
118	8" Water Main C-900 Class 200 PVC	LF	15			15	
119	8" Gate Valve	EA	3			3	


**RECORD PLANS
MAY 1, 2015**

REVISIONS			
NO.	DESCRIPTION	DATE	BY
1	REVISED LEGEND & QUANTITIES	4/16/14	PLG
2	CHANGED 16" G.V. TO BUTTERFLY VALVES	4/21/14	PLG
3	REVISED QUANTITIES	8/13/14	PLG

PREPARED BY:
WIER & ASSOCIATES, INC.
 ENGINEERS SURVEYORS LAND PLANNERS
 701 HIGHLANDER BLVD., SUITE 300 ARLINGTON, TEXAS 76015 METRO (817)467-7700
 www.wierassociates.com
 Texas Firm Registration No. F-2776

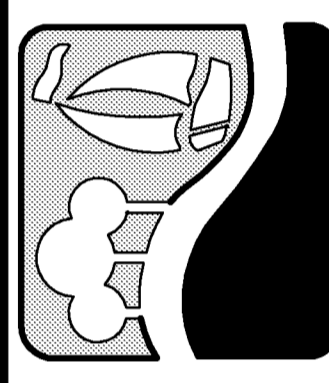

**JOHN KING BOULEVARD
FROM AIRPORT ROAD
TO JUSTIN ROAD
OFFSITE WATER LINE
TOPOGRAPHIC LEGEND
& SHEET QUANTITIES**

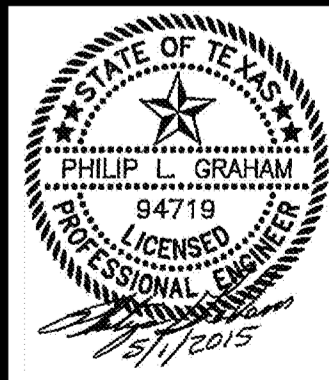

COPYRIGHT ©
 WIER & ASSOCIATES, INC.
 LAST SHEET EDIT
 DATE 4/21/2015
 WA# 13096
**SHEET NO.
001**


PRINTED: 5/1/2015 LAST SAVED: 4/21/2015 4:12 PM. FILE: OFFSITE-WATER-PLAN-PROFILE-I-13096.DWG

CAUTION !!
 EXISTING UTILITIES ARE INDICATED ON THE PLANS FROM AVAILABLE INFORMATION. IT SHALL BE THE RESPONSIBILITY OF THE CONTRACTOR TO VERIFY THE LOCATION OF ALL UTILITIES, TO NOTIFY ALL UTILITY COMPANIES OF THE CONTRACTORS OPERATIONS, TO PROTECT ALL UTILITIES FROM DAMAGE, TO REPAIR ALL UTILITIES DAMAGED DUE TO THE CONTRACTORS OPERATIONS, AND TO NOTIFY THE ENGINEER PROMPTLY OF ALL CONFLICTS OF THE WORK WITH EXISTING UTILITIES.


*** BENCHMARKS ***
BM.A: AN "X" CUT ON THE CENTER OF CURB INLET AT THE EDGE OF SIDEWALK ±25' FROM CURB RETURN AT NORTHWEST INTERSECTION OF JUSTIN RD & INDUSTRIAL PKWY.
 561.99 FT.
BM.B: AN "X" CUT ON SOUTHEAST CORNER OF SIDEWALK NEXT TO HEADWALL ON WEST SIDE OF JOHN KING BLVD ±1,700' NORTH OF I-30.
 563.49 FT.

NOTE:
 1. INSTALL BLUE EMS PAD ALONG WATER LINE EVERY 250', CHANGES IN DIRECTION, WATER VALVES, AND SERVICE CONNECTIONS.
 2. 6" TO 12" WATER LINES SHALL BE CLASS 200 DR 14. 16" WATER LINE SHALL BE CLASS 200 DR 18.

**RECORD PLANS
 MAY 1, 2015**

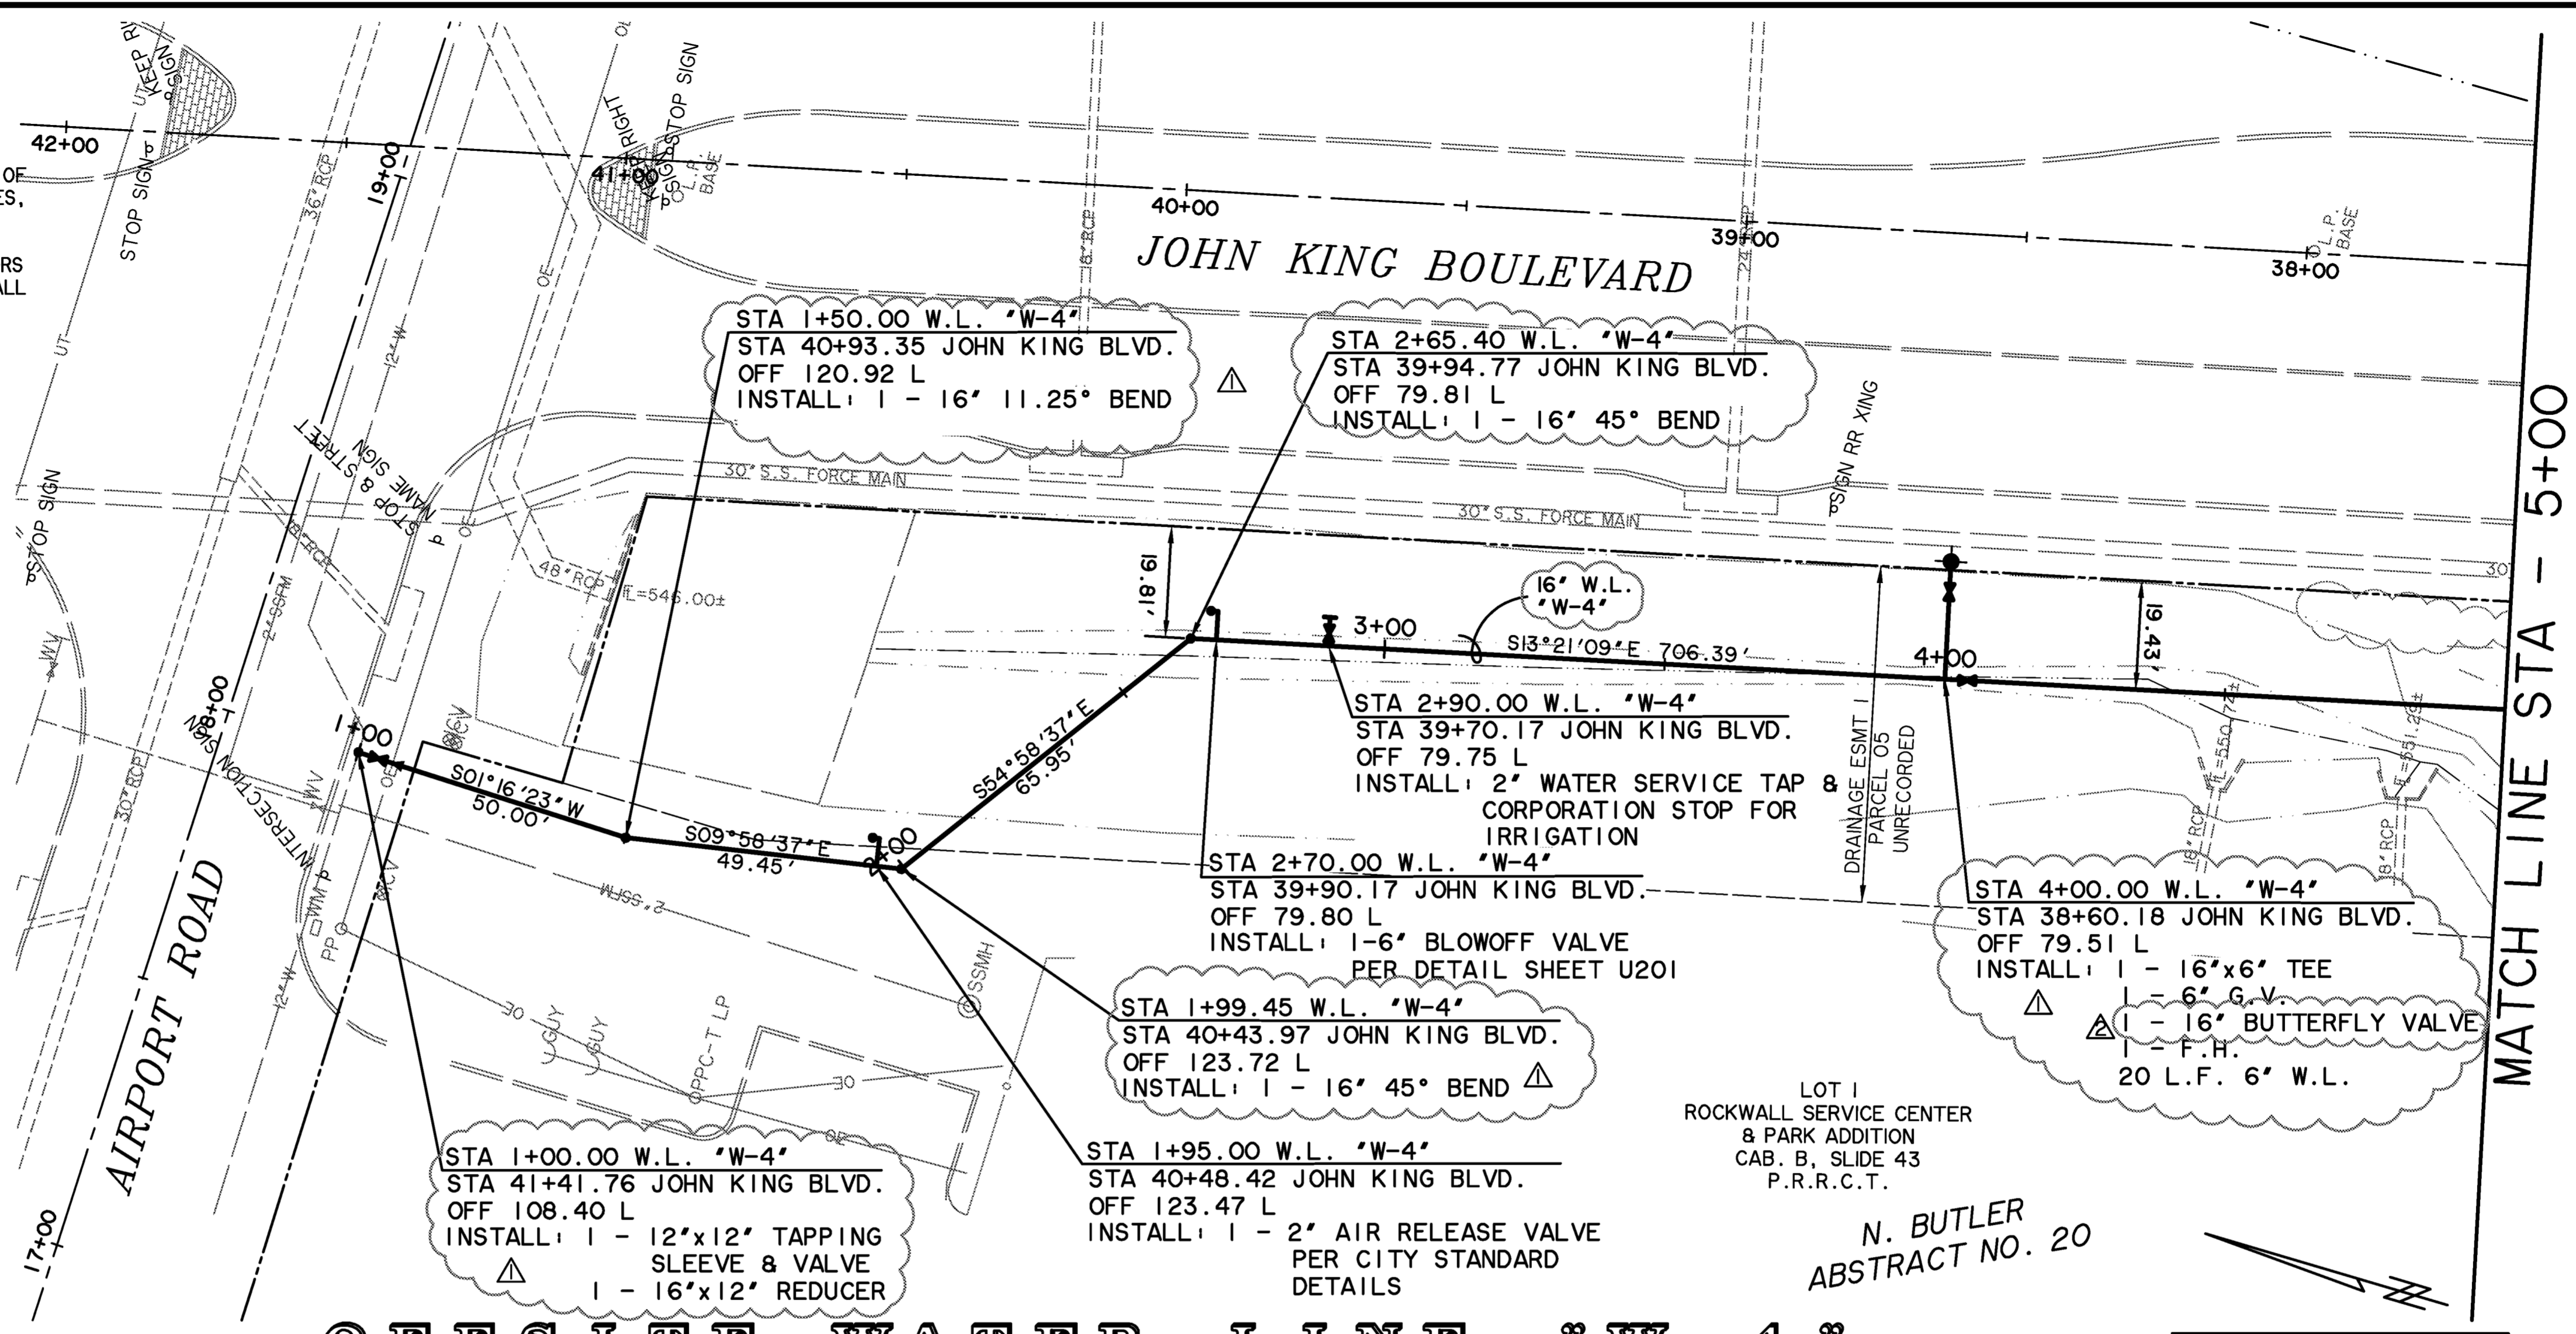


OFFSITE WATER LINE "W-4"

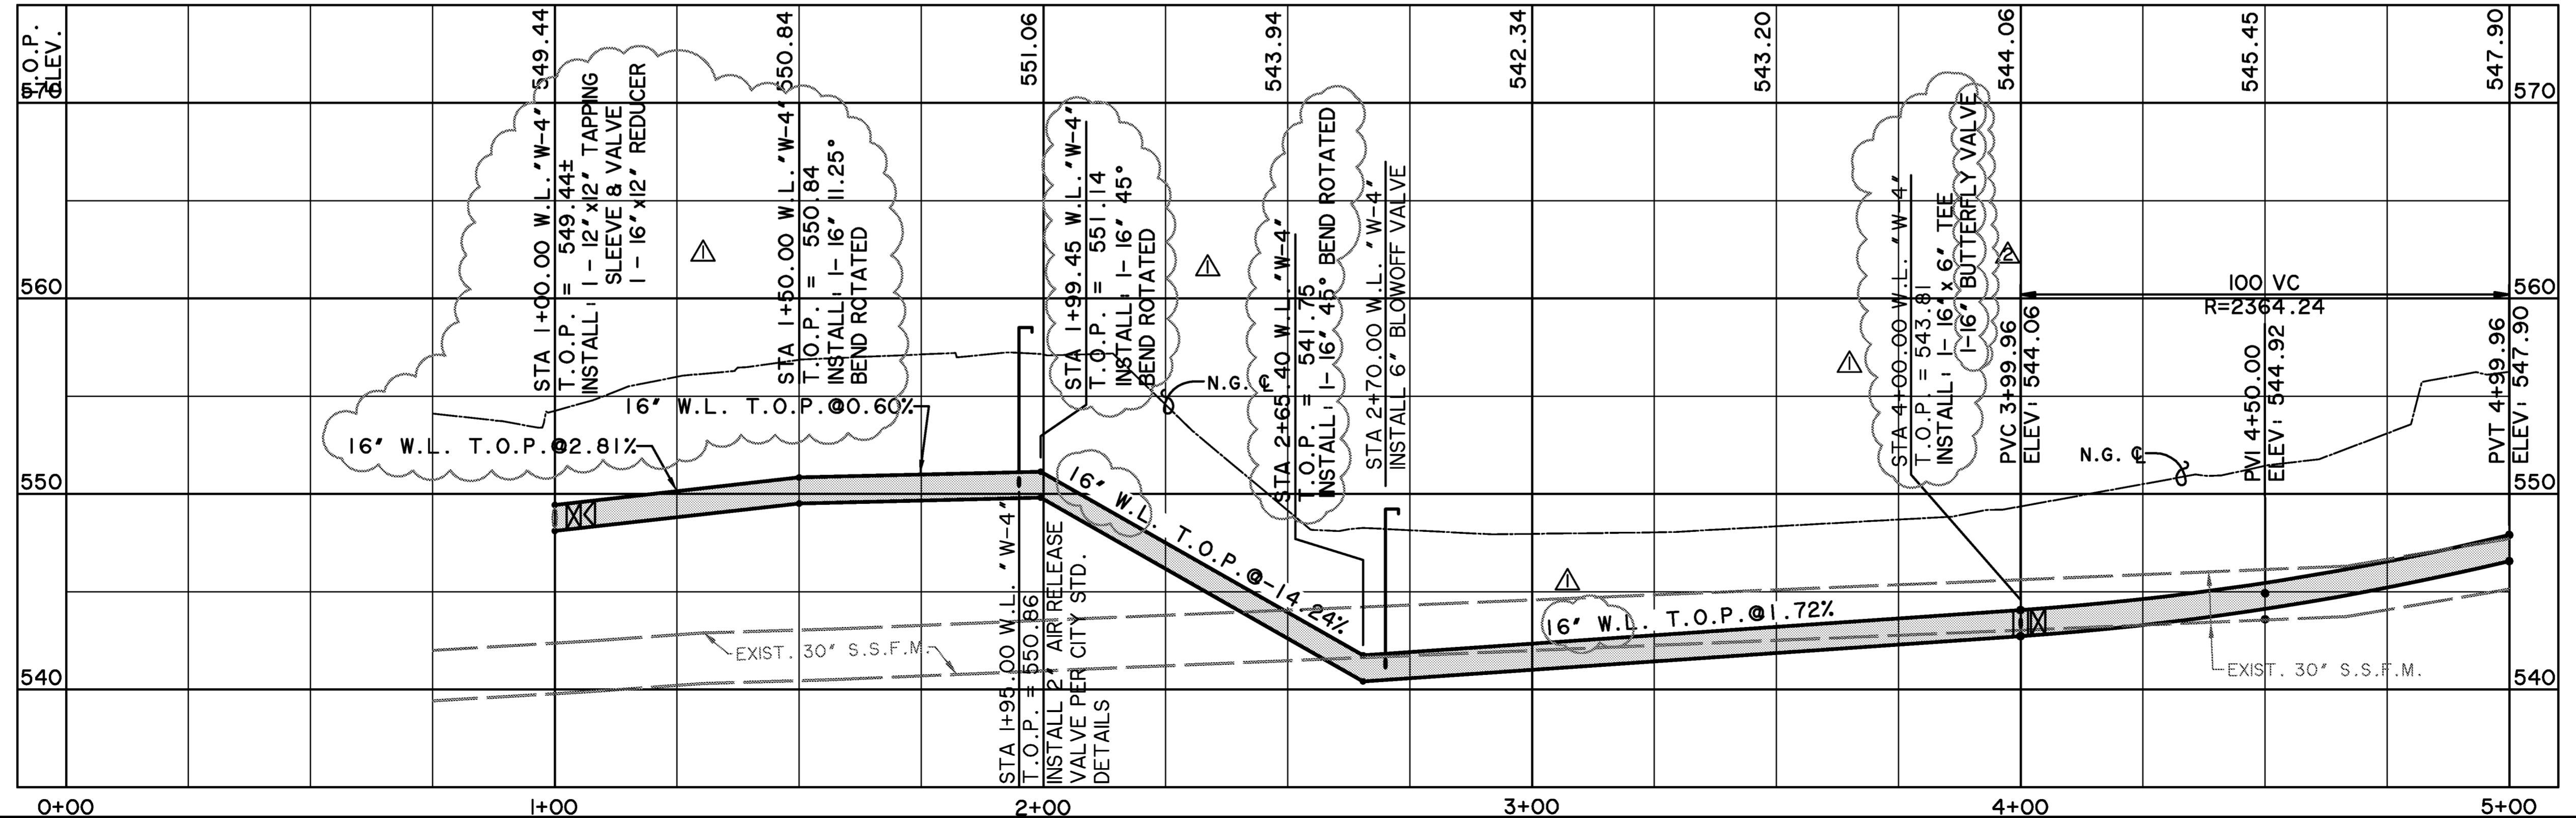


NO.	DESCRIPTION	DATE/BY
1	CHANGED WATER LINE FROM 12" TO 16"	4/16/14 PLG
2	CHANGED 16" G.V. TO BUTTERFLY VALVES	4/21/14 PLG

PREPARED BY:
WIER & ASSOCIATES, INC.
 ENGINEERS SURVEYORS LAND PLANNERS
 701 HIGHLANDER BLVD., SUITE 300 ARLINGTON, TEXAS 76015 METRO (817)467-7700
 Texas Firm Registration No. F-2776 www.wierassociates.com

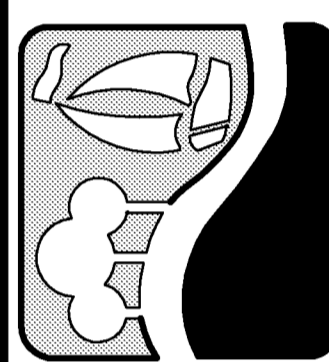

**JOHN KING BOULEVARD
 FROM AIRPORT ROAD
 TO JUSTIN ROAD
 OFFSITE WATER LINE "W-4"
 PLAN & PROFILE
 BEGINNING TO STA 5+00**

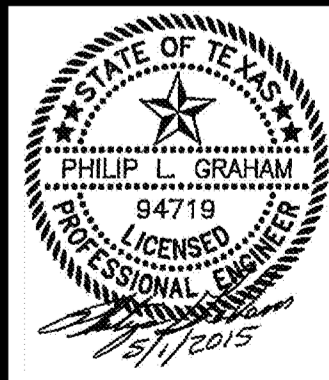


COPYRIGHT ©
 WIER & ASSOCIATES, INC.
 LAST SHEET TOTAL
 DATE 4/21/2015
 WA# 13096
**SHEET NO.
 U101**

PRINTED: 5/1/2015 LAST SAVED: 4/21/2015 4:13 PM FILE: OFFSITE-WATER-PLAN-PROFILE-2-13096.DWG

*** BENCHMARKS ***
BM.A: AN "X" CUT ON THE CENTER OF CURB INLET AT THE EDGE OF SIDEWALK ±25' FROM CURB RETURN AT NORTHWEST INTERSECTION OF JUSTIN RD & INDUSTRIAL PKWY.
 561.99 FT.
BM.B: AN "X" CUT ON SOUTHEAST CORNER OF SIDEWALK NEXT TO HEADWALL ON WEST SIDE OF JOHN KING BLVD ±1,700' NORTH OF I-30.
 563.49 FT.


NOTE:
 1. INSTALL BLUE EMS PAD ALONG WATER LINE EVERY 250', CHANGES IN DIRECTION, WATER VALVES, AND SERVICE CONNECTIONS.
 2. 6" TO 12" WATER LINES SHALL BE CLASS 200 DR 14. 16" WATER LINE SHALL BE CLASS 200 DR 18.

CAUTION !!
 EXISTING UTILITIES ARE INDICATED ON THE PLANS FROM AVAILABLE INFORMATION. IT SHALL BE THE RESPONSIBILITY OF THE CONTRACTOR TO VERIFY THE LOCATION OF ALL UTILITIES, TO NOTIFY ALL UTILITY COMPANIES OF THE CONTRACTORS OPERATIONS, TO PROTECT ALL UTILITIES FROM DAMAGE, TO REPAIR ALL UTILITIES DAMAGED DUE TO THE CONTRACTORS OPERATIONS, AND TO NOTIFY THE ENGINEER PROMPTLY OF ALL CONFLICTS OF THE WORK WITH EXISTING UTILITIES.

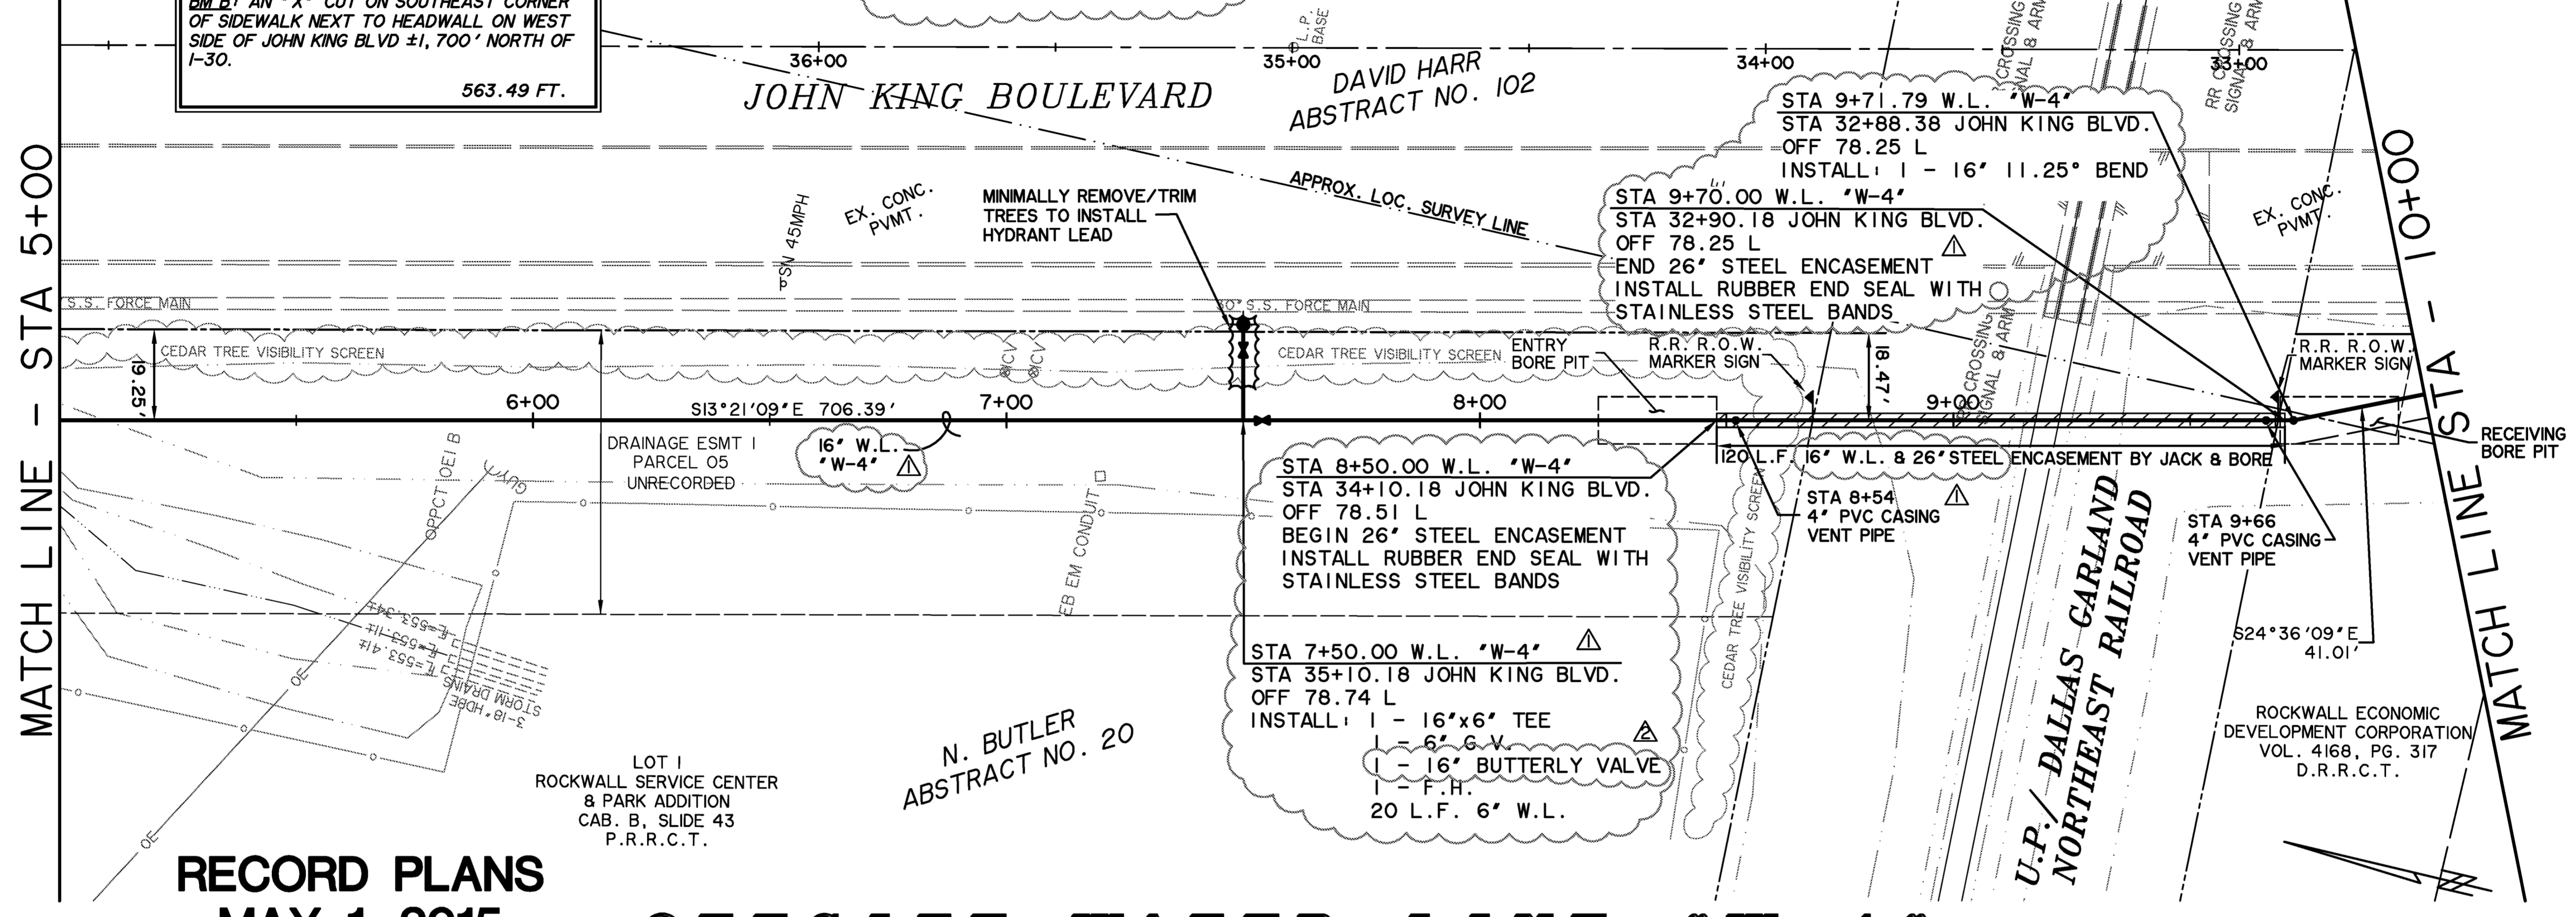


**RECORD PLANS
 MAY 1, 2015**

OFFSITE WATER LINE "W-4"

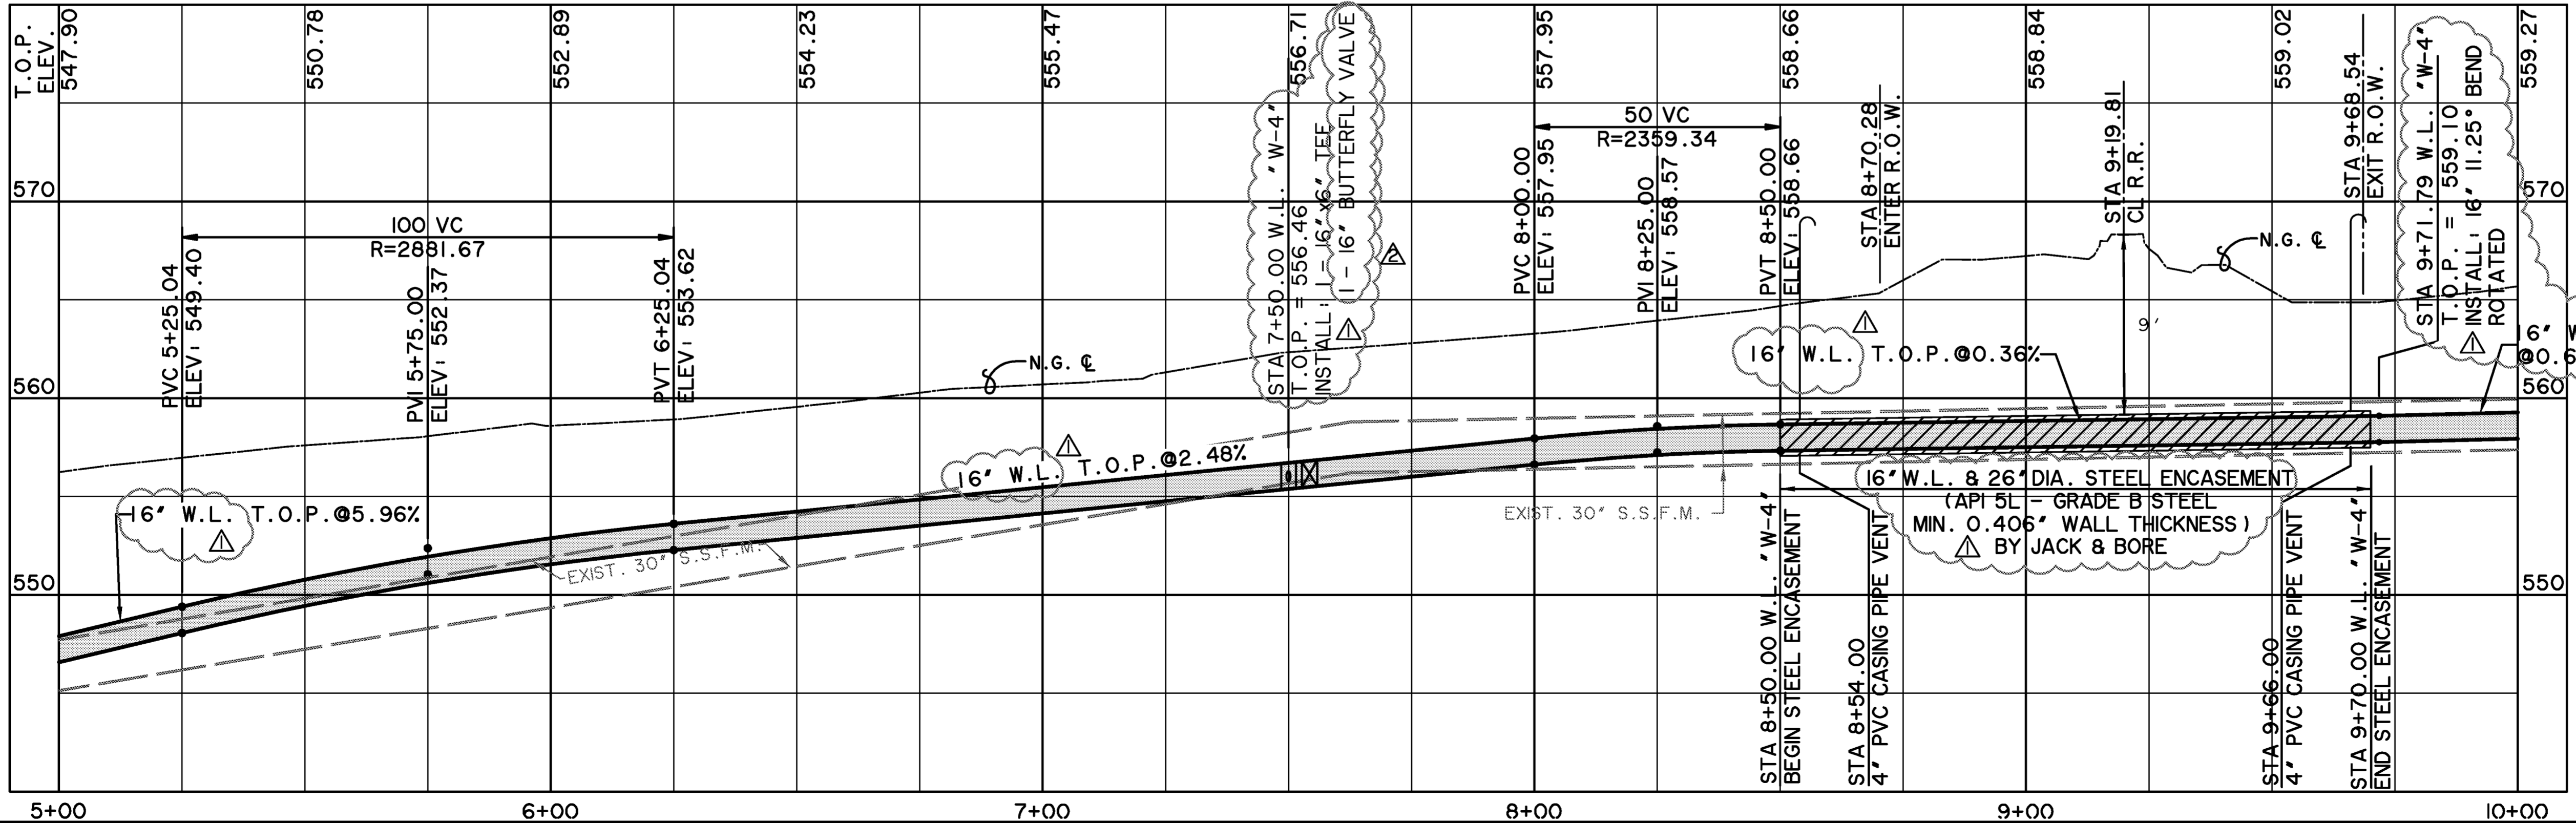


NO.	REVISIONS	DESCRIPTION	DATE	BY
1	CHANGED	WATER LINE FROM 12" TO 16"	4/16/14	PLG
2	CHANGED	16" G.V. TO BUTTERFLY VALVES	4/21/14	PLG

PREPARED BY:
WIER & ASSOCIATES, INC.
 ENGINEERS SURVEYORS LAND PLANNERS
 701 HIGHLANDER BLVD., SUITE 300 ARLINGTON, TEXAS 76015 METRO (817)467-7700
 www.wierassociates.com
 Texas Firm Registration No. F-2776

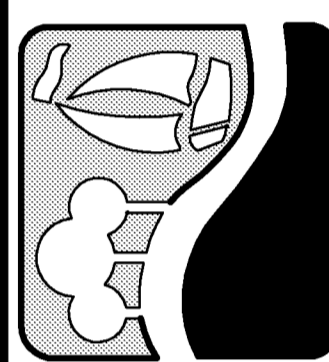

**JOHN KING BOULEVARD
 FROM AIRPORT ROAD
 TO JUSTIN ROAD
 OFFSITE WATER LINE "W-4"
 PLAN & PROFILE
 STA 5+00 TO 10+00**

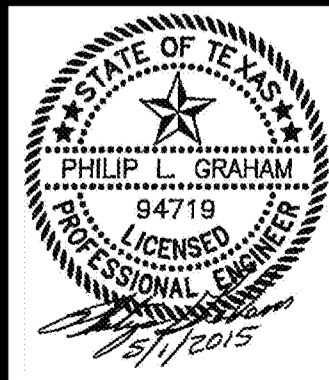


COPYRIGHT ©
 WIER & ASSOCIATES, INC.
 LAST SHEET EDIT
 DATE 4/21/2015
 WA# 13096
**SHEET NO.
 U102**


PRINTED: 5/1/2015 LAST SAVED: 4/21/2015 4:16 PM. FILE: OFFSITE-WATER-PLAN-PROFILE-3-13096.DWG

RECORD PLANS
MAY 1, 2015

PREPARED BY:
WIER & ASSOCIATES, INC.
ENGINEERS SURVEYORS LAND PLANNERS
701 HIGHLANDER BLVD., SUITE 300 ARLINGTON, TEXAS 76015 METRO (817)467-7700
www.wierassociates.com
Texas Firm Registration No. F-2776

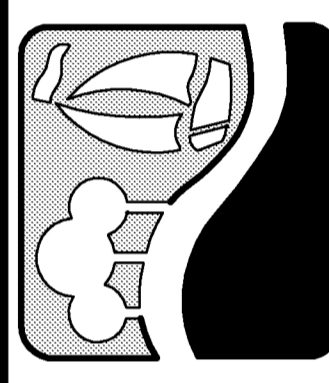


JOHN KING BOULEVARD
FROM AIRPORT ROAD
TO JUSTIN ROAD
OFFSITE WATER LINE "W-4"
PLAN & PROFILE
STA 10+00 TO 15+00

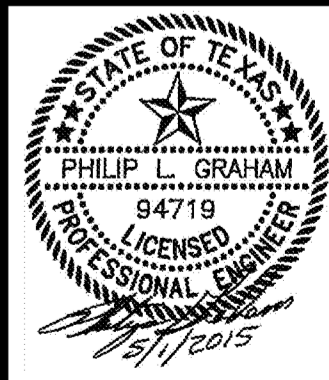

COPYRIGHT ©
WIER & ASSOCIATES, INC.
LAST SHEET TOTAL
DATE 4/21/2015
WA# 13096
SHEET NO.
U103

CAUTION !!
EXISTING UTILITIES ARE INDICATED ON THE PLANS FROM AVAILABLE INFORMATION. IT SHALL BE THE RESPONSIBILITY OF THE CONTRACTOR TO VERIFY THE LOCATION OF ALL UTILITIES, TO NOTIFY ALL UTILITY COMPANIES OF THE CONTRACTORS OPERATIONS, TO PROTECT ALL UTILITIES FROM DAMAGE, TO REPAIR ALL UTILITIES DAMAGED DUE TO THE CONTRACTORS OPERATIONS, AND TO NOTIFY THE ENGINEER PROMPTLY OF ALL CONFLICTS OF THE WORK WITH EXISTING UTILITIES.

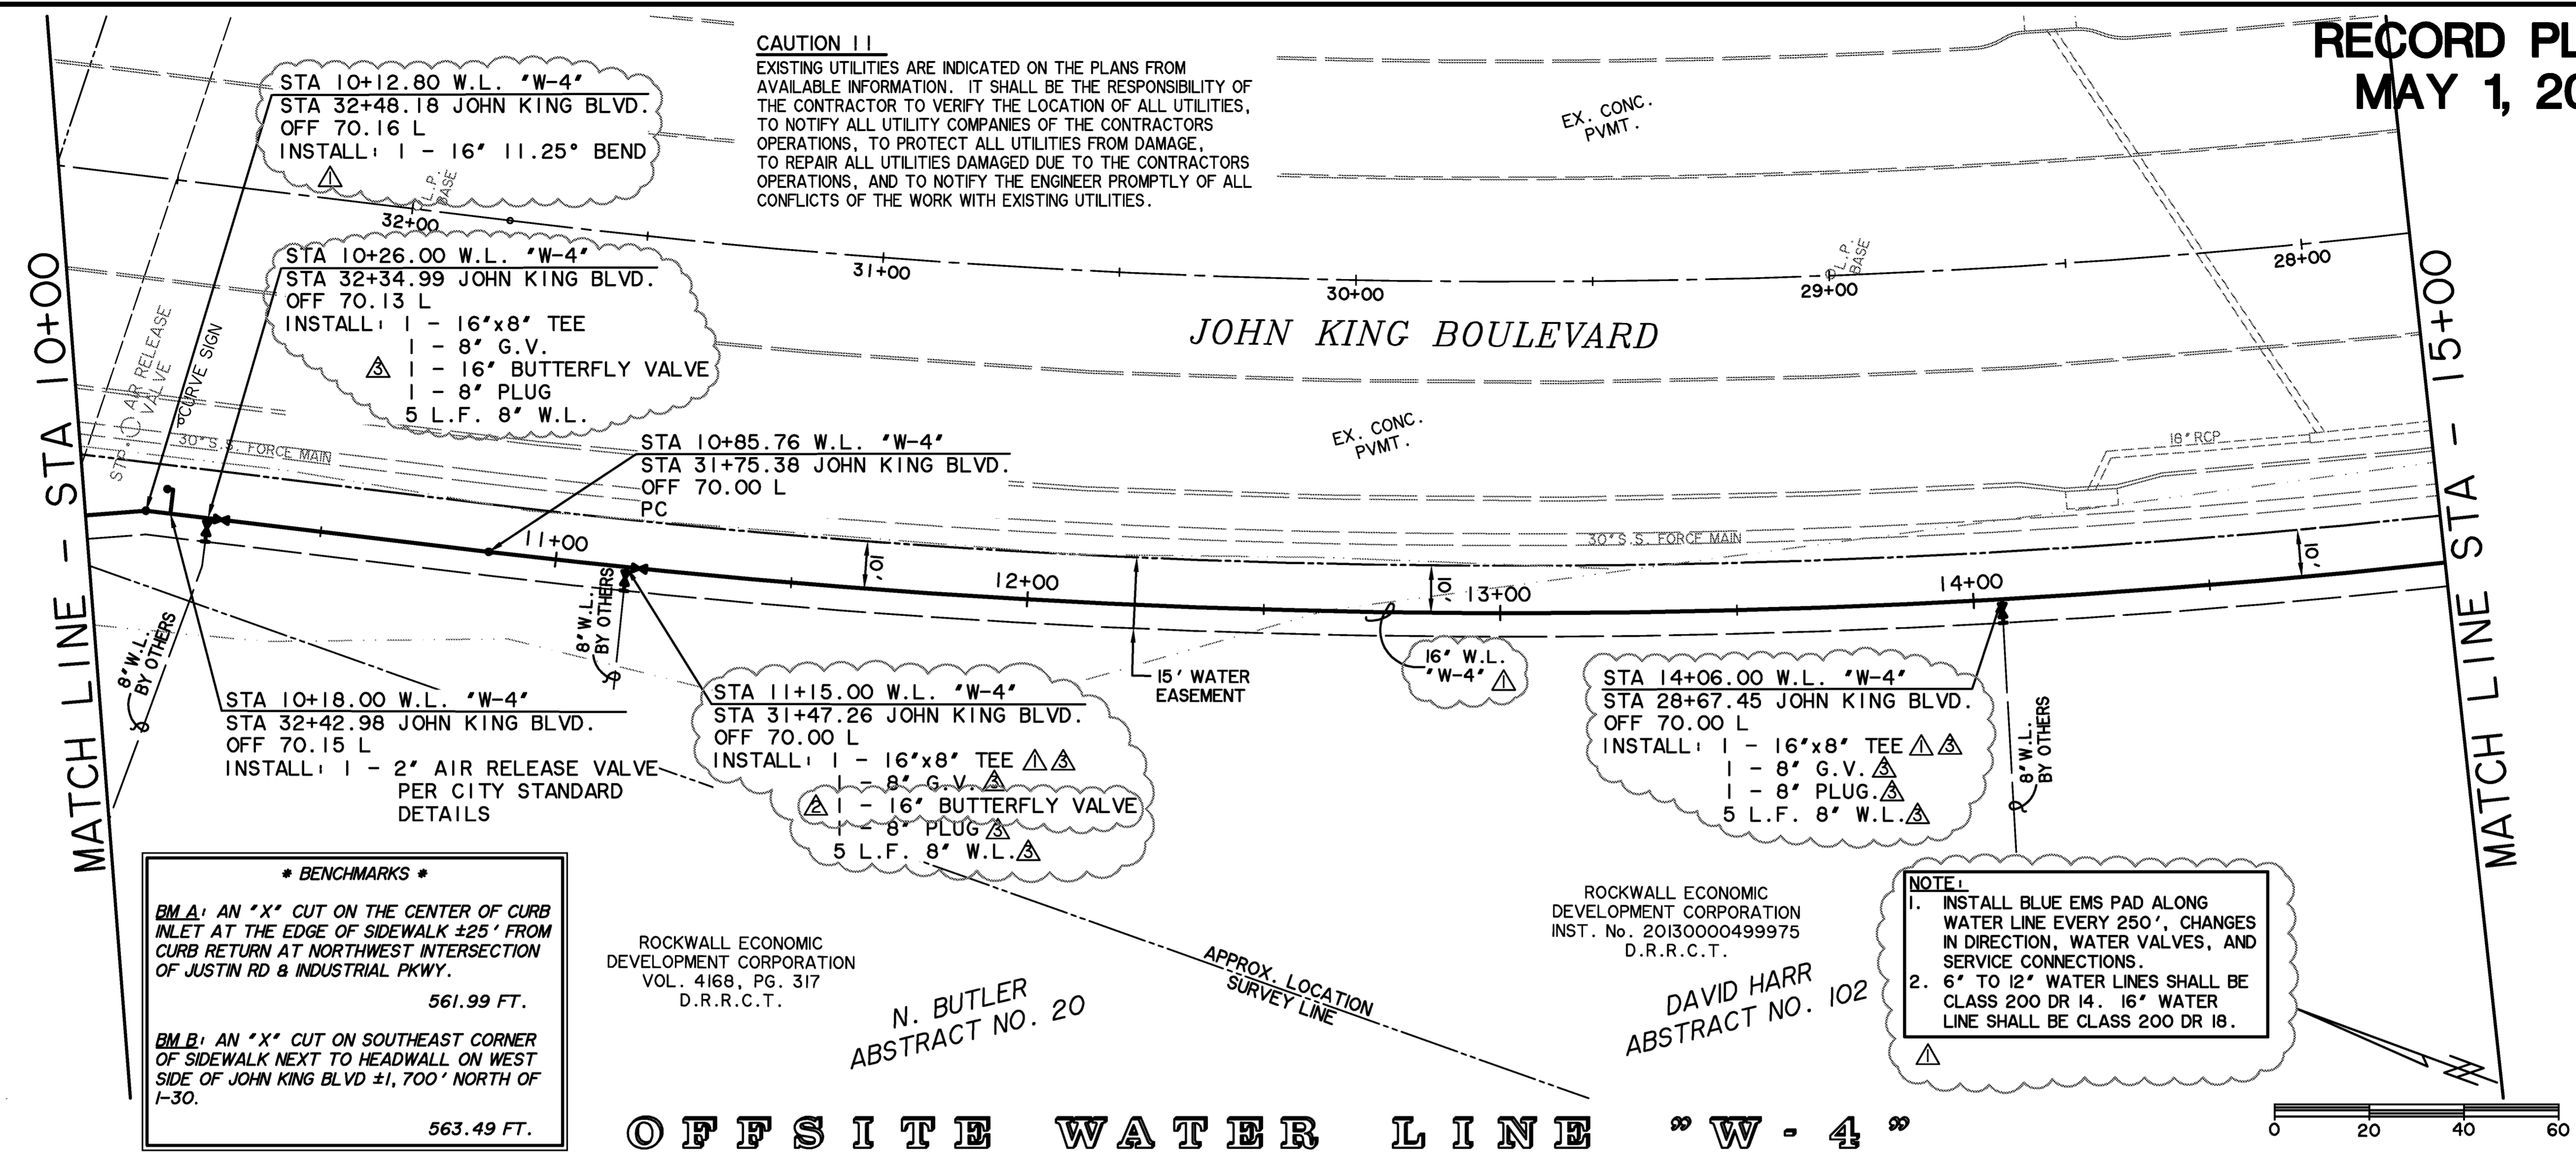

*** BENCHMARKS ***
BM.A: AN "X" CUT ON THE CENTER OF CURB INLET AT THE EDGE OF SIDEWALK ±25' FROM CURB RETURN AT NORTHWEST INTERSECTION OF JUSTIN RD & INDUSTRIAL PKWY.
561.99 FT.
BM.B: AN "X" CUT ON SOUTHEAST CORNER OF SIDEWALK NEXT TO HEADWALL ON WEST SIDE OF JOHN KING BLVD ±1,700' NORTH OF I-30.
563.49 FT.


ROCKWALL ECONOMIC DEVELOPMENT CORPORATION
VOL. 4168, PG. 317
D.R.R.C.T.

N. BUTLER
ABSTRACT NO. 20

ROCKWALL ECONOMIC DEVELOPMENT CORPORATION
INST. No. 20130000499975
D.R.R.C.T.


DAVID HARR
ABSTRACT NO. 102

NOTE:
1. INSTALL BLUE EMS PAD ALONG WATER LINE EVERY 250', CHANGES IN DIRECTION, WATER VALVES, AND SERVICE CONNECTIONS.
2. 6" TO 12" WATER LINES SHALL BE CLASS 200 DR 14. 16" WATER LINE SHALL BE CLASS 200 DR 18.

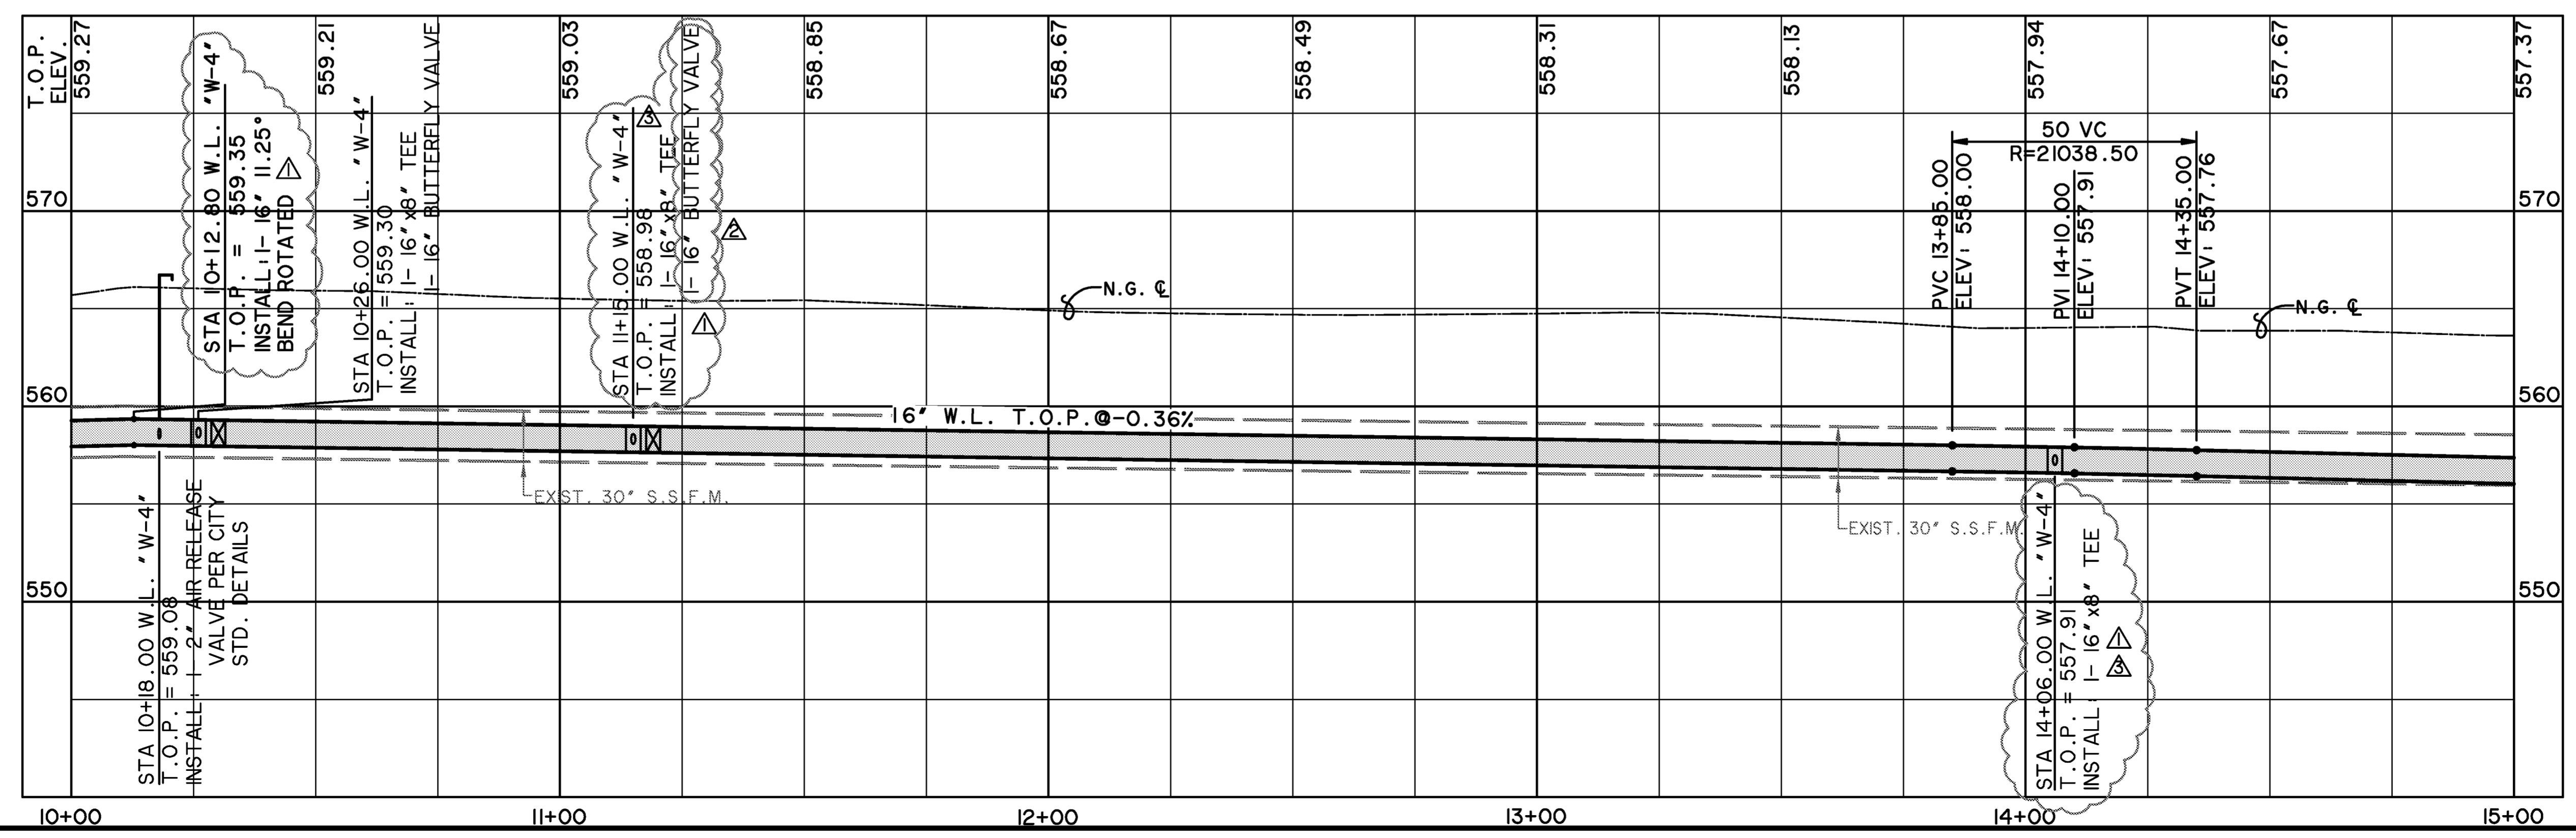

NO.	DESCRIPTION	DATE	BY
1	CHANGED WATER LINE FROM 12" TO 16"	4/16/14	PLG
2	CHANGED 16" G.V. TO BUTTERFLY VALVES	4/21/14	PLG
3	CHANGED 8" AIR RELEASE VALVE TO 2" PER CITY	8/13/14	PLG
4	CHANGED 8" AIR RELEASE VALVE TO 2" PER CITY	8/13/14	PLG

PRINTED: 5/1/2015 LAST SAVED: 4/21/2015 4:15 PM SAVED BY: CLAYTON FILE: OFFSITE-WATER-PLAN-PROFILE-4-13096.DWG

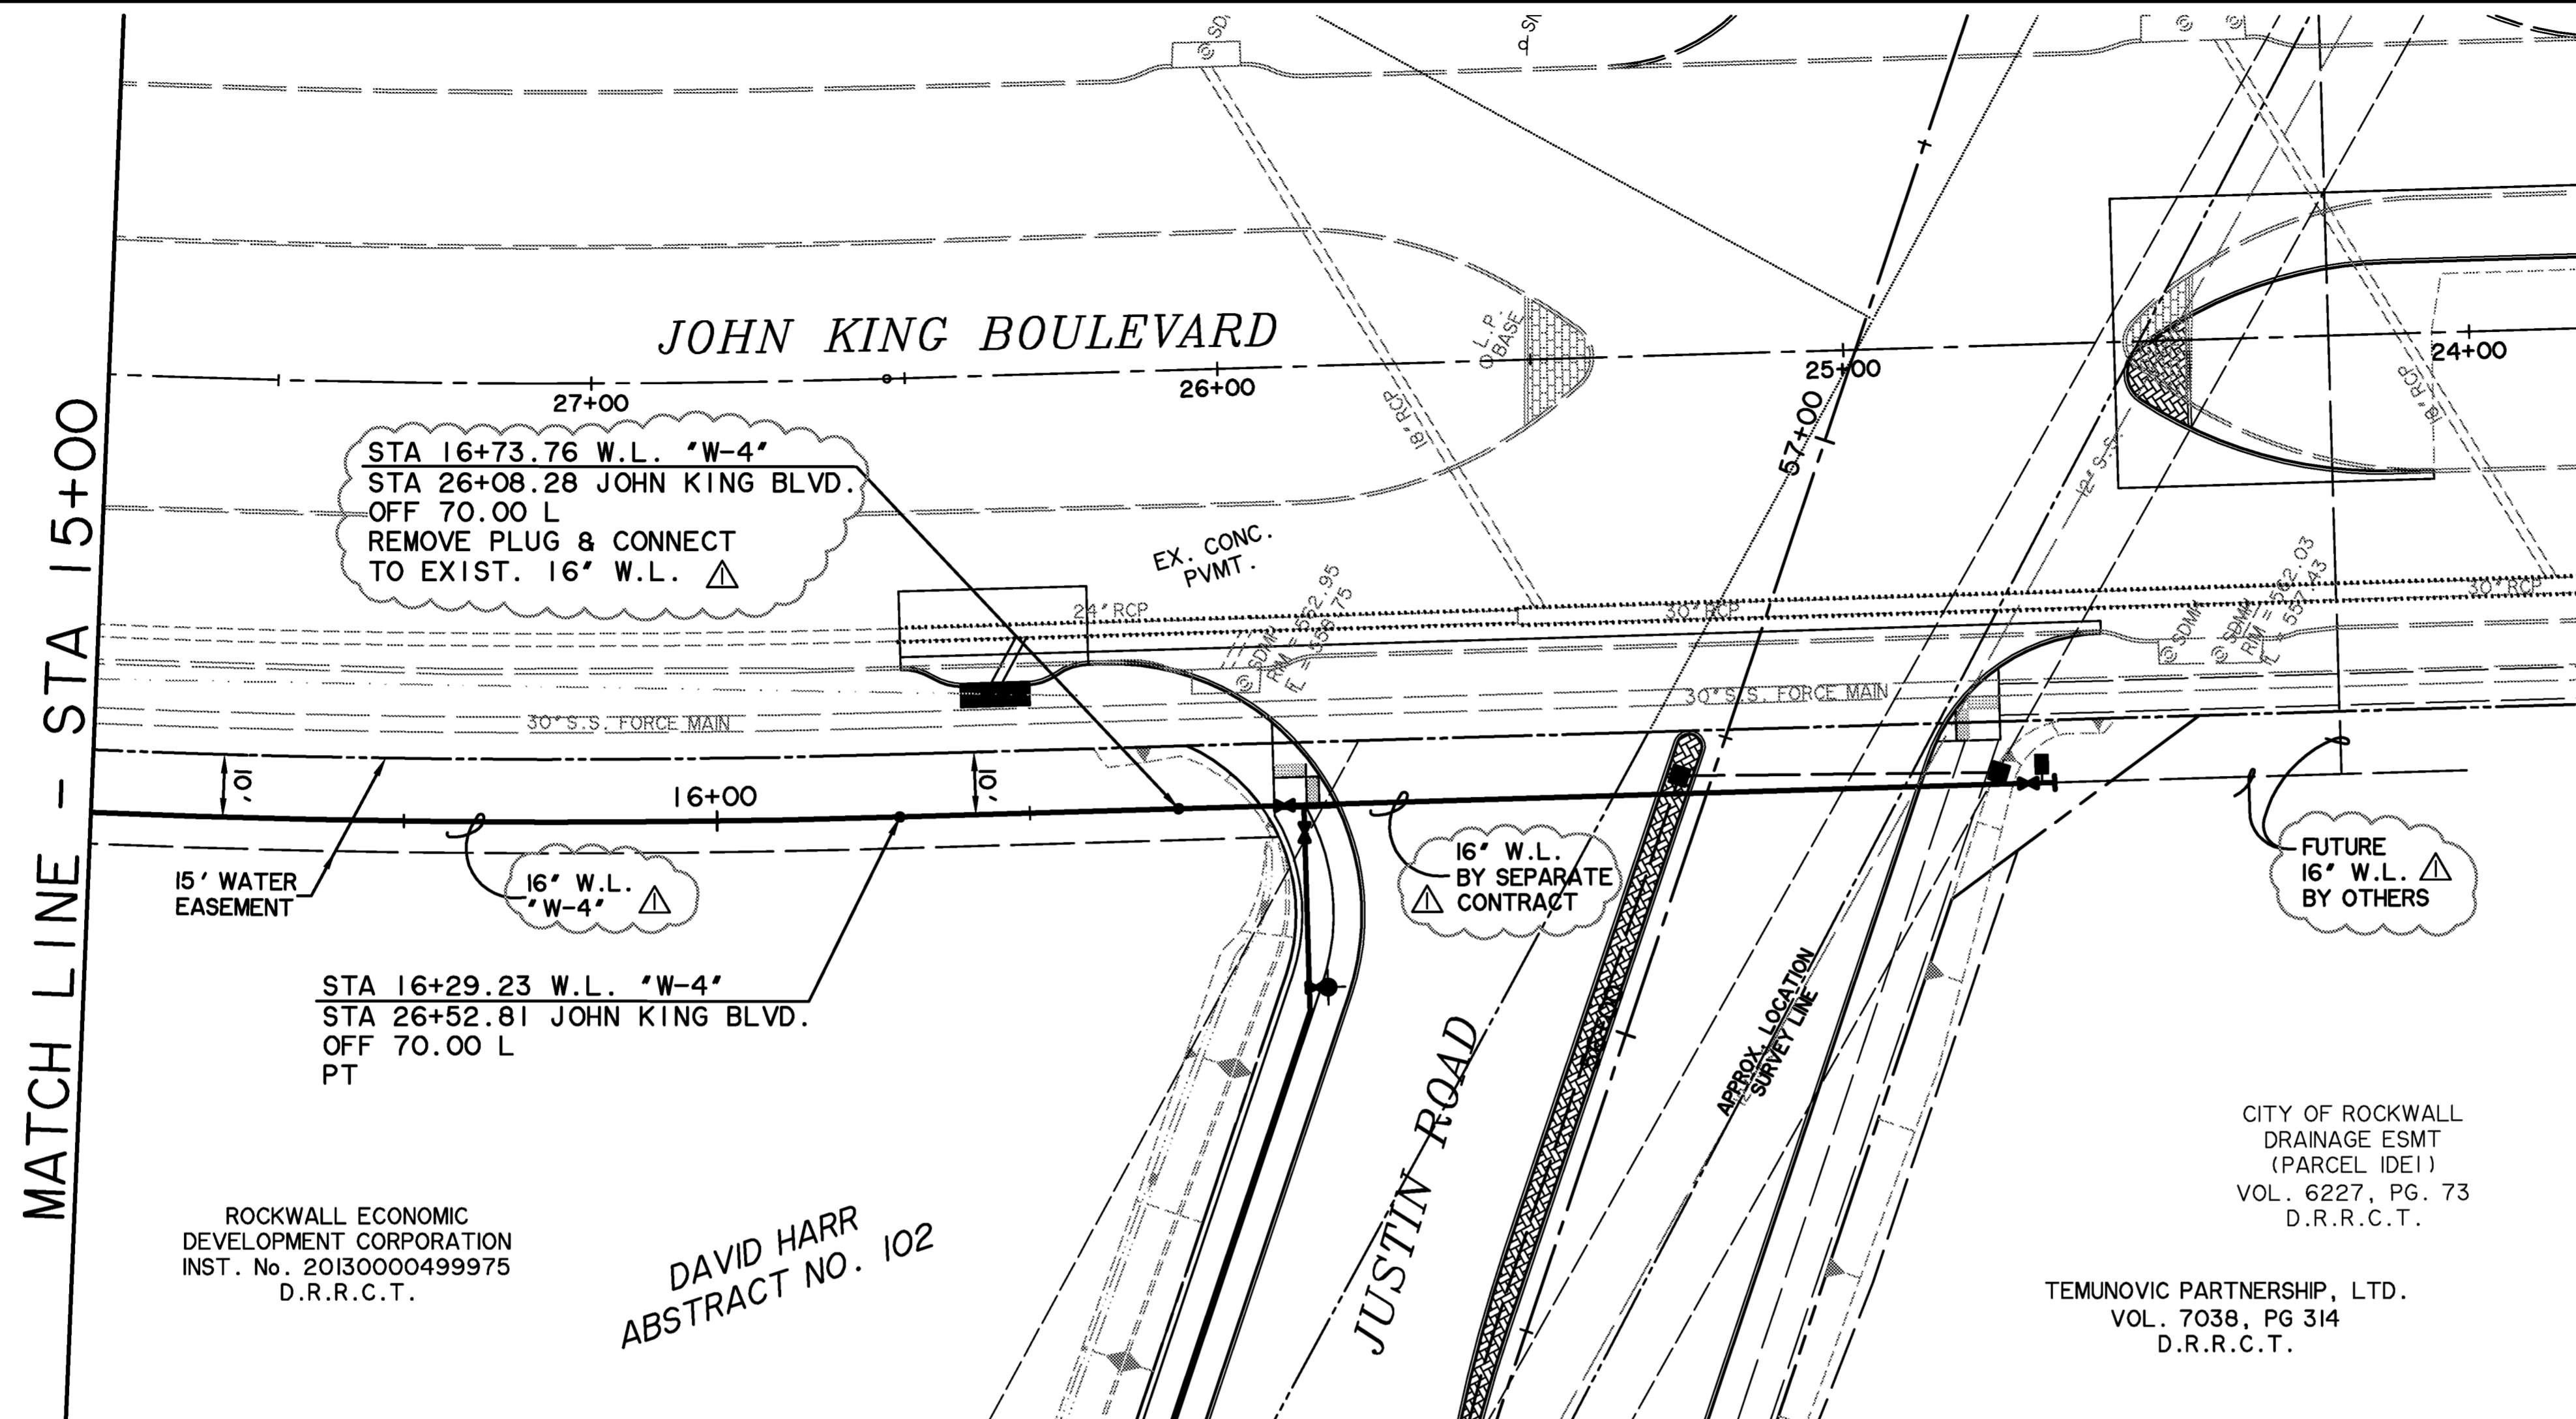

CAUTION !!
 EXISTING UTILITIES ARE INDICATED ON THE PLANS FROM AVAILABLE INFORMATION. IT SHALL BE THE RESPONSIBILITY OF THE CONTRACTOR TO VERIFY THE LOCATION OF ALL UTILITIES, TO NOTIFY ALL UTILITY COMPANIES OF THE CONTRACTOR'S OPERATIONS, TO PROTECT ALL UTILITIES FROM DAMAGE, TO REPAIR ALL UTILITIES DAMAGED DUE TO THE CONTRACTOR'S OPERATIONS, AND TO NOTIFY THE ENGINEER PROMPTLY OF ALL CONFLICTS OF THE WORK WITH EXISTING UTILITIES.

*** BENCHMARKS ***



BM A: AN "X" CUT ON THE CENTER OF CURB INLET AT THE EDGE OF SIDEWALK ±25' FROM CURB RETURN AT NORTHWEST INTERSECTION OF JUSTIN RD & INDUSTRIAL PKWY.
 561.99 FT.

BM B: AN "X" CUT ON SOUTHEAST CORNER OF SIDEWALK NEXT TO HEADWALL ON WEST SIDE OF JOHN KING BLVD ±1,700' NORTH OF I-30.
 563.49 FT.

NOTE:


- INSTALL BLUE EMS PAD ALONG WATER LINE EVERY 250', CHANGES IN DIRECTION, WATER VALVES, AND SERVICE CONNECTIONS.
- 6" TO 12" WATER LINES SHALL BE CLASS 200 DR 14. 16" WATER LINE SHALL BE CLASS 200 DR 18.

OFFSITE WATER LINE "W-4"

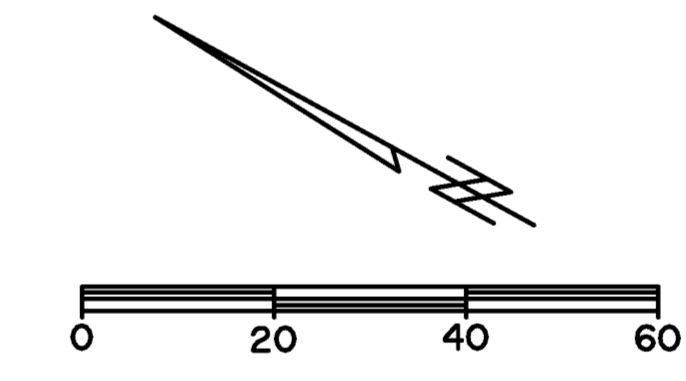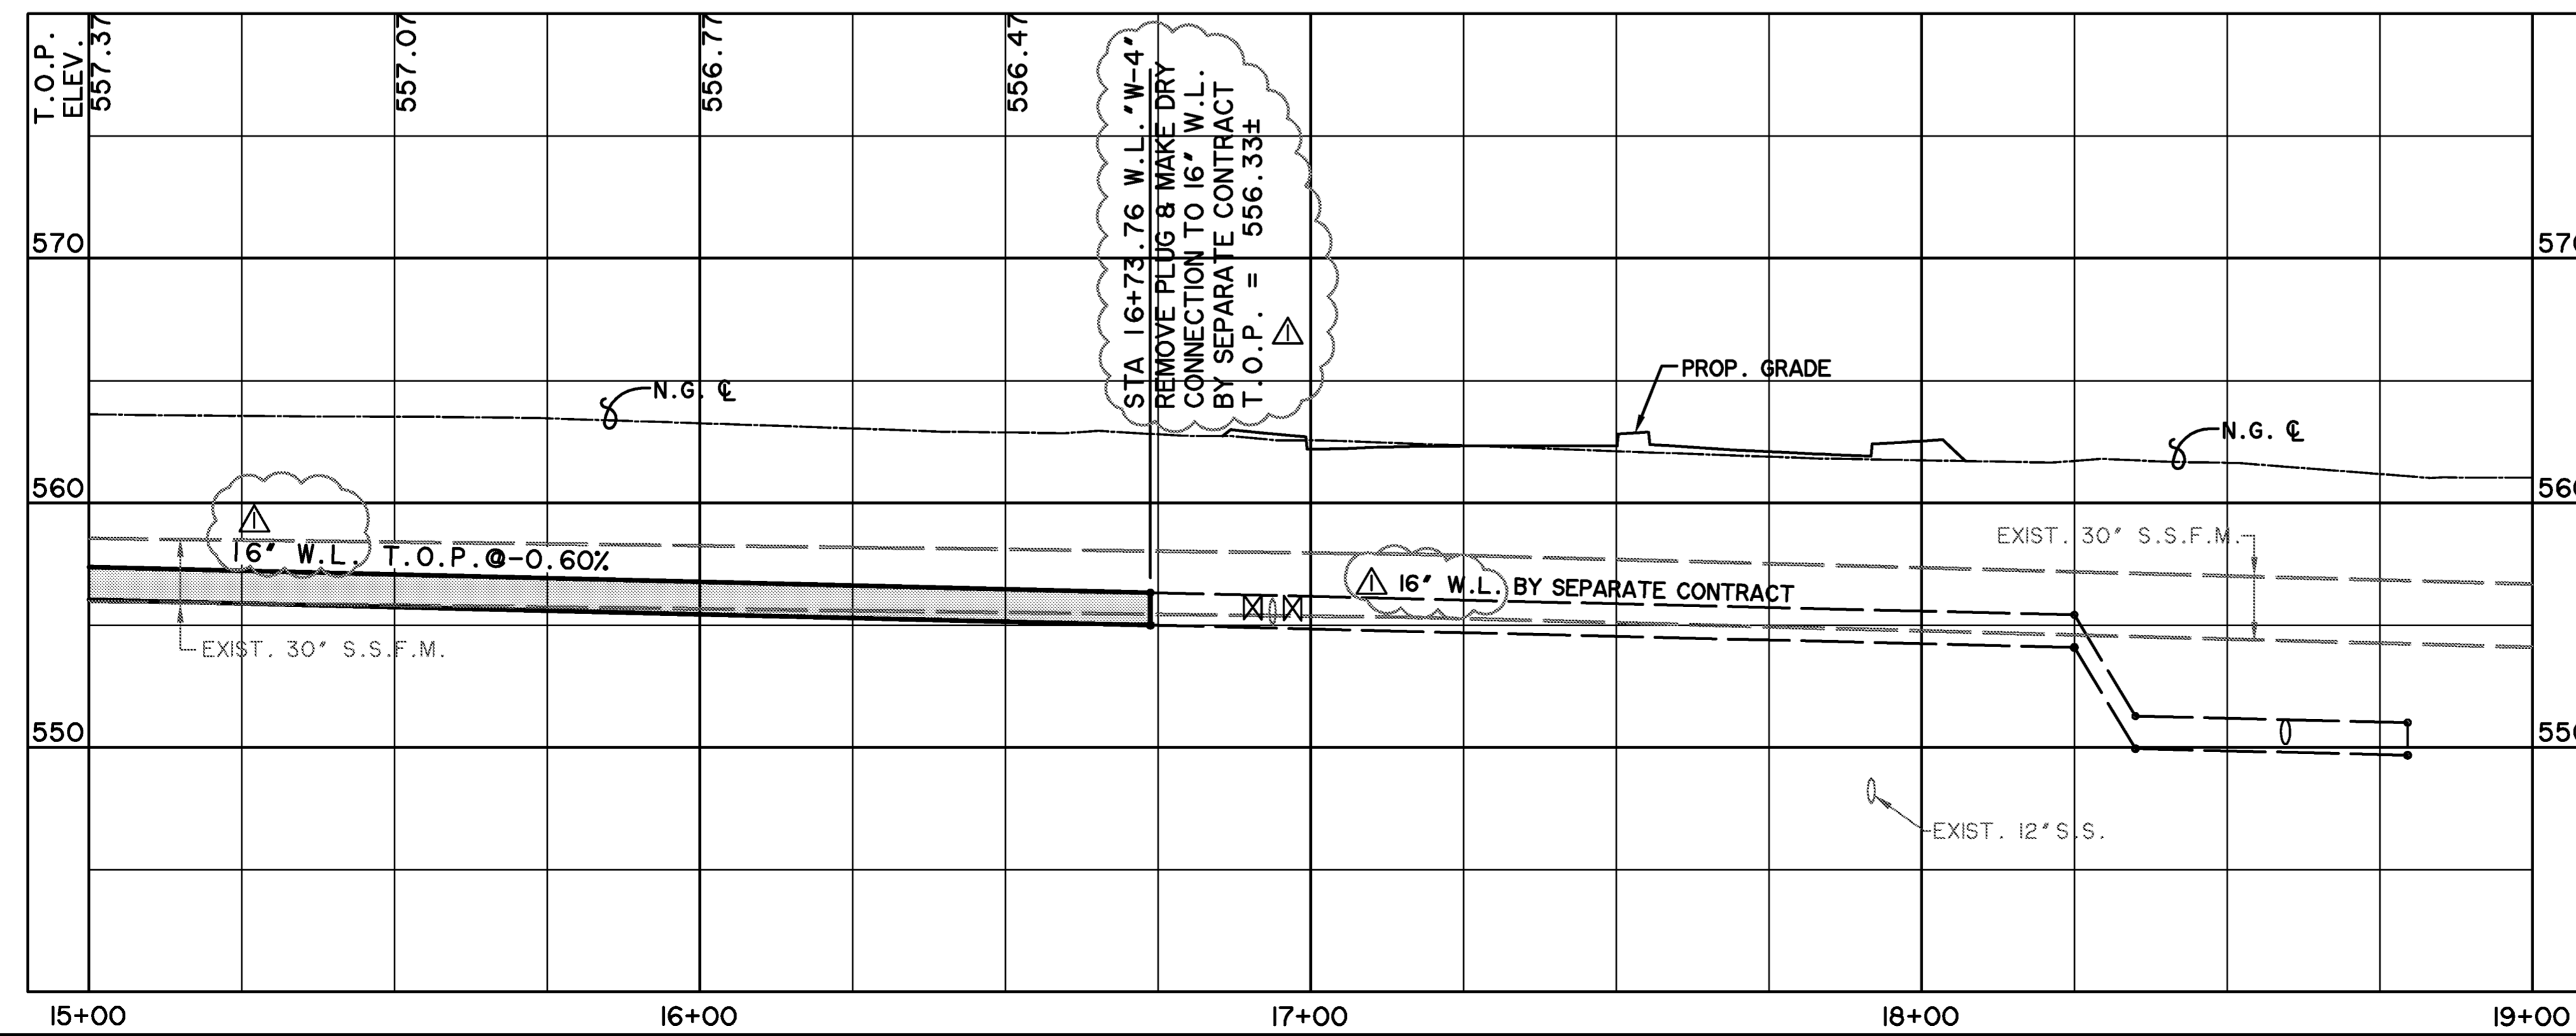


**RECORD PLANS
 MAY 1, 2015**

PREPARED BY:
WIER & ASSOCIATES, INC.
 ENGINEERS SURVEYORS LAND PLANNERS
 701 HIGHLANDER BLVD., SUITE 300 ARLINGTON, TEXAS 76015 METRO (817)467-7700
 www.wierassociates.com
 Texas Firm Registration No. F-2776


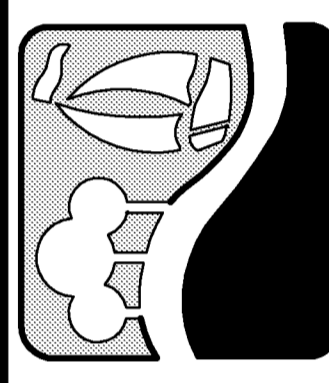


**JOHN KING BOULEVARD
 FROM AIRPORT ROAD
 TO JUSTIN ROAD
 OFFSITE WATER LINE "W-4"
 PLAN & PROFILE
 STA 15+00 TO END**

NO.	REVISIONS	DESCRIPTION	DATE BY
1	CHANGED	WATER LINE FROM 12" TO 16"	4/16/14 PLG

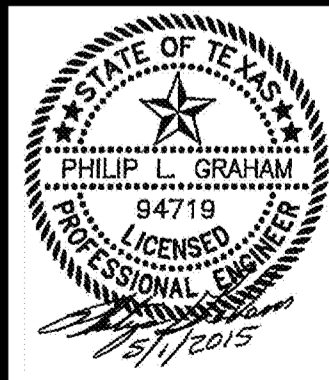


COPYRIGHT ©
 WIER & ASSOCIATES, INC.
 LAST SHEET EDIT
 DATE 4/21/2015
 WA# 13096
**SHEET NO.
 U104**

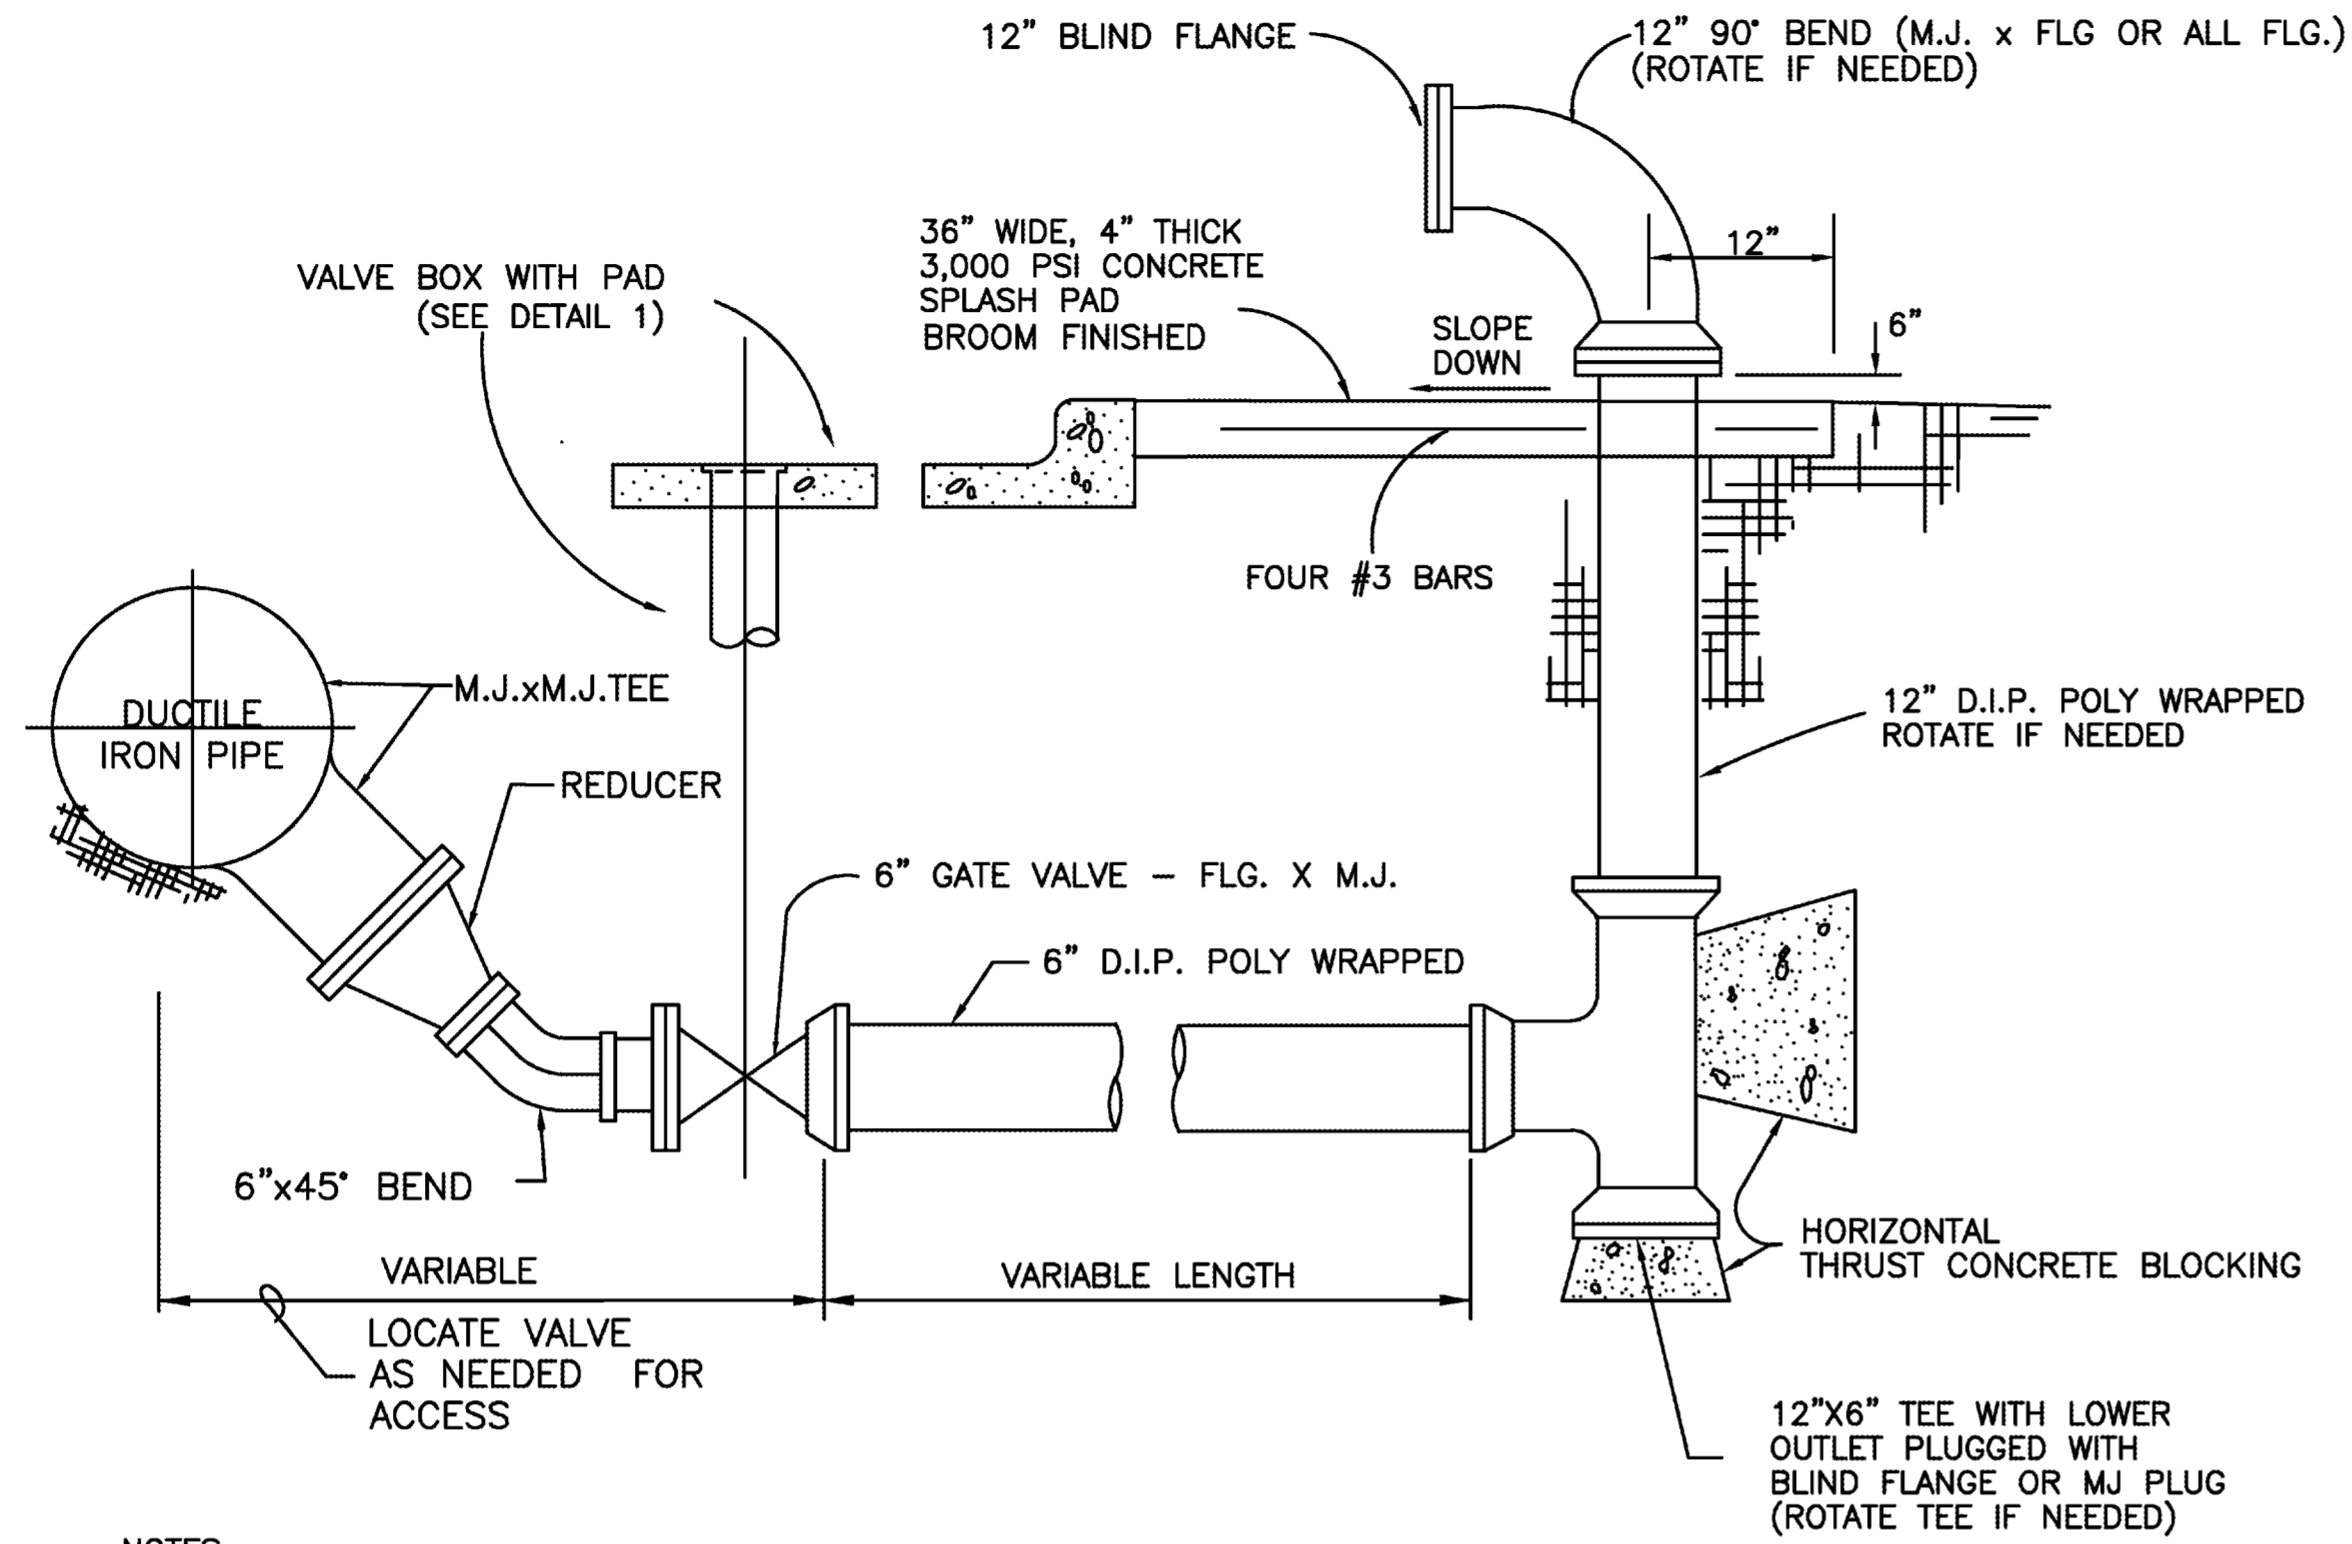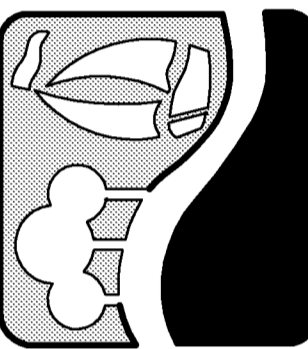


- NOTES**
1. ALL CONNECTIONS SHALL BE FLANGED OR MJ RESTRAINED WITH APPROVED RETAINER GLANDS OR THRUST RESTRAINT DEVICES.
 2. ALL PIPING TO BE DUCTILE IRON WITH ALL BURIED VALVE, PIPE & FITTINGS TO BE POLY-WRAPPED.
 3. BRUSH PAINT ALL ABOVE GROUND EXPOSED FITTINGS AND PIPE WITH TWO COATS OF FLYNT READY MIXED ALUMINUM PAINT OF GREENVILLE, TEXAS 1-800-473-5698. SILVER COLOR ONLY.
 4. APPLY TO PVC MAIN BY TURNING DOWN TEE AND INSTALLING A 45 DEGREE BEND. MUST BE APPROVED BY ENGINEER OR INSPECTOR.
 5. INSTALL RISER AT RIGHT-OF-WAY.

BLOW OFF DETAIL
N.T.S.

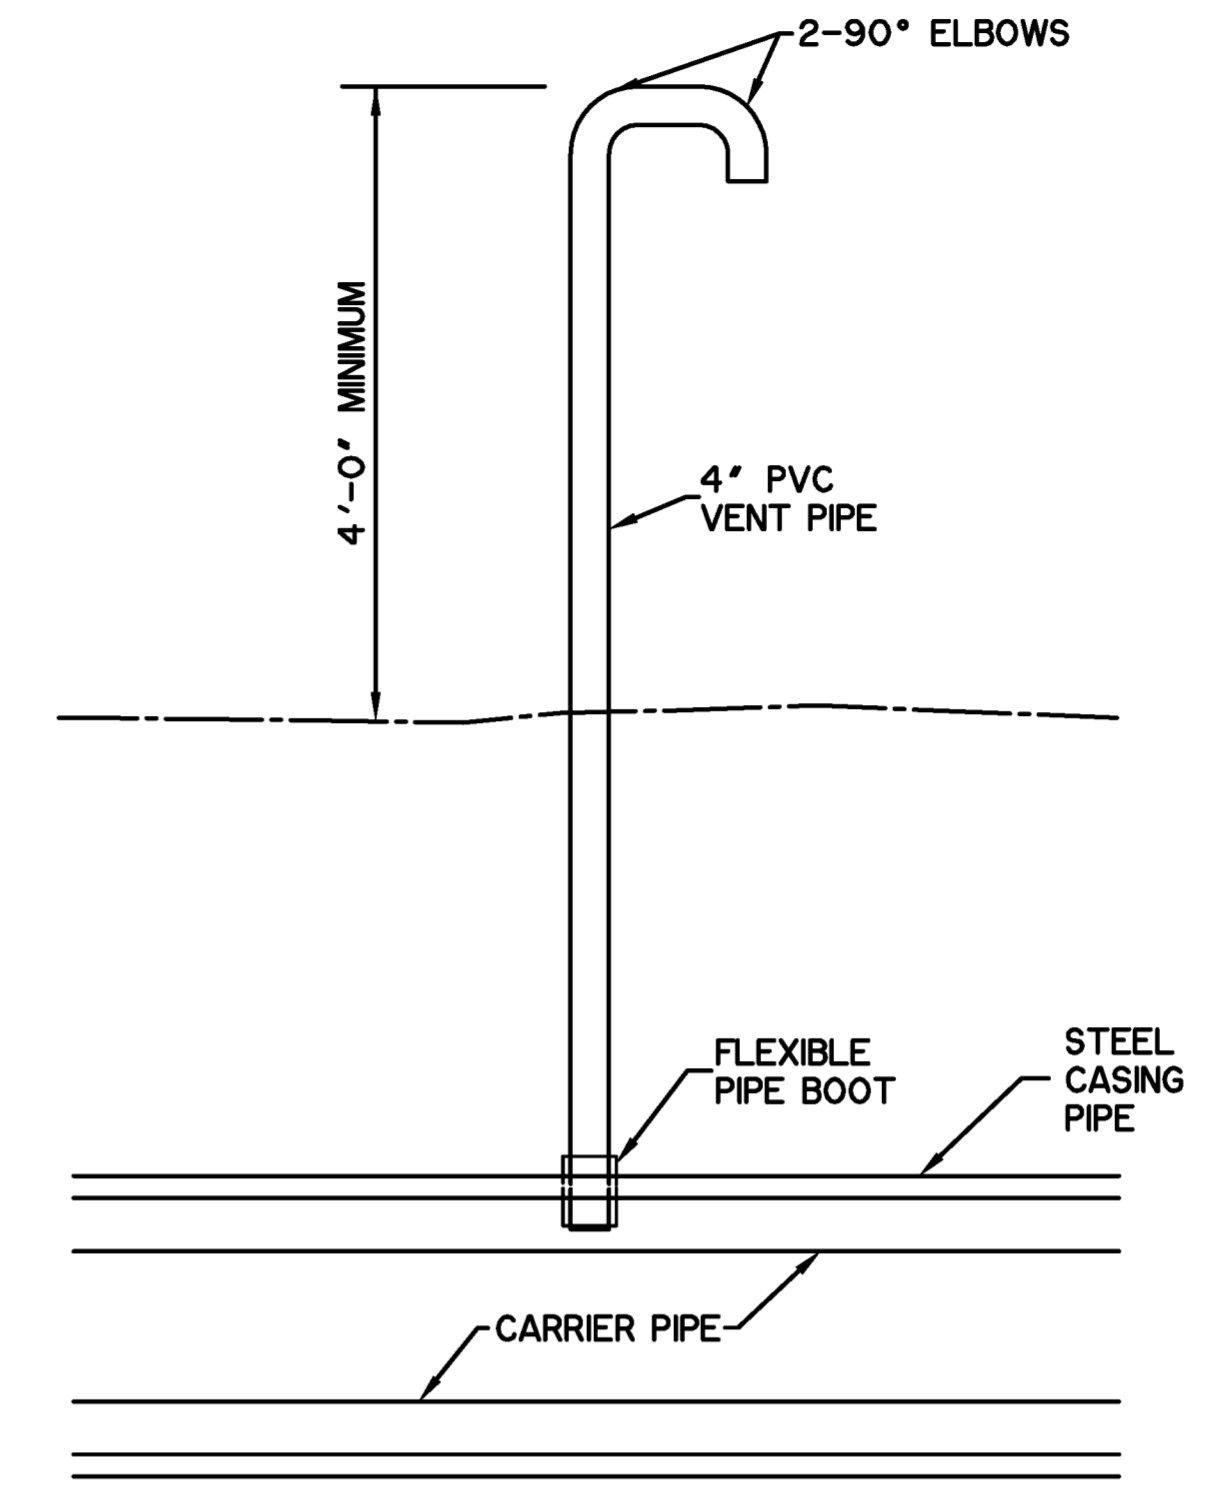


CASING PIPE VENT
N.T.S.

- CASING SPACER NOTES:**
1. THE CASING SPACERS SHALL BE OF PROJECTION TYPE THAT HAS A MINIMUM NUMBER OF PROJECTIONS AROUND THE CIRCUMFERENCE TOTALING THE NUMBER OF DIAMETER INCHES (16" PIPE, MIN. 16 PROJECTIONS) Δ
 2. CASING SPACERS SHALL HAVE A MAXIMUM SPACING SPAN AS SHOWN ON DETAIL. THE SPAN BETWEEN SPACERS SHALL RESULT IN CONSERVATIVE LONG TERM SAFETY FACTOR PROVIDED TOTAL LOAD PER SPACER DOES NOT EXCEED THE MAXIMUM LOAD FOR PIPE FULL OF LIQUID PER SPACER LISTED IN THE LITERATURE PER CLASS SPACER USED.
 3. SPACERS SHALL HAVE A MINIMUM HEIGHT THAT CLEARS THE PIPE BELL OR AS OTHERWISE INDICATED ON THE PLANS.
 4. CASING SPACERS SHALL USE DOUBLE BACKED TAPE PROVIDED WITH THE SPACERS, TO FASTEN TIGHTLY ONTO THE CARRIER PIPE, SO THAT THE SPACERS DO NOT MOVE DURING INSTALLATION.
 5. SPACERS SHALL BE RACI HIGH DENSITY POLYETHYLENE OR CITY APPROVED EQUAL.
 6. ALL CARRIER PIPE INSTALLED BY JACK AND BORE SHALL BE SUPPORTED BY QUARTER POINT GRADLE OF 2000 PSI CONCRETE ACROSS THE BORING PIT AND TO THE FIRST JOINT IN THE DITCH SECTION. ALL VOIDS WILL BE GROUTED WITH A 1:7 MINIMUM PROPORTIONED MIX WITH FIVE PERCENT (5%) TO FORTY PERCENT (40%) AIR ENTRAINMENT, AND WILL BE CONSIDERED A PART OF THE UNIT PRICE OF THE BORING OPERATION.

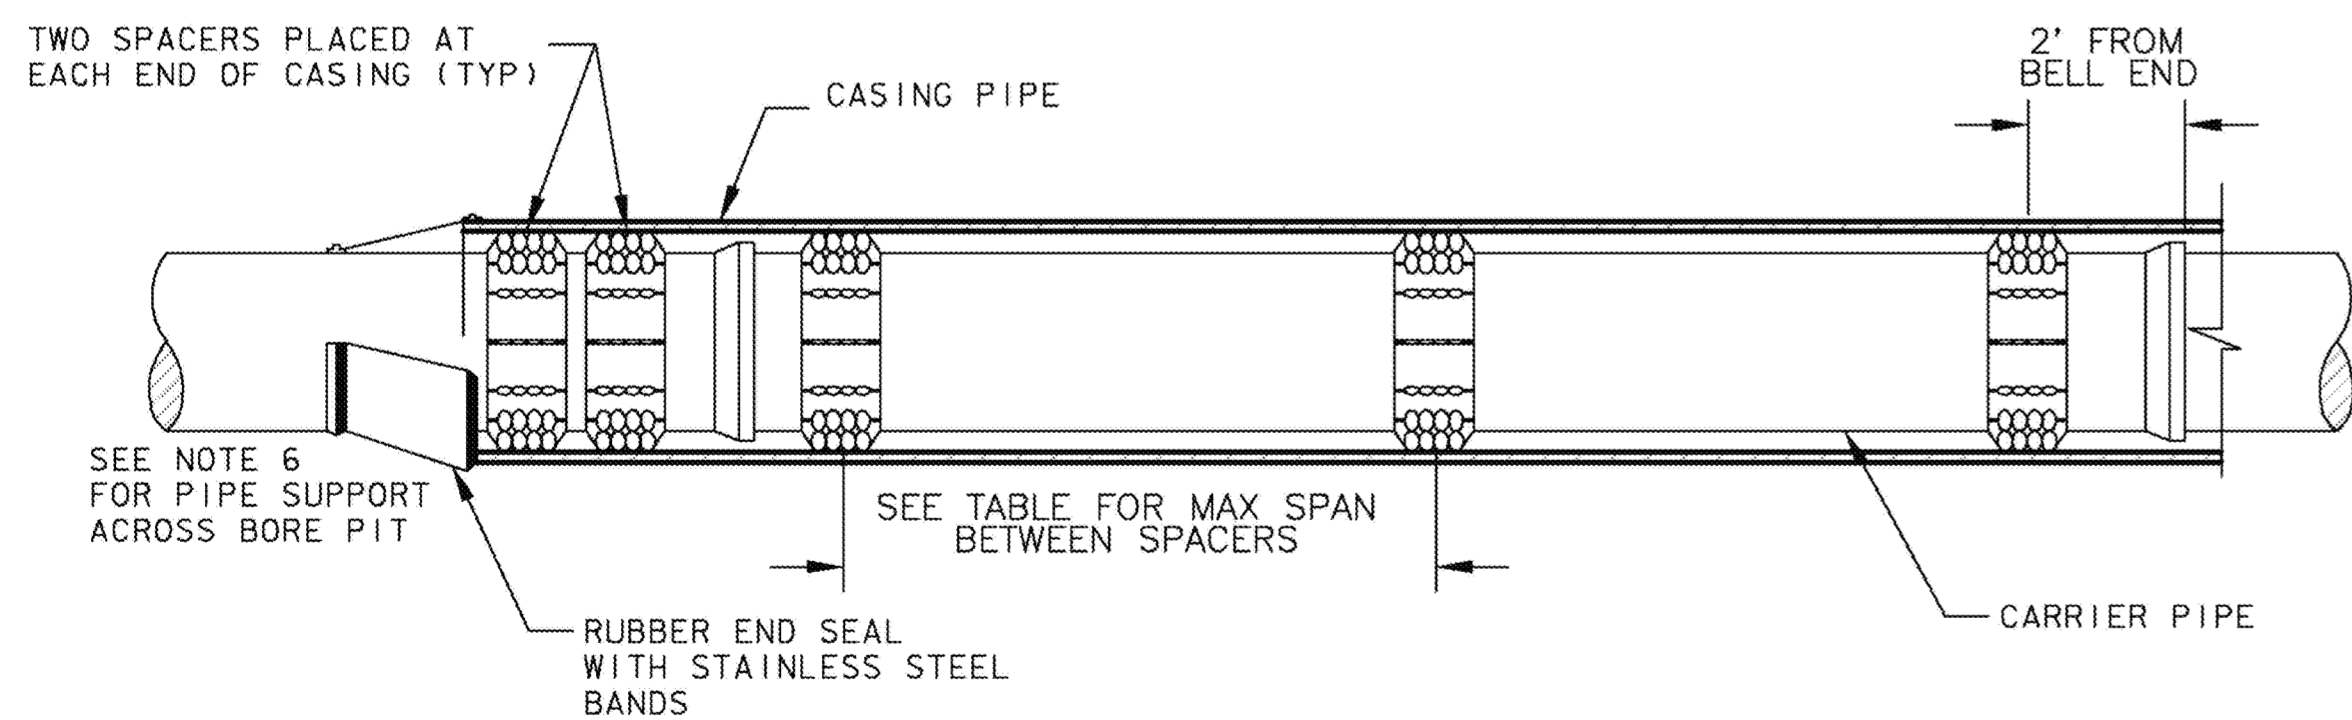

PIPE INSULATOR DETAIL
NOT TO SCALE

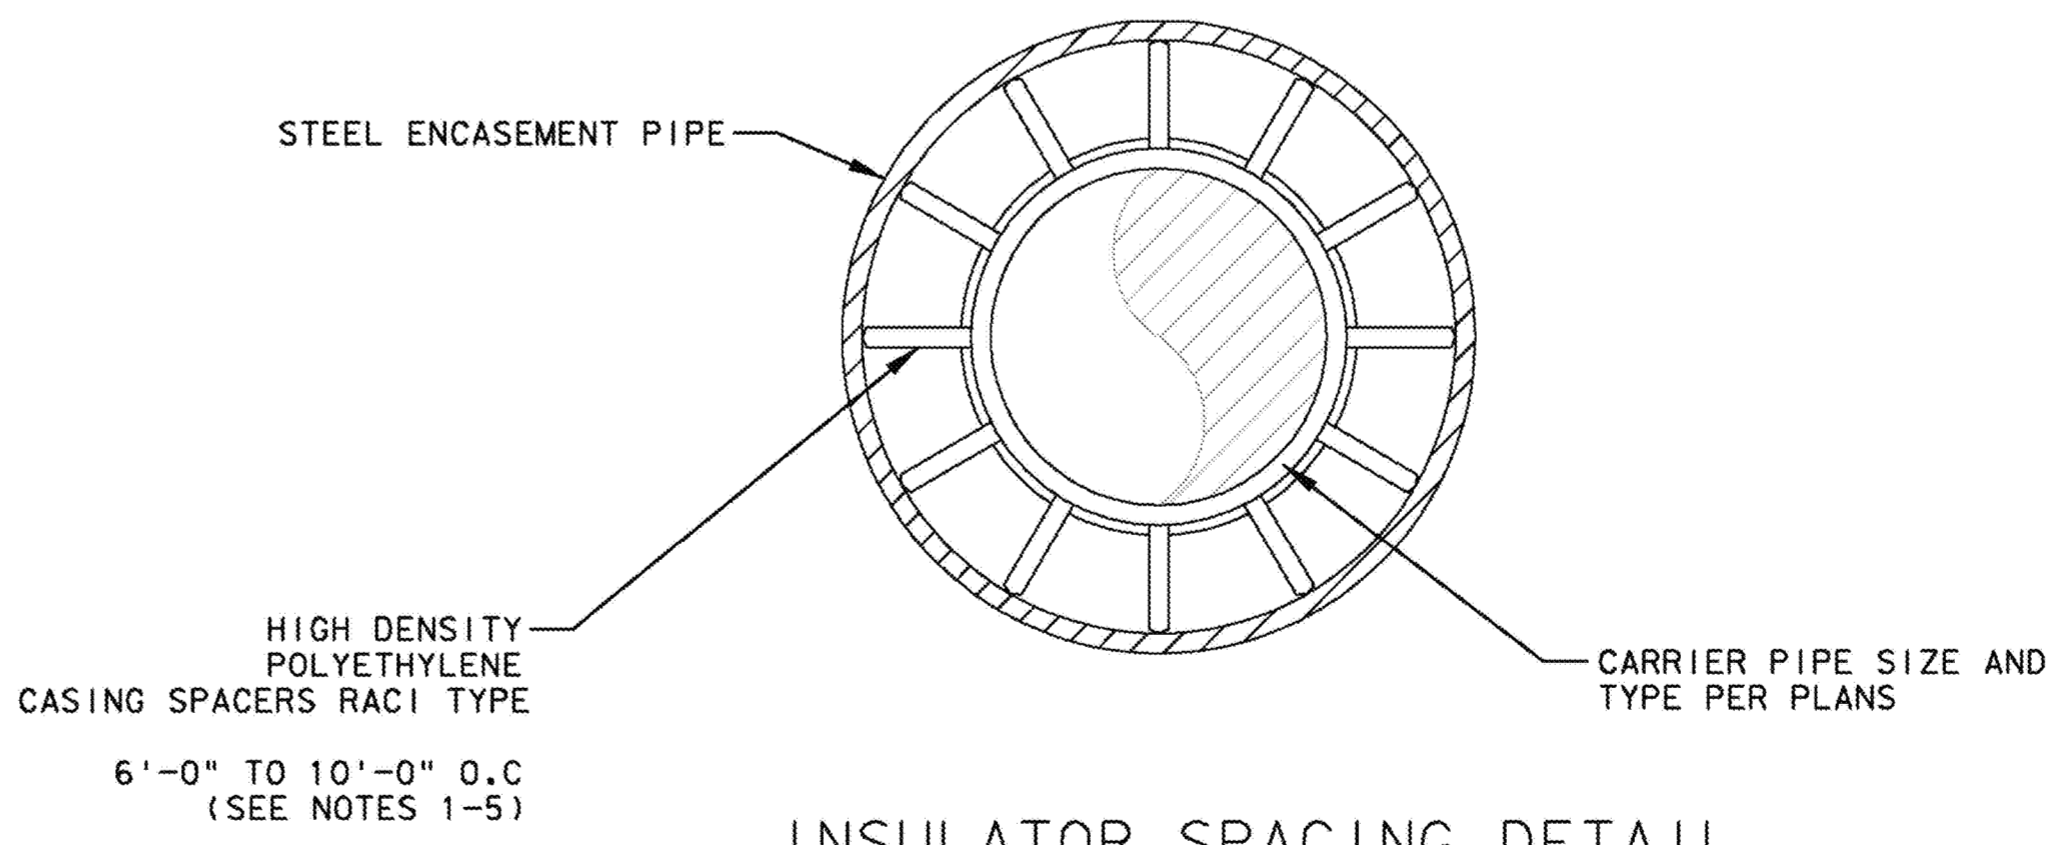


INSULATOR SPACING DETAIL
NOT TO SCALE


BORE CASING PIPE DETAIL
N.T.S.

REVISIONS			
NO.	DESCRIPTION	DATE	BY
Δ	REVISED SPACER NOTE 1	4/16/14	PLG


**RECORD PLANS
MAY 1, 2015**

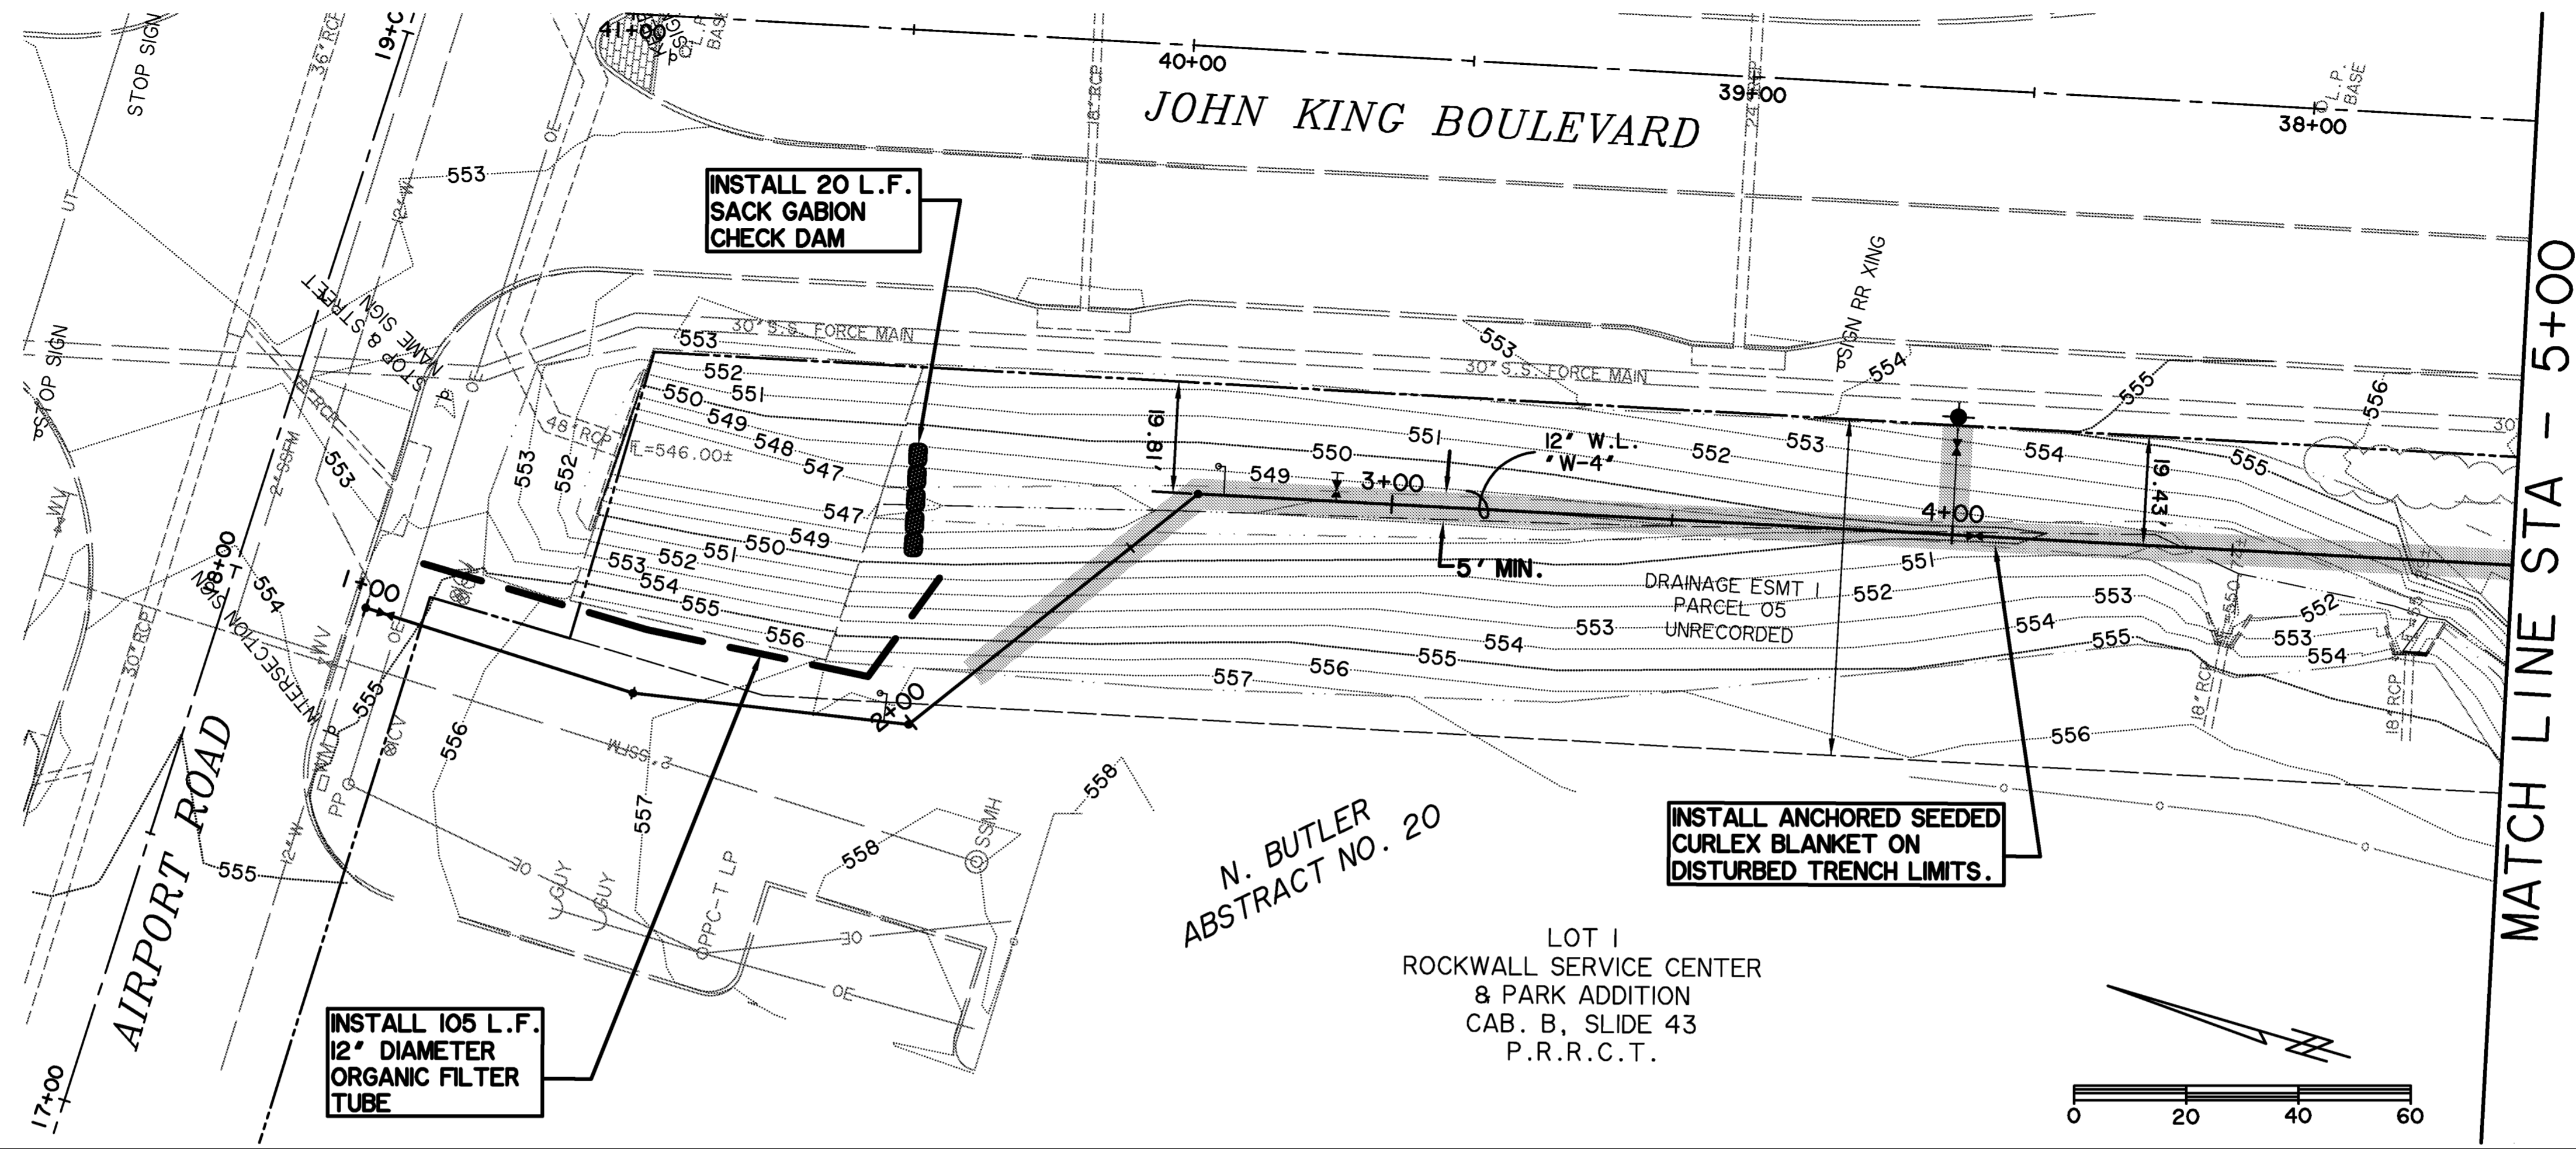

PREPARED BY:
WIER & ASSOCIATES, INC.
ENGINEERS SURVEYORS LAND PLANNERS
701 HIGHLANDER BLVD., SUITE 300 ARLINGTON, TEXAS 76015 METRO (817)467-7700
www.wierassociates.com
Texas Firm Registration No. F-2776

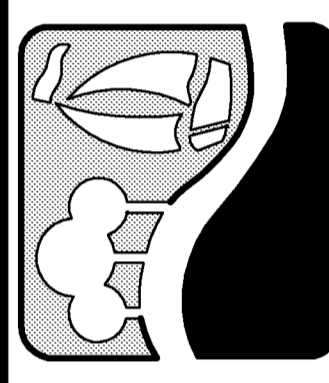


**JOHN KING BOULEVARD
FROM AIRPORT ROAD
TO JUSTIN ROAD
OFFSITE WATER LINE
EROSION CONTROL PLAN
BEGINNING TO STA 10+00**

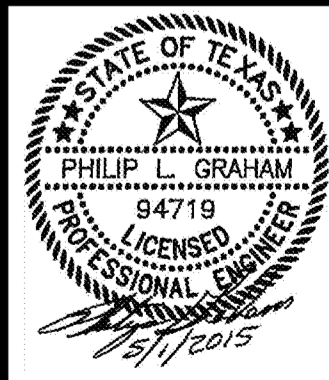

COPYRIGHT ©
WIER & ASSOCIATES, INC.
LAST SHEET EDIT
DATE 4/21/2015
WA# 13096
**SHEET NO.
E101**

PRINTED: 5/1/2015 LAST SAVED: 4/21/2015 4:18 PM. SAVED BY: CLAYTON FILE: OFFSITE-WATER-SWP3-PLAN-I-13096.DWG

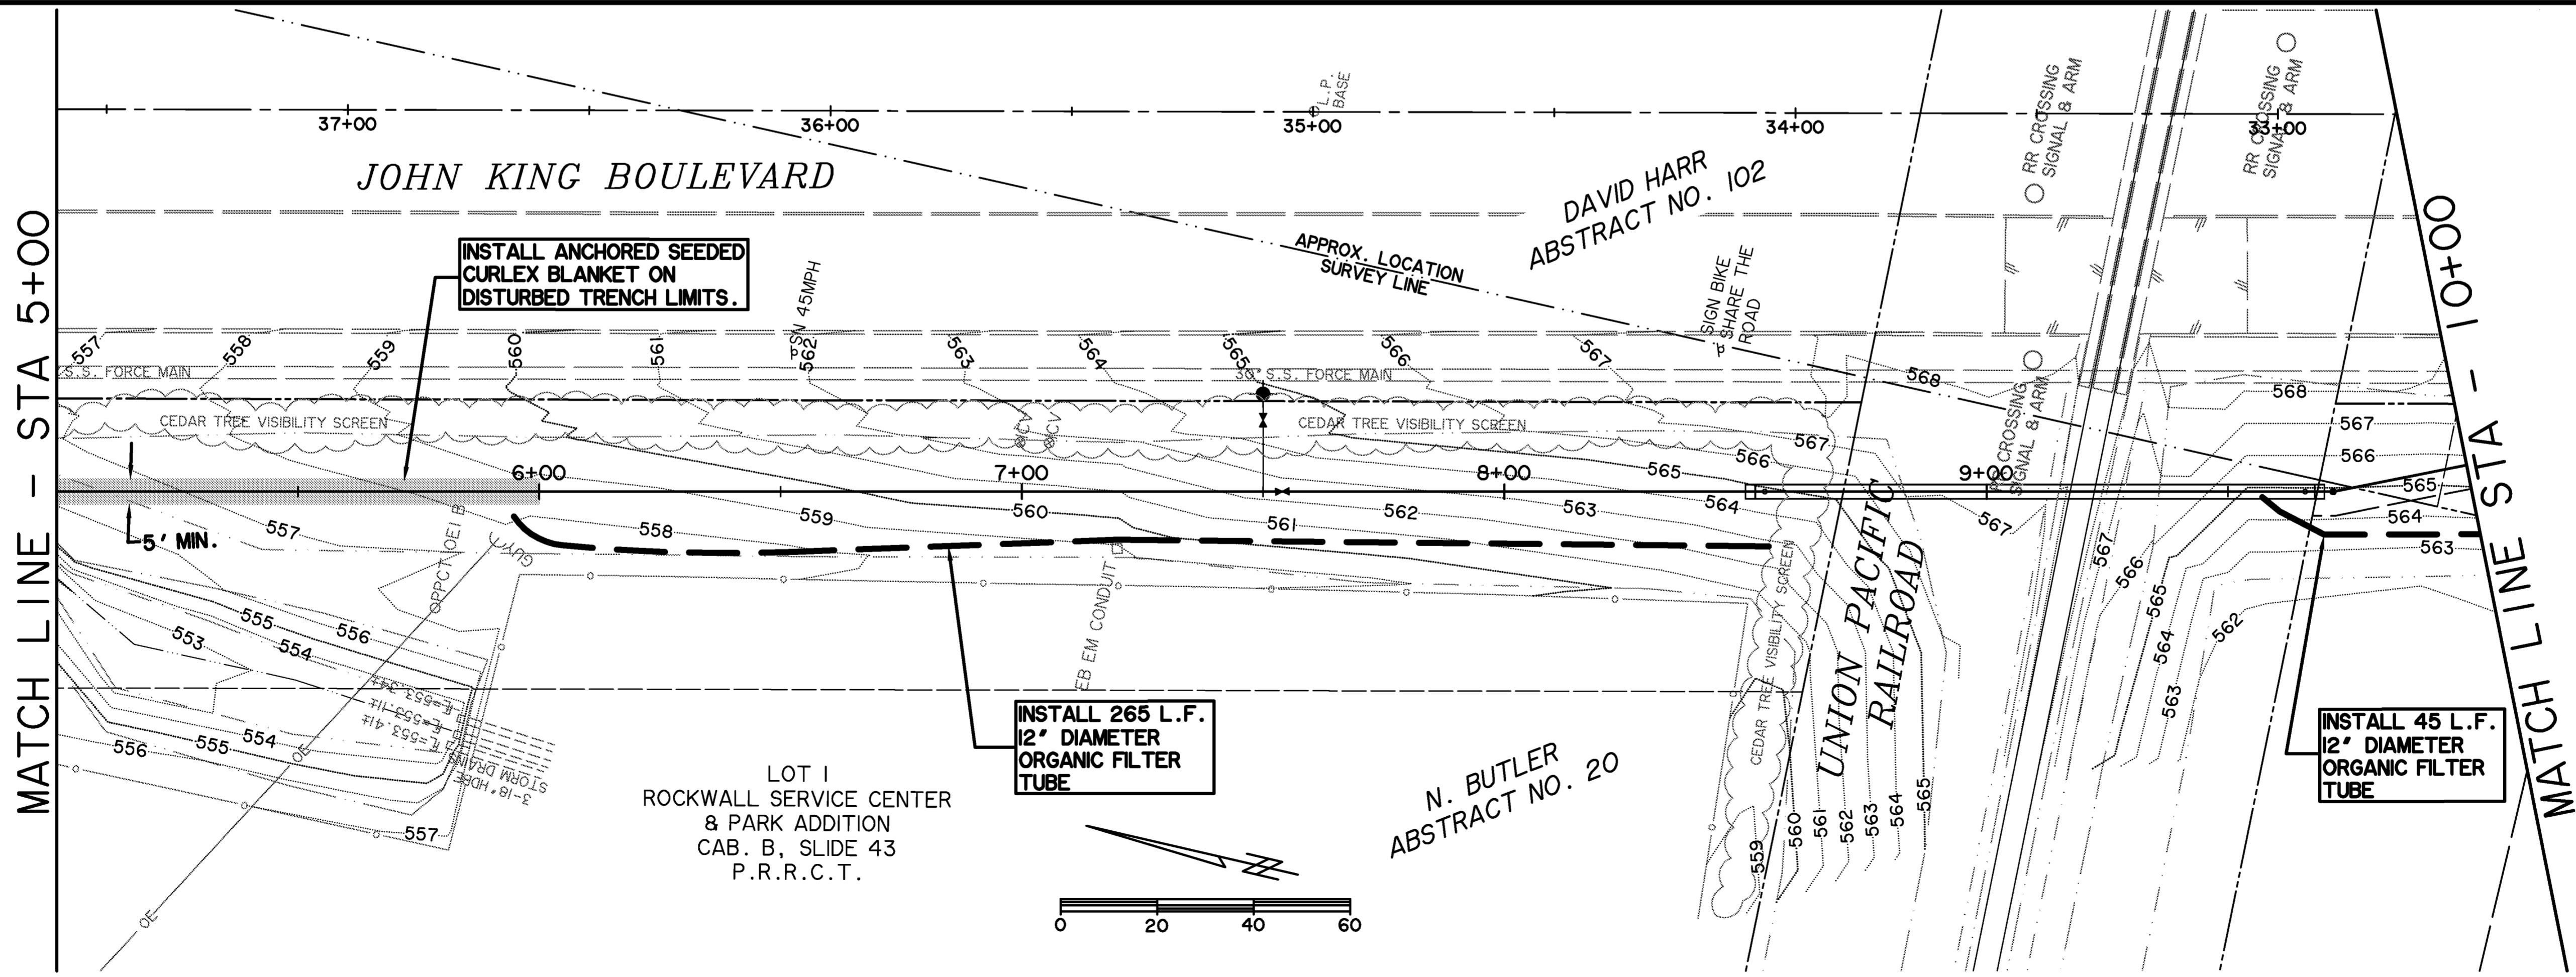

PRINTED: 5/1/2015 LAST SAVED: 4/21/2015 4:18 PM SAVED BY: CLAYTON FILE: OFFSITE-WATER-SWF3-PLAN-2-13096.DWG

RECORD PLANS
MAY 1, 2015

MATCH LINE - STA 10+00

MATCH LINE - STA 15+00

MATCH LINE STA - 15+00

JOHN KING BOULEVARD

JOHN KING BOULEVARD

N. BUTLER
ABSTRACT NO. 20

DAVID HARR
ABSTRACT NO. 102

CITY OF ROCKWALL
VOL. 5418, PG. 54
D.R.R.C.T.

CITY OF ROCKWALL
VOL. 5418, PG. 54
D.R.R.C.T.

CITY OF ROCKWALL
DRAINAGE ESMT
(PARCEL ID#1)
VOL. 6227, PG. 73
D.R.R.C.T.



INSTALL 500 L.F.
12" DIAMETER
ORGANIC FILTER
TUBE

INSTALL 185 L.F.
12" DIAMETER
ORGANIC FILTER
TUBE


SLOPE ESMT
UNRECORDED

DRAINAGE ESMT
UNRECORDED


APPROX. LOCATION
SURVEY LINE

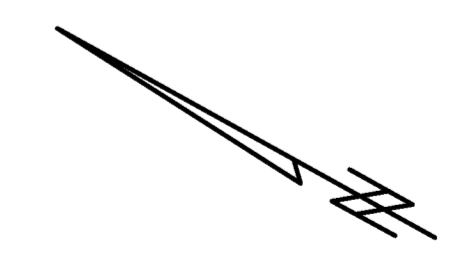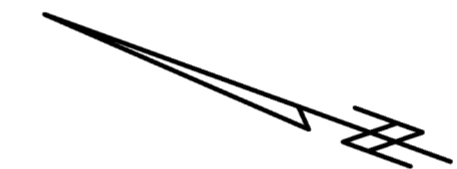

PREPARED BY:
WIER & ASSOCIATES, INC.
ENGINEERS SURVEYORS LAND PLANNERS
701 HIGHLANDER BLVD., SUITE 300 ARLINGTON, TEXAS 76015 METRO (817)467-7700
www.wierassociates.com
Texas Firm Registration No. F-2776

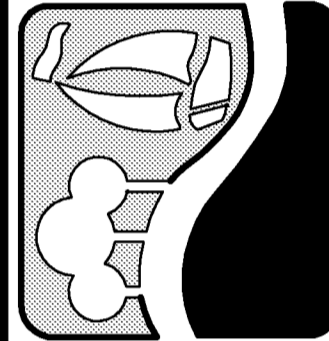


**JOHN KING BOULEVARD
FROM AIRPORT ROAD
TO JUSTIN ROAD
OFFSITE WATER LINE
EROSION CONTROL PLAN
STA 10+00 TO END**

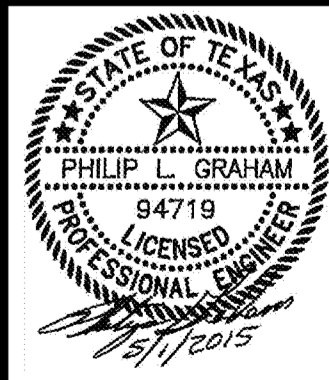

COPYRIGHT ©
WIER & ASSOCIATES, INC.
LAST SHEET TOTAL
DATE 4/21/2015
WA# 13096
SHEET NO.
E102

3.6 Organic Filter Tubes

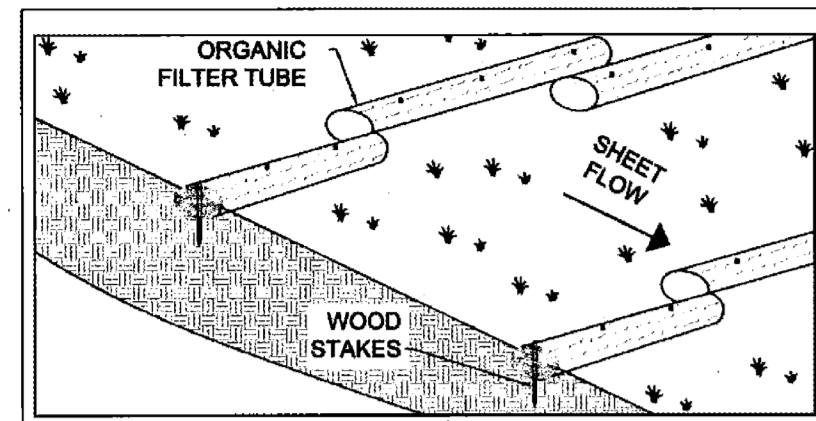

Description: Organic filter tubes are comprised of an open weave, mesh tube that is filled with a filter material (compost, wood chips, straw, coir, aspen fiber, or a mixture of materials). The tube may be constructed of geosynthetic material, plastic, or natural materials. Organic filter tubes are also called fiber rolls, fiber logs, wattles, mulch socks, and/or coir rolls. Filter tubes detain flow and capture sediment as linear controls along the contours of a slope or as a perimeter control down-slope of a disturbed area.

KEY CONSIDERATIONS

- DESIGN CRITERIA:**
- 9 inch minimum tube diameter when filled
 - 3 inch minimum embedment in soil
 - 18 inch minimum overlap at ends of tubes
 - Spacing based on drainage area and slope
 - Must be staked on soil and secured with rockbags on pavement
 - Turn ends of tube lines upslope a minimum of 10 feet
- ADVANTAGES / BENEFITS:**
- Effective means to treat sheet flow over a short distance
 - Relatively easy to install
 - May be used on steep slopes
 - Can provide perimeter control on paved surfaces or where soil type prevents embedment of other controls

- DISADVANTAGES / LIMITATIONS:**
- Difficult to remove when wet and/or filled with sediment
 - Relatively small effective areas for sediment capture

- MAINTENANCE REQUIREMENTS:**
- Inspect regularly
 - Repair eroded areas underneath the organic filter tubes
 - Re-align and stake tubes that are dislodged by flow
 - Remove sediment before it reaches half the height of the exposed tube

TARGETED POLLUTANTS

- Sediment
- Nutrients & Toxic Materials
- Oil & Grease
- Floatable Materials
- Other Construction Wastes

APPLICATIONS

- Perimeter Control
- Slope Protection
- Sediment Barrier
- Channel Protection
- Temporary Stabilization
- Final Stabilization
- Waste Management
- Housekeeping Practices

Fe=0.50-0.75
(Depends on soil type)

IMPLEMENTATION CONSIDERATIONS

- Capital Costs
- Maintenance
- Training
- Suitability for Slopes > 5%
- Other Considerations:**
 - None

3.6.1 Primary Use

Organic filter tubes are long, flexible controls that are used along a line of constant elevation (along a contour) on slopes. They are used as perimeter controls down slope of disturbed areas and on side slopes where stormwater may runoff the area. The tubes maintain sheet flow, slow velocities, and capture sediment. When used on slopes, they also shorten the slope length and protect the slope from erosion.

3.6.2 Applications

Organic filter tubes include a wide variety of tube and filter materials. Organic filter tubes are used as a perimeter sediment barrier, similar to silt fence, for development projects and linear projects, such as roadways and utilities. They work well on individual residential lots and on lots being re-developed, where space may be limited. Organic filter tubes are most effective with coarse to silty soil types. Additional controls may be needed to remove fine silts and clay soils suspended in stormwater.

Organic filter tubes can be used on paved surfaces where it's not possible to stake a silt fence. Applications on paved surfaces include perimeter controls for soil stockpiles, pavement repair areas, utility trenching, and building demolition. When compost filter material is used in tubes on pavement, the material has the added benefit removing some oil and grease from stormwater runoff.

Applications on slopes include temporary sediment control during construction and erosion control of the disturbed soil on the slope. Organic filter tubes may be used to control sheet flow on slopes when final stabilization measures are being applied and established.

Organic filter tubes may also be used for inlet protection and, in limited cases, as check dams in small drainage swales. Refer to Section 3.4 Inlet Protection and Section 2.1 Check Dam for the design criteria to use organic filter tubes in these applications.

3.6.3 Design Criteria

General Criteria

- Filter tubes should be installed along the contour.
- Tubes shall be staked with 2 inch by 2 inch wooden stakes at a maximum spacing of 4 feet. Rebar or similar metal stakes may be used instead of wooden stakes.
- When placed on pavement, sand or rock bags shall be placed abutting the down-slope side of the tubes to prevent runoff from dislodging the tubes. At a minimum, bags shall be placed one foot from each end of the tube and at the middle of the tube.
- Filter tubes shall be embedded a minimum of three inches when placed on soil. Placement on rock shall be designed as placement on pavement.
- The end of tubes shall overlap a minimum of 18 inches when multiple tubes are connected to form a linear control along a contour or a perimeter.
- The last 10 feet (or more) at the ends of a line of tubes shall be turned upslope to prevent bypass by stormwater. Additional upslope lengths of tubes may be needed every 200 to 400 linear feet, depending on the traverse slope along the line of tubes.
- The most common sizes of tubes are 9 and 12 inch diameter; however, tubes are available in sizes up to 24 inch diameter. The designer shall specify a diameter based on the site application. Tubes less than 9 inches in diameter when filled shall not be used.
- Manufactured organic filter tube products shall have documentation of a minimum 75 percent soil retention using ASTM D7351 Standard Test Method for Determination of Sediment Retention Device Effectiveness in Sheet Flow Applications.

- When using manufactured tubes, the manufacturer's recommendations for diameter and spacing based on slope, flow velocities, and other site conditions shall be followed when they are more stringent than the design criteria in this section.
- When used as a perimeter control on grades of 10:1 or less, criteria in the following table shall be used as a guide for the size and installation rate of the organic filter tube.

Drainage Area (Max)	Max Flow Length to the Tube	Tube Diameter (Min)
1/3 Acre per 100 feet	145 feet	18 inches
1/4 Acre per 100 feet	110 feet	15 inches
1/5 Acre per 100 feet	85 feet	12 inches
1/8 Acre per 100 feet	55 feet	9 inches

(Source: Modified and expanded from City of Plano Fact Sheet SP-13)
*Applicable on grades of 10:1 or flatter.

- When installing organic filter tubes along contours on slopes, criteria in the following table shall be used as a general guide for size and spacing of the tubes. Actual tube diameter and spacing shall be specified by the designer. The designer shall consider the tube manufacturer's recommendations, the soil type, flow volume on the slope, required performance life, and erosion control measures that may be used in conjunction with the tubes.

Slope (H:V)	Tube Diameter (Min)			
	9 Inches	12 Inches	18 Inches	24 Inches
5:1 to 10:1	35 feet	40 feet	55 feet	60 feet
4:1	30 feet	40 feet	50 feet	50 feet
3:1	25 feet	35 feet	40 feet	40 feet
2:1	20 feet	25 feet	30 feet	30 feet
1:1	10 feet	15 feet	20 feet	20 feet

(Source: Modified and expanded from Iowa Statewide Urban Design and Specifications Standards for Filter Socks)

Tube Material

- The designer shall specify the type of mesh based on the required life of the tube. At a minimum, the mesh shall have a rated life of one year under field conditions.
- If the tubes will be left onsite as part of the final stabilization, they must be constructed of 100 percent biodegradable jute, coir, sisal or similar natural fiber or 100 percent UV photodegradable plastic, polyester or geosynthetic material.
- Mesh tubes may be oval or round in cross-section.
- Mesh for the tubes shall be open and evenly woven. Size of weave openings shall be specified based on filter material. Openings may range from 1/2 inch for Erosion Control Compost to 2 inches for straw and coir.
- Mesh should not exceed 1/2 inch in diameter.

Filter Material

- Different filter materials have different properties and will affect sheet flow differently. The designer shall specify the type of material to be used (or excluded) on a particular site.
- Straw filter material shall be Certified Weed Free Forage. The straw must be in good condition, air-dried, and not rotten or moldy.

- Compost shall conform to the requirements for Erosion Control Compost in TxDOT Special Specification 1001 Compost (2004). Compost may provide some oil and grease removal; however, the large percentage of fines in compost will result in less filtering and more ponding of stormwater.
- Wood chips shall be 100 percent untreated chips and free of inorganic debris, such as plastic, glass, metal, etc. Wood chip size shall not be smaller than 1 inch and shall not exceed 3 inches in diameter. Shavings shall not be more than 5% of the total mass.

3.6.4 Design Guidance and Specifications

Specifications for Erosion Control Compost to be used as filter material may be found in Item 161 of the Standard Specifications for Construction and Maintenance of Highways, Streets, and Bridges (TxDOT 2004) and TxDOT Special Specification 1001 Compost (2004).

3.6.5 Inspection and Maintenance Requirements

Organic filter tubes should be inspected regularly (at least as often as required by the TPDES Construction General Permit). The filter tube should be checked to ensure that it is in continuous contact with the soil at the bottom of the embedment trench. Closely check for rill erosion that may develop under the filter tubes. Eroded spots must be repaired and monitored to prevent recurrence. If erosion under the tube continues, additional controls are needed.

Staking shall be checked to ensure that the filter tubes are not moving due to stormwater runoff. Repair and re-stake slumping filter tubes. Tubes that are split, torn or unraveling shall be repaired or replaced.

Check the filter tube material to make sure that it has not become clogged with sediment or debris. Clogged filter tubes usually lead to standing water behind the filter tube after the rain event. Sediment shall be removed from behind the filter tube before it reaches half the height of the exposed portion of the tube.



When sediment control is no longer needed on the site, the tubes may be split open and the filter material may be used for mulching during establishment of vegetation for final stabilization if it meets the criteria in Section 2.5 Mulching.

3.6.6 Example Schematics


The following schematics are example applications of the construction control. They are intended to assist in understanding the control's design and function.

The schematics are not for construction. They may serve as a starting point for creating a construction detail, but they must be site adapted by the designer. In addition, dimensions and notes appropriate for the application must be added by the designer.

**RECORD PLANS
MAY 1, 2015**

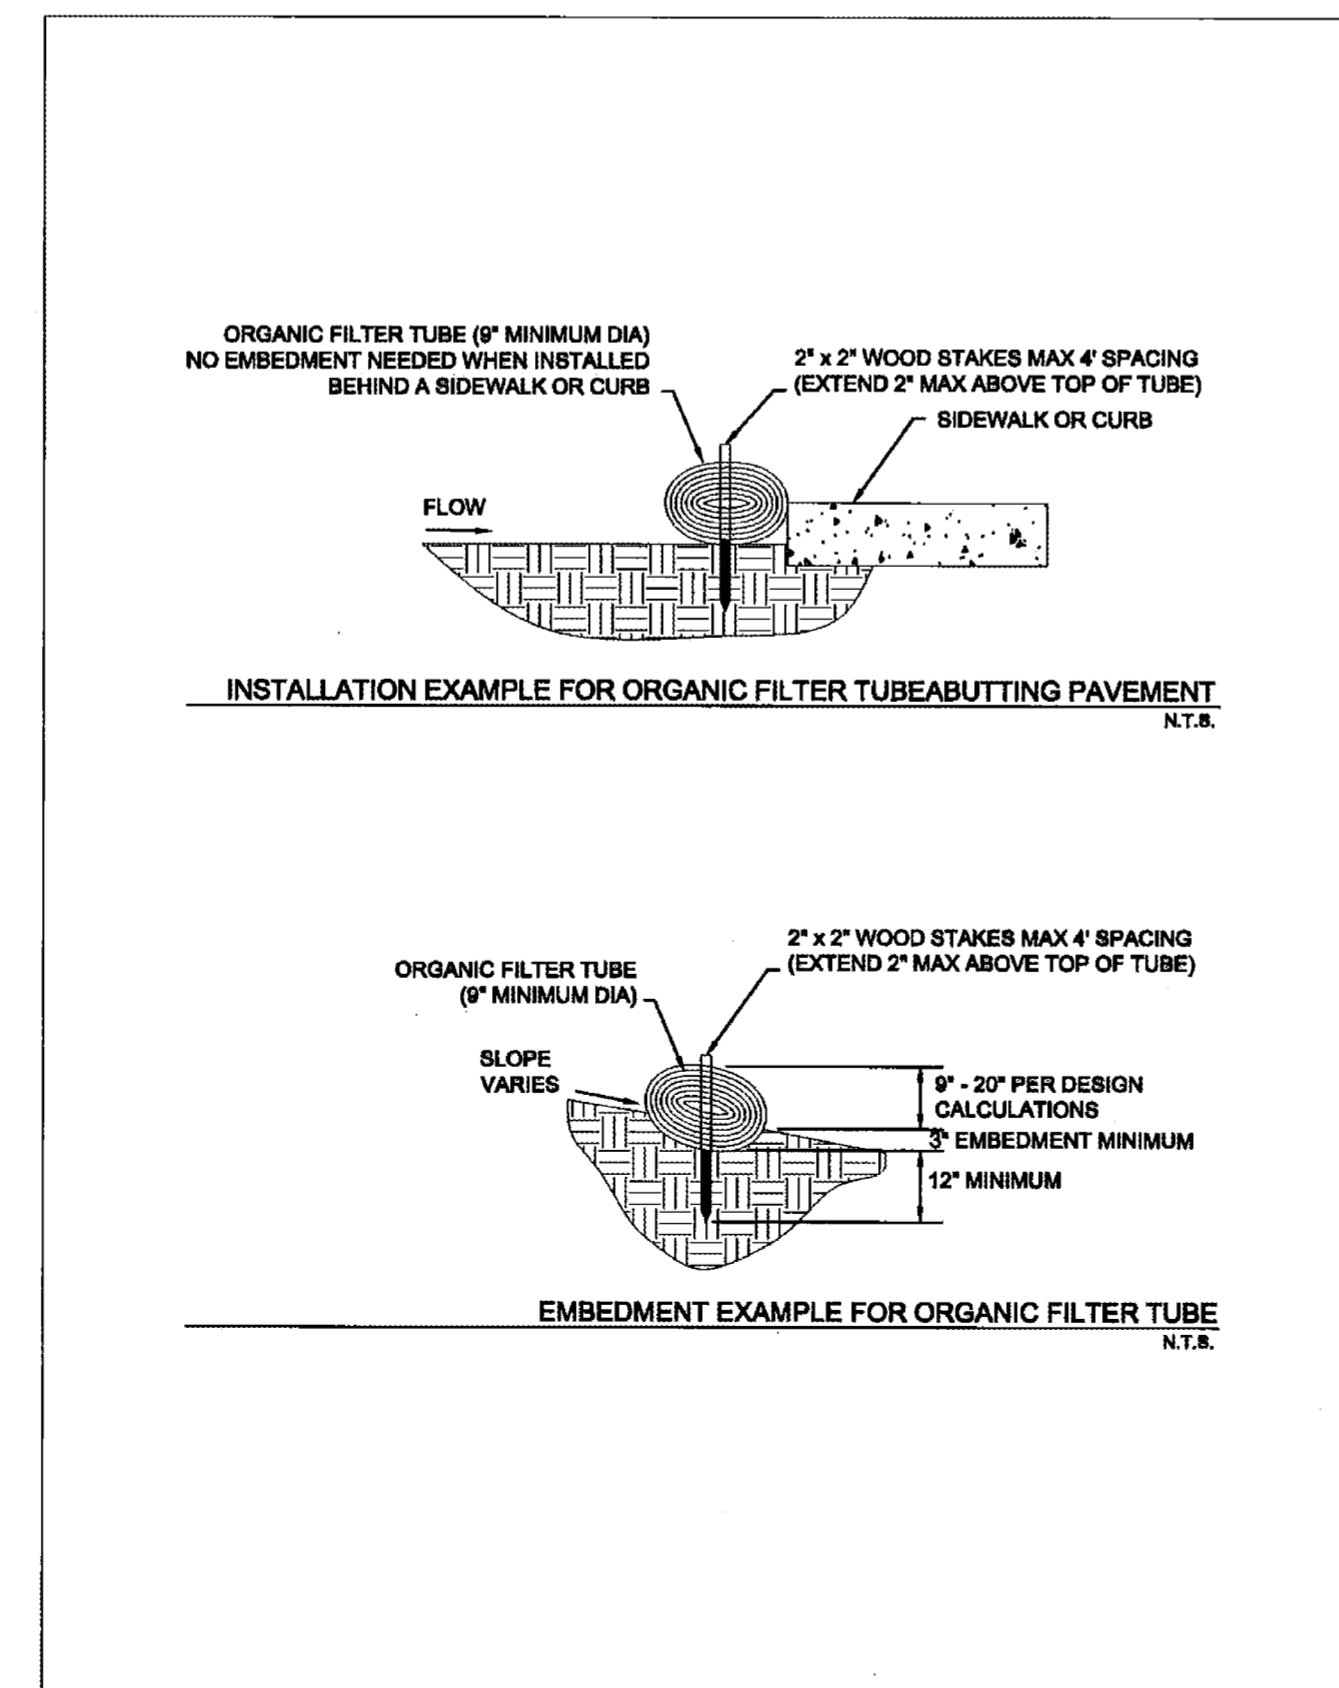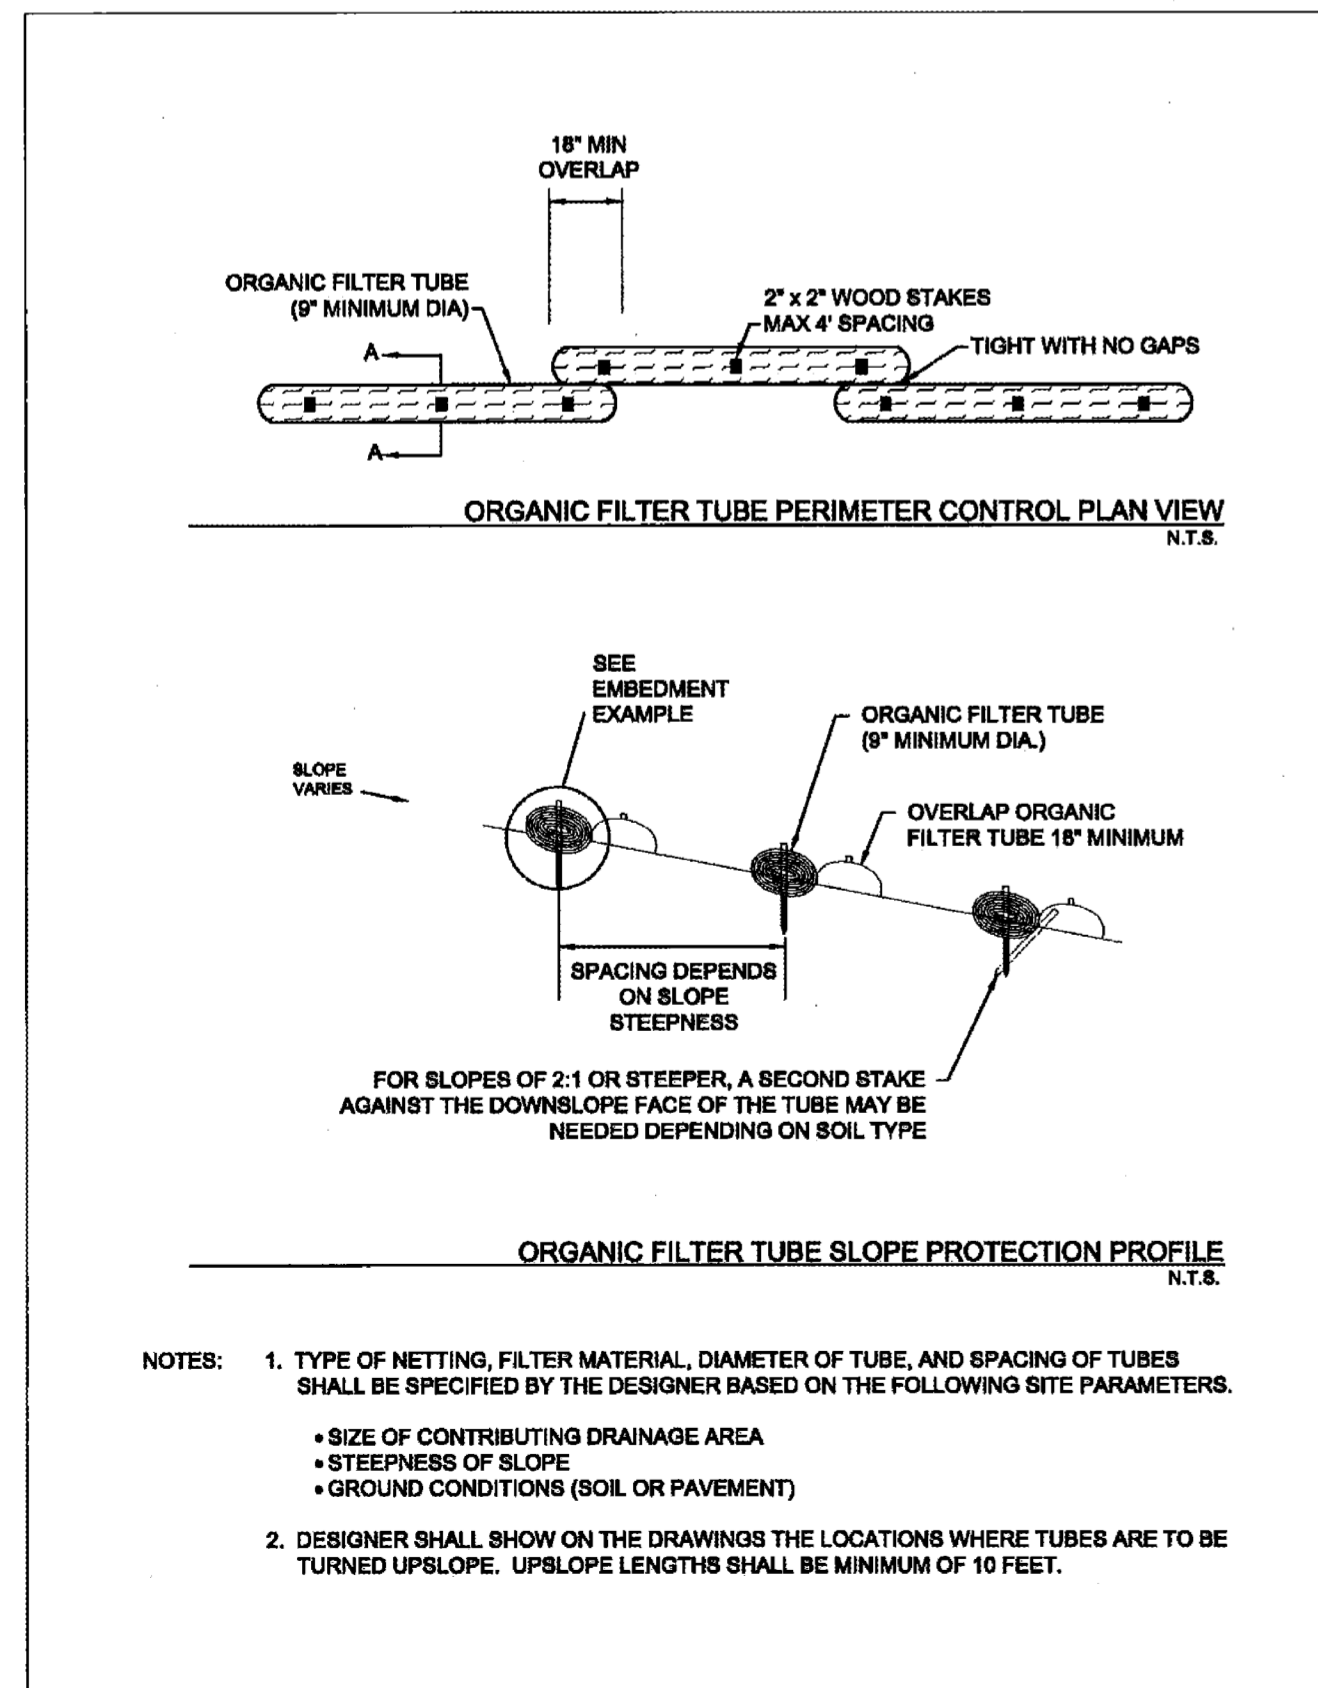

2.1 Check Dam

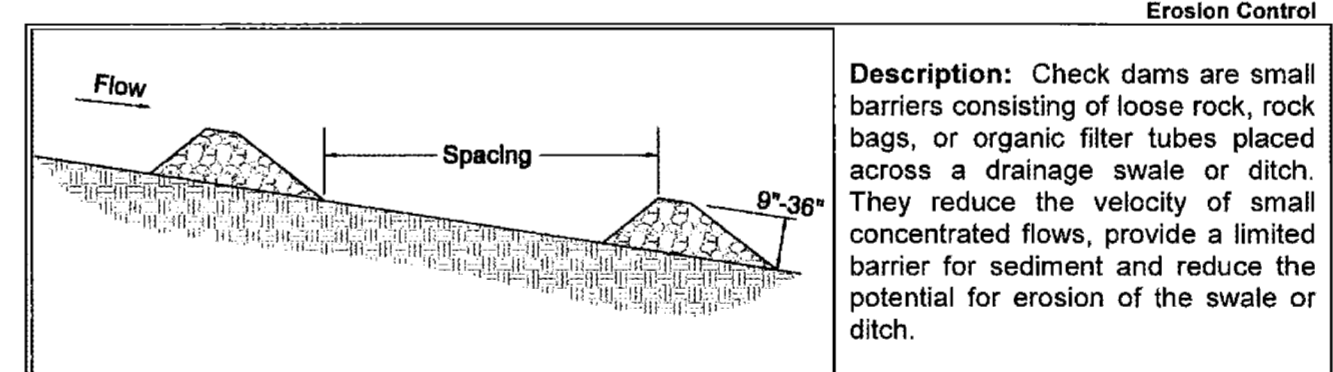

Description: Check dams are small barriers consisting of loose rock, rock bags, or organic filter tubes placed across a drainage swale or ditch. They reduce the velocity of small concentrated flows, provide a limited barrier for sediment and reduce the potential for erosion of the swale or ditch.

KEY CONSIDERATIONS

- DESIGN CRITERIA:**
- Heights between 9 inches and 36 inches
 - Top of the downstream dam should be at the same elevation as the toe of the upstream dam

- ADVANTAGES / BENEFITS:**
- Reduced velocities in long drainage swales or ditches
 - May be used with other channel protection measures
 - Provides some sediment removal

- DISADVANTAGES / LIMITATIONS:**
- Cannot be used in live stream channels
 - Minor ponding upstream of the check dams
 - Extensive maintenance or replacement of the dams required after heavy flows or high velocity flows
 - Mowing hazard from loose rocks if all rock is not removed at end of construction

- MAINTENANCE REQUIREMENTS:**
- Inspect regularly
 - Remove silt when it reaches approximately 1/2 the height of the dam or 12 inches, whichever is less

TARGETED POLLUTANTS

- Sediment
- Nutrients & Toxic Materials
- Oil & Grease
- Floatable Materials
- Other Construction Wastes

APPLICATIONS

- Perimeter Control
- Slope Protection
- Sediment Barrier
- Channel Protection
- Temporary Stabilization
- Final Stabilization
- Waste Management
- Housekeeping Practices

Fe=0.30-0.50
(Depends on soil type)

IMPLEMENTATION CONSIDERATIONS

- Capital Costs
- Maintenance
- Training
- Suitability for Slopes > 5%
- Other Considerations:**
 - None

2.1.1 Primary Use

Check dams are used in long drainage swales or ditches to reduce erosive velocities. They are typically used in conjunction with other channel protection techniques such as vegetation lining and turf reinforcement mats. Check dams provide limited treatment to sediment-laden flows. They are more useful in reducing flow velocities to acceptable levels for stabilization methods. Check dams may be used in combination with stone outlet sediment traps, where the check dams prevent erosion of the swale while the sediment trap captures sediment at the downstream end of the swale.

2.1.2 Applications

Check dams are typically used in swales and drainage ditches along linear projects such as roadways. They can also be used in short swales down a steep slope, such as swales down a highway embankment, to reduce velocities. Check dams shall not be used in live stream channels.


Check dams should be installed before the contributing drainage area is disturbed, so as to mitigate the effects on the swale from the increase in runoff. If the swale itself is graded as part of the construction activities, check dams are installed immediately upon completion of grading to control velocities in the swale until stabilization is completed.

2.1.3 Design Criteria


General Criteria

- Typically, the dam height should be between 9 inches and 36 inches, depending on the material of which they are made. The height of the check dam shall always be less than one-third the depth of the channel.
- Dams should be spaced such that the top of the downstream dam is at the same elevation as the toe of the upstream dam. On channel grades flatter than 0.4 percent, check dams should be placed at a distance that allows small pools to form between each check dam.
- The top of the side of the check dam shall be a minimum of 12 inches higher than the middle of the dam. In addition, the side of the dams shall be embedded a minimum of 18 inches into the side of the drainage ditch, swale or channel to minimize the potential for flows to erode around the side of the dam.
- Larger flows (greater than 2-year, 24-hour design storm) must pass the check dam without causing excessive upstream flooding.
- Check dams should be used in conjunction with other sediment reduction techniques prior to releasing flow onsite.
- Use geotextile filter fabric under check dams of 12 inches in height or greater. The fabric shall meet the following minimum criteria:
 - Tensile Strength, ASTM D4632 Test Method for Grab Breaking Load and Elongation of Geotextiles, 250-lbs.
 - Puncture Rating, ASTM D4833 Test Method for Index Puncture Resistance of Geotextiles, Geomembranes, and Related Products, 135-lbs.
 - Mullen Burst Rating, ASTM D3786 Standard Test Method for Hydraulic Bursting Strength of Textile Fabrics-Diaphragm Bursting Strength Tester Method, 420-psi.
 - Apparent Opening Size, ASTM D4751 Test Method for Determining Apparent Opening Size of a Geotextile, U.S. Sieve No. 20 (max).
- Loose, unconfined soil, wood chips, compost, and other material that can float or be transported by runoff shall not be used to construct check dams.

PREPARED BY:
WIER & ASSOCIATES, INC.
SURVEYORS LAND PLANNERS
ENGINEERS
701 HIGHLANDER BLVD., SUITE 300 ARLINGTON, TEXAS 76015 METRO (817)467-7700
www.wierassociates.com
Texas Firm Registration No. F-2776

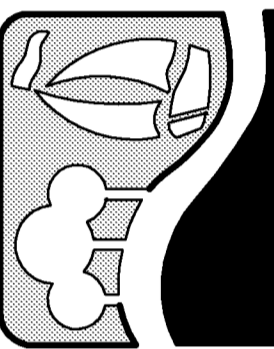

JOHN KING BOULEVARD
FROM AIRPORT ROAD
TO JUSTIN ROAD
OFFSITE WATER LINE
EROSION CONTROL DETAILS

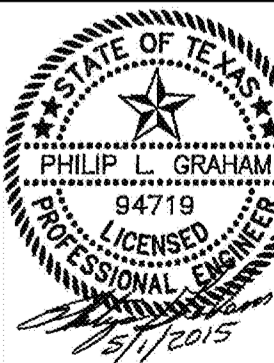

COPYRIGHT ©
WIER & ASSOCIATES, INC.
LAST SHEET EDIT
DATE 4/21/2015
WA# 13096

SHEET NO.
E201

Rock Check Dams

- Stone shall be well graded with stone size ranging from 3 to 6 inches in diameter for a check dam height of 24 inches or less. The stone size range for check dams greater than 24 inches is 4 to 8 inches in diameter.
- Rock check dams shall have a minimum top width of 2 feet with side slopes of 2:1 or flatter.

Rock Bag Check Dams

- Rock bag check dams should have a minimum top width of 16 inches.
- Bag length shall be 24 inches to 30 inches, width shall be 16 inches to 18 inches and thickness shall be 6 inches to 8 inches and having a minimum weight of 40 pounds.
- Minimum rock bag dam height of 12 inches would consist of one row of bags stacked on top of two rows of bag. The dam shall always be one more row wide than it is high, stacked pyramid fashion.
- Bags should be filled with pea gravel, filter stone, or aggregate that is clean and free of deleterious material.
- Sand bags shall not be used for check dams, due to their propensity to break and release sand that is transported by the concentrated flow in the drainage swale or ditch.
- Bag material shall be polypropylene, polyethylene, polyamide or cotton burlap woven fabric, minimum unit weight 4-ounces-per-square-yard, Mullen burst strength exceeding 300-psi as determined by ASTM D3786, Standard Test Method for Hydraulic Bursting Strength of Textile Fabrics-Diaphragm Bursting Strength Tester Method, and ultraviolet stability exceeding 70 percent.
- PVC pipes may be installed through the dam to allow for controlled flow through the dam. Pipe should be schedule 40 or heavier polyvinyl chloride (PVC) having a nominal internal diameter of 2 inches.

Sack Gabion Check Dams

- Sack gabion check dams may be used in channels with a contributing drainage area of 5 acres or less.
- Sack gabions shall be wrapped in galvanized steel, woven wire mesh. The wire shall be 20 gauge with 1 inch diameter, hexagonal openings.
- Wire mesh shall be one piece, wrapped around the rock, and secured to itself on the downstream side using wire ties or hog rings.
- Sack gabions shall be staked with 3/4 inch rebar at a maximum spacing of three feet. Each wire sack shall have a minimum of two stakes.
- Stone shall be well graded with a minimum size range from 3 to 6 inches in diameter.

Organic Filter Tube Check Dams

- Organic filter tubes may be used as check dams in channels with a contributing drainage area of 5 acres or less.
- Organic filter tubes shall be a minimum of 12 inches in diameter.
- Filter material used within tubes to construct check dams shall be limited to coir, straw, aspen fiber and other organic material with high cellulose content. The material should be slow to decay or leach nutrients in standing water.
- Staking of filter tubes shall be at a maximum of 4 foot spacing and shall alternate through the tube and on the downstream face of the tube.
- Unless superseded by requirements in this section, filter tubes and filter material shall comply with the

Check Dam Revised 04/10	CC-14
iSWM™ Technical Manual	Construction Controls

criteria in Section 3.6 Organic Filter Tubes.

2.1.4 Design Guidance and Specifications

Specifications for construction of this item may be found in the Standard Specifications for Public Works Construction – North Central Texas Council of Governments, Section 201.9 Check Dam (Rock). Specifications are also available in the Standard Specifications for Construction and Maintenance of Highways, Streets, and Bridges (TxDOT 2004), Item 506.2.A and Item 506.4.C.1.

2.1.5 Inspection and Maintenance Requirements


Check dams should be inspected regularly (at least as often as required by the TPDES Construction General Permit). Silt must be removed when it reaches approximately 1/3 the height of the dam or 12 inches, whichever is less. Inspectors should monitor the edges of the dam where it meets the sides of the drainage ditch, swale or channel for evidence of erosion due to bypass or high flows. Eroded areas shall be repaired. If erosion continues to be a problem, modifications to the check dam or additional controls are needed.

Care must be used when taking out rock check dams in order to remove as much rock as possible. Loose rock can create an extreme hazard during mowing operations once the area has been stabilized.

2.1.6 Example Schematics

The following schematics are example applications of the construction control. They are intended to assist in understanding the control's design and function.

The schematics are **not for construction**. They may serve as a starting point for creating a construction detail, but they must be adapted for the site by the designer. Dimensions and notes appropriate for the application must also be added by the designer.

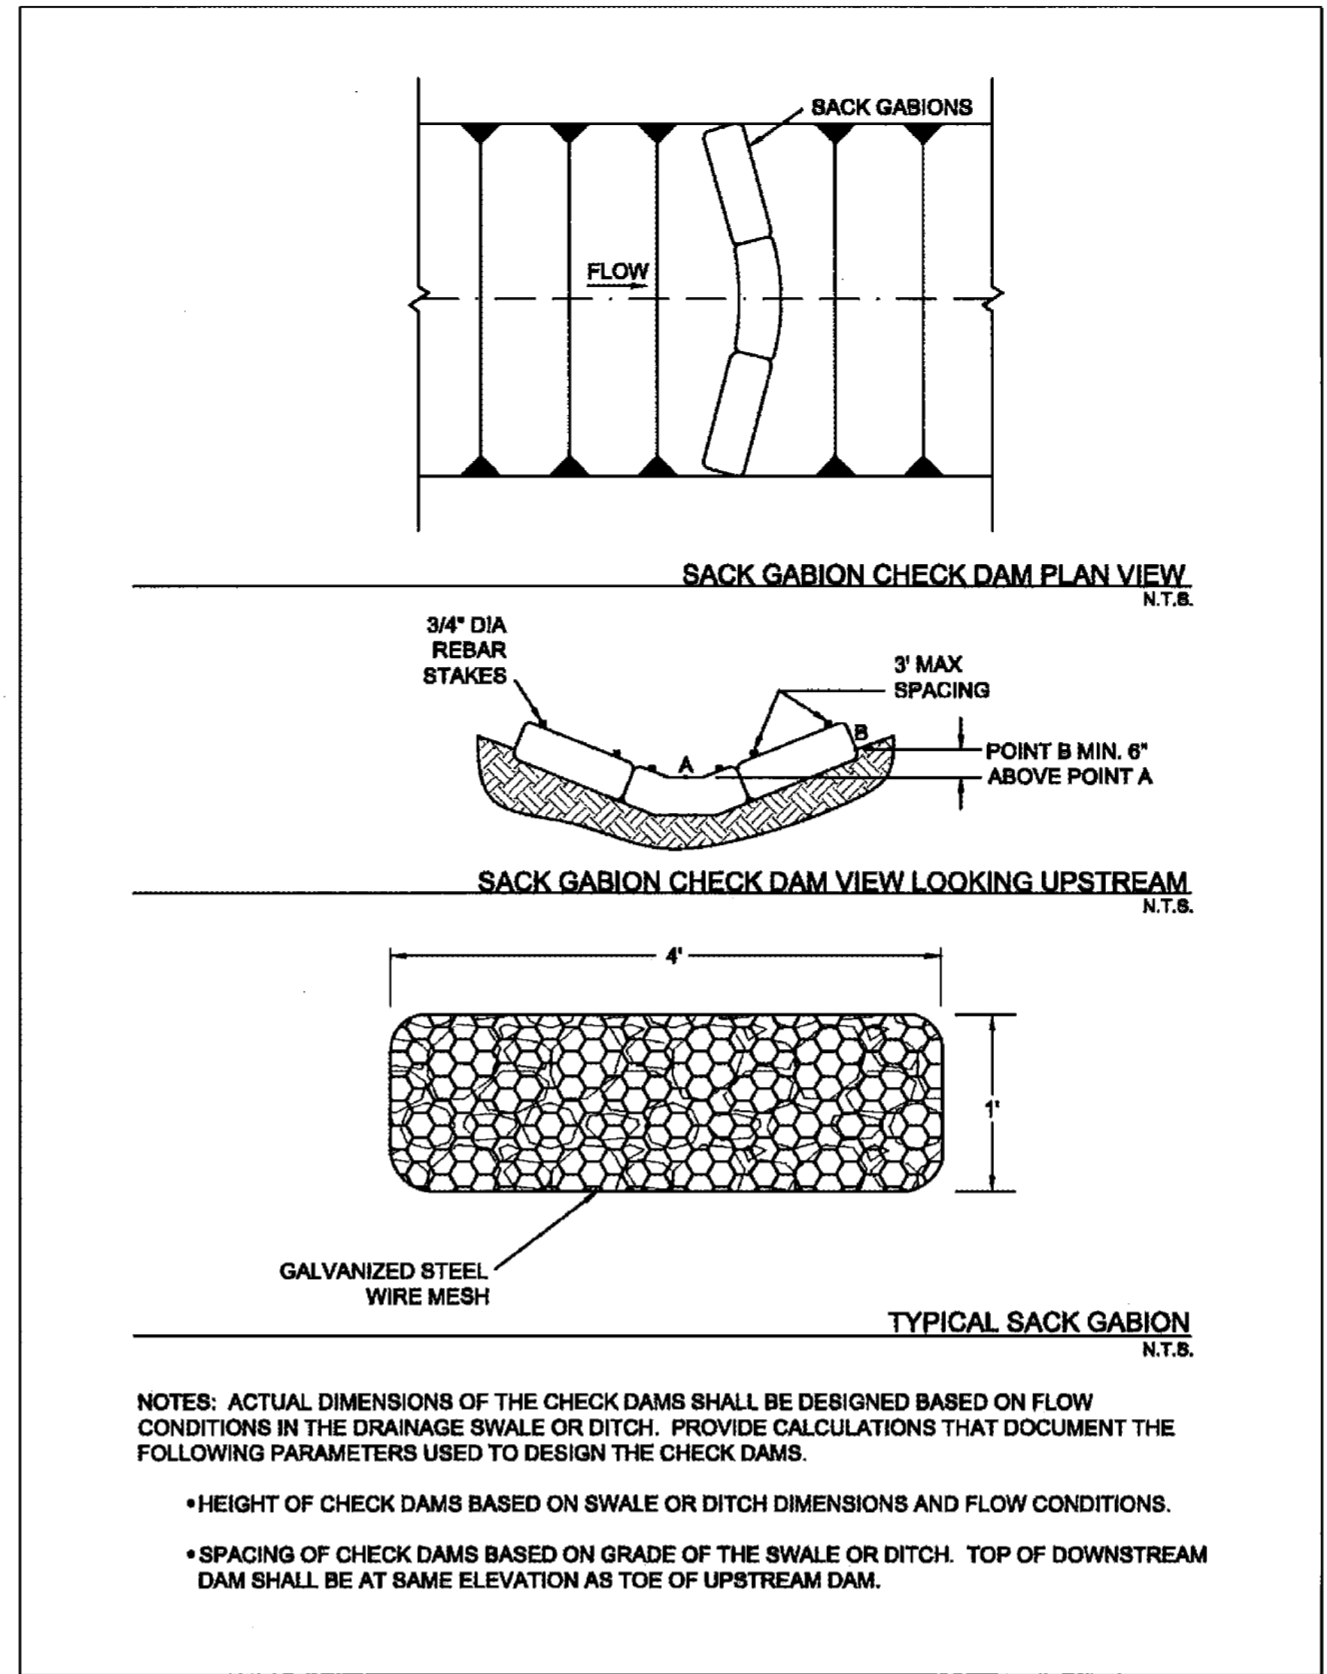

Check Dam Revised 04/10	CC-18
iSWM™ Technical Manual	Construction Controls

2.3.1 Primary Use

Erosion control blankets (ECBs) are used to hold seed and soil in place until vegetation is established on disturbed areas. They can be used on many types of disturbed areas, but are particularly effective for slopes and embankments and in small drainage swales.

ECBs seeded for vegetation may be used as a perimeter control. When used in combination with other sediment barriers, such as silt fence or organic filter tubes, blankets may be used as a perimeter control with or without vegetation.

2.3.2 Applications

ECBs may be used on many types of disturbed areas but are most applicable on gradual to steep (2:1) cut/fill slopes and in swales and channels with low to moderate flow velocities. In these applications they may provide temporary stabilization by themselves or may be used with seeding to provide final stabilization. ECBs are also used to establish vegetation in channels where velocities are less than 6.0 feet per second.

When seeded for establishment of vegetation, ECBs can be an effective perimeter along the down slope side of linear construction projects (roads and utilities). ECBs with vegetation are also used as perimeter controls for new development, particularly at the front on residential lots in new subdivisions. ECBs are an effective aid in establishing vegetated filter strips.

2.3.3 Design Criteria

- The designer shall specify the manufacturer, type of erosion control blanket to be used, and dimensioned limits of installation based on the site topography and drainage.
- The type and class of erosion control blanket must be specified in accordance with the manufacturer's guidance for the slope of the area to be protected, the flow rate (sheet flow on cut/fill slopes) or velocity (concentrated flow in swales) of stormwater runoff in contact with the ECB, and the anticipated length of service.
- ECBs should meet the applicable "Minimum Performance Standards for TxDOT" as published by TxDOT in its "Erosion Control Report" and/or be listed on the most current annual "Approved Products List for TxDOT" applicable to TxDOT Item 169 Soil Retention Blanket and its Special Provisions.
- ECBs shall be installed vertically down slope (across contours) on cut/fill slopes and embankments and along the contours (parallel to flow) in swales and drainage ditches.
- ECBs designed to remain onsite as part of final stabilization shall have netting or mesh only on one side (the exposed side) of the ECB. The ECB shall be installed with the side that does not have netting or mesh in contact with the soil surface. All materials in the ECB, including anchors, should be 100 percent biodegradable within three years.
- On cut/fill slopes and drainage ditches or swales designed to receive erosion control blankets for temporary or final stabilization, installation of the ECBs shall be initiated immediately after completing grading of the slope or drainage way, and in no case later than 14 days after completion of grading these features. Do not delay installation of ECBs on these highly-erodible areas until completion of construction activities and stabilization of the remainder of the site.
- Unless the ECB is seeded to establish vegetation, perimeter control applications shall be limited to thirty foot wide drainage areas (i.e. linear construction projects) for an 8 foot width of ECB. When seeded for vegetation, use of ECBs for perimeter control shall follow the criteria in the Section 3.15 Vegetated Filter Strips and Buffers.
- Prior to the installation of the ECB, all rocks, dirt clods, stumps, roots, trash and any other obstructions that would prevent the ECB from lying in direct contact with the soil shall be removed.

Erosion Control Blankets Revised 04/10	CC-26
--	-------

- Anchor trenching shall be located along the top of slope of the installation area, except for small areas with less than 2 percent slope.
- Installation and anchoring shall conform to the recommendations shown within the manufacturer's published literature for the erosion control blanket. Anchors (staples) shall be a minimum of 8 inches in length and 1 inch wide. They shall be made of 11-gauge wire, or equivalent, unless the ECB is intended to remain in place with final stabilization and biodegrade.
- Particular attention must be paid to joints and overlapping material. Overlap along the sides and at the ends of ECBs should be per the manufacturer's recommendations for site conditions and the type of ECB being installed. At a minimum, the end of each roll of ECB shall overlap the next roll by 3 feet and the sides of rolls shall overlap 4 inches.
- After installation, the blankets should be checked for uniform contact with the soil, security of the lap joints, and flushness of the staples with the ground.
- When ECBs are installed to assist with establishing vegetation, seeding shall be completed before installation of the ECB. Criteria for seeding are provided in Section 2.9 Vegetation.
- Turf Reinforcement Mats should be used instead of ECBs for permanent erosion control and for stabilizing slopes greater than 2:1.
- ECBs are limited to use in swales and channels that have shear stresses of less than 2.0 pounds per square foot. Turf reinforcement mats shall be used in open channels with higher shear stresses.

2.3.4 Design Guidance and Specifications

Specifications for construction of this item may be found in the Standard Specifications for Public Works Construction – North Central Texas Council of Governments, Section 201.15 Erosion Control Blankets and in Item 169 of the Standard Specifications for Construction and Maintenance of Highways, Streets, and Bridges (TxDOT, 2004).

2.3.5 Inspection and Maintenance Requirements


Erosion control blankets should be inspected regularly (at least as often as required by the TPDES Construction General Permit) for bare spots caused by weather or other events. Missing or loosened blankets must be replaced or re-anchored.

Check for excess sediment deposited from runoff. Remove sediment and/or replace blanket as necessary. In addition, determine the source of excess sediment and implement appropriate measures to control the erosion. Also check for rill erosion developing under the blankets. If found, repair the eroded area. Determine the source of water causing the erosion and add controls to prevent its recurrence.

2.3.6 Example Schematics


The following schematics are example applications of the construction control. They are intended to assist in understanding the control's design and function.

The schematics are **not for construction**. The designer is responsible for working with ECB manufacturers to ensure the proper ECB is specified based on the site topography and drainage. Installation measures should be dictated by the ECB manufacturer and are dependent on the type of ECB installed. Manufacturer's recommendations for overlap, anchoring, and stapling shall always be followed. Criteria shown here are applicable only when they are more stringent than those provided by the manufacturer.

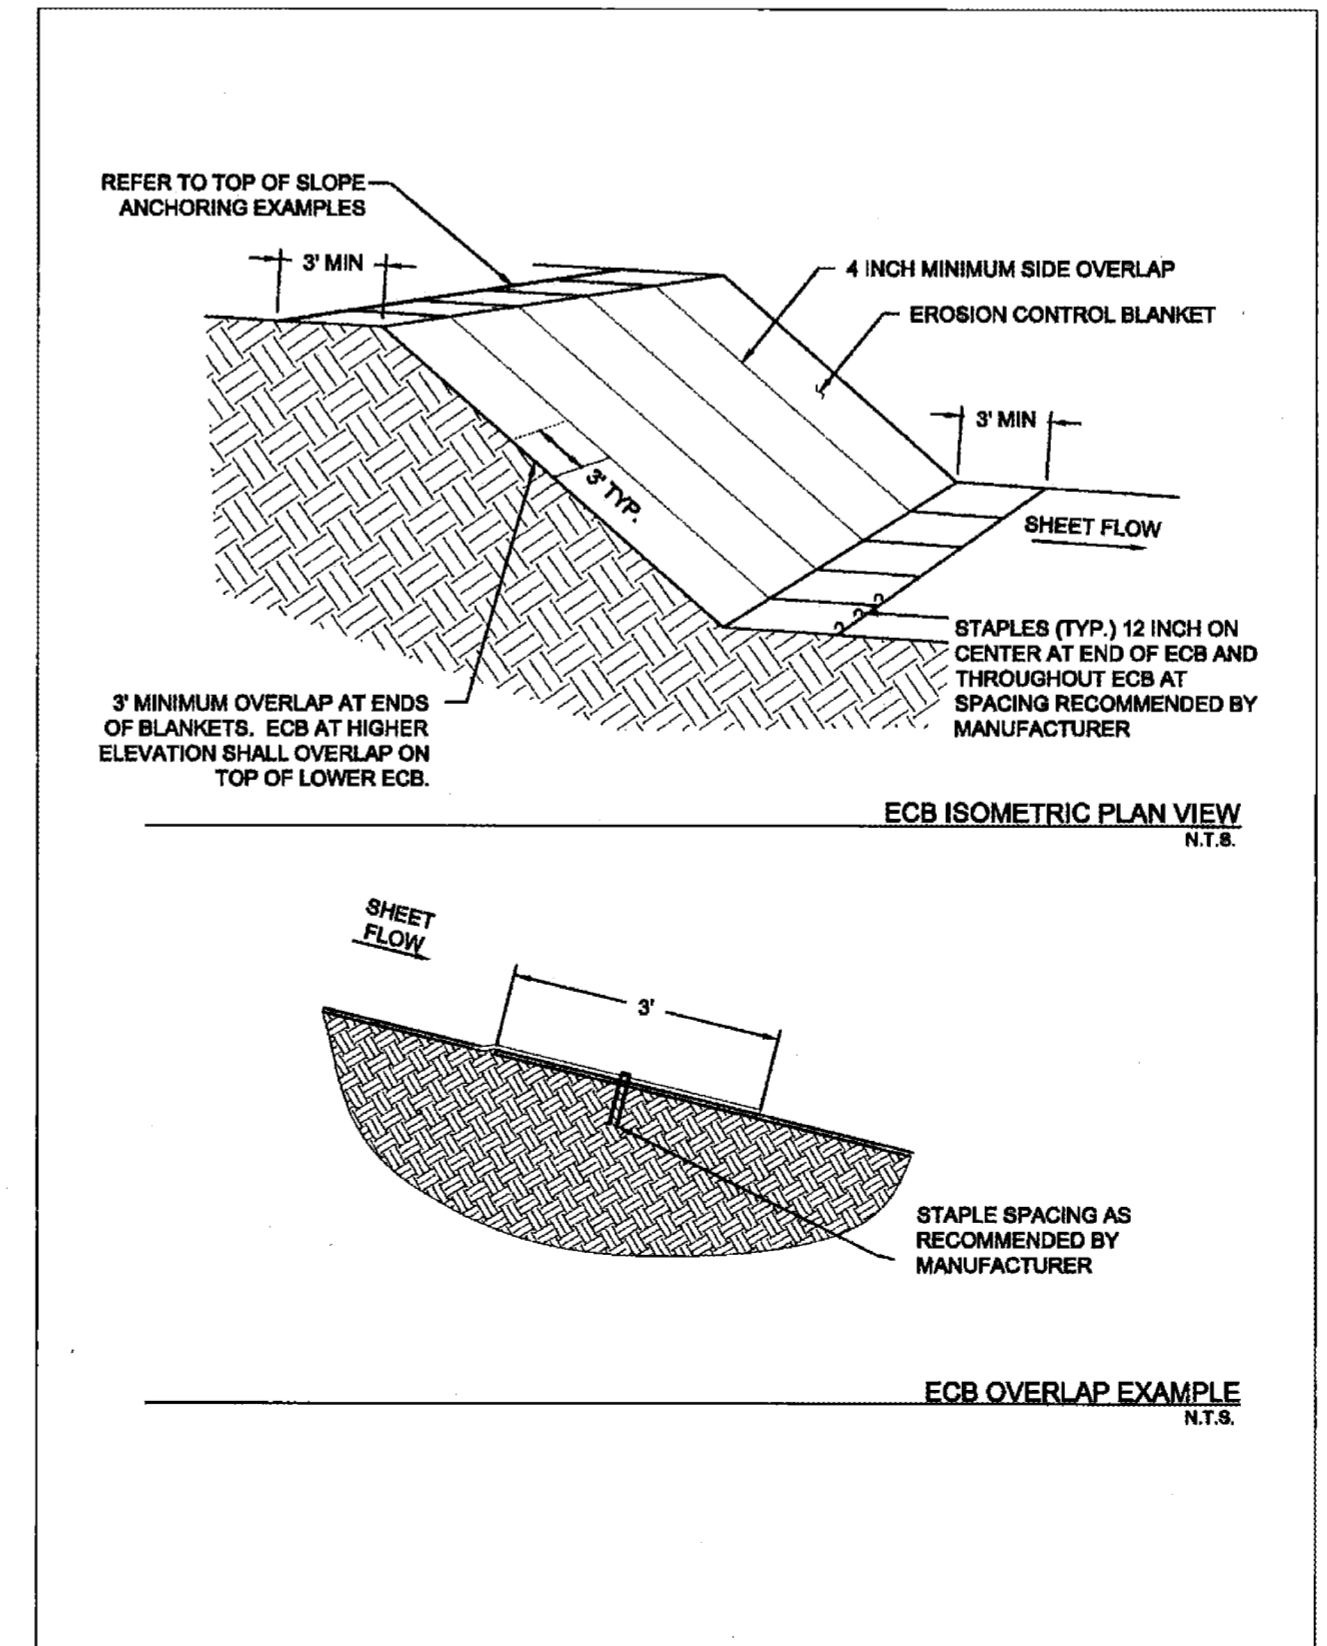

Erosion Control Blankets Revised 04/10	CC-27
--	-------

2.3 Erosion Control Blankets

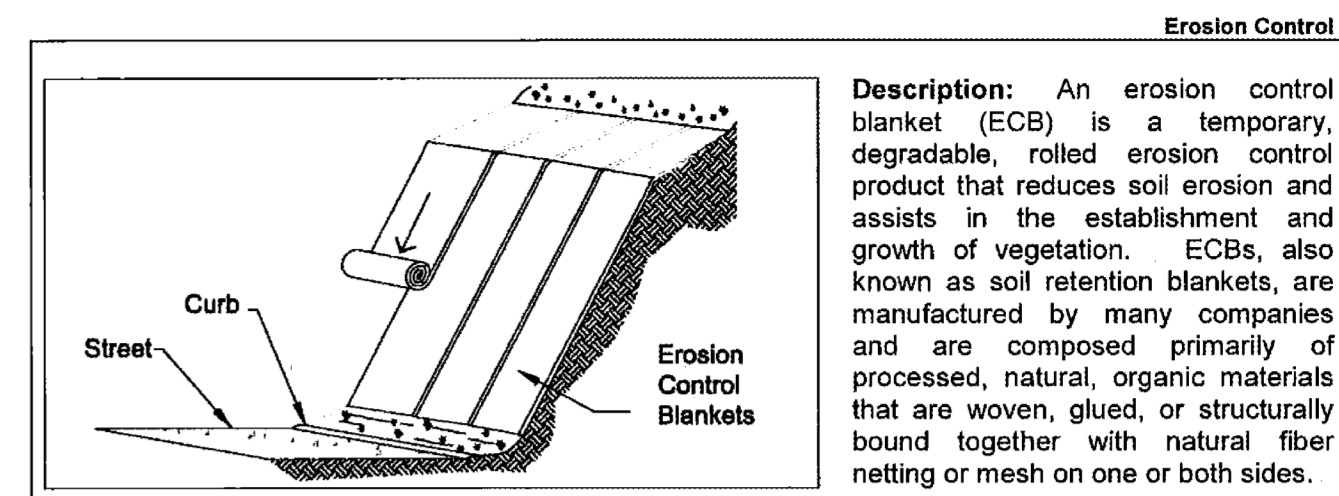

KEY CONSIDERATIONS

- DESIGN CRITERIA:**
- ECB selected based on slope, flow rate and length of service
 - Specify preparation of soil surface to ensure uniform contact with blanket
 - Installation and anchoring according to manufacturer's recommendations

- ADVANTAGES / BENEFITS:**
- Holds seed and soil in place until vegetation is established
 - Effective for slopes, embankments and small channels

- DISADVANTAGES / LIMITATIONS:**
- Not for use on slopes greater than 2:1 or in channels with shear stresses greater than 2.0 pounds per square foot

- MAINTENANCE REQUIREMENTS:**
- Replace or re-anchor loosened blankets
 - Remove sediment deposited on blankets

TARGETED POLLUTANTS

- Sediment
- Nutrients & Toxic Materials
- Oil & Grease
- Floatable Materials
- Other Construction Waste

APPLICATIONS

Perimeter Control
Slope Protection
Sediment Barrier
Channel Protection
Temporary Stabilization
Final Stabilization

- Waste Management**
Housekeeping Practices


Fe=0.90 (Ground cover)
Fe=0.65 (Perimeter w/o vegetation)

IMPLEMENTATION CONSIDERATIONS

- Capital Costs
- Maintenance
- Training
- Suitability for Slopes > 5%

- Other Considerations:**
- Life expectancy, partial degradation, and mowing/maintenance issues for ECBs left in place as part of final stabilization


Erosion Control Blankets Revised 04/10	CC-25
iSWM™ Technical Manual	Construction Controls

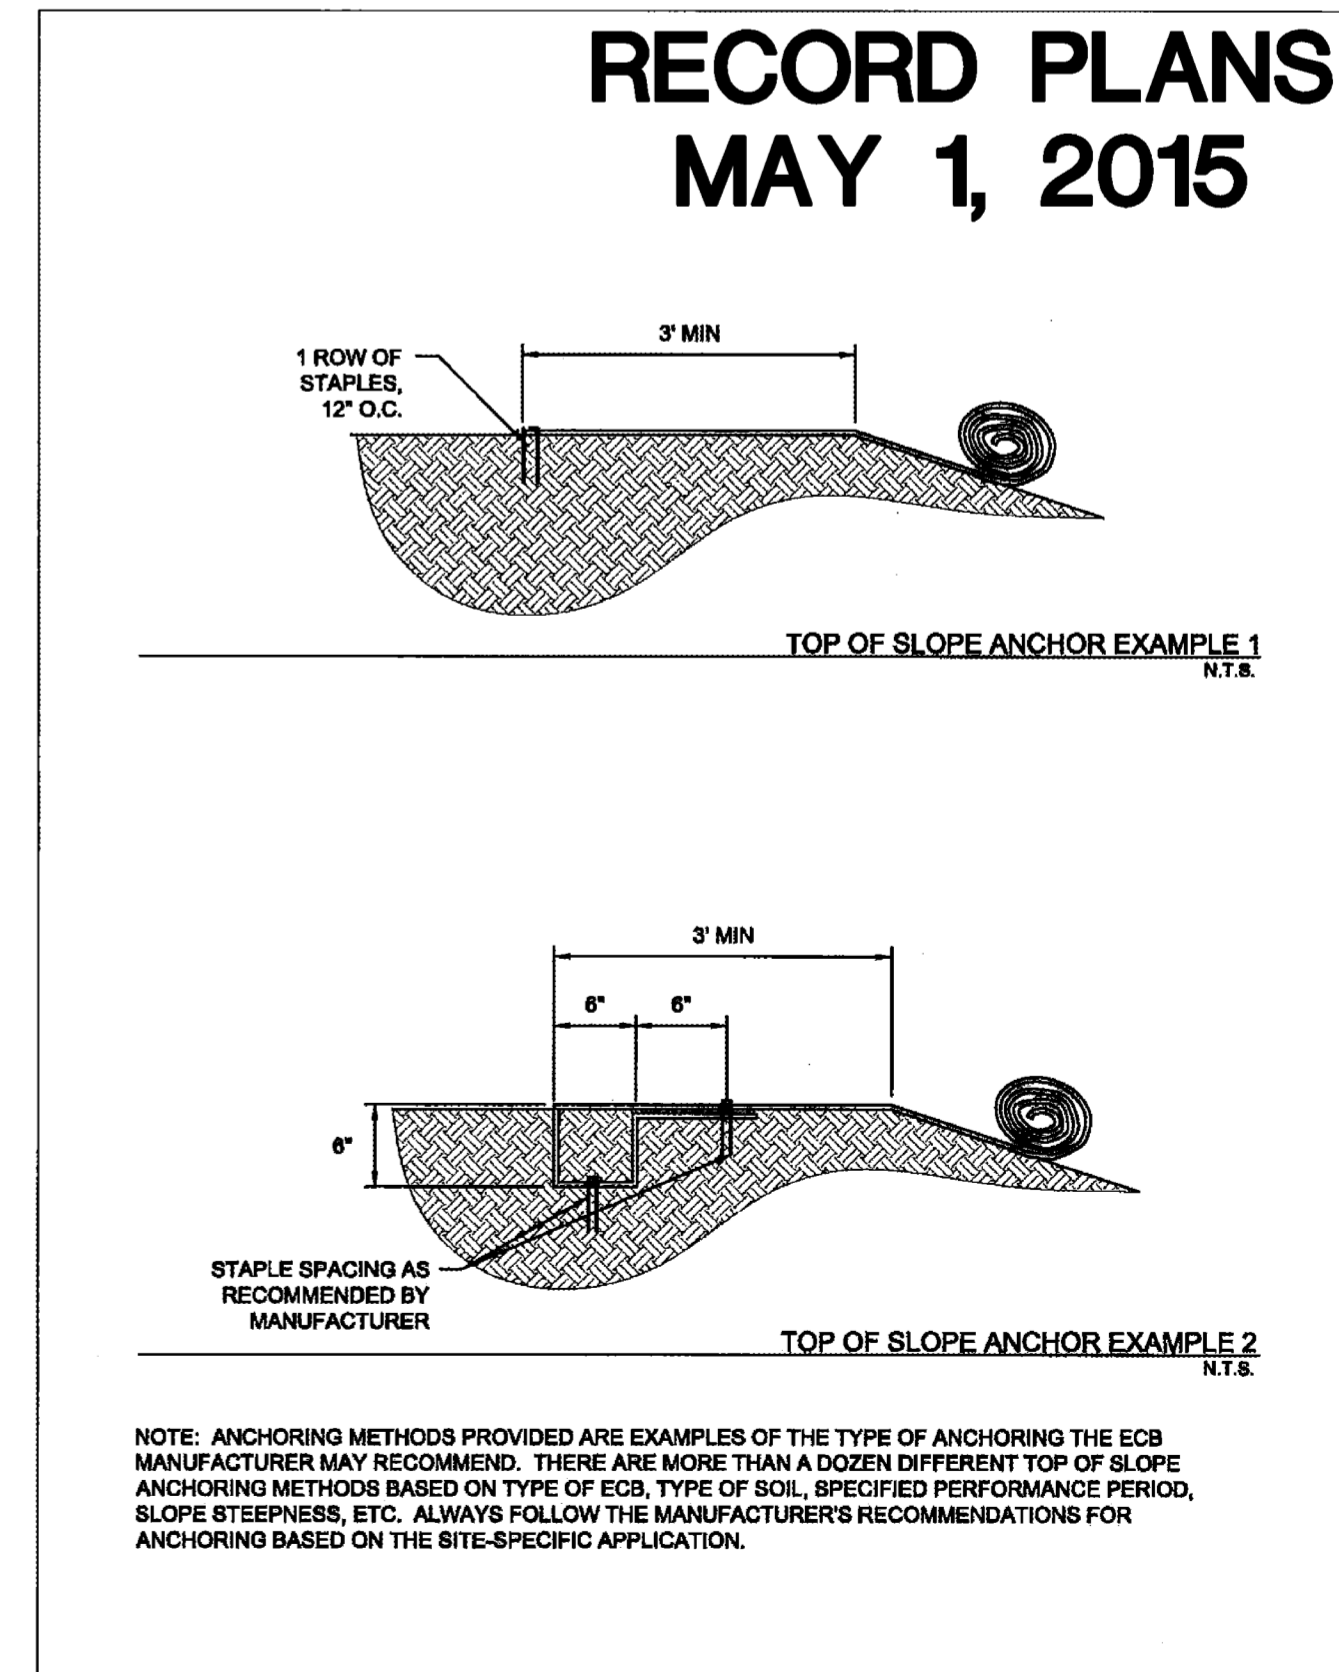


Erosion Control Blankets Revised 04/10	CC-29
--	-------

PRINTED: 5/1/2015 4:20 PM FILE: OFFSITE-WATER-SWPS-DETAILS-2-13096.DWG

PREPARED BY:
WIER & ASSOCIATES, INC.
ENGINEERS SURVEYORS LAND PLANNERS
 701 HIGHLANDER BLVD., SUITE 300 ARLINGTON, TEXAS 76015 METRO (817)467-7700
 www.wierassociates.com
 Texas Firm Registration No. F-2776

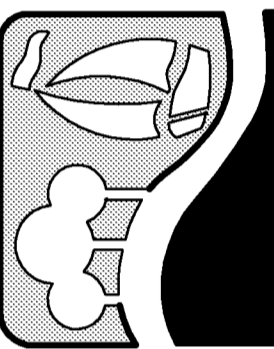

JOHN KING BOULEVARD
 FROM AIRPORT ROAD
 TO JUSTIN ROAD
 OFFSITE WATER LINE
 EROSION CONTROL DETAILS

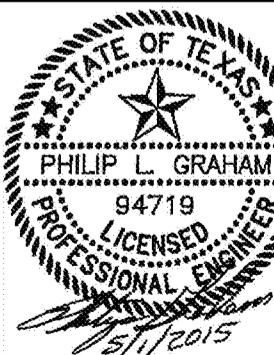

COPYRIGHT ©
 WIER & ASSOCIATES, INC.
 LAST SHEET EDIT
 DATE 4/21/2015
 WA# 13096

SHEET NO.
E202