


STATION	LENGTH	ADDITIONAL FLOW	TOTAL FLOW	CAPACITY	VELOCITY	CULVERT SIZE	NO. OF BARREL	PIPE SLOPE (%)	INVERT ELEVATION (DS)	INVERT ELEVATION (US)	HGL (DS)	HGL (US)	GROUND RIM (DS)	GROUND RIM (UP)	FRICTION SLOPE (S)	VELOCITY HEAD
FROM	TO	(cfs)	(cfs)	(cfs)	(ft/s)	(in)		(%)	(ft)	(ft)	(ft)	(ft)	(ft)	(ft)	(ft/ft)	ft
0+05.00	0+00.00	5.00	9.80	385.35	1721.95	84\"/>										

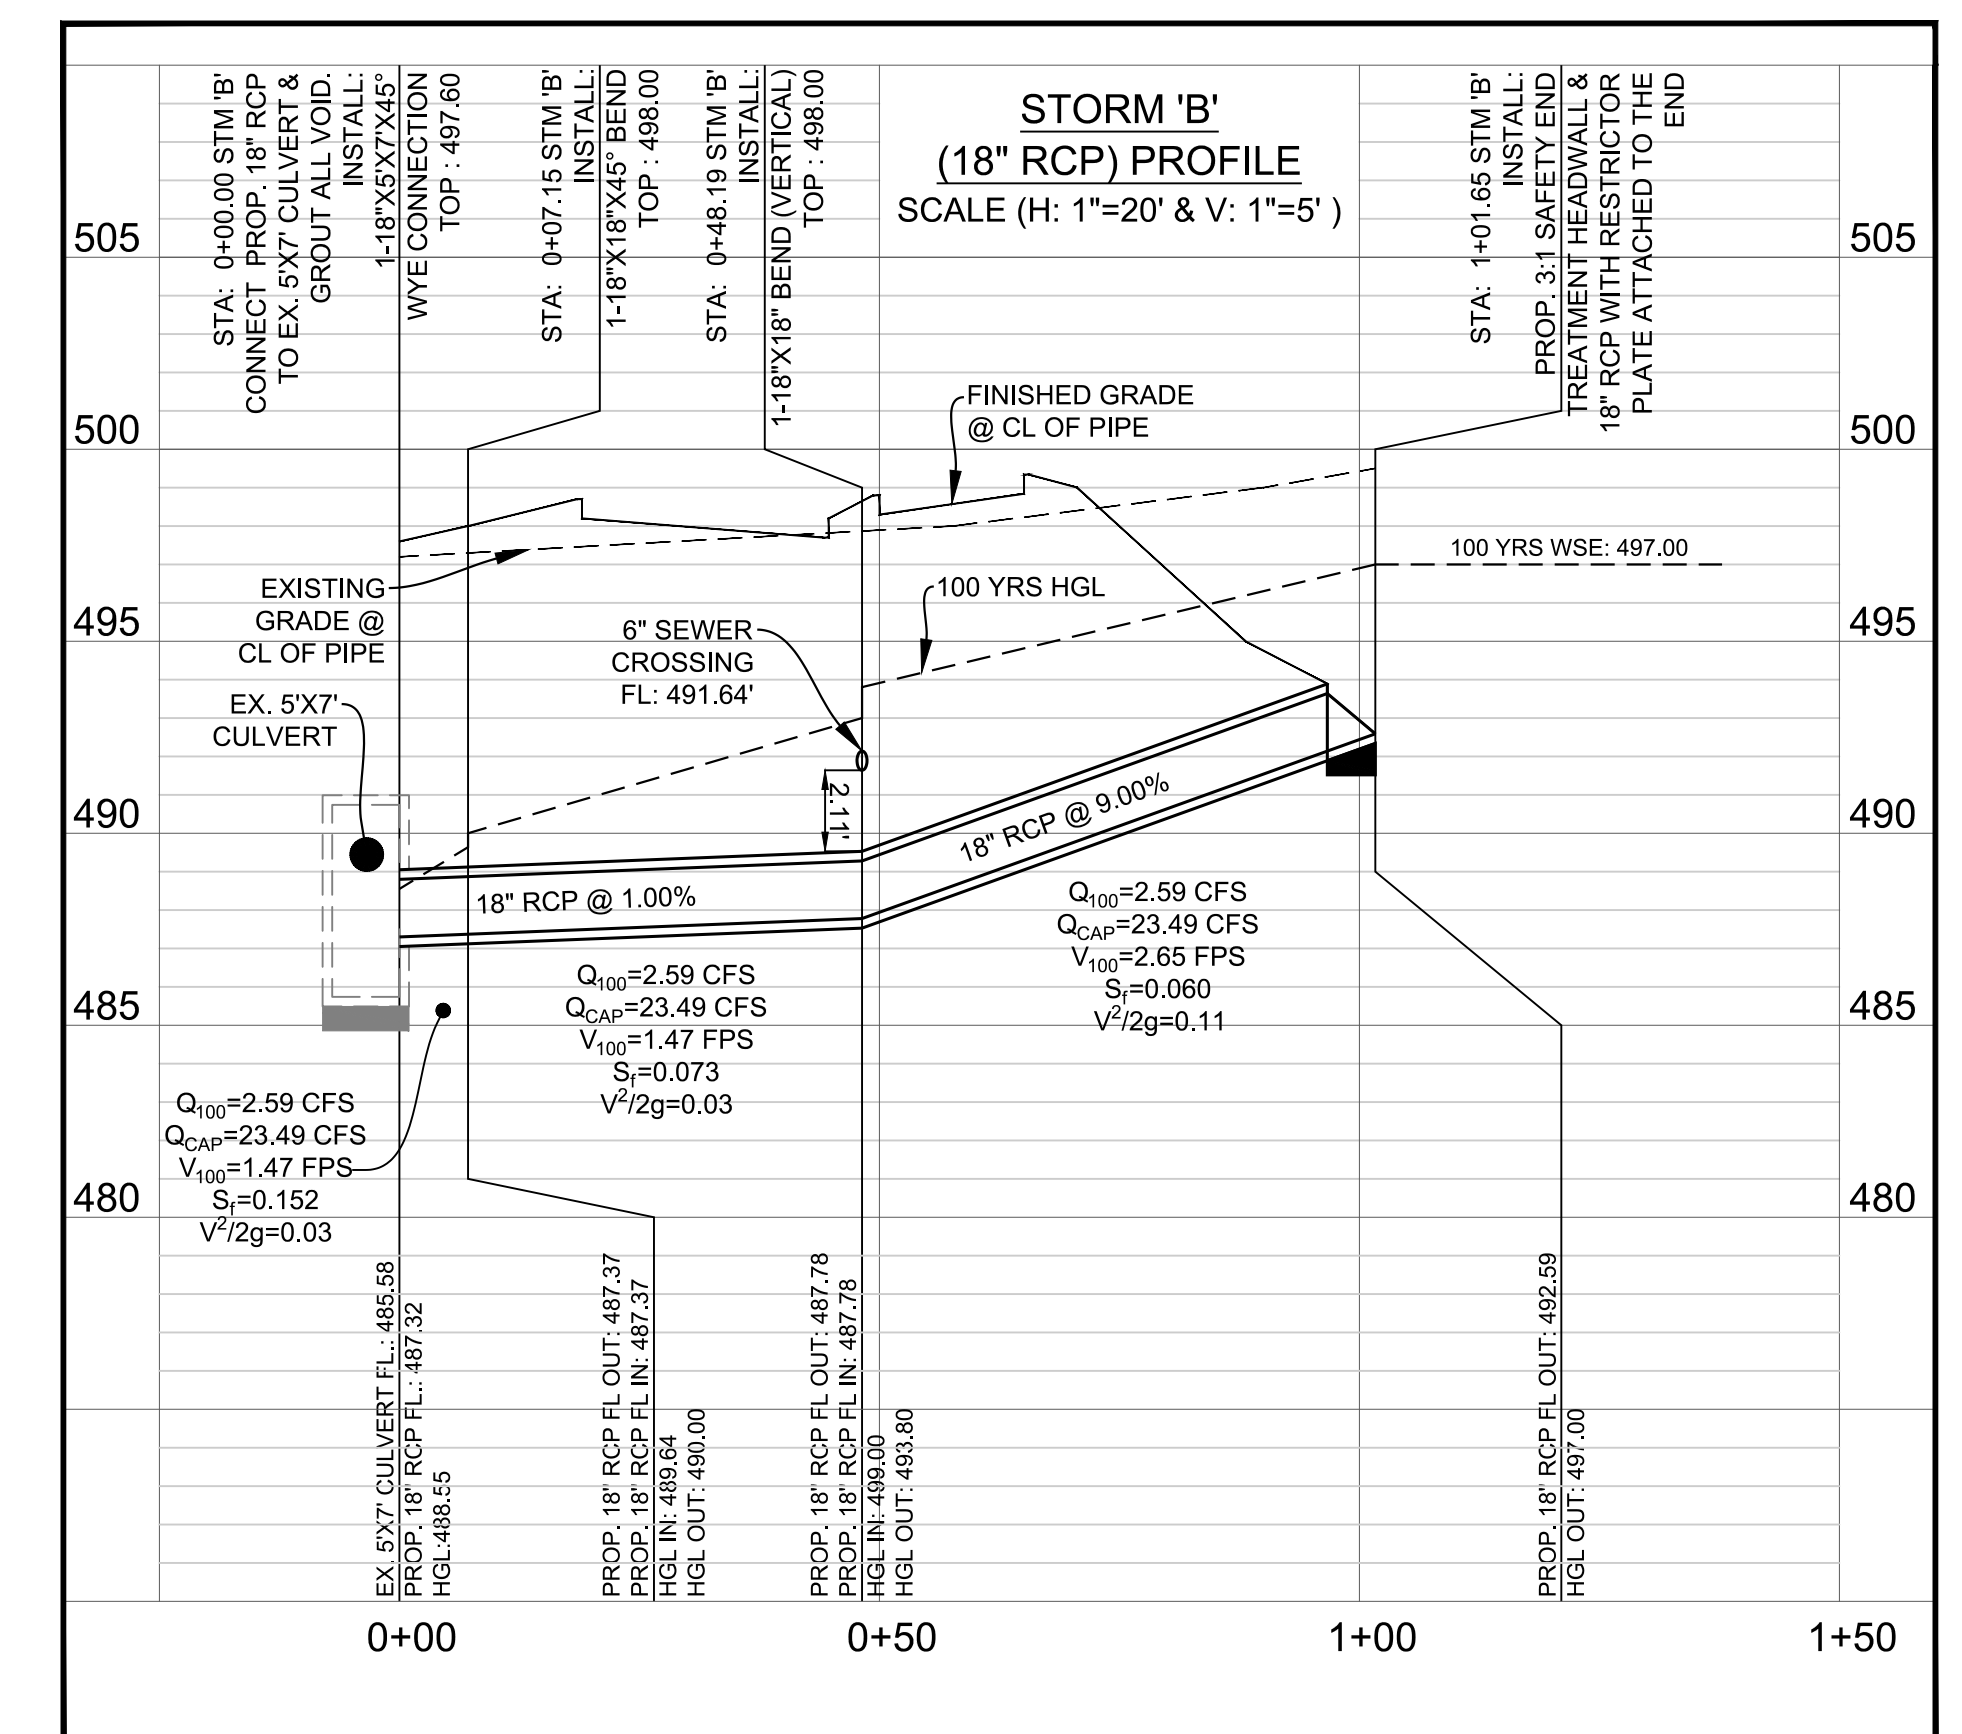


STATION	LENGTH	TOTAL FLOW	CAPACITY	VELOCITY	PIPE SIZE	PIPE SLOPE (%)	INVERT ELEVATION (DS)	INVERT ELEVATION (US)	HGL (DS)	HGL (US)	GROUND RIM (DS)	GROUND RIM (UP)	FRICTION SLOPE (S)	VELOCITY HEAD	
FROM	TO	(ft)	(cfs)	(cfs)	(ft/s)	(in)	(%)	(ft)	(ft)	(ft)	(ft)	(ft)	(ft/ft)	ft	
0+07.15	0+00.00	7.15	2.59	23.49	1.47	18.00	1.00%	487.30	487.37	488.55	489.64	497.60	498.00	0.152	0.03
0+48.19	0+07.15	41.04	2.59	23.49	1.47	18.00	1.00%	487.37	487.78	490.00	493.00	498.80	498.80	0.073	0.03
1+01.65	0+48.19	53.46	2.59	23.49	2.65	18.00	9.00%	487.78	492.59	493.80	497.00	498.80	492.59	0.060	0.11

AS-BUILT DRAWINGS:  
TO THE BEST OF OUR KNOWLEDGE TRIANGLE ENGINEERING LLC., HEREBY STATES THAT THIS PLAN IS AS-BUILT. THE INFORMATION PROVIDED IS BASED ON SURVEYING AT THE SITE AND INFORMATION PROVIDED BY THE CONTRACTOR.

KARTAVYA S. PATEL, P.E. NO. 97534


NO.	DATE	DESCRIPTION	BY
1	12/03/2019	AS-BUILT RECORD DRAWINGS	KP

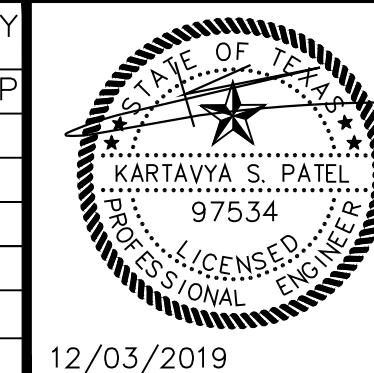

12/03/2019

## RECORD DRAWING

PROPOSED DETENTION & STORM PROFILE  
KIDDIE ACADEMY  
NEC OF N. LAKESHORE DRIVE & E. FORK ROAD  
CITY OF ROCKWALL  
ROCKWALL COUNTY, TEXAS

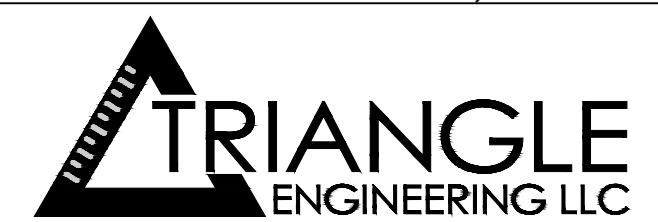

T: 214.609.9271 | F: 469.359.6709 | E: kpatel@triangle-engr.com  
W: triangle-engr.com | O: 1784 W. McDermott Drive, Suite 110, Allen, TX 75013  
Planning | Civil Engineering | Construction Management  
DESIGN/DRAWN DATE SCALE PROJECT NO. SHEET NO.  
KP DS 08/23/16 SEE SCALE BAR 028-16 6.3  
TX PE FIRM #11525