

LEGEND

- DOUBLE WALL PRODUCT PIPING
- - - SINGLE WALL FIBERGLASS VENT PIPING
- DIRECTION OF FLOW


SCHEDULE NOTES

- 1 SALES KIOSK. SEE ARCHITECTURAL AND SITE DEVELOPMENT DRAWINGS FOR ANY SITE SPECIFIC RESTROOM REQUIREMENTS.
- 2 EDGE OF CANOPY ABOVE.
- 3 6" CONCRETE CANOPY DRIVE SLAB.
- 4 U SHAPED PIPE BOLLARD (TYP.).
- 5 CANOPY COLUMN (TYP.).
- 6 DISPENSER ISLAND (TYP.).
- 7 PRODUCT DISPENSER (3+0) (TYP.).
- 8 PRODUCT DISPENSER (3+1) (TYP.).
- 9 CONTRACTOR SHALL CLOSELY COORDINATE DEPTH OF FUEL LINES WITH DEPTH OF STORM SEWER LINE AT THIS LOCATION
- 10 BOLLARD MOUNTED E-STOP LOCATION - SEE DETAIL 11 ON SHEET A2.3
- 11 1-1/2" FLEXIBLE DOUBLE WALL PRODUCT PIPING IN 4" FLEXIBLE ACCESS DUCT. NO SLOPE REQUIRED BETWEEN DISPENSERS. NO LIQUID TRAPS OR HIGH SPOTS ALLOWED IN PIPE RUN. SLOPE DOWN 1/8" PER FOOT MINIMUM FROM CLOSEST DISPENSER TO TANK.
- 12 2" SINGLE WALL RIGID FIBERGLASS VENT PIPING. SLOPE DOWN 1/8" PER FOOT MINIMUM TO TANK.
- 13 NOT USED
- 14 DIESEL VENT MANHOLE.
- 15 SUBMERSIBLE PUMP MANHOLE (TYP.).
- 16 INTERSTITIAL MONITOR MANHOLE (TYP.).
- 17 GASOLINE FILL MANHOLE (TYP.).
- 18 SINGLE COMPARTMENT DOUBLE WALL UNDERGROUND STORAGE TANK (20,000 GALLON UNLEADED).
- 19 TWO COMPARTMENT DOUBLE WALL UNDERGROUND STORAGE TANK (10,000 GALLON DIESEL AND 8,000 GALLON PREMIUM UNLEADED).
- 20 8" CONCRETE TANK SLAB
- 21 2" BLACK STEEL VENT RISER. NOTE: REFER TO SITE PLANS TO VERIFY USE OF REMOTE VENT RISERS OR ALTERNATE COLUMN VENT RISERS.
- 22 DIESEL FILL SINGLE MANHOLE (TYP.).
- 23 TANK (ALL CORNERS OF TANK EXCAVATION) AND PRODUCT LINE OBSERVATION WELLS (WITHIN 10' OF TANK EXCAVATION AND AT MAXIMUM 50' SPACING ALONG PRODUCT LINES).
- 24 NOT USED
- 25 INSTALL TANK OVERFILL ALARM AND ACKNOWLEDGEMENT SWITCH AT 5'-0" ABOVE FINISH GRADE. LOCATE TO PROVIDE UNOBSTRUCTED VIEW FOR DELIVERY VEHICLE OPERATOR.
- 26 STAGE I VAPOR RECOVERY MANHOLE (TYP.).
- 27 EMERGENCY STOP LOCATION.

THIS SHEET IS FOR GENERAL REFERENCE ONLY. REFER TO SITE PLAN FOR UNDERGROUND TANK LOCATION AND ORIENTATION.

CONTRACTOR SHALL FURNISH AND INSTALL A 6" WIDE MARKING TAPE (EMPIRE MAGNATEC #31-143) IN EACH TRENCH WHEN BACKFILLING SUPPLY, VAPOR RETURN, AND VENT LINES

2 PIPING LAYOUT
SCALE: 1" = 10'-0"

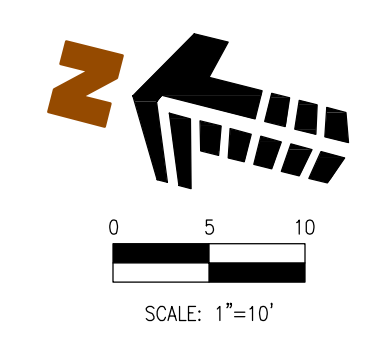

REVISIONS		DATE
No.	DESCRIPTION	DATE
1	E-STOP CLARIFICATION	04/07/2016
2	PERMIT REVIEW RESPONSES	04/18/2016
3	AS-BUILT	10/27/2016

Project #: SW-574
Designed By: DLJ
Drawn By: EVR
Checked By: MDC
Date: NOVEMBER, 2015
Scale: FULL
Disk File: KroSW574_T1.0-PIPE
Model:
760 WALK-IN - 6 (GD)
Address:
Golias St. and Quail Run Rd.
Rockwall, TX

FUELING LAYOUTS
Drawing No.: T1.0

THIS DRAWING IS AND SHALL REMAIN THE PROPERTY OF THE KROGER COMPANY REPRODUCTION OR ALTERATION OF THIS DRAWING WITHOUT THE EXPRESS WRITTEN PERMISSION OF THE KROGER COMPANY IS PROHIBITED. (NOT PUBLISHED: ALL RIGHTS RESERVED)
NOTE TO CONTRACTOR:
THIS SET OF DRAWINGS AND DOCUMENTS IS INTENDED AS A SET OF GUIDELINES FOR THE PROJECT AND ARE INTENDED TO BE USED IN CONJUNCTION WITH A SET OF CONSTRUCTION SPECIFICATIONS TO BE SUPPLIED BY OWNER. THEY MUST BE READ TO INCORPORATE ALL APPLICABLE FEDERAL, STATE, AND LOCAL CODES INCLUDING FEDERAL A.D.A. REQUIREMENTS. THIS SET ASSUMES THAT THERE ARE NO UNUSUAL SOIL CONDITIONS OR WIND LOADS; THE FAILURE OF THIS CONDITION MAY REQUIRE SIGNIFICANT CHANGES TO THESE DOCUMENTS. IT IS THE RESPONSIBILITY OF THE GENERAL CONTRACTOR TO CONFORM TO ALL APPLICABLE CODES AND TO INFORM THE OWNERS/ARCHITECTS OF ANY QUESTIONS OR CLARIFICATIONS WHICH ARE DESIRED. CONTRACTORS SHALL ALSO VISIT THE SITE BEFORE BIDDING. CONTRACTORS ARE REQUIRED TO KNOW ALL OBSERVABLE CONDITIONS AND APPLICABLE CODES.