

CIVIL CONSTRUCTION PLANS FOR KROGER STORE SW574

@
CITY OF ROCKWALL, ROCKWALL COUNTY, TEXAS
S.S. McCURRY SURVEY, ABSTRACT NO. 146
SW 574

PROJECT DIRECTORY


CITY OF ROCKWALL
AMY WILLIAMS P.E.
385 S. GOLIAD ST
ROCKWALL, TX 75078
972-771-7700

CLIENT:
KROGER TEXAS L.P.
751 FREEPORT PARKWAY
COPPELL, TX 75019
469-645-7951

ELECTRIC COMPANY
ONCOR ELECTRIC DELIVERY COMPANY
RANDY VOIGHT
310 HIGHWAY 205
TERRELL, TX 75160

TELEPHONE COMPANY
AT&T
SCOTT ULRICH
2702 WESLEY STREET
GREENVILLE, TX 75401
903-457-2303

GAS COMPANY
ATMOS ENERGY CORPORATION
DINAH WOOD
310 HIGHWAY 66
GARLAND, TX 75040
972-485-6277

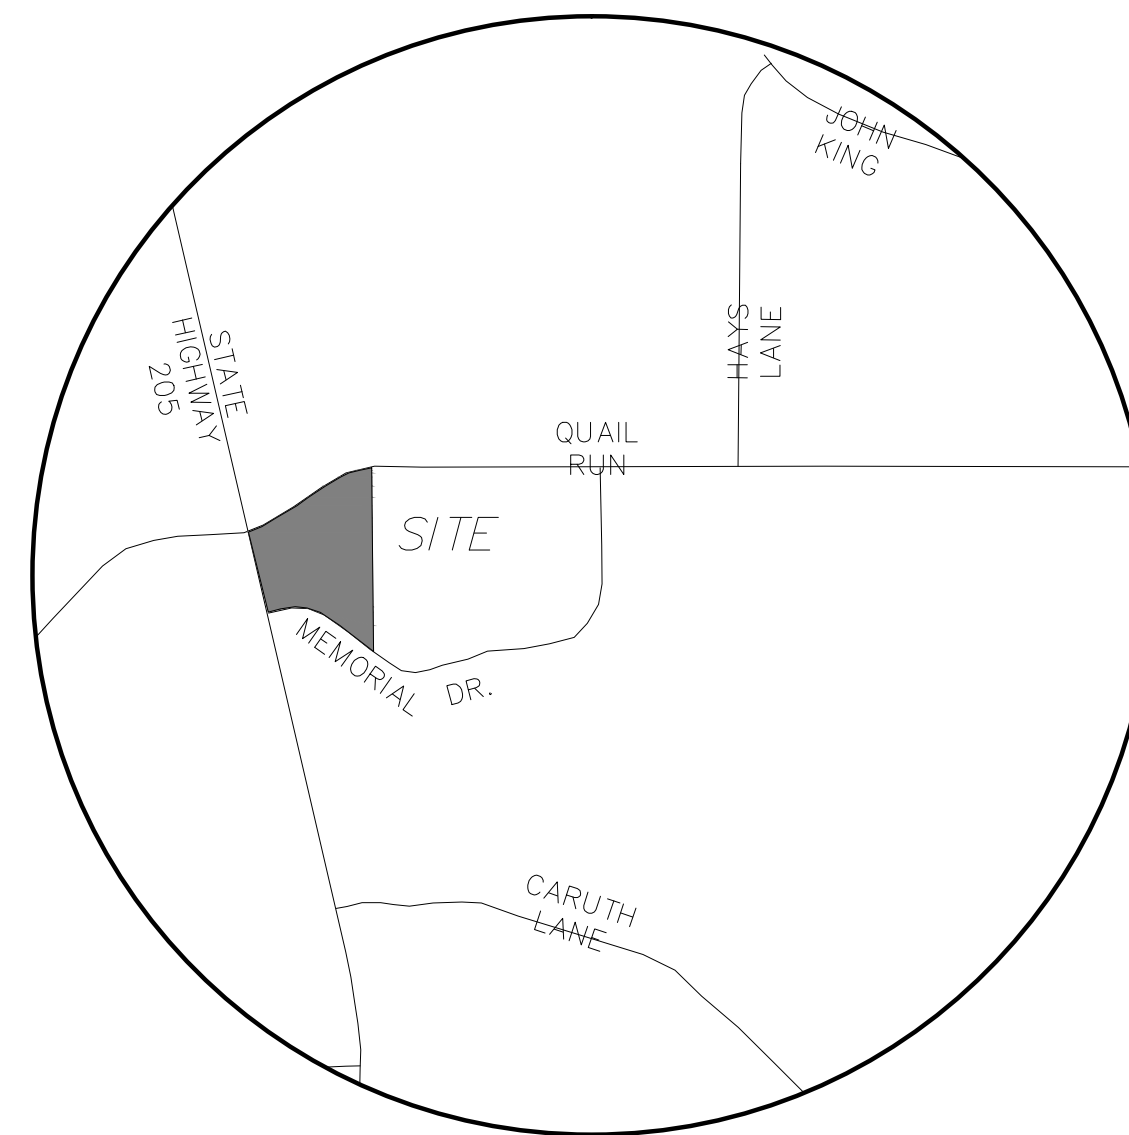


VICINITY MAP

AS-BUILT

THIS RECORD DRAWING IS COMPILATION OF A COPY OF THE SEALED ENGINEERING DRAWING FOR THIS PROJECT; MODIFIED BY ADDENDA, CHANGE ORDERS, AND INFORMATION FURNISHED BY THE CONTRACTOR. THE INFORMATION SHOWN ON THE RECORD DRAWINGS IS PROVIDED BASED ON SURVEYING AT THE SITE AND INFORMATION PROVIDED BY THE CONTRACTOR OR OTHERS NOT ASSOCIATED WITH THE DESIGN ENGINEER. THE ORIGINAL SEALED DRAWING ARE ON FILE AT THE OFFICES OF WINKELMANN AND ASSOCIATES, INC.

Maria L. Bonilla
10-19-2016
DATE

WINKELMANN AND ASSOCIATES, INC.

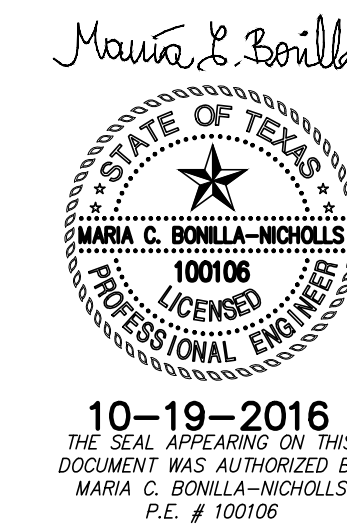

**Winkelmann
& Associates, Inc.**

CONSULTING CIVIL ENGINEERS ■ SURVEYORS
6750 HILLCREST PLAZA DRIVE, SUITE 325 (972) 490-7090
DALLAS, TEXAS 75230 (972) 490-7099 FAX
Texas Engineers Registration No. 89
Texas Surveyors Registration No. 100866-00
COPYRIGHT © 2016, Winkelmann & Associates, Inc.