


**INDEX**

Sheet Number	Sheet Title
C-00.00	COVER SHEET
C-00.01	PROJECT INDEX
C-00.02	PLAT
C-01.00	SITE PLAN
C-02.00	GENERAL NOTES
C-03.00	EX CONDITIONS & DEMOLITION PLAN
C-04.00	STAGING PLAN
<del>C-05.00</del>	<del>KROGER LIMITS OF WORK</del>
<del>C-06.00</del>	<del>FUEL LIMITS OF WORK</del>
C-07.01	PAVING AND DIMENSION CONTROL PLAN
C-07.02	ISLAND DETAILS KEYMAP
C-07.03	ISLAND DETAIL
C-07.04	ISLAND DETAIL
C-07.05	PAVEMENT MARKING & SIGNAGE
C-08.01	GRADING PLAN KEYMAP
C-08.02	GRADING PLAN
C-08.03	GRADING PLAN
C-08.04	ACCESSIBILITY PLAN
C-08.05	ACCESSIBILITY PLAN
C-08.06	SIDEWALK PLAN
C-08.07	WALL 1 PROFILE
C-08.08	WALL 3 PROFILE
C-08.09	WALL 4 PROFILE
C-08.10	WALL CROSS SECTIONS KEYMAP
C-08.11	WALL CROSS SECTIONS
C-08.12	WALL CROSS SECTIONS
C-08.13	RETAINING WALL KEYMAP
C-08.14	WALL DETAILS
C-08.15	WALL DETAILS ACCESSIBLE HANDRAIL
C-08.16	MASONRY SCREENING WALL DETAIL
C-08.17	MONUMENT SIGN WALL
C-08.18	ACCESSIBILITY PLAN RAMP REMEDIATION
<del>C-09.00</del>	<del>GEO TECH SECTION</del>
C-10.01	EXISTING DRAINAGE AREA MAP
C-10.02	EXISTING DRAINAGE AREA TABLE
C-10.03	PROPOSED DRAINAGE AREA MAP
C-10.04	PROPOSED DRAINAGE AREA TABLE
C-11.01	STORM PLAN KEYMAP
C-11.02	STORM PLAN
C-11.03	STORM PLAN
C-11.04	STORM PROFILE
C-11.05	STORM PROFILE
C-11.06	STORM PROFILE
C-11.07	STORM PROFILE
C-11.08	STORM PROFILE
C-11.09	STORM PROFILE
C-11.10	STORM PROFILE
C-11.11	STORM PROFILE
C-11.12	STORM PROFILE
C-11.13	STORM PROFILE
C-11.14	STORM PROFILE
C-11.15	STORM HYDRAULIC COMPUTATIONS

C-11.16	STORM HYDRAULIC COMPUTATIONS
C-11.17	INLET COMPUTATIONS
C-11.18	DETENTION POND 1
C-11.19	DETENTION POND 1 CALCULATIONS
C-11.20	DETENTION POND 2 CALCULATIONS
C-12.01	WATER PLAN KEYMAP
C-12.02	WATER PLAN
C-12.03	WATER PLAN
C-12.04	WATER DETAIL
C-13.01	SANITARY SEWER PLAN KEYMAP
C-13.02	SANITARY SEWER PLAN
C-13.03	SANITARY SEWER PLAN
C-13.04	SANITARY SEWER PROFILE
C-13.05	SANITARY SEWER PROFILE
C-13.06	SANITARY SEWER PROFILE
C-13.07	SANITARY SEWER PROFILE
C-13.08	DRIVEWAY CROSS SECTIONS KEYMAP
C-13.09	NORTH DRIVE CROSS SECTION
C-13.10	SOUTH DRIVE CROSS SECTION
C-13.11	FUEL CENTER DRIVE CROSS SECTION
C-14.01	EROSION CONTROL PLAN PHASE 1
C-14.02	EROSION CONTROL PLAN PHASE 2
C-14.03	EROSION CONTROL PLAN PHASE 3
C-14.04	EROSION CONTROL DETAILS
C-14.05	EROSION CONTROL DETAILS
C-15.01	CIVIL DETAILS
C-15.02	CIVIL DETAILS
C-15.03	CIVIL DETAILS
C-15.04	CIVIL DETAILS
C-15.05	CIVIL DETAILS
C-15.06	CIVIL DETAILS
C-15.07	CITY DETAILS
C-15.08	CITY DETAILS
C-15.09	CITY DETAILS
C-15.10	CITY DETAILS
C-15.11	CITY DETAILS
C-15.12	CITY DETAILS
C-15.13	KROGER DETAILS
C-15.14	KROGER DETAILS
C-15.15	KROGER DETAILS
C-15.16	CIVIL DETAIL
C-15.17	CIVIL DETAIL
<del>E-0-0-E-2.0</del>	<del>ELECTRICAL SITE PLAN</del>
L-0~L-3	LANDSCAPE PLANS
L-4~L-8	IRRIGATION PLANS
P-1~P-3	CMP-DETENTION EAST
P-4~P-6	CMP-DETENTION WEST
P-F-1	CMP-DETENTION FABRICATION DETAIL
RW-01~RW-18	RETAINING WALL STRUCTURAL PLANS

AS-BUILT


THIS RECORD DRAWING IS COMPILATION OF A COPY OF THE SEALED ENGINEERING DRAWING FOR THIS PROJECT; MODIFIED BY ADDENDA, CHANGE ORDERS, AND INFORMATION FURNISHED BY THE CONTRACTOR. THE INFORMATION SHOWN ON THE RECORD DRAWINGS IS PROVIDED BASED ON SURVEYING AT THE SITE AND INFORMATION PROVIDED BY THE CONTRACTOR OR OTHERS NOT ASSOCIATED WITH THE DESIGN ENGINEER. THE ORIGINAL SEALED DRAWING ARE ON FILE AT THE OFFICES OF WINKELMANN AND ASSOCIATES, INC.

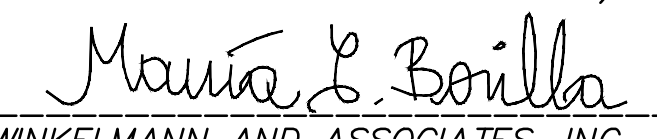  
 WINKELMANN AND ASSOCIATES, INC.


10-19-2016  
 DATE

PROJECT INDEX  
 SEC N. GOLIAD ST. AND E. QUAIL  
 RUN RD.  
 ROCKWALL, TEXAS

C-00.01  
 DAL574



**Winkelmann & Associates, Inc.**  
 CONSULTING CIVIL ENGINEERS & SURVEYORS  
 8720 HILGREET PLAZA DRIVE, SUITE 325  
 ROCKWALL, TEXAS 75087  
 (972) 940-7090  
 (972) 940-7098 FAX  
 State Engineer Registration No. 89  
 State Surveyors Registration No. 100866-00  
 State Professional Engineer Registration No. 100106  
 Winkelman & Associates, Inc.

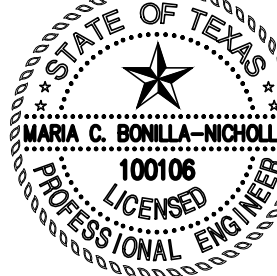

10-19-2016  
 THE SEAL APPEARING ON THIS DOCUMENT WAS AUTHORIZED BY  
 MARIA C. BOILLA-NICHOLS  
 P.E. # 100106

No.	REVISION	DATE
1.	ISSUE FOR CONSTRUCTION BULLETIN #1	12/09/2015
2.		
3.		
4.		
5.		
6.		