

*****NOTICES TO CONTRACTOR*****

EXISTING UNDERGROUND/BURIED PUBLIC, PRIVATE, AND FRANCHISE UTILITIES/FACILITIES AFFECT THIS SITE, AND ARE DEPICTED ON THE PLANS FOR THE BEST AVAILABLE INFORMATION AT THE TIME THE PLANS WERE PRODUCED. WINKELMANN & ASSOC., INC. SHALL NOT BE RESPONSIBLE FOR KNOWING THE EXACT LOCATION OF ALL FACILITIES OR DEPICTING EXACT LOCATIONS OF SAID FACILITIES ON THE PLANS BEYOND WHAT IS STATED ABOVE.




CONTRACTOR(S) SHALL CALL "811" A MINIMUM OF 48 HOURS PRIOR TO BEGINNING WORK ON THE SITE, AND SHALL NOT BEGIN ANY EXCAVATION OR DEMOLITION ACTIVITIES UNTIL AFTER SAID FACILITIES HAVE BEEN MARKED AND/OR FLAGGED PER "811" OR THE FACILITY OWNERS.

CONTRACTOR(S) SHALL BE WHOLLY RESPONSIBLE FOR ANY DAMAGE THAT MAY OCCUR TO SAID FACILITIES DUE TO WORK BEING DONE WITHOUT FOLLOWING THE PROCEDURES ABOVE.

AS-BUILT

THIS RECORD DRAWING IS COMPILATION OF A COPY OF THE SEALED ENGINEERING DRAWING FOR THIS PROJECT; MODIFIED BY ADDENDA, CHANGE ORDERS, AND INFORMATION FURNISHED BY THE CONTRACTOR. THE INFORMATION SHOWN ON THE RECORD DRAWINGS IS PROVIDED BASED ON SURVEYING AT THE SITE AND INFORMATION PROVIDED BY THE CONTRACTOR OR OTHERS NOT ASSOCIATED WITH THE DESIGN ENGINEER. THE ORIGINAL SEALED DRAWING ARE ON FILE AT THE OFFICES OF WINKELMANN AND ASSOCIATES, INC.

Maria L. Boilla 10-19-2016
 WINKELMANN AND ASSOCIATES, INC. DATE

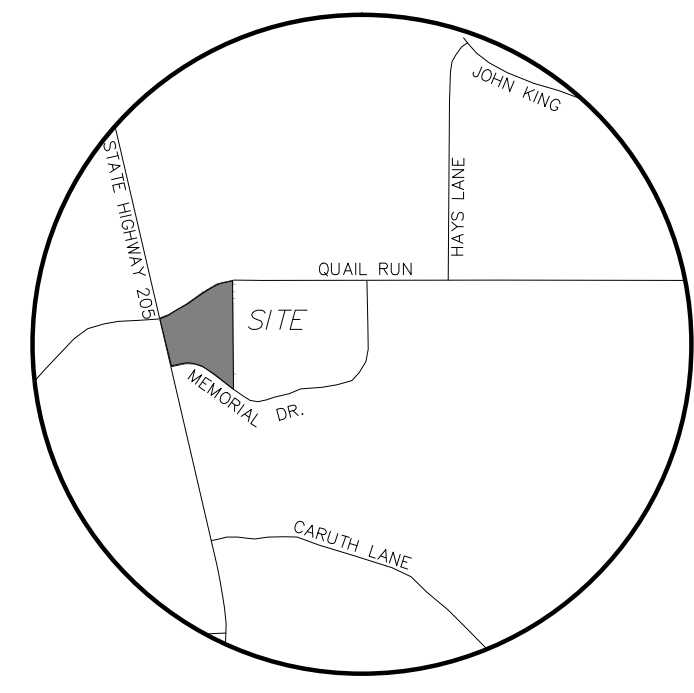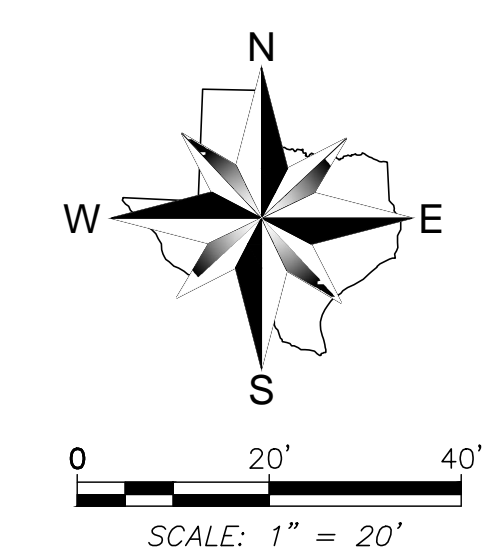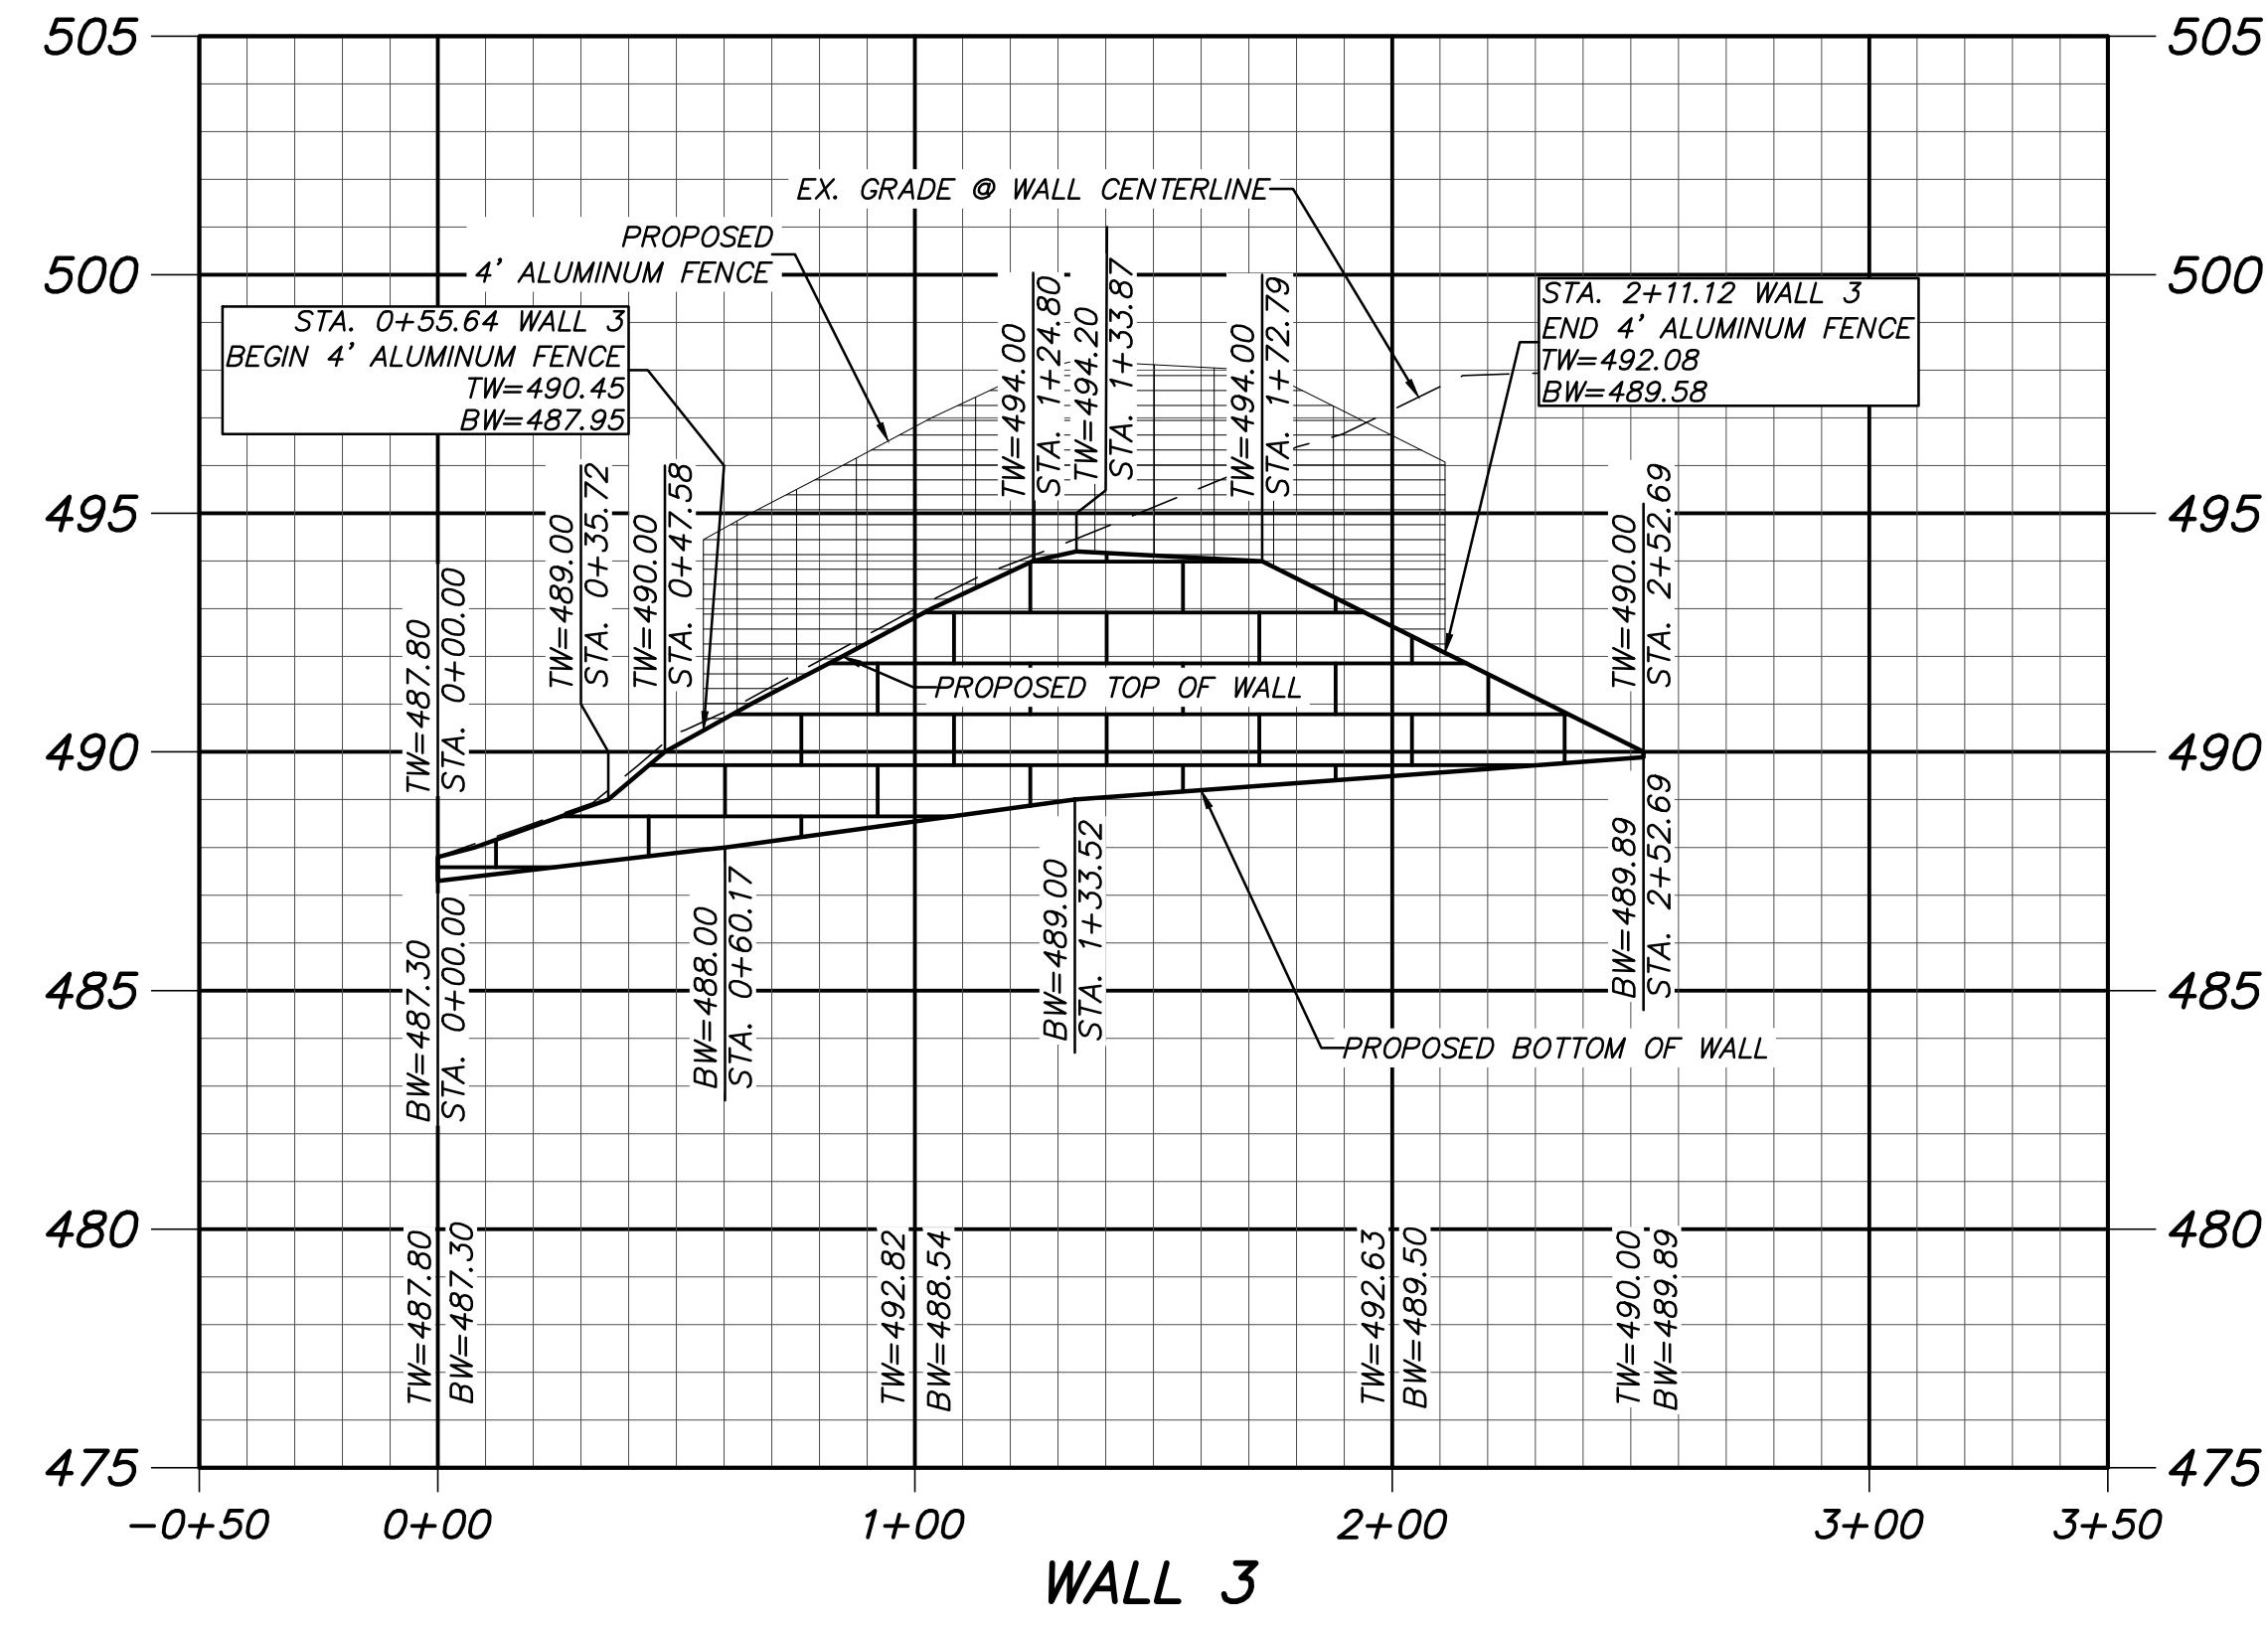

- GRADING LEGEND**
- 493 --- EXISTING CONTOURS
 - 488 --- PROP. CONTOURS
 - ▬▬▬ RETAINING WALL
 - +— GRADE BREAK HP
 - +— GRADE BREAK LP
- IF GENERAL CONTRACTOR SELECTS TO USE OTHER WALL CONTRACTOR, MUST SUBMIT SIGNED AND SEALED PLANS.

- LEGEND**
- | | |
|-----------------------|--------------------------------|
| PP Power Pole | IRF Iron Rod Found |
| GW Guy Wire | GRS Iron Rod Set |
| MH Manhole | GIRS Iron Rod Set w/ cap "WAI" |
| WV Water Valve | GIRP Iron Rod Found w/ cap |
| TP Telephone Pedestal | XCS X-Cut in Concrete Set |
| WM Water Meter | XCP X-Cut in Concrete Found |
| FH Fire Hydrant | PKS PK Nail Set |
| LP Light Pole | PKF PK Nail Found |
| IV Irrigation Valve | SS Sanitary Sewer |
| CO Clean Out | SW Storm Sewer |
| AC Air Conditioner | TF Transformer pad |
| TV Cable Box | GM Gas Meter |
| SB Signal Box | GMR Gas Marker |
| SP Signal Pole | TSN Traffic Sign |
| SN Sign | UCC Underground Cable Marker |
| CM Control Monument | EB Electric Box |
| | EM Electric Meter |

ALL RESPONSIBILITY FOR ADEQUACY OF DESIGN REMAINS WITH THE DESIGN ENGINEER. THE CITY OF ROCKWALL, IN REVIEWING AND RELEASING PLANS FOR CONSTRUCTION, ASSUMES NO RESPONSIBILITY FOR ADEQUACY OR ACCURACY OF DESIGN.

No.	DATE	REVISION	APPROV
6.			
5.			
4.	03/11/2016	RESPONSE TO MIA-SURVEY	M.B.
3.	07/27/2016	REVISION #1	M.B.
2.	12/18/2015	ISSUE FOR CONSTRUCTION	M.B.
1.	12/09/2015	BULLETIN #1	M.B.

Winkelmann & Associates, Inc.
 CONSULTING CIVIL ENGINEERS • SURVEYORS
 7720 HILGRET PLAZA DRIVE, SUITE 325
 ROCKWALL, TEXAS 75087
 (972) 460-7099
 (972) 460-7098 FAX
 State Engineer Registration No. 89
 State Surveyor Registration No. 100866-00
 State Professional Engineer Registration No. 100866-00
 State Professional Engineer Registration No. 100866-00

STATE OF TEXAS
 MARIA C. BOILLA-NICHOLS
 10016
 LICENSED
 PROFESSIONAL ENGINEER
 10-19-2016
 THE SEAL APPEARING ON THIS DOCUMENT WAS AUTHORIZED BY MARIA C. BOILLA-NICHOLS, P.E. # 100106

WALL 3 PROFILE
 SEC. N. GOLIAD ST. AND E. QUAIL RUN RD.
 ROCKWALL, TEXAS

C-08.08
 DAL574