


**DETAIL A-1**  
TYPICAL WALL SECTION  
FOR COMBINATION  
RETAINING & SCREENWALL

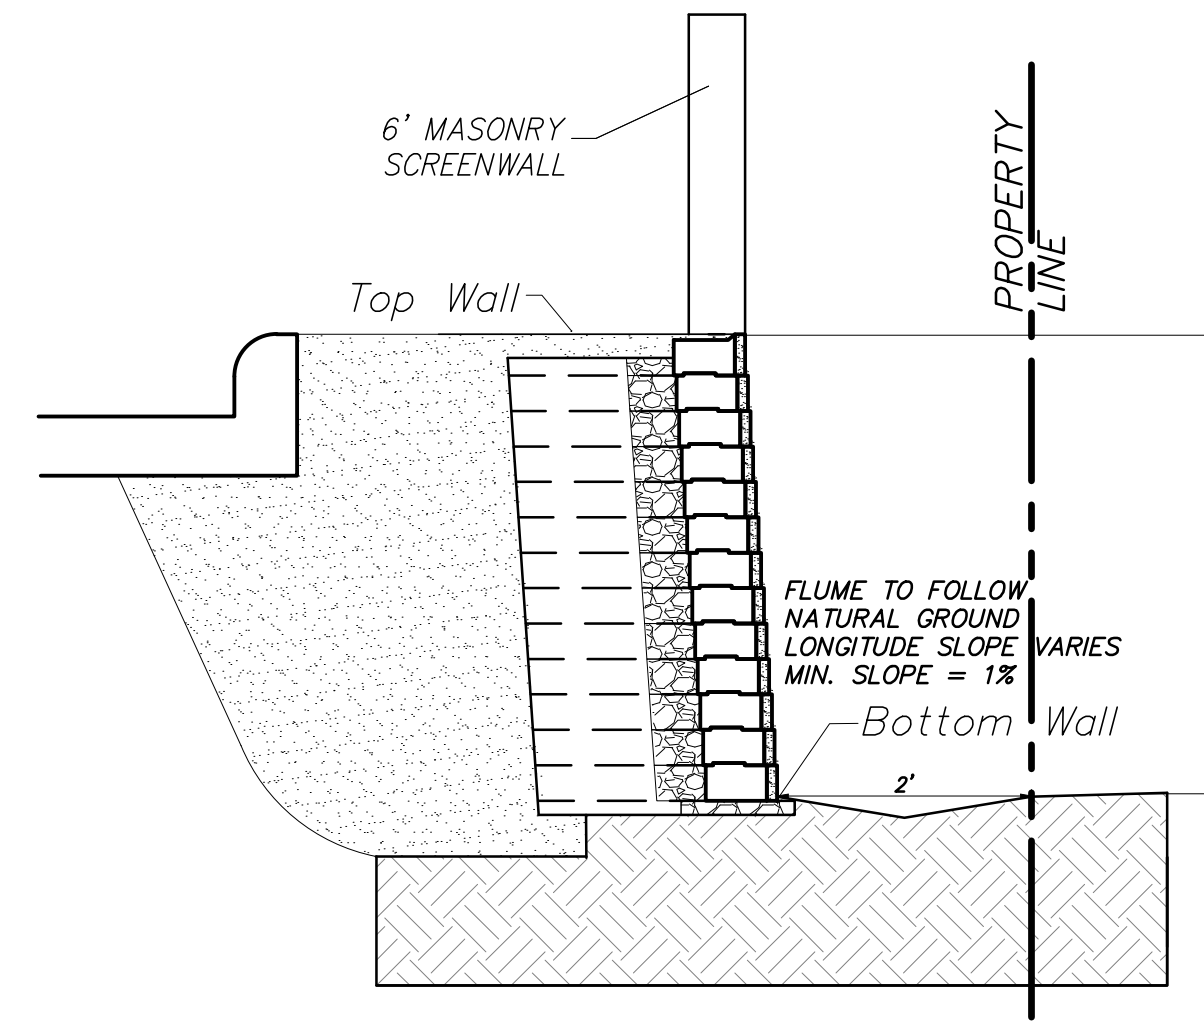


**DETAIL A-2**  
TYPICAL WALL SECTION  
FOR COMBINATION  
RETAINING & SCREENWALL

NOTE:  
NOT FOR CONSTRUCTION  
FOR CLARIFICATION AND LAYOUT  
PURPOSES ONLY


AS-BUILT

THIS RECORD DRAWING IS COMPILATION OF A COPY OF THE SEALED ENGINEERING DRAWING FOR THIS PROJECT; MODIFIED BY ADDENDA, CHANGE ORDERS, AND INFORMATION FURNISHED BY THE CONTRACTOR. THE INFORMATION SHOWN ON THE RECORD DRAWINGS IS PROVIDED BASED ON SURVEYING AT THE SITE AND INFORMATION PROVIDED BY THE CONTRACTOR OR OTHERS NOT ASSOCIATED WITH THE DESIGN ENGINEER. THE ORIGINAL SEALED DRAWING ARE ON FILE AT THE OFFICES OF WINKELMANN AND ASSOCIATES, INC.


*Maria L. Bonilla* 10-19-2016  
WINKELMANN AND ASSOCIATES, INC. DATE

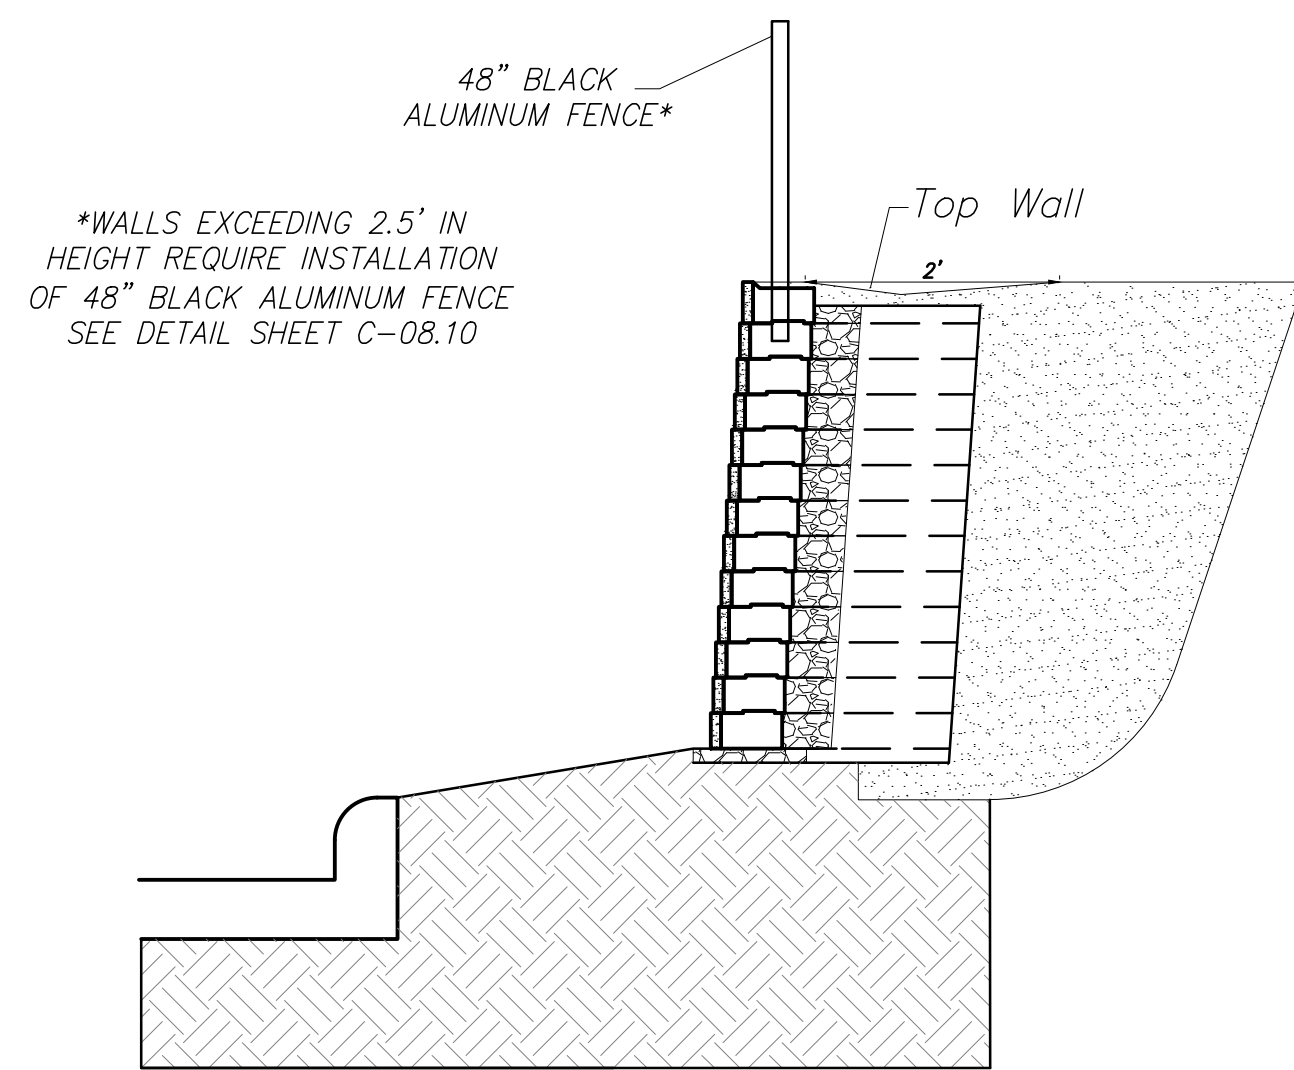

**DETAIL B-1**  
TYPICAL WALL SECTION  
FOR RETAINING WALL

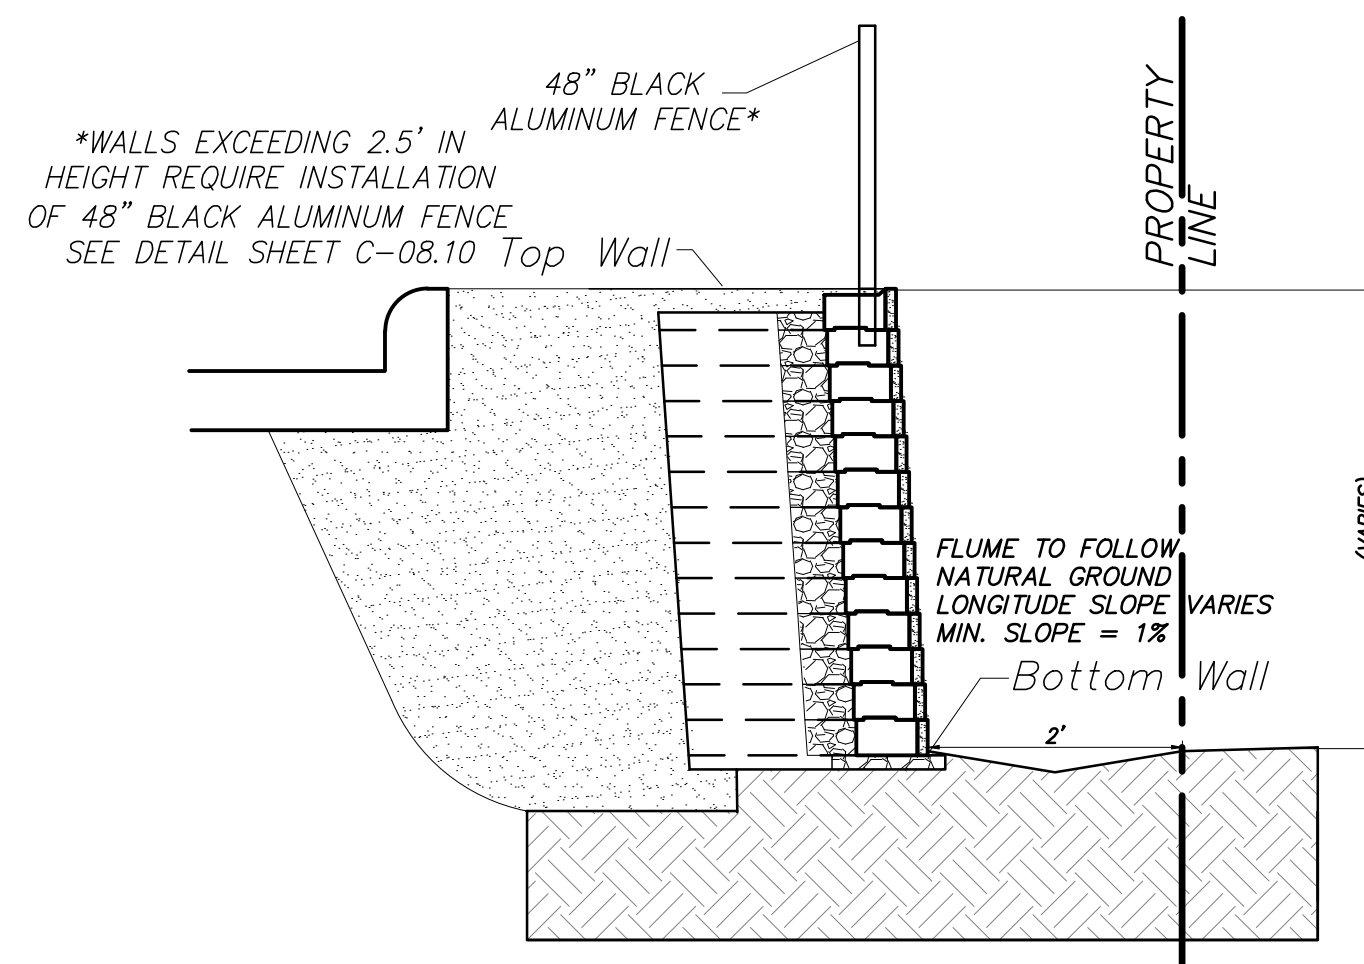

**DETAIL B-2**  
TYPICAL WALL SECTION  
FOR RETAINING WALL

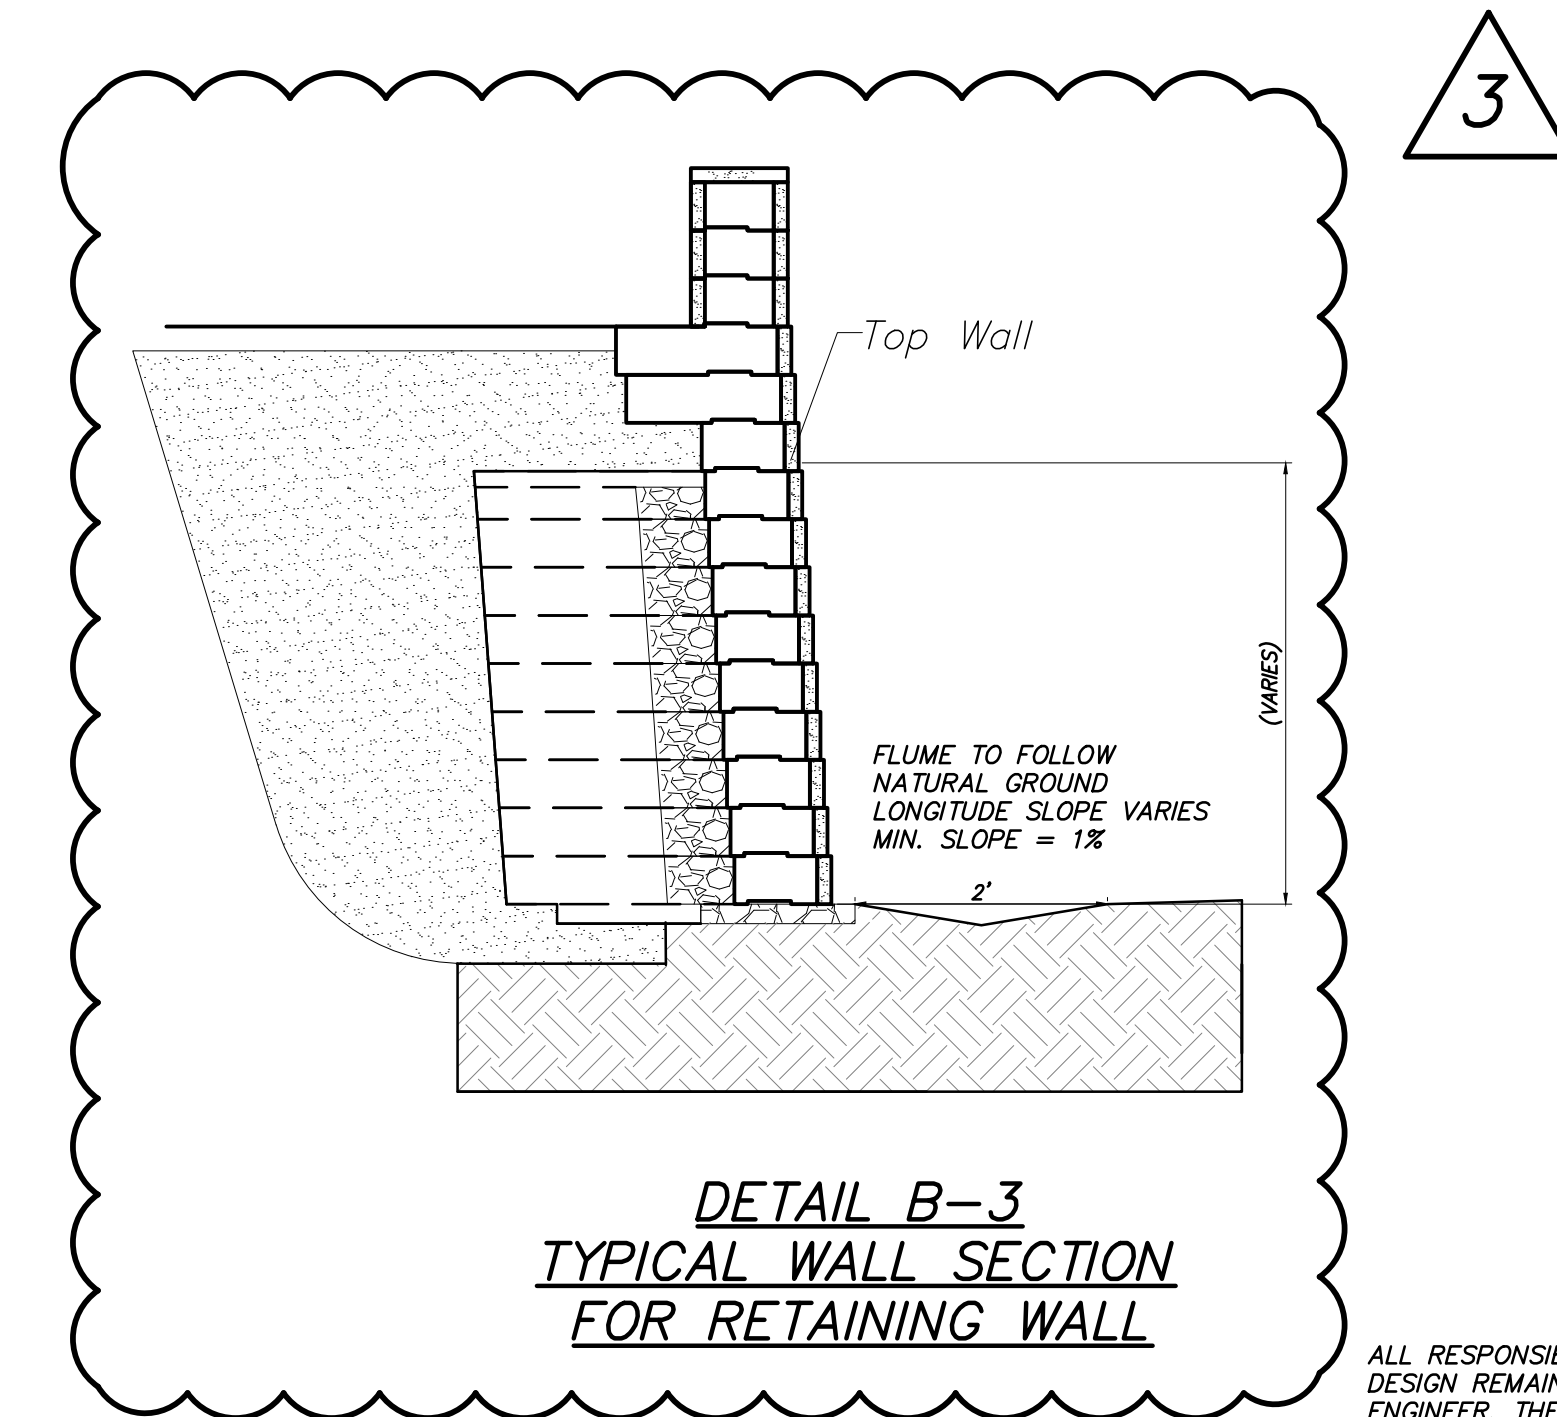

**DETAIL B-3**  
TYPICAL WALL SECTION  
FOR RETAINING WALL

ALL RESPONSIBILITY FOR ADEQUACY OF DESIGN REMAINS WITH THE DESIGN ENGINEER. THE CITY OF ROCKWALL, IN REVIEWING AND RELEASING PLANS FOR CONSTRUCTION, ASSUMES NO RESPONSIBILITY FOR ADEQUACY OR ACCURACY OF DESIGN.

No.	DATE	REVISION
6.		
5.		
4.	3/23/2015	RESPONSE TO RFI 028
3.	12/18/2015	ISSUE FOR CONSTRUCTION
2.	12/09/2015	BULLETIN #1
1.		

**Winkelmann & Associates, Inc.**  
CONSULTING CIVIL ENGINEERS & SURVEYORS  
6720 HILGRET PLAZA DR., SUITE 325  
ROCKWALL, TEXAS 75087  
Phone: 972-940-7090  
Fax: 972-940-7096  
Professional Engineer Registration No. 89  
Professional Surveyor Registration No. 109866-00  
CORPORATE OFFICE: WINKELMANN & ASSOCIATES, INC.

WALL DETAILS  
SEC. N. GOLIAD ST. AND E. QUAIL  
RUN RD.  
ROCKWALL, TEXAS

C-08.14  
DAL574