

IF GENERAL CONTRACTOR SELECTS TO USE OTHER WALL CONTRACTOR, MUST SUBMIT SIGNED AND SEALED PLANS.

GRADING LEGEND

| | |
|-----------------|-------------------|
| - - - 49.3 | EXISTING CONTOURS |
| — 488 | PROP. CONTOURS |
| — [dashed line] | RETAINING WALL |
| — [dashed line] | GRADE BREAK HP |
| — [dashed line] | GRADE BREAK LP |

ALL RESPONSIBILITY FOR ADEQUACY OF DESIGN REMAINS WITH THE DESIGN ENGINEER. THE CITY OF ROCKWALL, IN REVIEWING AND RELEASING PLANS FOR CONSTRUCTION, ASSUMES NO RESPONSIBILITY FOR ADEQUACY OR ACCURACY OF DESIGN.

LEGEND

| | |
|-----------------------|--------------------------------|
| PP Power Pole | IRF Iron Rod Found |
| CW Guy Wire | IRS Iron Rod Set |
| MH Manhole | CIRS Iron Rod Set w/ cap "WAI" |
| WV Water Valve | CIRF Iron Rod Found w/ cap |
| TP Telephone Pedestal | XCS X Cut in Concrete Set |
| WM Water Meter | XCF X Cut in Concrete Found |
| FH Fire Hydrant | PKS PK Nail Set |
| LP Light Pole | SS Sanitary Sewer |
| IV Irrigation Valve | SW Storm Sewer |
| CO Clean Out | TF Transformer pad |
| AC Air Conditioner | GM Gas Meter |
| TV Cable Box | GMK Gas Marker |
| SB Signal Box | TSN Traffic Sign |
| SP Signal Pole | UGC Underground Cable Marker |
| SN Sign | EB Electric Box |
| CM Control Monument | EM Electric Meter |

*****NOTICES TO CONTRACTOR*****

EXISTING UNDERGROUND/BURIED PUBLIC, PRIVATE, AND FRANCHISE UTILITIES/FACILITIES AFFECT THIS SITE, AND ARE DEPICTED ON THE PLANS PER THE BEST AVAILABLE INFORMATION AT THE TIME THE PLANS WERE PRODUCED. WINKELMANN & ASSOC., INC. SHALL NOT BE RESPONSIBLE FOR KNOWING THE EXACT LOCATION OF ALL FACILITIES OR DEPICTING EXACT LOCATIONS OF SAID FACILITIES ON THE PLANS BEYOND WHAT IS STATED ABOVE.

CONTRACTOR(S) SHALL CALL "811" A MINIMUM OF 48 HOURS PRIOR TO BEGINNING WORK ON THE SITE, AND SHALL NOT BEGIN ANY EXCAVATION OR DEMOLITION ACTIVITIES UNTIL AFTER SAID FACILITIES HAVE BEEN MARKED AND/OR FLAGGED PER "811" OR THE FACILITY OWNERS.

CONTRACTOR(S) SHALL BE WHOLLY RESPONSIBLE FOR ANY DAMAGE THAT MAY OCCUR TO SAID FACILITIES DUE TO WORK BEING DONE WITHOUT FOLLOWING THE PROCEDURES ABOVE.


AS-BUILT

THIS RECORD DRAWING IS COMPILATION OF A COPY OF THE SEALED ENGINEERING DRAWING FOR THIS PROJECT; MODIFIED BY ADDENDA, CHANGE ORDERS, AND INFORMATION FURNISHED BY THE CONTRACTOR. THE INFORMATION SHOWN ON THE RECORD DRAWINGS IS PROVIDED BASED ON SURVEYING AT THE SITE AND INFORMATION PROVIDED BY THE CONTRACTOR OR OTHERS NOT ASSOCIATED WITH THE DESIGN ENGINEER. THE ORIGINAL SEALED DRAWING ARE ON FILE AT THE OFFICES OF WINKELMANN AND ASSOCIATES, INC.

Maria C. Boilla
WINKELMANN AND ASSOCIATES, INC. 10-19-2016 DATE

| No. | DATE | REVISION |
|-----|------------|--------------------|
| 6. | | |
| 5. | | |
| 4. | | |
| 3. | | |
| 2. | | |
| 1. | 07/06/2016 | RESPONSE TO RFI 44 |
| | | M.B. |
| | | APPROV |

Winkelmann & Associates, Inc.
CONSULTING CIVIL ENGINEERS ■ SURVEYORS
7720 HILGRET PLAZA DRIVE, SUITE 325
ROCKWALL, TEXAS 75087
(972) 460-7090
FAX (972) 460-7098
Professional Registration No. 1008666-00
State Engineer Registration No. 1008666-00
Surveyor Registration No. 1008666-00
Professional Engineer Registration No. 1008666-00

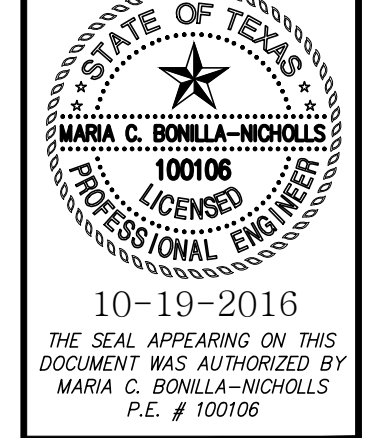

MONUMENT SIGN WALL
SEC. N. GOLIAD ST. AND E. QUAIL RUN RD.,
ROCKWALL, TEXAS

C-08.17
DAL574