


3

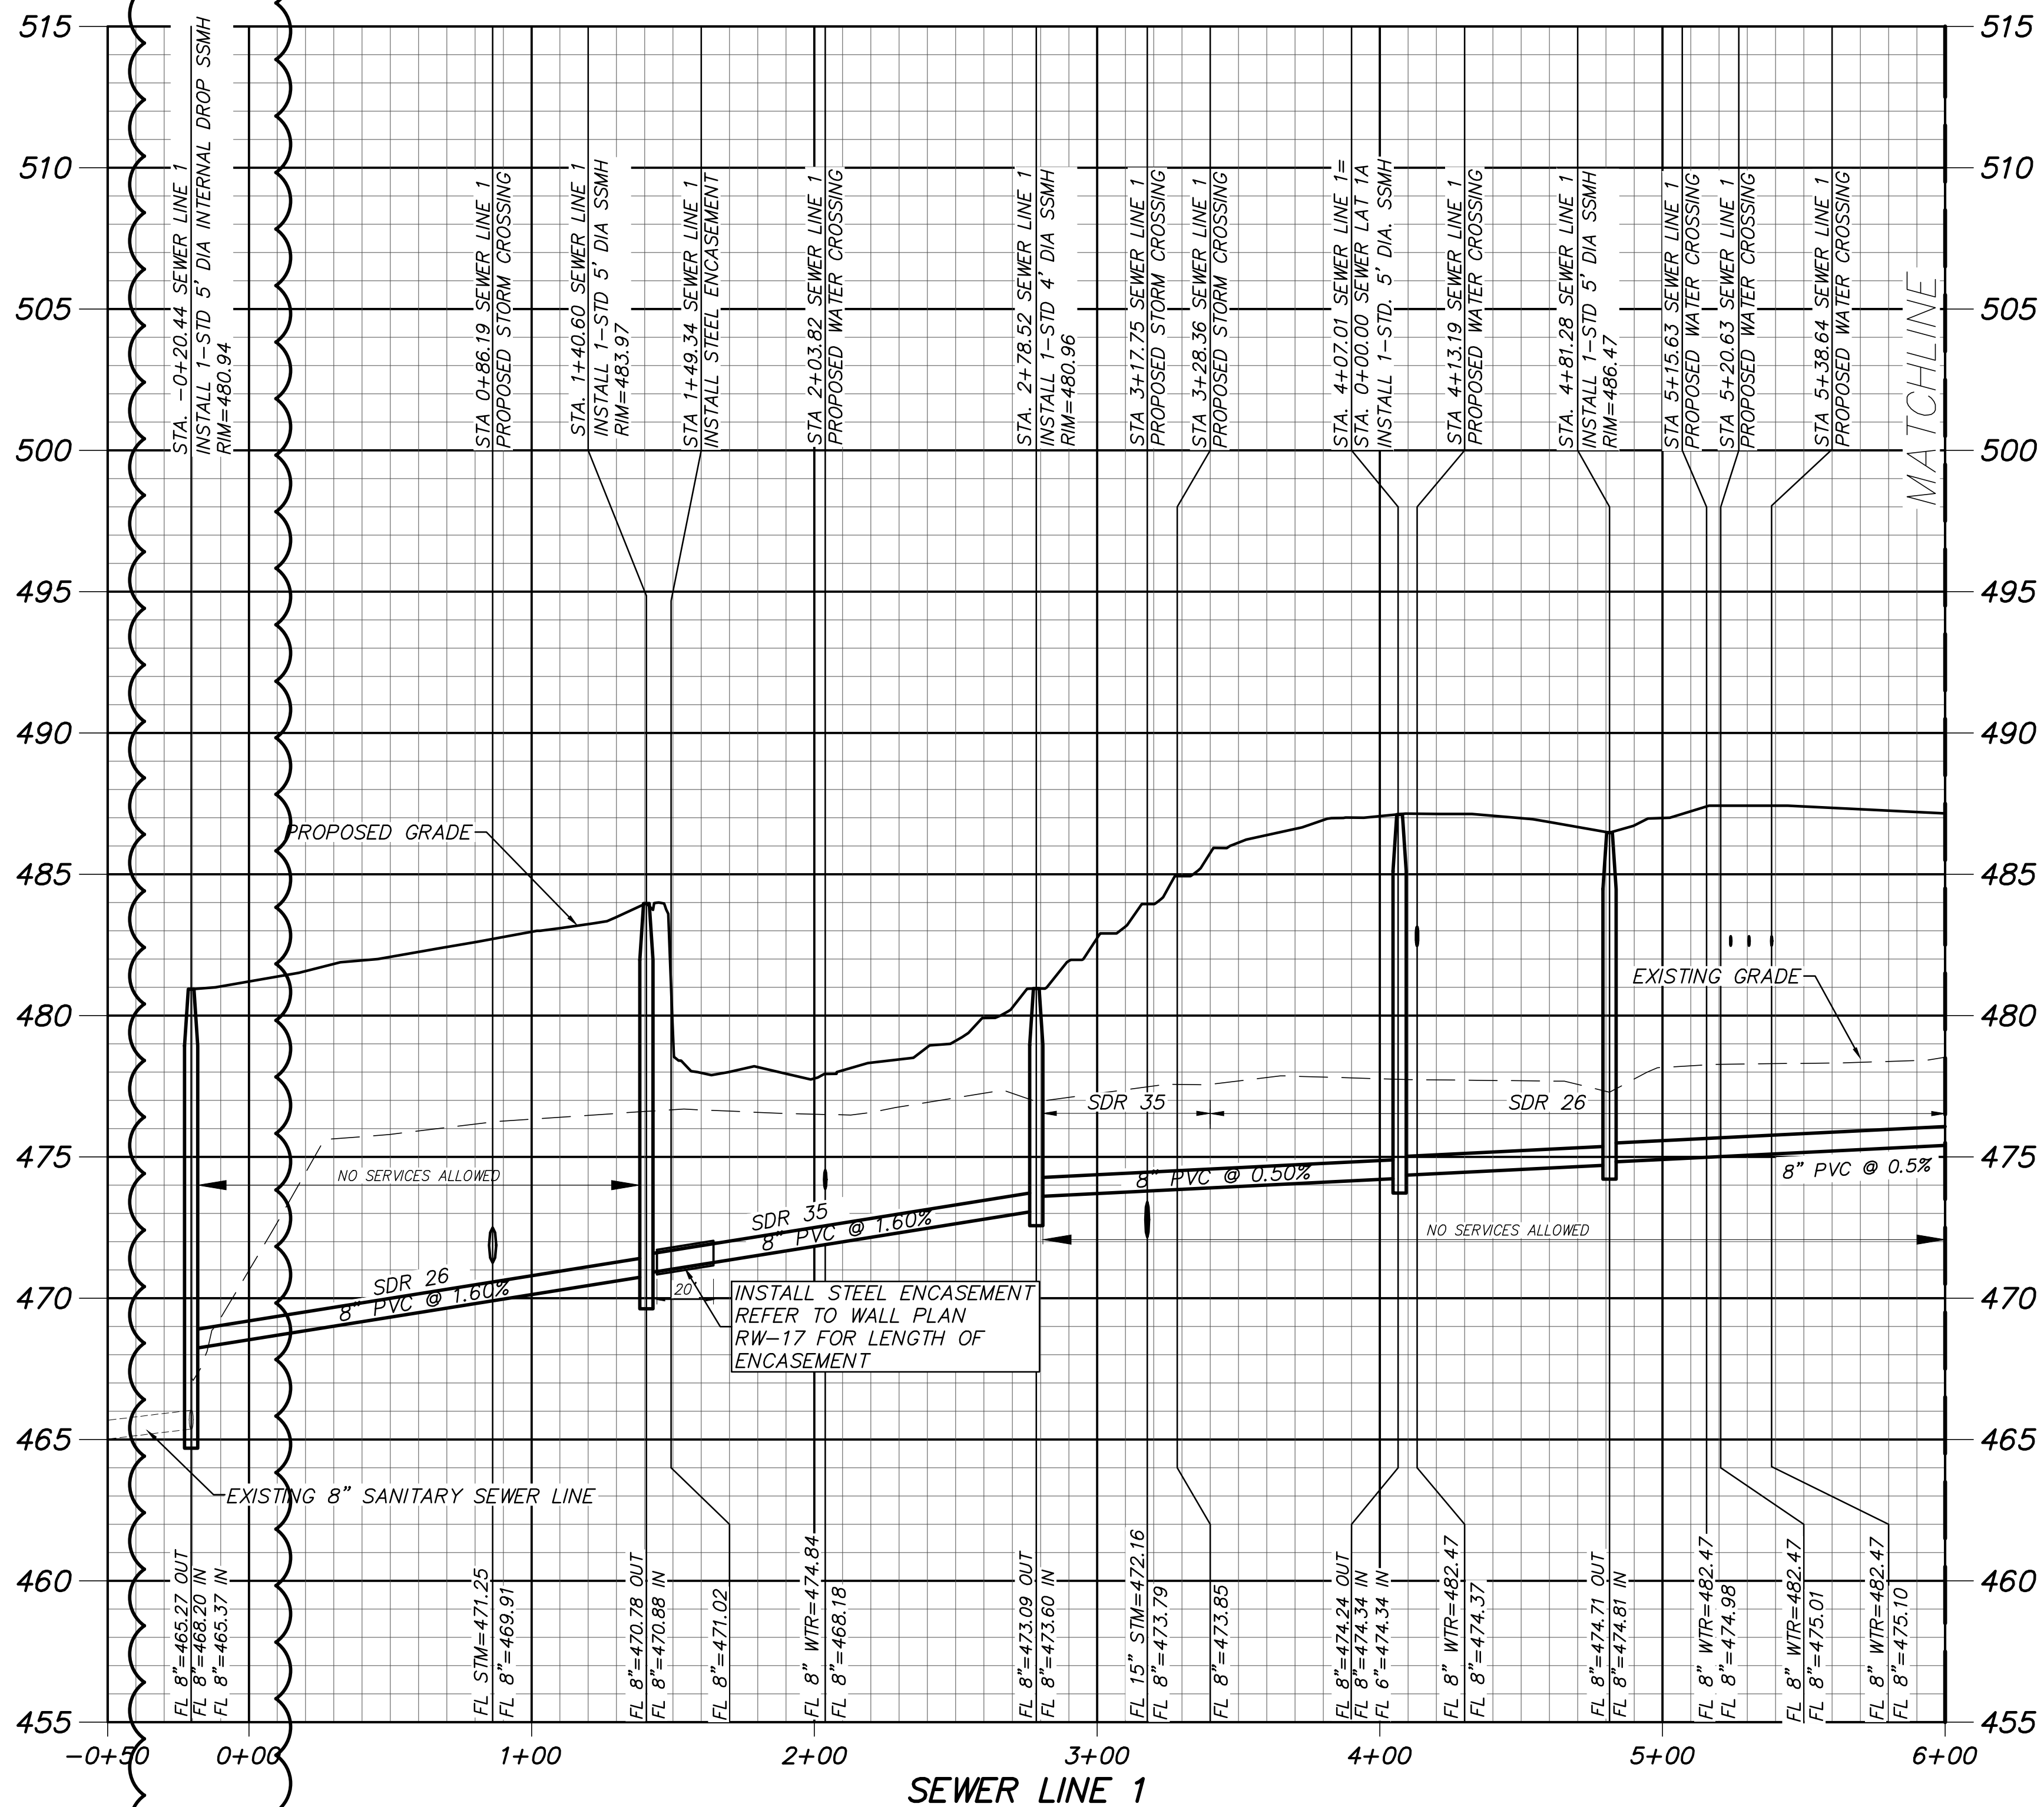

BENCH MARKS:
 BM#1 - "X" cut inside of "a" cut at the centerline of a curb inlet, southeasterly curb line of Quail Run, ±23.6 feet northeast of the POINT OF BEGINNING.
 ELEVATION - 482.71 feet
 BM#2 - "X" cut at the southeast end of a curb inlet, southeasterly curb line of Memorial Drive, ±13.4 feet southeast of the southeast property corner.
 ELEVATION - 472.19 feet

ALL RESPONSIBILITY FOR ADEQUACY OF DESIGN REMAINS WITH THE DESIGN ENGINEER. THE CITY OF ROCKWALL, IN REVIEWING AND RELEASING PLANS FOR CONSTRUCTION, ASSUMES NO RESPONSIBILITY FOR ADEQUACY OR ACCURACY OF DESIGN.

SCALE:
 H 1" = 40'
 V 1" = 4'

AS-BUILT
 THIS RECORD DRAWING IS COMPILATION OF A COPY OF THE SEALED ENGINEERING DRAWING FOR THIS PROJECT; MODIFIED BY ADDENDA, CHANGE ORDERS, AND INFORMATION FURNISHED BY THE CONTRACTOR. THE INFORMATION SHOWN ON THE RECORD DRAWINGS IS PROVIDED BASED ON SURVEYING AT THE SITE AND INFORMATION PROVIDED BY THE CONTRACTOR OR OTHERS NOT ASSOCIATED WITH THE DESIGN ENGINEER. THE ORIGINAL SEALED DRAWING ARE ON FILE AT THE OFFICES OF WINKELMANN AND ASSOCIATES, INC.
 Maria L. Boilla
 WINKELMANN AND ASSOCIATES, INC. 10-19-2016
 DATE

NOTICES TO CONTRACTOR
 EXISTING UNDERGROUND/BURIED PUBLIC, PRIVATE, AND FRANCHISE UTILITIES/FACILITIES AFFECT THIS SITE, AND ARE DEPICTED ON THE PLANS PER THE BEST AVAILABLE INFORMATION AT THE TIME THE PLANS WERE PRODUCED. WINKELMANN & ASSOC., INC. SHALL NOT BE RESPONSIBLE FOR KNOWING THE EXACT LOCATION OF ALL FACILITIES OR DEPICTING EXACT LOCATIONS OF SAID FACILITIES ON THE PLANS BEYOND WHAT IS STATED ABOVE.
 CONTRACTOR(S) SHALL CALL "811" A MINIMUM OF 48 HOURS PRIOR TO BEGINNING WORK ON THE SITE, AND SHALL NOT BEGIN ANY EXCAVATION OR DEMOLITION ACTIVITIES UNTIL SAID FACILITIES HAVE BEEN MARKED AND/OR FLAGGED PER "811" OR THE FACILITY OWNERS.
 CONTRACTOR(S) SHALL BE WHOLLY RESPONSIBLE FOR ANY DAMAGE THAT MAY OCCUR TO SAID FACILITIES DUE TO WORK BEING DONE WITHOUT FOLLOWING THE PROCEDURES ABOVE.

No.	REVISION	DATE
6.		
5.		
4.	RESPONSE TO RFI 025	03/24/2016
3.	ISSUE FOR CONSTRUCTION	12/18/2015
2.	BULLETIN #1	12/09/2015
1.		

Winkelmann & Associates, Inc.
 CONSULTING CIVIL ENGINEERS ■ SURVEYORS
 7720 HILGREET PLAZA DRIVE, SUITE 325
 ROCKWALL, TEXAS 75087
 (972) 460-7090
 (972) 460-7096 FAX
 State Engineer Registration No. 89
 State Surveyor Registration No. 100866-00
 State Professional Engineer Registration No. 100866-00
 State Professional Land Surveyor Registration No. 100866-00

STATE OF TEXAS
 MARIA C. BOILLA-NICHOLS
 100106
 LICENSED
 PROFESSIONAL ENGINEER
 10-19-2016
 THE SEAL APPEARING ON THIS DOCUMENT WAS AUTHORIZED BY MARIA C. BOILLA-NICHOLS P.E. # 100106

SANITARY SEWER PROFILE
 SEC N. GOLIAD ST. AND E. QUAIL RUN RD.
 ROCKWALL, TEXAS

C-13.04
 DAL574