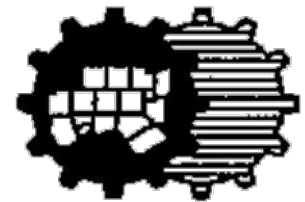


GENERAL NOTES:

1. IN GENERAL, REINFORCING STEEL SHALL BE #4 BARS ON 12" CENTERS BOTH WAYS FOR GUTTER, BOTTOM SLAB ENDS, FRONT AND BACK WALLS, AND #4 BARS ON 6" CENTERS BOTH WAYS FOR TOP SLAB. AN ADDITIONAL #6 BAR SHALL BE PLACED IN THE FRONT EDGE OF THE TOP SLAB IN THE INLETS AND ADDITIONAL REINFORCING STEEL SHALL BE PLACED AROUND MANHOLES AS SHOWN.
2. ALL REINFORCING STEEL SHALL BE GRADE 60.
3. ALL CONCRETE SHALL BE 4,200 PSI . ALL EXPOSED CORNERS SHALL BE CHAMFERED 3/4".
4. ALL REINFORCING STEEL SHALL HAVE A MINIMUM COVER OF 2" TO THE CENTERS OF THE BARS.
5. 10'-0" OF EXISTING CURB AND GUTTER UPSTREAM AND 10'-0" OF EXISTING CURB AND GUTTER DOWNSTREAM SHALL BE REMOVED AND REPOURED INTEGRALLY WITH EACH INLET.
6. ALL BACK FILLING SHALL BE PERFORMED BY MECHANICAL TAMPING TO 95% STANDARD PROCTOR DENSITY.

STANDARD DRAWING NO.
6030D


CURB INLET RECESSED
GENERAL NOTES

North Central Texas Council of Governments

 STANDARD SPECIFICATION REFERENCE
702
 DATE
OCT. '04

STANDARD DRAWING NO.
6030D

AS-BUILT

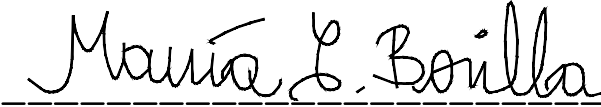
THIS RECORD DRAWING IS COMPILATION OF A COPY OF THE SEALED ENGINEERING DRAWING FOR THIS PROJECT; MODIFIED BY ADDENDA, CHANGE ORDERS, AND INFORMATION FURNISHED BY THE CONTRACTOR. THE INFORMATION SHOWN ON THE RECORD DRAWINGS IS PROVIDED BASED ON SURVEYING AT THE SITE AND INFORMATION PROVIDED BY THE CONTRACTOR OR OTHERS NOT ASSOCIATED WITH THE DESIGN ENGINEER. THE ORIGINAL SEALED DRAWING ARE ON FILE AT THE OFFICES OF WINKELMANN AND ASSOCIATES, INC.


 WINKELMANN AND ASSOCIATES, INC.


10-19-2016
 DATE

ALL RESPONSIBILITY FOR ADEQUACY OF DESIGN REMAINS WITH THE DESIGN ENGINEER. THE CITY OF ROCKWALL, IN REVIEWING AND RELEASING PLANS FOR CONSTRUCTION, ASSUMES NO RESPONSIBILITY FOR ADEQUACY OR ACCURACY OF DESIGN.

| | | | | | | | | | |
|-----|--|--|--|------------|------------|------|----------|-------------|--------|
| 6. | | | | | | | | | |
| 5. | | | | | | | | | |
| 4. | | | | | | | | | |
| 3. | | | | | | | | | |
| 2. | | | | 12/18/2015 | 12/09/2015 | DATE | REVISION | BULLETIN #1 | M.B. |
| 1. | | | | | | | | | M.B. |
| No. | | | | | | | | | APPROV |



Winkelman & Associates, Inc.
CONSULTING CIVIL ENGINEERS ■ SURVEYORS
7750 HILGRET PLAZA DR., SUITE 325
ROCKWALL, TEXAS 75087
PHONE: (972) 940-7090
FAX: (972) 940-7098
Professional Engineer Registration No. 89
Professional Surveyor Registration No. 108666-00
Professional Engineer Registration No. 108666-00
Professional Surveyor Registration No. 108666-00



STATE OF TEXAS
MARIA C. BOULLA-NICHOLS
 100106
 LICENSED PROFESSIONAL ENGINEER
 10-19-2016
THE SEAL APPEARING ON THIS DOCUMENT WAS AUTHORIZED BY MARIA C. BOULLA-NICHOLS P.E. # 100106

CIVIL DETAILS
SEC. N. GOLIAD ST. AND E. QUAIL RUN RD.
ROCKWALL, TEXAS

C-15.05
DAL574