



ALL RESPONSIBILITY FOR ADEQUACY OF DESIGN REMAINS WITH THE DESIGN ENGINEER. THE CITY OF ROCKWALL, IN REVIEWING AND RELEASING PLANS FOR CONSTRUCTION, ASSUMES NO RESPONSIBILITY FOR ADEQUACY OR ACCURACY OF DESIGN.

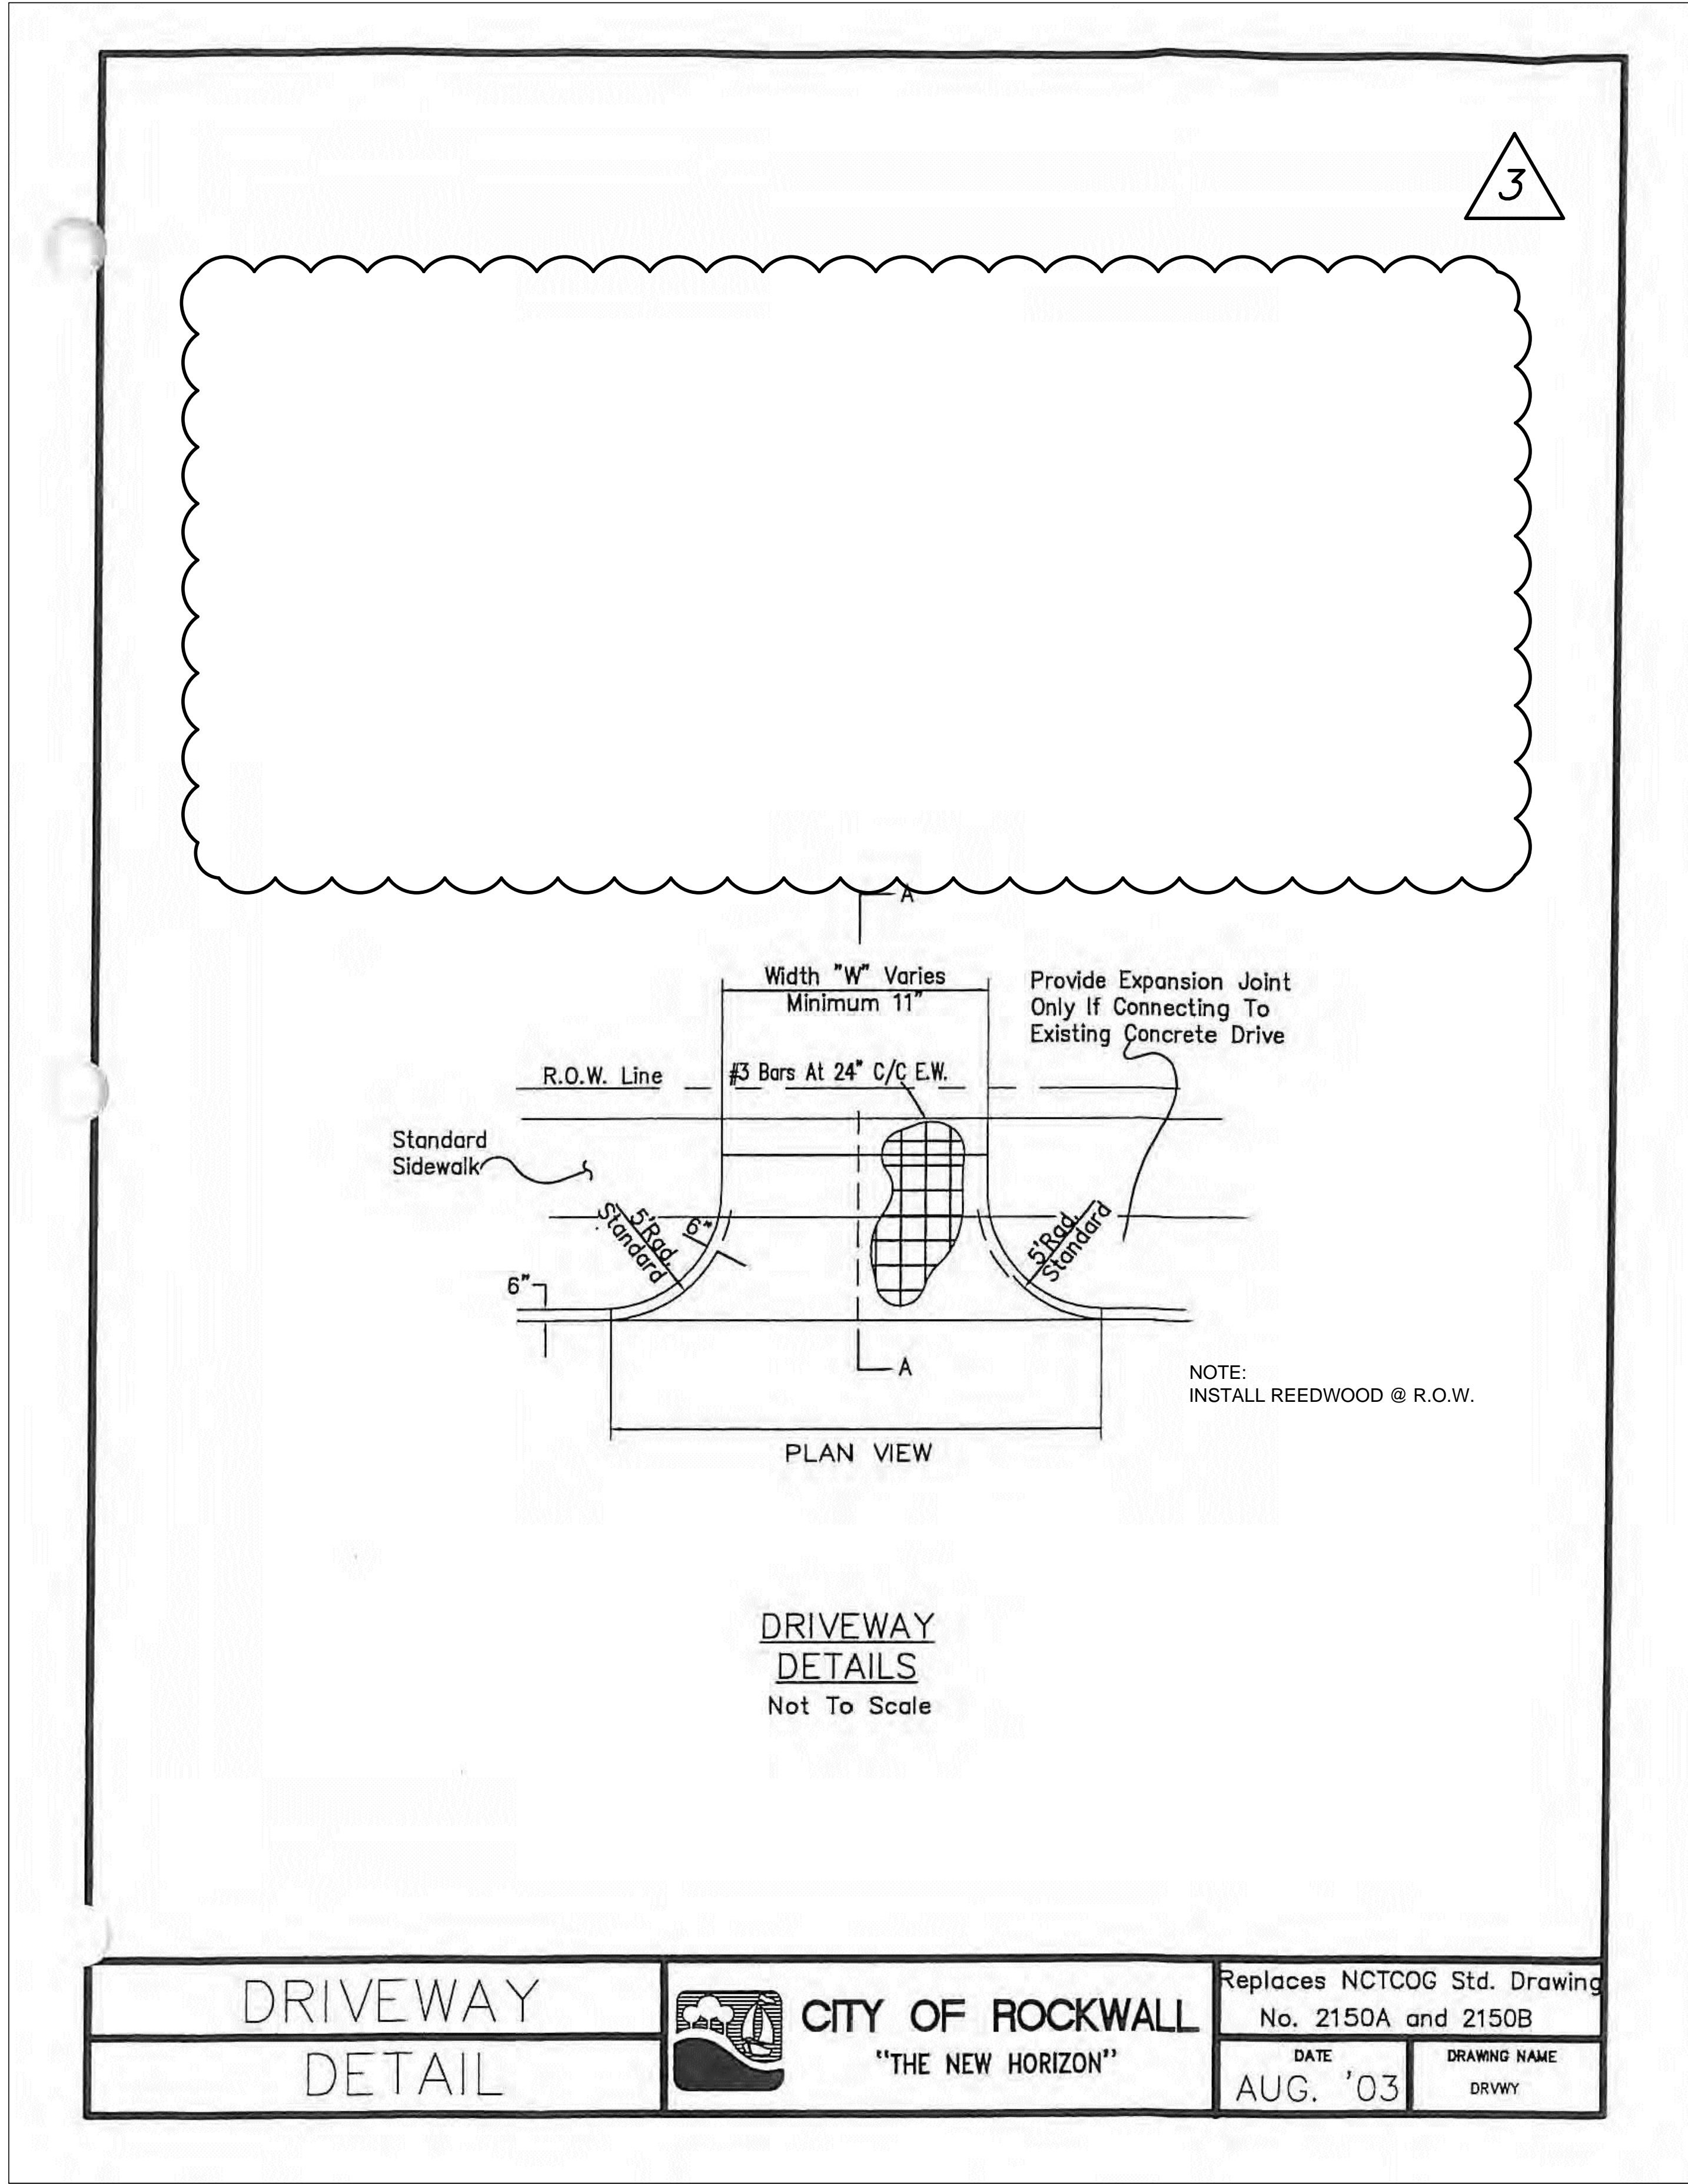

AS-BUILT

THIS RECORD DRAWING IS COMPILATION OF A COPY OF THE SEALED ENGINEERING DRAWING FOR THIS PROJECT; MODIFIED BY ADDENDA, CHANGE ORDERS, AND INFORMATION FURNISHED BY THE CONTRACTOR. THE INFORMATION SHOWN ON THE RECORD DRAWINGS IS PROVIDED BASED ON SURVEYING AT THE SITE AND INFORMATION PROVIDED BY THE CONTRACTOR OR OTHERS NOT ASSOCIATED WITH THE DESIGN ENGINEER. THE ORIGINAL SEALED DRAWING ARE ON FILE AT THE OFFICES OF WINKELMANN AND ASSOCIATES, INC.

*Maria C. Boilla*  
WINKELMANN AND ASSOCIATES, INC.      10-19-2016  
DATE

DRIVEWAY DETAIL	 <b>CITY OF ROCKWALL</b> "THE NEW HORIZON"	Replaces NCTCOG Std. Drawing No. 2150A and 2150B	
		DATE AUG. '03	DRAWING NAME DRWY

No.	DATE	REVISION	APPROV
6.			
5.			
4.	06/03/2016	RESPONSE TO T&S COMMENTS	M.B.
3.	12/18/2015	ISSUE FOR CONSTRUCTION	M.B.
2.	12/09/2015	BULLETIN #1	M.B.
1.			

**Winkelmann & Associates, Inc.**  
CONSULTING CIVIL ENGINEERS • SURVEYORS  
1720 HILGRET PLAZA DRIVE, SUITE 325  
ROCKWALL, TEXAS 75087  
(972) 940-7090  
FAX (972) 940-7096  
Professional Engineer Registration No. 89  
Professional Surveyor Registration No. 100866-00  
Subcontractor of State, Metropolitan & Associates, Inc.

STATE OF TEXAS  
MARIAN C. BOILLA-NICHOLLS  
100106  
LICENSED  
PROFESSIONAL ENGINEER  
10-19-2016  
THE SEAL APPEARING ON THIS DOCUMENT WAS AUTHORIZED BY MARIAN C. BOILLA-NICHOLLS P.E. # 100106

CITY DETAILS  
SEC N. GOLIAD ST. AND E. QUAIL  
RUN RD.  
ROCKWALL, TEXAS

C-15.07  
DAL574