


DISCLAIMER: The use of this standard is governed by the "Texas Engineering Practice Act". No warranty of any kind is made by TxDOT for any purpose whatsoever. TxDOT assumes no responsibility for the conversion of this standard to other formats or for incorrect results or damages resulting from its use.

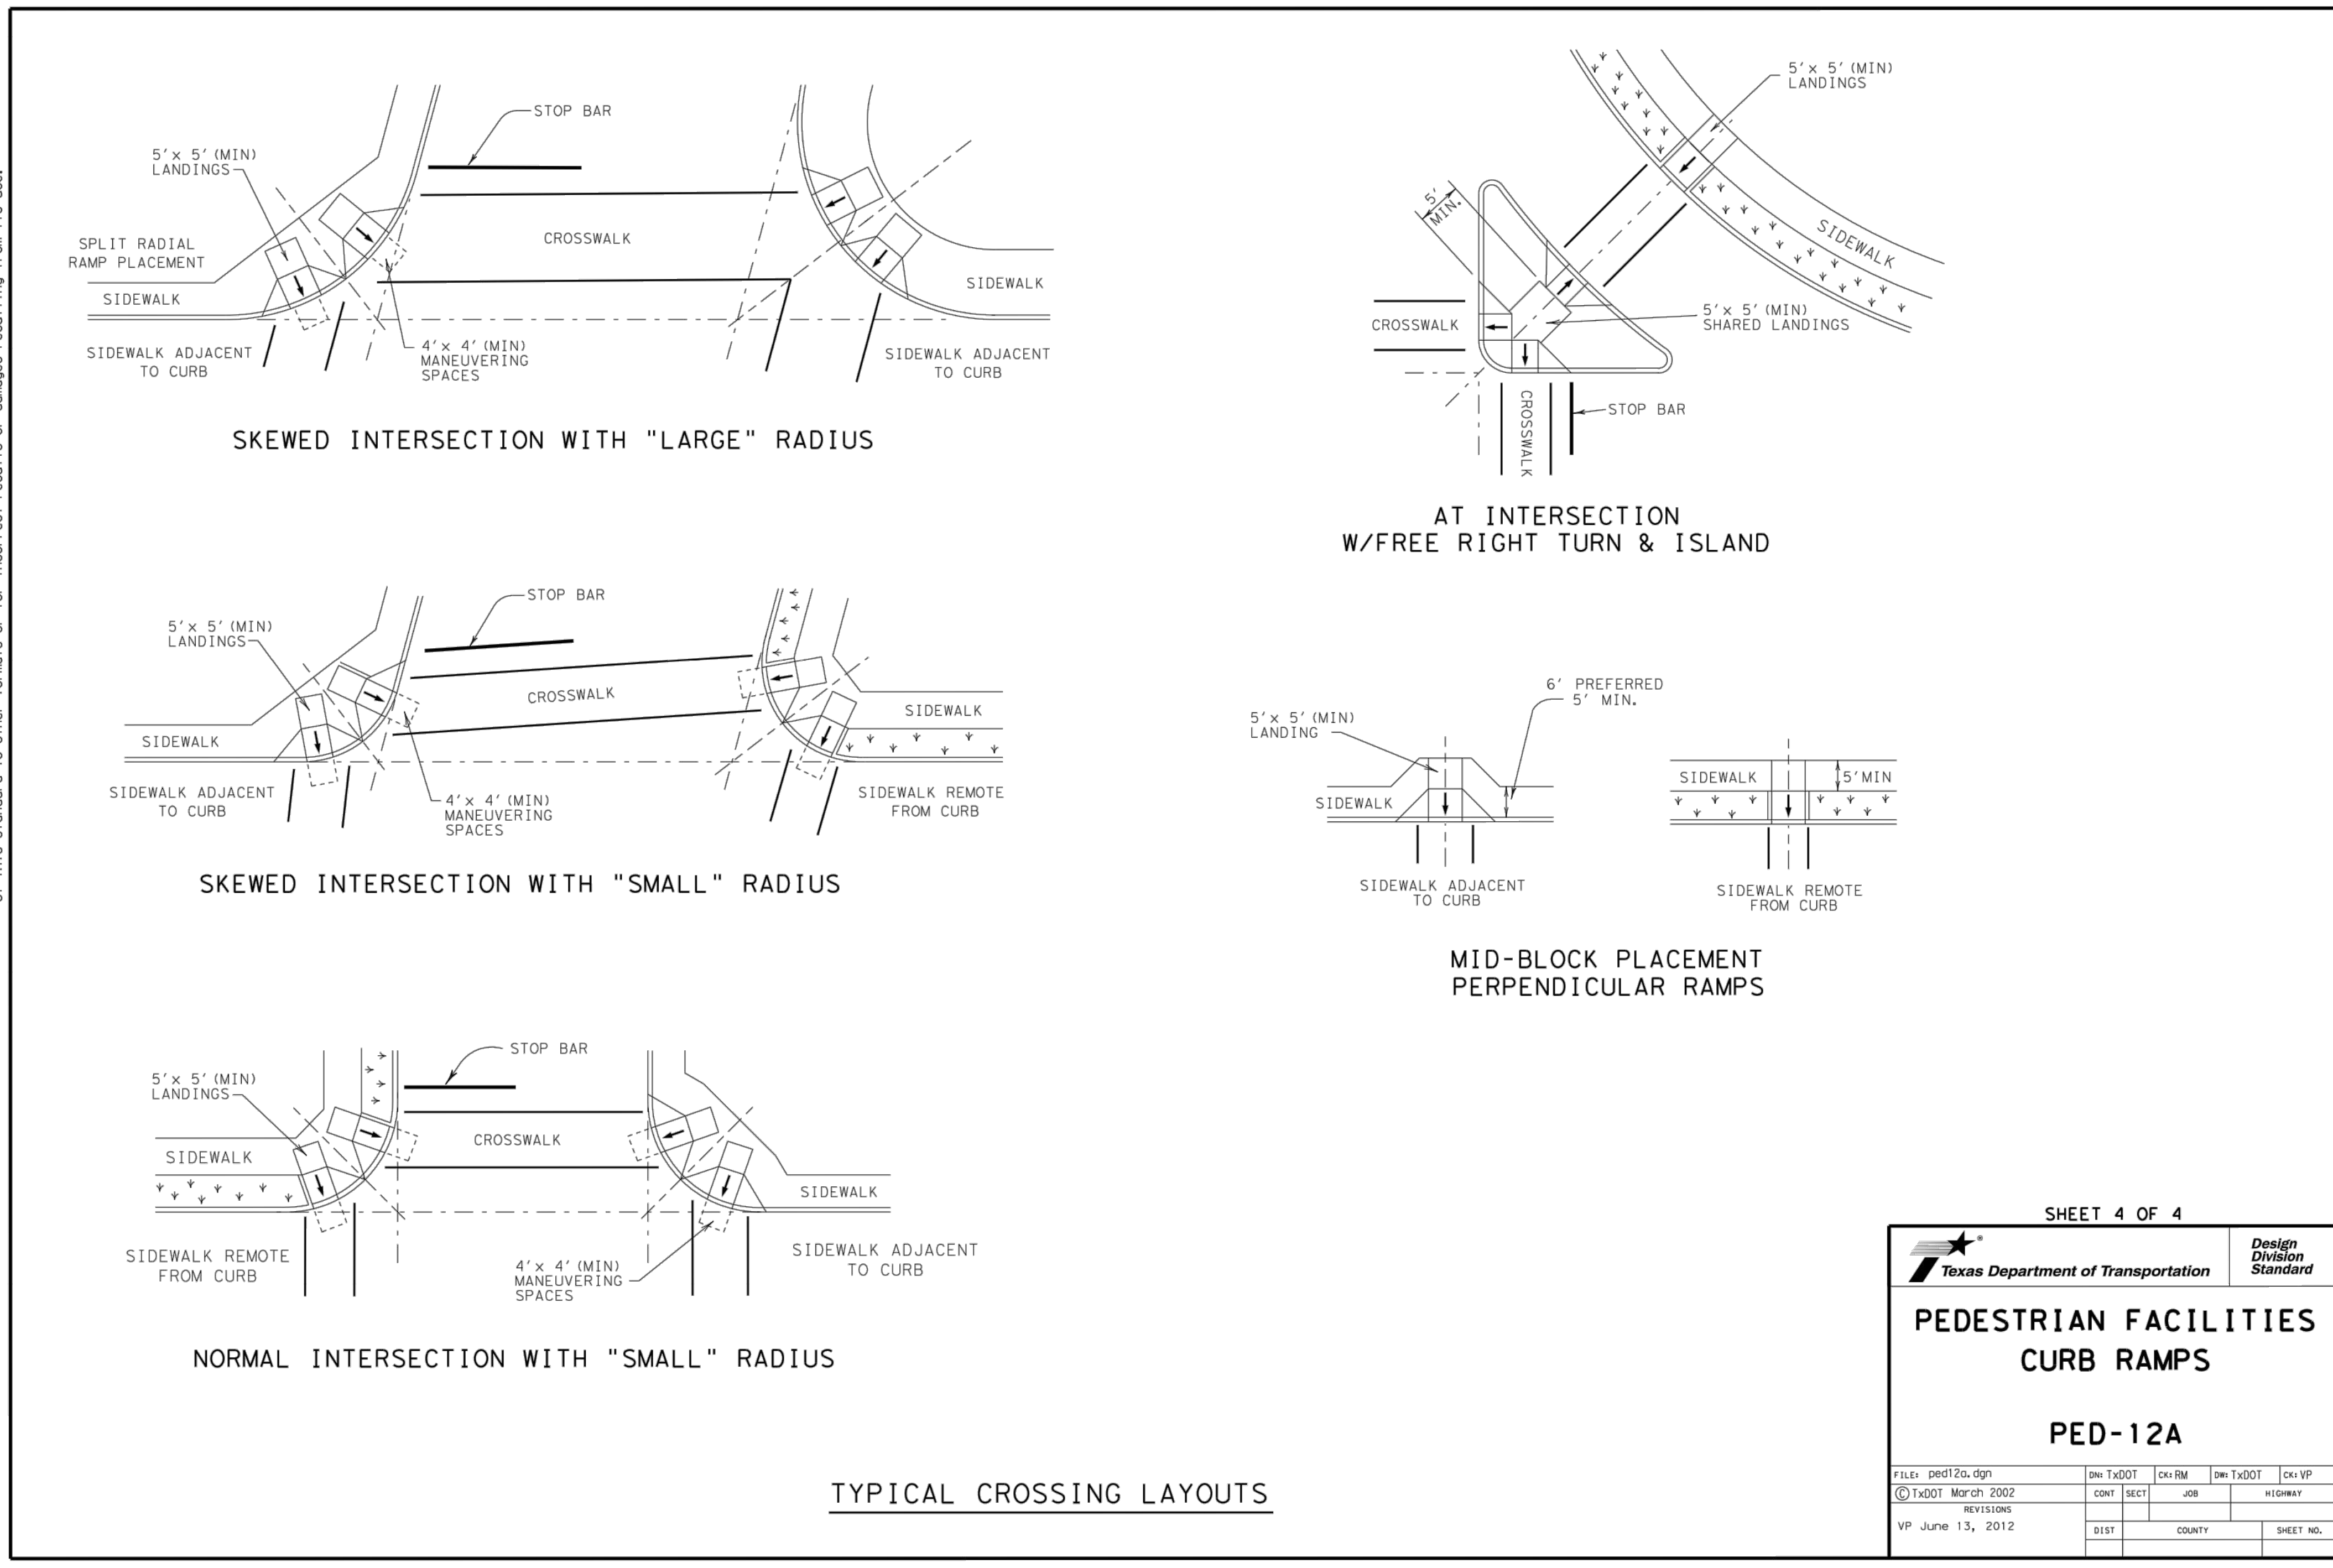

SHEET 4 OF 4

Texas Department of Transportation
Design Division Standard

**PEDESTRIAN FACILITIES
CURB RAMPS**

PED-12A

FILE: ped12a.dgn	DN: TxDOT	CK: RM	DN: TxDOT	CK: VP
© TxDOT March 2002	CONT	SECT	JOB	HIGHWAY
REVISIONS	DIST	COUNTY	SHEET NO.	
VP June 13, 2012				

ALL RESPONSIBILITY FOR ADEQUACY OF DESIGN REMAINS WITH THE DESIGN ENGINEER. THE CITY OF ROCKWALL, IN REVIEWING AND RELEASING PLANS FOR CONSTRUCTION, ASSUMES NO RESPONSIBILITY FOR ADEQUACY OR ACCURACY OF DESIGN.

AS-BUILT

THIS RECORD DRAWING IS COMPILATION OF A COPY OF THE SEALED ENGINEERING DRAWING FOR THIS PROJECT; MODIFIED BY ADDENDA, CHANGE ORDERS, AND INFORMATION FURNISHED BY THE CONTRACTOR. THE INFORMATION SHOWN ON THE RECORD DRAWINGS IS PROVIDED BASED ON SURVEYING AT THE SITE AND INFORMATION PROVIDED BY THE CONTRACTOR OR OTHERS NOT ASSOCIATED WITH THE DESIGN ENGINEER. THE ORIGINAL SEALED DRAWING ARE ON FILE AT THE OFFICES OF WINKELMANN AND ASSOCIATES, INC.

Maria C. Bonilla
WINKELMANN AND ASSOCIATES, INC. 10-19-2016
DATE

Winkelmann & Associates, Inc.
CONSULTING CIVIL ENGINEERS ■ SURVEYORS
7720 HILGRET PLAZA DRIVE, SUITE 325
ROCKWALL, TEXAS 75087
(972) 940-7090
Fax: (972) 940-7098
Professional Engineer Registration No. 89
Professional Surveyor Registration No. 100866-00
Professional Engineer Registration No. 100866-00
Professional Surveyor Registration No. 100866-00

STATE OF TEXAS
MARIA C. BONILLA-NICHOLLS
100106
LICENSED PROFESSIONAL ENGINEER

10-19-2016
THE SEAL APPEARING ON THIS DOCUMENT WAS AUTHORIZED BY MARIA C. BONILLA-NICHOLLS, P.E. # 100106

CITY DETAILS
SEC. N. GOLIAD ST. AND E. GUAL RUN RD.
ROCKWALL, TEXAS

No.	REVISION	DATE	M.B.
1.	ISSUE FOR CONSTRUCTION BULLETIN #1	12/09/2015	M.B.
2.		12/18/2015	M.B.
3.			
4.			
5.			
6.			

C-15.09
DAL574

LAST SAVED BY: BHOGUE, October 20, 2016

G:\315\85\ENGINEERING\Construction Plans\151585-CITY DETAILS.dwg