


- LEGEND**
- F.H. FIRE HYDRANT
 - X SET CHISELED "X" SET
 - F.X. CHISELED "X" FOUND
 - I.R. IRON ROD FOUND (SIZE AS NOTED)
 - S.I.R. IRON ROD SET (SIZE AS NOTED)
 - U.P. OVERHEAD UTILITY POLE W/ GUY
 - U.E. UNDERGROUND ELECTRIC OR TELEPHONE
 - L.P. LIGHT POLE (EX)
 - S.S.M. SANITARY SEWER MANHOLE (EX)
 - S.C.O. SAN. SWR. CLEAN OUT (EX)
 - G.V. GAS VALVE (EX)
 - W.V. WATER VALVE (EX)
 - T. TREE
 - PROP. COMBINATION GRATE INLET
 - PROP. DROP INLET
 - PROP. CURB INLET
 - PROP. SIGNAGE (H.C.)
 - PAINTED HANDICAP SYMBOL
 - ▬ PROPOSED STORM SEWER
 - ▬ EXISTING STORM SEWER
 - ▬ REMOVE EX. CONC. P.V.M.T.

NOTE: ALL PIPE TO BE CL III RCP UNLESS NOTED OTHERWISE.

MATCH LINE SEE SHEET C-13


CENTERLINE STORM SEWER CURVE DATA

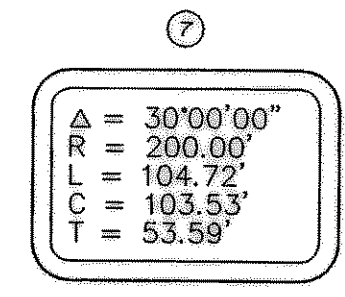

BENCH MARK:
BOX CUT IN NW CURB RETURN AT THE INTERSECTION OF WESTWOOD AND ROCKWALL PARKWAY. ELEVATION = 537.56

AS BUILT
DATE 12/14/05

THE SEAL APPEARING ON THIS DOCUMENT WAS AUTHORIZED BY BRYAN M. BURGER, P.E. 90880 ON 1/23/05

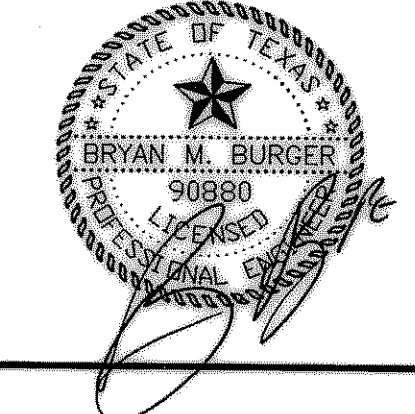

2	5-02-05	ISSUED FOR CONSTRUCTION
1	3-22-05	ADDENDUM NO. 15 REVISED 6" CURB INLETS TO 5" CURB INLETS & ADJUSTED FLOW LINES
REV	DATE	REMARKS
DRAINAGE PLAN		
LOTS 6, 17, 18 & 19, BLOCK A		
HORIZON RIDGE ADDITION		
THE CITY OF ROCKWALL, TEXAS		
LAWRENCE A. CATES & ASSOC., LLP		CONSULTING ENGINEERS
14800 QUORUM DRIVE, SUITE 200		DALLAS, TEXAS
DESIGN	DRAWN	DATE
LAC	MCL	01-28-05
SCALE	NOTES	FILE
1" = 40'	D.P.	24104 DRAINAGE2
NO.	C-12	