


M. J. DALE  
BARKSDALE  
SURVEY  
A-111

**BENCH MARK(S) :**  
EXISTING SQUARE CUT ON TOP OF WEST CURB OF LAKESIDE DRIVE  
LOCATED APPROXIMATELY 120 FEET NORTH OF RAILROAD, AT THE  
NORTHWEST CORNER. ELEV=506.23

LEGEND :	
PROP. STM. SWR.	RIGHT-OF-WAY
EX. STM. SWR.	LOT LINE
PROP. SAN. SWR.	DITCH FLOWLINE
EX. SAN. SWR.	EX. GAS
PROP. WATER	EX. BURIED TELEPHONE
EX. WATER	EX. BURIED ELECTRICAL
FENCE	
PROP. FIRE HYDRANT	PROP. GATE VALVE
PROP. MANHOLE	PROP. MANHOLE
POWER POLE	CLEANOUT
GUY WIRE	WATER METER
PHONE BOX	GAS METER
ROW-MARKER	ROAD SIGN
IRON PIN	BENCHMARK
TRAVERSE POINT	TREE
MAILBOX	

REVISIONS			
REV. NO.	DESCRIPTION	DATE	DRWN. BY

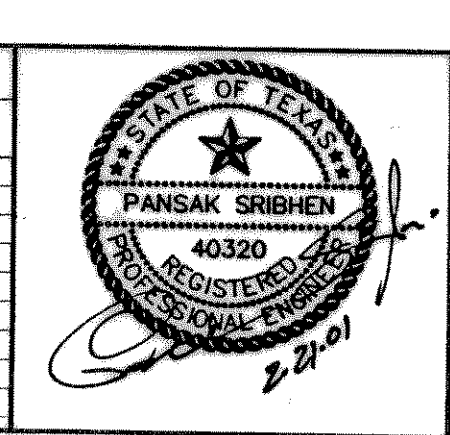

**ASA ENGINEERING**  
17819 DAVENPORT RD, SUITE 215  
DALLAS, TEXAS 75252  
(972) 248-9651 FAX (972) 248-9681

CITY OF ROCKWALL, TEXAS LA JOLLA POINTE ADDITION					
DRAINAGE AREA MAP					
DESIGN	DRAWN	DATE	SCALE	PROJ. No	SHEET No.
PSA	MIR	2-22-01	1"=100'	2001.LJP	D-1