


BENCH MARK(S) :
 EXISTING SQUARE CUT ON TOP OF WEST CURB OF LAKESIDE DRIVE LOCATED APPROXIMATELY 120 FEET NORTH OF RAILROAD, AT THE NORTHWEST CORNER. ELEV=506.23

LEGEND :

PROP. STM. SWR.	RIGHT-OF-WAY	PROP. FIRE HYDRANT	EXIST. FIRE HYDRANT
EX. STM. SWR.	LOT LINE	PROP. GATE VALVE	EXIST. GATE VALVE
PROP. SAN. SWR.	DITCH FLOWLINE	PROP. MANHOLE	EXIST. MANHOLE
EX. SAN. SWR.	EX. GAS	POWER POLE	CLEANOUT
PROP. WATER	EX. BURIED TELEPHONE	GUY WIRE	WATER METER
EX. WATER	EX. BURIED ELECTRICAL	PHONE BOX	GAS METER
FENCE		ROAD-MARKER	ROAD SIGN
		IRON PIN	BENCHMARK
		TRAVERSE POINT	TREE
		MAILBOX	

REVISIONS

REV. NO.	DESCRIPTION	DATE	DRWN. BY

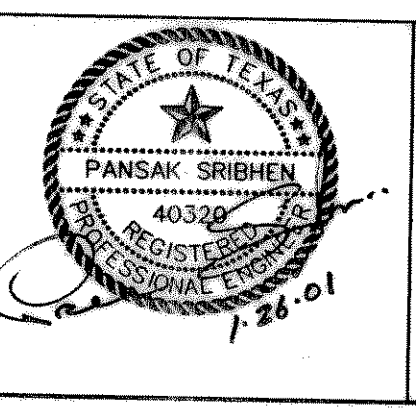

ASA ENGINEERING
 17819 DAVENPORT RD., SUITE 215
 DALLAS, TEXAS 75252
 (972) 248-9651 FAX (972) 248-9681

**CITY OF ROCKWALL, TEXAS
 LA JOLLA POINTE ADDITION**

STORM SEWER PROFILE - LINE D-1

DESIGN	DRAWN	DATE	SCALE	PROJ. No.	SHEET No.
PSA	MIR	01-26-01	1"=20' H 1"=5' V	2001.LJP	D-9