


BENCH MARK(S) :
 EXISTING SQUARE CUT ON TOP OF WEST CURB OF LAKESIDE DRIVE
 LOCATED APPROXIMATELY 120 FEET NORTH OF RAILROAD, AT THE
 NORTHWEST CORNER. ELEV=506.23

LEGEND :

REV. NO.	DESCRIPTION	DATE	DRWN. BY

REVISIONS

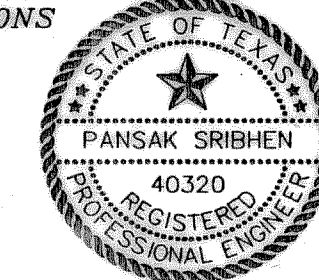

ASA ENGINEERING
 17819 DAVENPORT RD, SUITE 215
 DALLAS, TEXAS 75252
 (972) 248-9651 FAX (972) 248-9681

CITY OF ROCKWALL, TEXAS
LA JOLLA POINTE ADDITION
PAVING & DRAINAGE IMPROVEMENTS
LA JOLLA PT. DR.

DESIGN	DRAWN	DATE	SCALE	PROJ. No.	SHEET No.
PSA	MIR	2-28-01	H:V = 40:10	2001 LJP	PH2P-3