
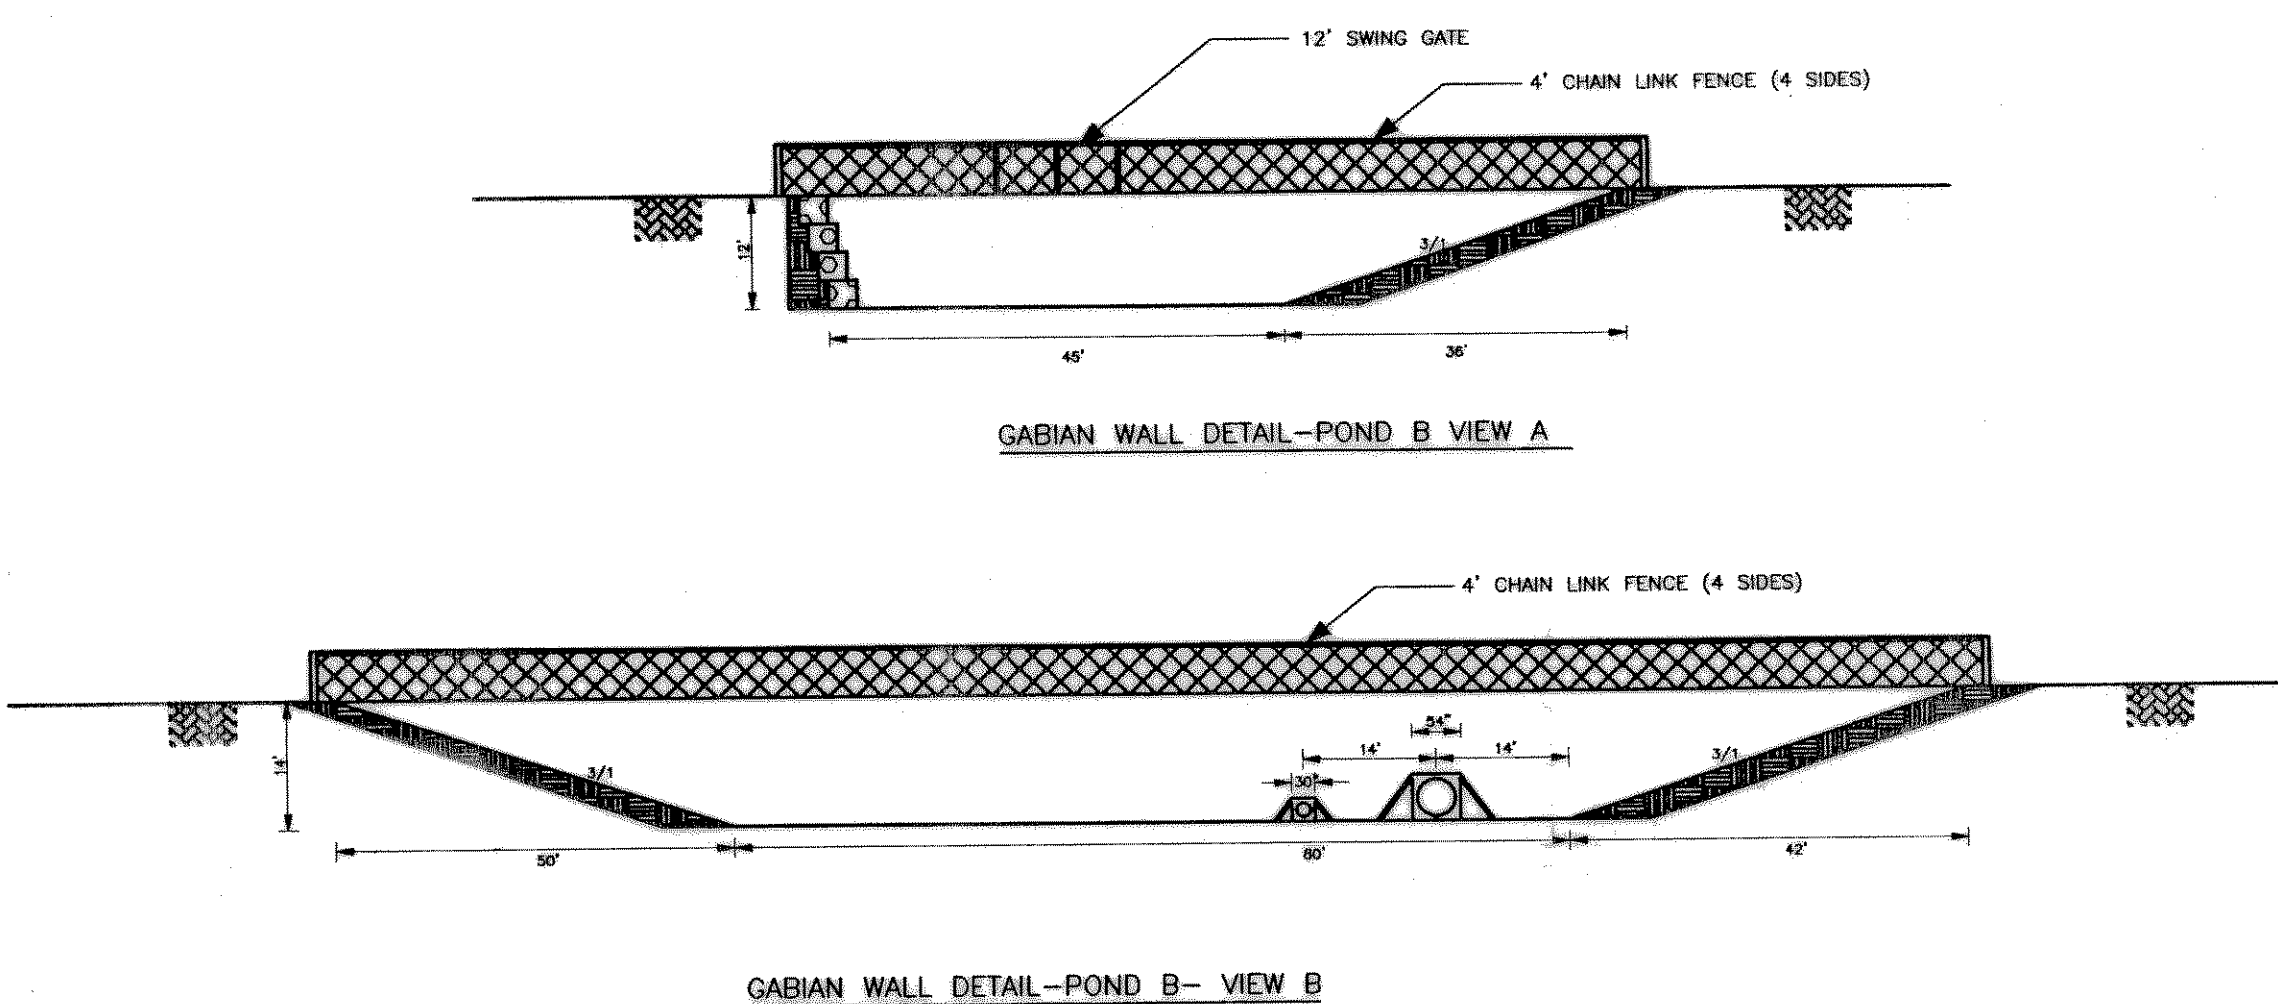


LINE	AREA	C	T	I	Q
B-2	0.76	0.8	10	9.8	5.96
B-3	14.1	0.9	10	9.8	124.36

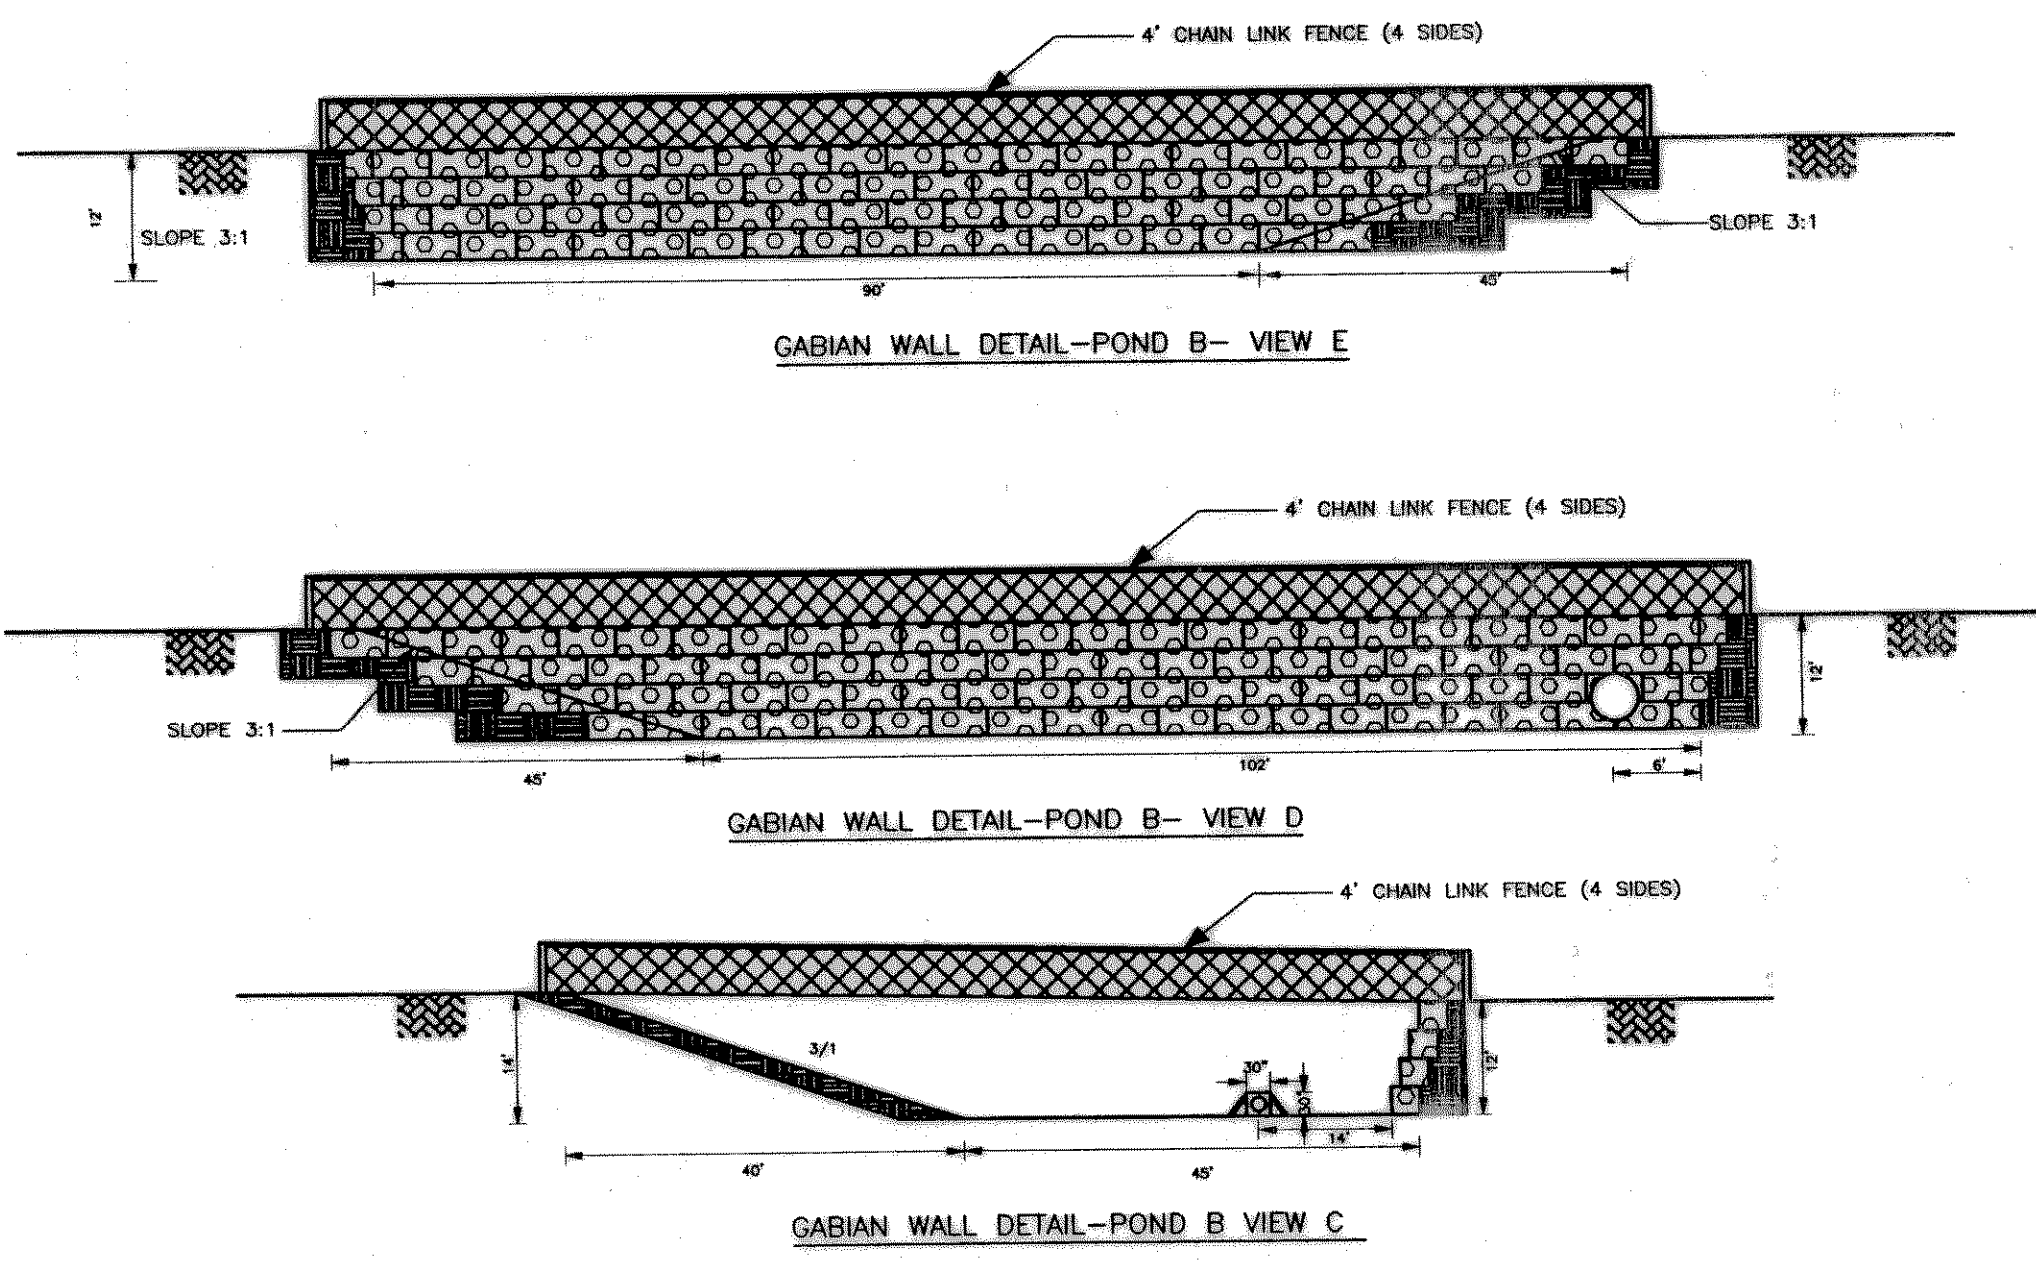


**BENCH MARK(S) :**  
 EXISTING SQUARE CUT ON TOP OF WEST CURB OF LAKESIDE DRIVE LOCATED APPROXIMATELY 120 FEET NORTH OF RAILROAD, AT THE NORTHWEST CORNER. ELEV=506.23

**LEGEND :**

PROP. STM. SWR.		RIGHT-OF-WAY	
EX. STM. SWR.		LOT LINE	
PROP. SAN. SWR.		DITCH FLOWLINE	
EX. SAN. SWR.		EX. GAS	
PROP. WATER		EX. BURIED TELEPHONE	
EX. WATER		EX. BURIED ELECTRICAL	
FENCE			

PROP. FIRE HYDRANT		EXIST. FIRE HYDRANT	
PROP. GATE VALVE		EXIST. GATE VALVE	
PROP. MANHOLE		EXIST. MANHOLE	
POWER POLE		CLEANOUT	
GUY WIRE		WATER METER	
PHONE BOX		GAS METER	
ROW-MARKER		ROAD SIGN	
IRON PIN		BENCHMARK	
TRAVERSE POINT		TREE	
MAILBOX			

REVISIONS			
REV. NO.	DESCRIPTION	DATE	DRWN. BY

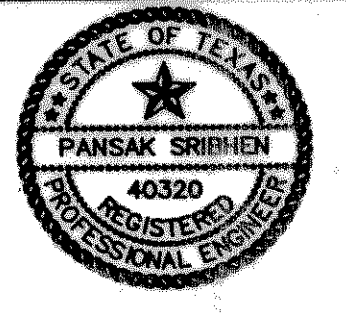

**ASA ENGINEERING**  
 17819 DAVENPORT RD, SUITE 215  
 DALLAS, TEXAS 75252  
 (972) 248-9651 FAX (972) 248-9681

CITY OF ROCKWALL, TEXAS  
 LA JOLLA POINTE ADDITION  
**STORM SEWER PROFILE - LINE B-2 AND LINE B-3**

DESIGN	DRAWN	DATE	SCALE	PROJ. No.	SHEET No.
PSA	MIR	2-22-01	1"=20' H 1"=5' V	2001.LJP	D-12