


LINE	AREA	C	T	I	Q
A-1	2.09	0.8	10	9.8	14.92
A-2	1.25	0.8	10	9.8	9.8
A-3	1.89	0.35	10	9.8	6.47

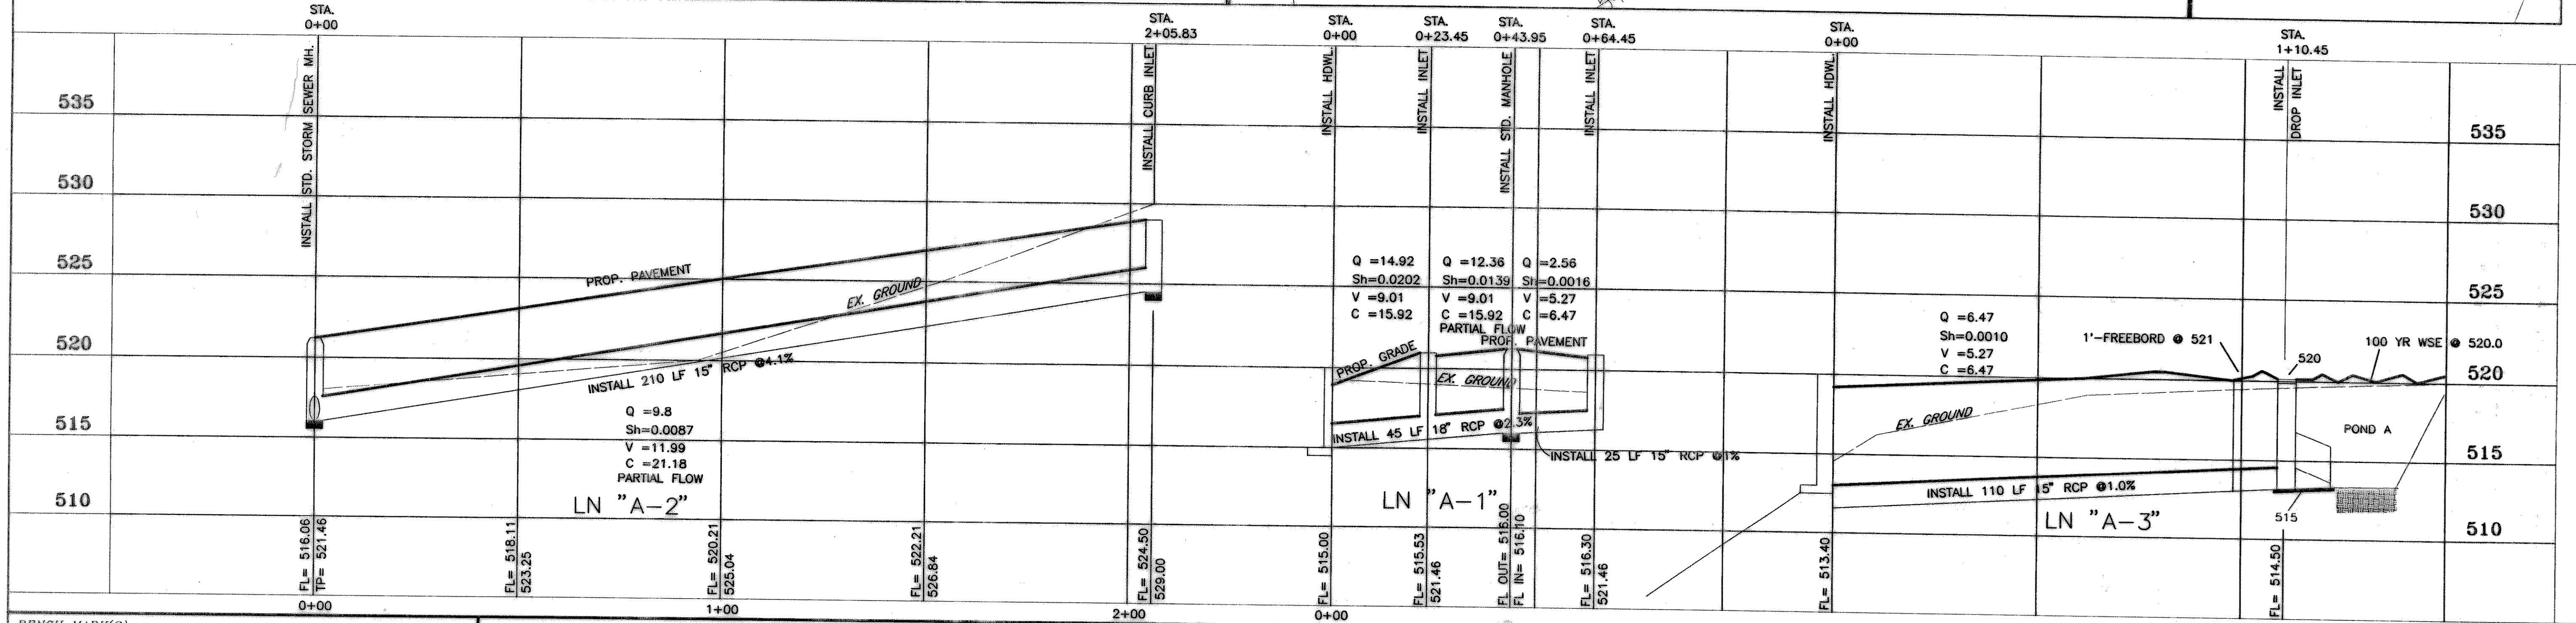


BENCH MARK(S)
 EXISTING SQUARE CUT ON TOP OF WEST CURB OF LAKESIDE DRIVE LOCATED APPROXIMATELY 120 FEET NORTH OF RAILROAD, AT THE NORTHWEST CORNER. ELEV=506.23

LEGEND

PROP. STM. SWR.	RIGHT-OF-WAY	PROP. FIRE HYDRANT
EX. STM. SWR.	LOT LINE	EXIST. FIRE HYDRANT
PROP. SAN. SWR.	DITCH FLOWLINE	EXIST. GATE VALVE
EX. SAN. SWR.	EX. GAS	EXIST. MANHOLE
PROP. WATER	EX. BURIED TELEPHONE	CLEANOUT
EX. WATER	EX. BURIED ELECTRICAL	WATER METER
FENCE		GAS METER
		ROAD SIGN
		BENCHMARK
		TREE

REVISIONS

REV. NO.	DESCRIPTION	DATE	DRWN. BY

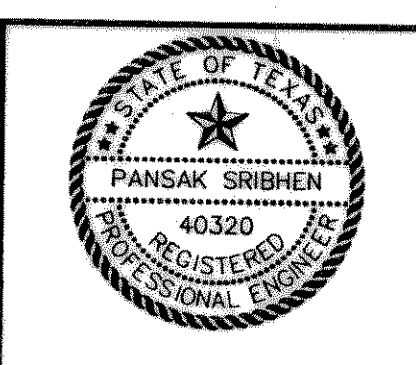

ASA ENGINEERING
 17819 DAVENPORT RD, SUITE 215
 DALLAS, TEXAS 75252
 (972) 248-9651 FAX (972) 248-9681

CITY OF ROCKWALL, TEXAS
LA JOLLA POINTE ADDITION
STORM SEWER PROFILE - LINE A-1 AND LINE A-2 LAGUNA DRIVE

DESIGN	DRAWN	DATE	SCALE	PROJ. No.	SHEET No.
PSA	MIR	2-22-01	1"=20' H 1"=5' V	2001.LJP	D-4

C:\2000\2001\LJP\CURRENT\11111.dwg Thu Mar 01 15:23:11 2001 MIBALI
 HP DesignJet 1050C Hewlett-Packard HP-GL/2 device, A01, 4.3 (4x.1) - Jul 22 1998