


LINE	AREA	C	T	I	Q
B-1	2.6	0.8	10	9.8	20.73
B-4	0.78	0.8	10	9.8	6.12
B-5	0.83	0.8	10	9.8	6.51

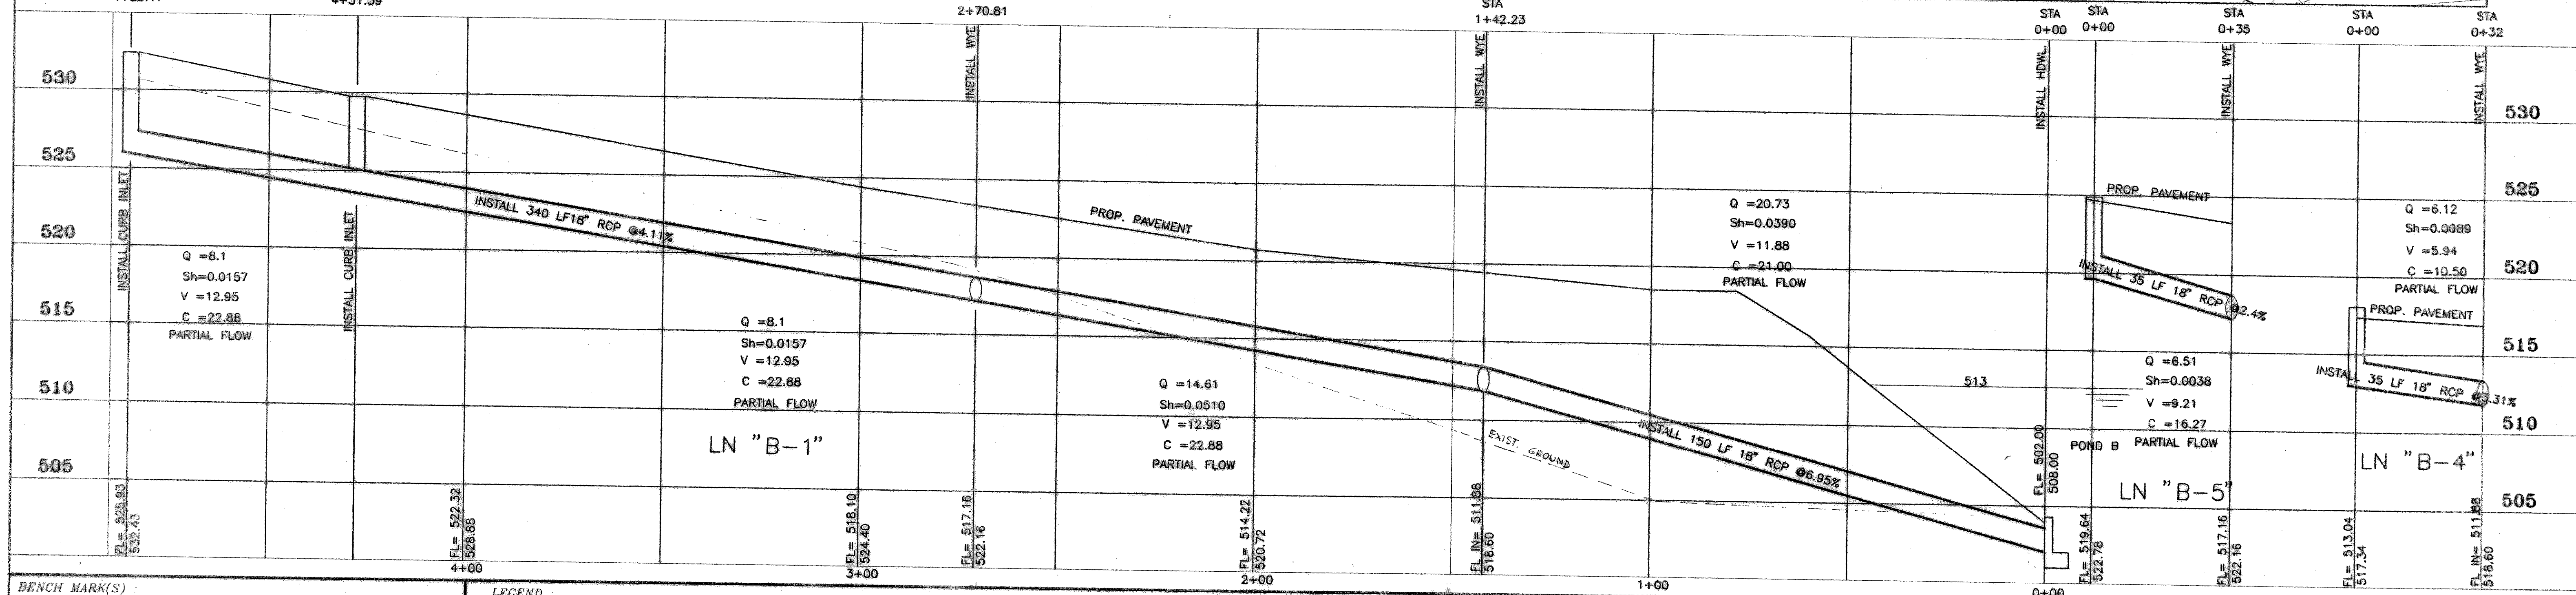


BENCH MARK(S)
 EXISTING SQUARE CUT ON TOP OF WEST CURB OF LAKESIDE DRIVE LOCATED APPROXIMATELY 120 FEET NORTH OF RAILROAD, AT THE NORTHWEST CORNER. ELEV=506.23

LEGEND

PROP. STM. SWR.	RIGHT-OF-WAY	PROP. FIRE HYDRANT
EX. STM. SWR.	LOT LINE	EXIST. FIRE HYDRANT
PROP. SAN. SWR.	DITCH FLOWLINE	PROP. GATE VALVE
EX. SAN. SWR.	EX. GAS	EXIST. GATE VALVE
PROP. WATER	EX. BURIED TELEPHONE	PROP. MANHOLE
EX. WATER	EX. BURIED ELECTRICAL	EXIST. MANHOLE
FENCE		POWER POLE
		GUY WIRE
		PHONE BOX
		ROW-MARKER
		IRON PIN
		TRAVERSE POINT
		MAILBOX
		TREE

REVISIONS

REV. NO.	DESCRIPTION	DATE	DRWN. BY

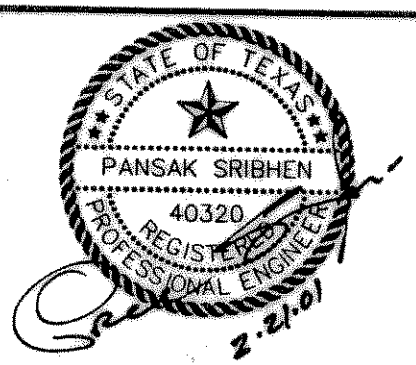

ASA ENGINEERING
 17819 DAVENPORT RD, SUITE 215
 DALLAS, TEXAS 75252
 (972) 248-9651 FAX (972) 248-9681

**CITY OF ROCKWALL, TEXAS
 LA JOLLA POINTE ADDITION**

**STORM SEWER PROFILE - LINE B-1
 CATALINA DRIVE**

DESIGN	DRAWN	DATE	SCALE	PROJ. No.	SHEET No.
PSA	MIR	1-8-01	1"=20' H 1"=5' V	2001-LJP	D-5

C:\2000\2001\LJP\CURRENT\1005.dwg New Feb 19 10:35:37 2001 MIRALI
 HP DesignJet 1050C Hewlett-Packard HP-BL/2 Drivers, A01, 4.3 (4x1) - Jul 22 1998