


LINE	AREA	C	T	I	Q
C-1	2.22	0.8	10	9.8	17.4
C-2	0.18	0.8	10	9.8	1.41
C-3	0.18	0.8	10	9.8	1.41

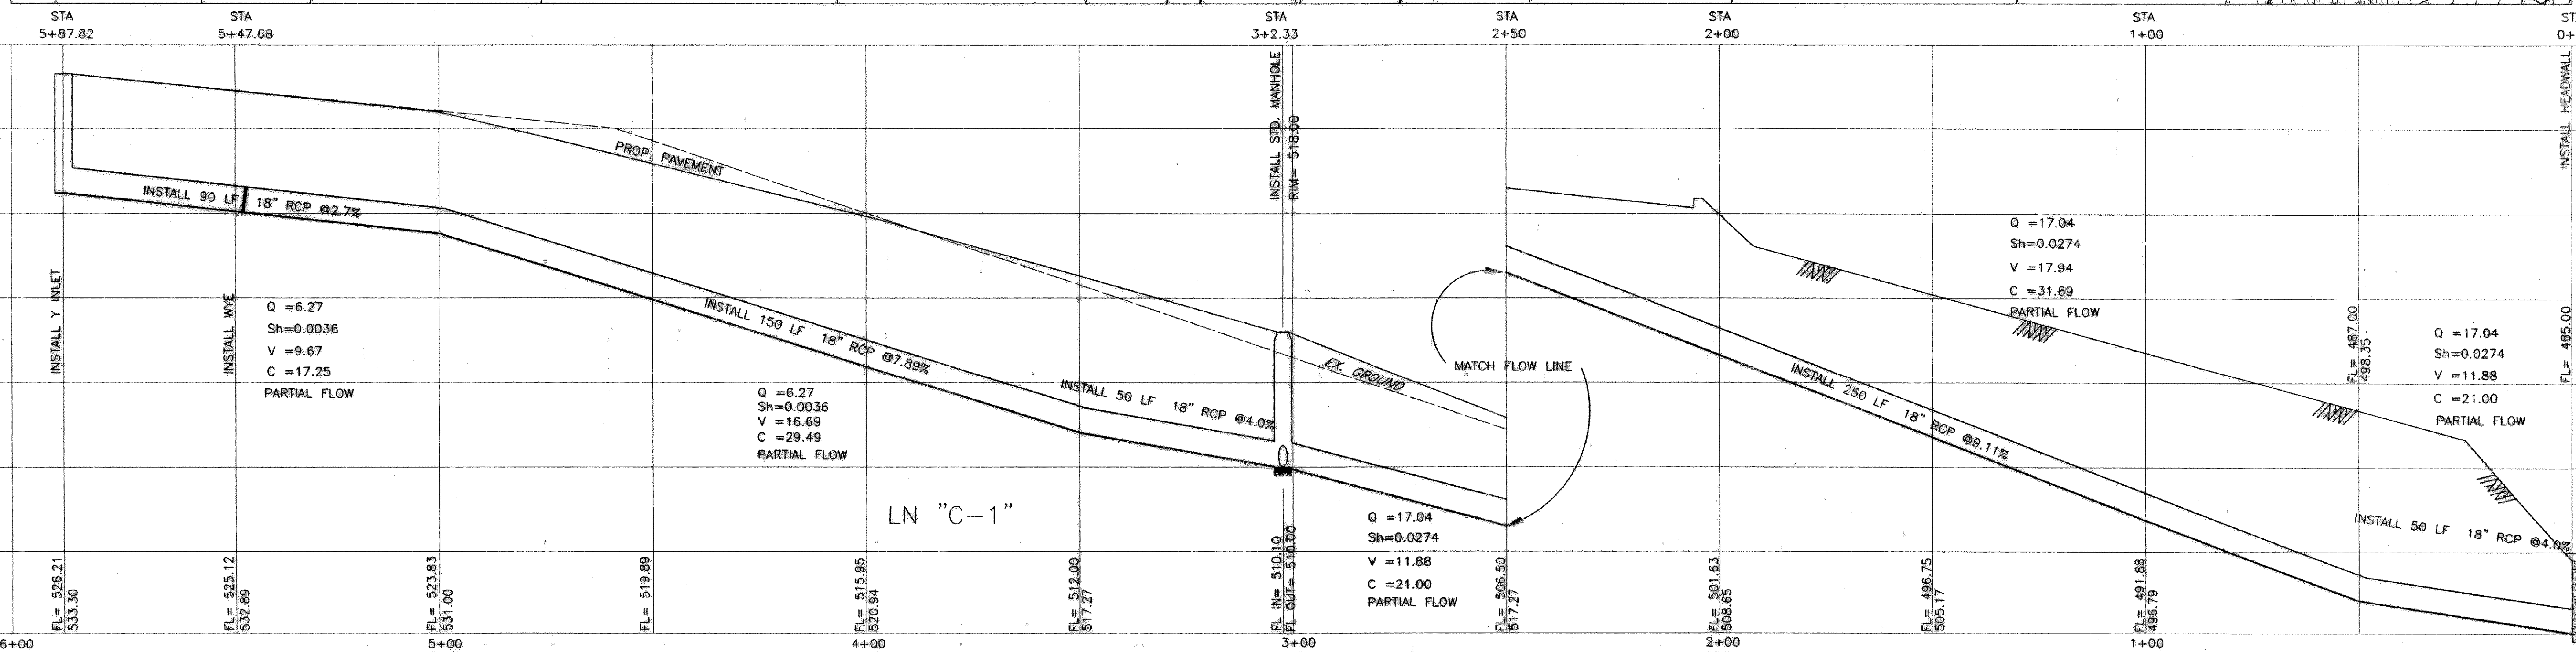

BENCH MARK(S):
 EXISTING SQUARE CUT ON TOP OF WEST CURB OF LAKESIDE DRIVE LOCATED APPROXIMATELY 120 FEET NORTH OF RAILROAD, AT THE NORTHWEST CORNER. ELEV=506.23

LEGEND:

PROP. STM. SWR.	RIGHT-OF-WAY	PROP. FIRE HYDRANT	EXIST. FIRE HYDRANT
EX. STM. SWR.	LOT LINE	PROP. GATE VALVE	EXIST. GATE VALVE
PROP. SAN. SWR.	DITCH FLOWLINE	PROP. MANHOLE	EXIST. MANHOLE
EX. SAN. SWR.	EX. GAS	CLEANOUT	WATER METER
PROP. WATER	EX. BURIED TELEPHONE	BUY WIRE	PHONE BOX
EX. WATER	EX. BURIED ELECTRICAL	ROW-MARKER	IRON PIN
FENCE		TRAVERSE POINT	MAILBOX

REVISIONS

REV. NO.	DESCRIPTION	DATE	DRWN. BY



ASA ENGINEERING
 17819 DAVENPORT RD, SUITE 215
 DALLAS, TEXAS 75252
 (972) 248-9651 FAX (972) 248-9681

CITY OF ROCKWALL, TEXAS
LA JOLLA POINTE ADDITION
STORM SEWER PROFILE - LINE C-1
LAGUNA DRIVE

DESIGN	DRAWN	DATE	SCALE	PROJ. No	SHEET No
PSA	MIR	9-21-00	1"=20' H 1"=5' V	2001.LJP	D-6