


LINE	AREA	C	T	I	Q
B-2	0.76	0.8	10	9.8	5.96
B-3	14.1	0.9	10	9.8	124.36

APPROVED FOR CONSTRUCTION  
JAN 02 2001

JAN 02 2001

City of Rockwall Engineering Dept.  
City Engineer: CAT

REVISION  
JAN 10 2001  
CITY OF ROCKWALL ENGINEERING DEPT.

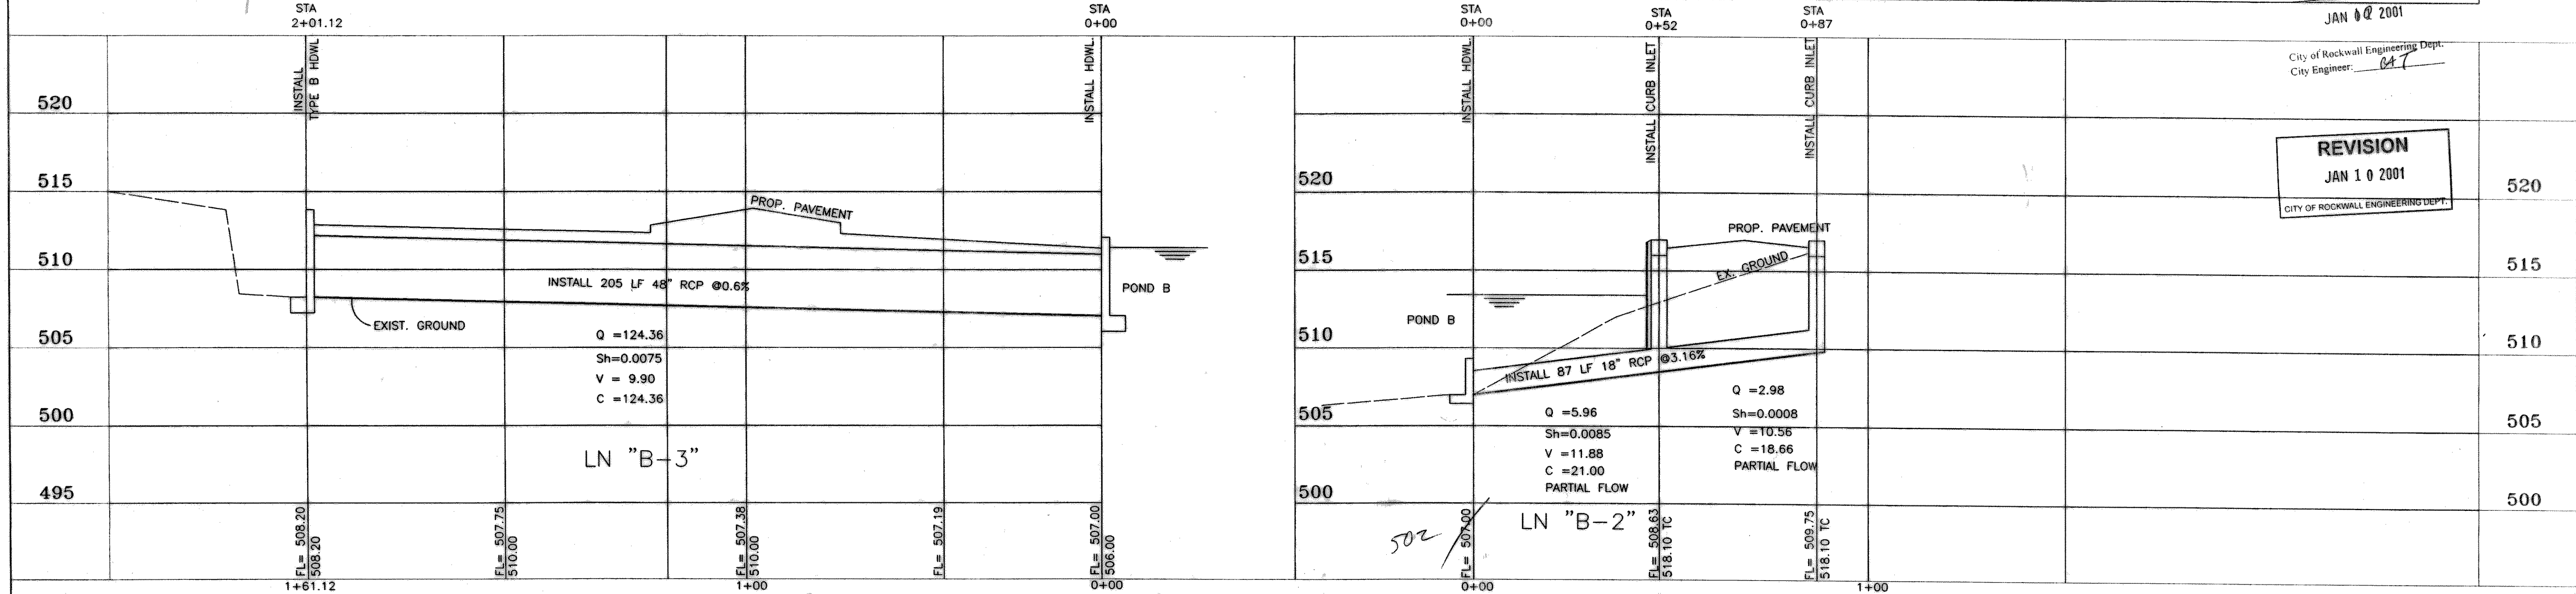


**BENCH MARK(S) :**  
EXISTING SQUARE CUT ON TOP OF WEST CURB OF LAKESIDE DRIVE LOCATED APPROXIMATELY 120 FEET NORTH OF RAILROAD, AT THE NORTHWEST CORNER. ELEV=506.23

**LEGEND :**

PROP. STM. SWR.		RIGHT-OF-WAY		PROP. FIRE HYDRANT		EXIST. FIRE HYDRANT	
EX. STM. SWR.		LOT LINE		PROP. GATE VALVE		EXIST. FIRE GATE VALVE	
PROP. SAN. SWR.		DITCH FLOWLINE		PROP. MANHOLE		EXIST. MANHOLE	
EX. SAN. SWR.		EX. GAS		POWER POLE		CLEANOUT	
PROP. WATER		EX. BURIED TELEPHONE		GUY WIRE		WATER METER	
EX. WATER		EX. BURIED ELECTRICAL		PHONE BOX		GAS METER	
FENCE				ROW-MARKER		ROAD SIGN	
				IRON PIN		BENCHMARK	
				TRAVERSE POINT		TREE	
				MAILBOX			

**REVISIONS**

REV. NO.	DESCRIPTION	DATE	DRWN. BY

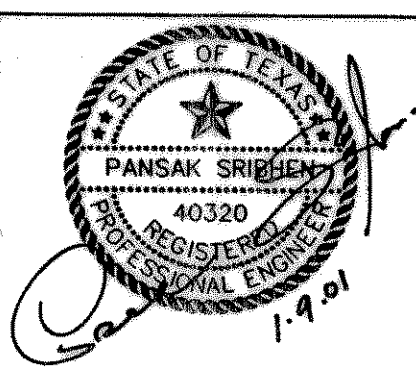

**ASA ENGINEERING**  
17819 DAVENPORT RD., SUITE 215  
DALLAS, TEXAS 75252  
(972) 248-9651 FAX (972) 248-9661

**CITY OF ROCKWALL, TEXAS  
LA JOLLA POINTE ADDITION**

**STORM SEWER PROFILE - LINE B-2 AND LINE B-3**

DESIGN	DRAWN	DATE	SCALE	PROJ. No	SHEET No
PSA	MIR	9-21-00	1"=20' H 1"=5' V	2001.LJP	D-7