


LINE	AREA	C	T	I	Q
D-2	4.84	.35	9.8	10	16.60

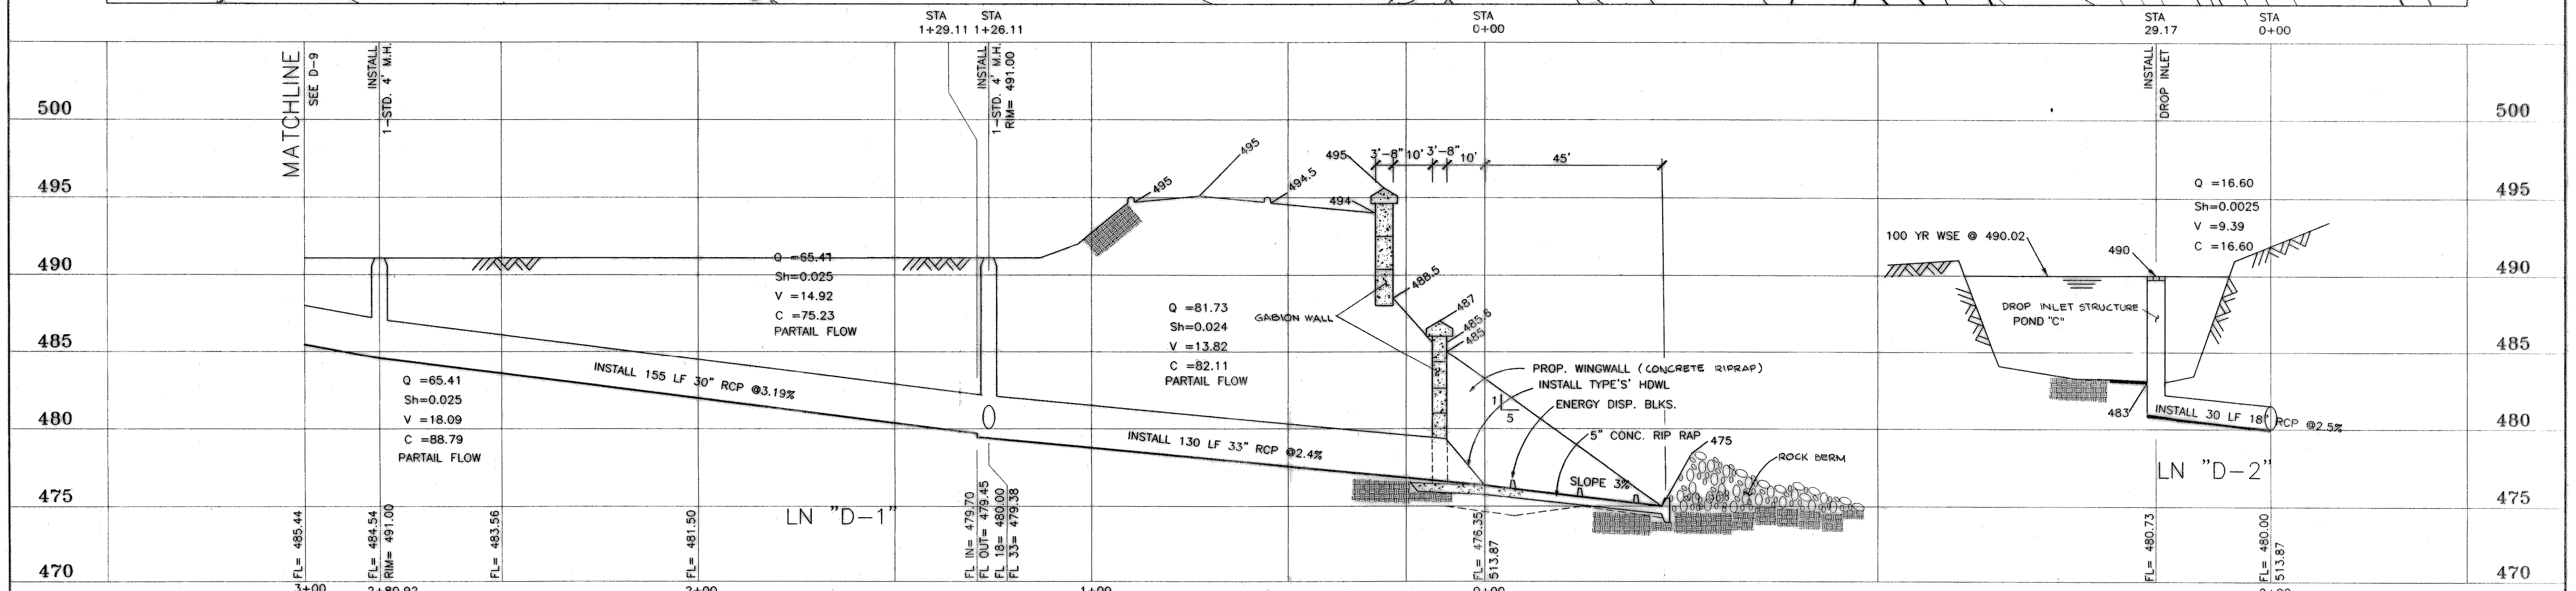

BENCH MARK(S) : EXISTING SQUARE CUT ON TOP OF WEST CURB OF LAKESIDE DRIVE LOCATED APPROXIMATELY 120 FEET NORTH OF RAILROAD, AT THE NORTHWEST CORNER. ELEV=906.23		LEGEND : PROP. STM. SWR. [Symbol] EX. STM. SWR. [Symbol] PROP. SAN. SWR. [Symbol] EX. SAN. SWR. [Symbol] PROP. WATER [Symbol] EX. WATER [Symbol] FENCE [Symbol]		RIGHT-OF-WAY [Symbol] LOT LINE [Symbol] DITCH FLOWLINE [Symbol] EX. GAS [Symbol] EX. BURIED TELEPHONE [Symbol] EX. BURIED ELECTRICAL [Symbol]		PROP. FIRE HYDRANT [Symbol] PROP. GATE VALVE [Symbol] PROP. MANHOLE [Symbol] POWER POLE [Symbol] GUY WIRE [Symbol] PHONE BOX [Symbol] ROW-MARKER [Symbol] IRON PIN [Symbol] TRAVERSE POINT [Symbol] MAILBOX [Symbol]		EXIST. FIRE HYDRANT [Symbol] EXIST. GATE VALVE [Symbol] EXIST. MANHOLE [Symbol] CLEANOUT [Symbol] WATER METER [Symbol] GAS METER [Symbol] ROAD SIGN [Symbol] BENCHMARK [Symbol] TREE [Symbol]		REVISIONS <table border="1"> <thead> <tr> <th>REV. NO.</th> <th>DESCRIPTION</th> <th>DATE</th> <th>DRWN BY</th> </tr> </thead> <tbody> <tr> <td> </td> <td> </td> <td> </td> <td> </td> </tr> </tbody> </table>		REV. NO.	DESCRIPTION	DATE	DRWN BY									CITY OF ROCKWALL, TEXAS LA JOLLA POINTE ADDITION STORM SEWER PROFILE - LINE D-1 AND LINE D-2 <table border="1"> <thead> <tr> <th>DESIGN</th> <th>DRAWN</th> <th>DATE</th> <th>SCALE</th> <th>PROJ. No.</th> <th>SHEET No.</th> </tr> </thead> <tbody> <tr> <td>PSA</td> <td>MIR</td> <td>01-26-01</td> <td>1"=20' H 1"=5' V</td> <td>2001.LLP</td> <td>D-8</td> </tr> </tbody> </table>		DESIGN	DRAWN	DATE	SCALE	PROJ. No.	SHEET No.	PSA	MIR	01-26-01	1"=20' H 1"=5' V	2001.LLP	D-8
REV. NO.	DESCRIPTION	DATE	DRWN BY																																		
DESIGN	DRAWN	DATE	SCALE	PROJ. No.	SHEET No.																																
PSA	MIR	01-26-01	1"=20' H 1"=5' V	2001.LLP	D-8																																

C:\2000\2001\LP\lp1018.dwg F11 Jan 25 15:10:40 2001 Andy