


BENCH MARK(S) :
 EXISTING SQUARE CUT ON TOP OF WEST CURB OF LAKESIDE DRIVE
 LOCATED APPROXIMATELY 120 FEET NORTH OF RAILROAD, AT THE
 NORTHWEST CORNER. ELEV=506.23

LEGEND :

REVISIONS

REV. NO.	DESCRIPTION	DATE	DRWN BY

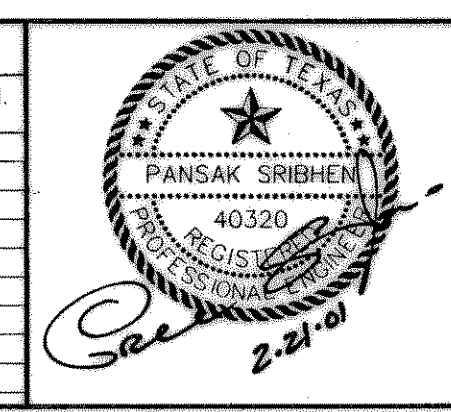

ASA ENGINEERING
 17819 DAVENPORT RD, SUITE 215
 DALLAS, TEXAS 75252
 (972) 248-9651 FAX (972) 248-9681

**CITY OF ROCKWALL, TEXAS
 LA JOLLA POINTE ADDITION**

SEWER IMPROVEMENTS PLAN

DESIGN	DRAWN	DATE	SCALE	PROJ. No	SHEET No.
PSA	MIR	2-21-01	1"=100'	2001.LJP	U-2

C:\2000\2001\LJP\CURRENT\LAND-2.dwg NH Feb 21 14:46:20 2001