

APPROVED FOR CONSTRUCTION


OCT 3 2000

City of Rockwall Engineering Dept.
City Engineer: _____

BENCH MARK(S) :
EXISTING SQUARE CUT ON TOP OF WEST CURB OF LAKESIDE DRIVE LOCATED APPROXIMATELY 120 FEET NORTH OF RAILROAD, AT THE NORTHWEST CORNER. ELEV=506.23

LEGEND :

REVISIONS			
REV. NO.	DESCRIPTION	DATE	DRWN. BY

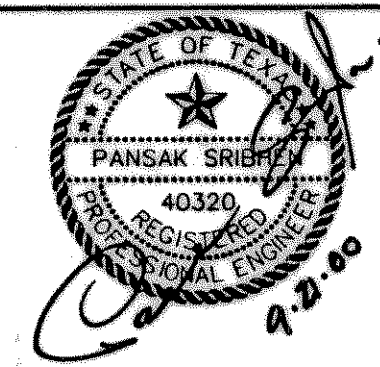

ASA ENGINEERING
17819 DAVENPORT RD, SUITE 215
DALLAS, TEXAS 75252
(972) 248-9651 FAX (972) 248-9681

**CITY OF ROCKWALL, TEXAS
LA JOLLA POINTE ADDITION**

WATER IMPROVEMENTS LINE 'A'

DESIGN	DRAWN	DATE	SCALE	PROJ. No.	SHEET No.
PSA	PSA	9-21-00	H:1"=40' V:1"=10'	2001 LJP	U-3