

Min. SDR 26 if Depth over 10'

APPROVED FOR
CONSTRUCTION


OCT 3 2000

City of Rockwall Engineering Dept.
City Engineer: _____

BENCH MARK(S) :
EXISTING SQUARE CUT ON TOP OF WEST CURB OF LAKESIDE DRIVE
LOCATED APPROXIMATELY 120 FEET NORTH OF RAILROAD, AT THE
NORTHWEST CORNER. ELEV=506.23

LEGEND :

REVISIONS			
REV. NO.	DESCRIPTION	DATE	DRWN BY

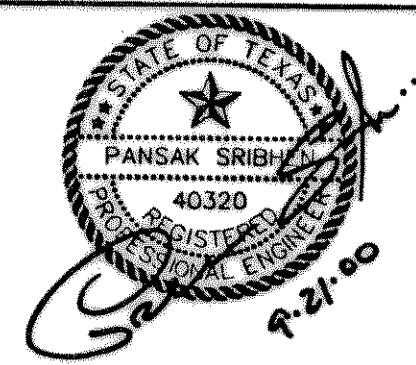

ASA
ENGINEERING
17819 DAVENPORT HILL, SUITE 215
DALLAS, TX 75252
(972) 248-9651 FAX (972) 248-9681

CITY OF ROCKWALL, TEXAS
LA JOLLA POINTE ADDITION
WATER AND SEWER IMPROVEMENTS

DESIGN	DRAWN	DATE	SCALE	PROJ. No.	SHEET No.
PSA	PSA	9 21 00	H 1" = 40' V 1" = 10'	2001 LJP	U-6