

APPROVED FOR CONSTRUCTION

OCT 3 2000

City of Rockwall Engineering Dept.
City Engineer: _____


BENCH MARK(S) :
EXISTING SQUARE CUT ON TOP OF WEST CURB OF LAKESIDE DRIVE
LOCATED APPROXIMATELY 120 FEET NORTH OF RAILROAD, AT THE
NORTHWEST CORNER. ELEV=506.23

LEGEND :

--	--	--	--

REVISIONS

REV. NO.	DESCRIPTION	DATE	DRWN. BY

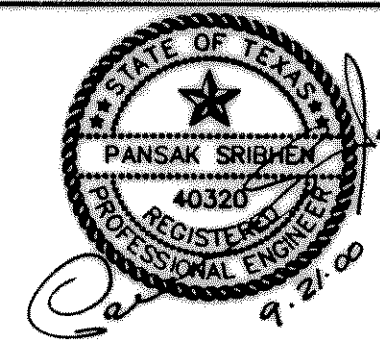

ASA ENGINEERING
17819 DAVENPORT RD., SUITE 215
DALLAS, TEXAS 75252
(972) 248-9651 FAX (972) 248-9651

**CITY OF ROCKWALL, TEXAS
LA JOLLA POINTE ADDITION**

WATER AND SEWER IMPROVEMENTS

DESIGN	DRAWN	DATE	SCALE	PROJ. No.	SHEET No.
PSA	MIR	9-21-00	H 1" = 40' V 1" = 10'	2001 LJP	U-7

C:\2000\2001\PL\CURRENT\U-7\1.dwg Fr1 Sep 22 10:29:03 2000